

**ASSOCIATED ATTACHMENTS/ENCLOSURES:**

Attachment 02.04.03-09B: Guntersville Calculation  
Calculation **CDQ000020080011, Rev. 1**  
Title **Dam Rating Curve - Guntersville**  
EDMS Number: **L58 090908 002**

(266 Pages including Cover Sheet)

NPG CALCULATION COVERSHEET/CCRIS UPDATE

REV 0 EDMS/RIMS NO. L 58 090224 004		EDMS TYPE: Calculations (nuclear)		EDMS ACCESSION NO (N/A for REV. 0) <b>L 58 090908 002</b>				
Calc Title: Initial Dam Rating Curve, Guntersville								
CALC ID	TYPE	ORG	PLANT	BRANCH	NUMBER	CUR REV	NEW REV	REVISION APPLICABILITY Entire calc <input checked="" type="checkbox"/> Selected pages <input type="checkbox"/>
CURRENT	CN	NUC	GEN	CEB	CDQ000020080011	0	1	
NEW	CN	NUC	GEN	CEB				
ACTION	NEW REVISION <input checked="" type="checkbox"/>	DELETE RENAME <input type="checkbox"/>	SUPERSEDE DUPLICATE <input type="checkbox"/>	CCRIS UPDATE ONLY <input type="checkbox"/> (Verifier Approval Signatures Not Required)		No CCRIS Changes <input type="checkbox"/> (For calc revision, CCRIS been reviewed and no CCRIS changes required)		
UNITS N/A	SYSTEMS N/A		UNIDS N/A					
DCN.EDC.N/A See Below		APPLICABLE DESIGN DOCUMENT(S) N/A				CLASSIFICATION E		
QUALITY RELATED? Yes <input checked="" type="checkbox"/> No <input type="checkbox"/>	SAFETY RELATED? (If yes, QR = yes) Yes <input checked="" type="checkbox"/> No <input type="checkbox"/>		UNVERIFIED ASSUMPTION Yes <input type="checkbox"/> No <input checked="" type="checkbox"/>	SPECIAL REQUIREMENTS AND/OR LIMITING CONDITIONS? Yes <input checked="" type="checkbox"/> No <input type="checkbox"/>		DESIGN OUTPUT ATTACHMENT? Yes <input type="checkbox"/> No <input checked="" type="checkbox"/>	SAR/TS and/or ISFSI SAR/CoC AFFECTED Yes <input type="checkbox"/> No <input checked="" type="checkbox"/>	
PREPARER ID A.C. Murr	PREPARER PHONE NO 205-298-6074	PREPARING ORG (BRANCH) BWSC (CEB)		VERIFICATION METHOD Design Review	NEW METHOD OF ANALYSIS <input type="checkbox"/> Yes <input checked="" type="checkbox"/> No			
PREPARER SIGNATURE Andrew Murr	DATE 08/27/2009	CHECKER SIGNATURE Bryant Bondurani		DATE 8/28/09				
VERIFIER SIGNATURE L.Y. Lin	DATE 8/28/09	APPROVAL SIGNATURE K.E. Gates		DATE 9-4-09				
STATEMENT OF PROBLEM/ABSTRACT								
<p>Initial dam rating (headwater rating) curves are required as inputs to TVA's SOCH and TRBROUTE models, used in performing flood-routing calculations for the Tennessee River. The initial dam rating curves provide total dam discharge as a function of headwater elevation and are used to define the beginning conditions for the hydraulic analysis. The final dam rating curve is confirmed and documented in the SOCH Probable Maximum Flood model calculation by validating the headwater-tailwater relationship across the modeled dam configuration.</p> <p>Note: This dam rating curve determined in this calculation must only be used for determining the effects of a Probable Maximum Flood (PMF) upstream of Guntersville Dam (see Section 5.0).</p> <p>EDCN - 22404 (SQN) EDCN - 54018 (WBN) EDCN - later (BFN)</p> <p><i>This calculation contains electronic attachments and must be stored in EDMS as an Adobe .pdf file to maintain the ability to retrieve the electronic attachments.</i></p>								
MICROFICHE/EFICHE Yes <input type="checkbox"/> No <input checked="" type="checkbox"/> FIGE NUMBER(S)								
<input type="checkbox"/> LOAD INTO EDMS AND DESTROY <input checked="" type="checkbox"/> LOAD INTO EDMS AND RETURN CALCULATION TO CALCULATION LIBRARY. ADDRESS: LP4D-C <input type="checkbox"/> LOAD INTO EDMS AND RETURN CALCULATION TO:								

NPG CALCULATION COVERSHEET/CCRIS UPDATE

REV 0 EDMS/RIMS NO. <b>L58 090224 004</b>		EDMS TYPE: Calculations (nuclear)		EDMS ACCESSION NO (N/A for REV 0) N/A				
Calc Title: Dam Rating Curves, Guntersville								
CALC ID	TYPE	ORG	PLANT	BRANCH	NUMBER	CUR REV	NEW REV	REVISION APPLICABILITY Entire calc <input type="checkbox"/> Selected pages <input type="checkbox"/>
CURRENT	CN	NUC						
NEW	CN	NUC	GEN	CEB	CDQ000020080011	N/A	0	
ACTION	NEW REVISION <input type="checkbox"/>	DELETE RENAME <input type="checkbox"/>	SUPERSEDE DUPLICATE <input type="checkbox"/>	CCRIS UPDATE ONLY <input type="checkbox"/>	(Verifier Approval Signatures Not Required)			No CCRIS Changes <input type="checkbox"/> (For calc revision, CCRIS been reviewed and no CCRIS changes required)
UNITS	SYSTEMS		UNIDS					
N/A	N/A		N/A					
DCN.EDC. N/A	APPLICABLE DESIGN DOCUMENT(S)				CLASSIFICATION			
N/A	N/A				E			
QUALITY RELATED? Yes <input checked="" type="checkbox"/> No <input type="checkbox"/>	SAFETY RELATED? (If yes, QR = yes) Yes <input checked="" type="checkbox"/> No <input type="checkbox"/>	UNVERIFIED ASSUMPTION Yes <input checked="" type="checkbox"/> No <input type="checkbox"/>	SPECIAL REQUIREMENTS AND/OR LIMITING CONDITIONS? Yes <input checked="" type="checkbox"/> No <input type="checkbox"/>	DESIGN OUTPUT ATTACHMENT? Yes <input type="checkbox"/> No <input checked="" type="checkbox"/>	SAR/TS and/or ISFSI SAR/CoC AFFECTED Yes <input type="checkbox"/> No <input checked="" type="checkbox"/>			
PREPARER ID gaschohl	PREPARER PHONE NO 865-632-3968	PREPARING ORG (BRANCH) CEB	VERIFICATION METHOD Design Review	NEW METHOD OF ANALYSIS <input type="checkbox"/> Yes <input checked="" type="checkbox"/> No				
PREPARER SIGNATURE G.A. Schohl <i>Gerald A. Schohl</i>	DATE 02/6/2009	CHECKER SIGNATURE <i>JANIE B. MAUTER</i>	DATE 2/9/09					
VERIFIER SIGNATURE <i>ANDREW C. MURR</i>	DATE 2/9/09	APPROVAL SIGNATURE <i>F.B. SPATES</i>	DATE 2/24/09					
STATEMENT OF PROBLEM/ABSTRACT								
<p>Dam rating (headwater rating) curves for 20 dams are required as inputs to TVA's SOCH and TRBROUTE models, which perform flood-routing calculations for the Tennessee River and tributaries. The dam rating curves provide total dam discharge as a function of headwater elevation. This calculation presents the dam curve for Guntersville Dam.</p> <p>Assumption 3.1.1 limits this dam rating curve to use in determination of PMF levels for plants above Guntersville reservoir. This rating curve is not acceptable for use in determination of the PMF levels at Browns Ferry. See Section 5.1.</p> <p><i>W. Miller</i></p> <p><b>This calculation contains electronic attachments and must be stored in EDMS as an Adobe .pdf file to maintain the ability to retrieve the electronic attachments.</b></p>								
MICROFICHE/EFICHE Yes <input type="checkbox"/> No <input checked="" type="checkbox"/> FICHE NUMBER(S)								
<input type="checkbox"/> LOAD INTO EDMS AND DESTROY <input checked="" type="checkbox"/> LOAD INTO EDMS AND RETURN CALCULATION TO CALCULATION LIBRARY. ADDRESS: LP4D-C <input type="checkbox"/> LOAD INTO EDMS AND RETURN CALCULATION TO:								

NPG CALCULATION COVERSHEET/CCRIS UPDATE

<u>CALC ID</u>	<u>TYPE</u>	<u>ORG</u>	<u>PLANT</u>	<u>BRANCH</u>	<u>NUMBER</u>	<u>REV</u>
	CN	NUC	GEN	CEB	CDQ000020080011	1

**ALTERNATE CALCULATION IDENTIFICATION**

<u>BLDG</u>	<u>ROOM</u>	<u>ELEV</u>	<u>COORD/AZIM</u>	<u>FIRM</u> BWSC	<u>Print Report</u> Yes <input type="checkbox"/>
CATEGORIES NA					

**KEY NOUNS (A-add, D-delete)**

<u>ACTION</u> (A/D)	<u>KEY NOUN</u>	<u>A/D</u>	<u>KEY NOUN</u>

**CROSS-REFERENCES (A-add, C-change, D-delete)**

<u>ACTION</u> (A/C/D)	<u>XREF</u> <u>CODE</u>	<u>XREF</u> <u>TYPE</u>	<u>XREF</u> <u>PLANT</u>	<u>XREF</u> <u>BRANCH</u>	<u>XREF</u> <u>NUMBER</u>	<u>XREF</u> <u>REV</u>
A	S	CN	GEN	CEB	CDQ000020080041	
A	S	CN	GEN	CEB	CDQ000020080046	
A	S	CN	GEN	CEB	CDQ000020080053	
A	S	CN	GEN	CEB	CDQ000020080054	

CCRIS ONLY UPDATES:  
Following are required only when making keyword/cross reference CCRIS updates and page 1 of form NEDP-2-1 is not included:

PREPARER SIGNATURE	DATE	CHECKER SIGNATURE	DATE
PREPARER PHONE NO.	EDMS ACCESSION NO.		

**NPG CALCULATION RECORD OF REVISION**

CALCULATION IDENTIFIER CDQ000020080011

Title Initial Dam Rating Curve, Guntersville

Revision No.	DESCRIPTION OF REVISION
0	Initial issue Total Pages: 75
1	<p>This calculation was revised to remove the conservative tailwater assumption. Significant changes to text are marked with a right-hand margin revision bar.</p> <p>Pages deleted: 3  Pages revised: 1, 2, 3, 4, 6, 8, 9, 14, 17  New pages added: 1a  Calculation header was revised (Title and Revision) on all pages from page 5, inclusive.  UVA 3.2.1 – Removed based on Reference 31.  UVA 3.2.2 – Removed based on Reference 32.  UVA 3.2.3 – Removed based on conservative estimate.  UVA 3.2.4 – Removed based on conservative estimate and validation at a later date.  UVA 3.2.5 – Removed based on Reference 33.  Revised electronic attachment 19 and 21.</p> <p>Total pages for Revision 1: 74</p>

**NPG CALCULATION TABLE OF CONTENTS**

Calculation Identifier: CDQ000020080011

Revision: 1

**TABLE OF CONTENTS**

SECTION	TITLE	PAGE
	Coversheet	1
	Revision 0 Coversheet	1a
	CCRIS Update Sheet	2
	Revision Log	3
	Table of Contents	4
	Computer Input Sheet	5
1	Purpose	6
2	References	8
3	Assumptions & Methodology	9
4	Design Input	12
5	Special Requirements/Limiting Conditions	14
6	Calculations	15
7	Results/Conclusions	17
Attachment		
1	General plan, Guntersville Dam (Ref. 1)	
2	Photograph of Guntersville Dam (Ref. 2)	
3	Upper miter gates of main and auxiliary locks	2 pages
4	Turbine discharge curves and turbine data	4 pages
5	Tailwater rating curve provided by TVA River Operations Flood Risk Section	4 pages
6	Table of Spillway Gate Arrangements (Ref.3)	
7	Location of Spillway Gates and Key to Gate Arrangements (Ref. 3)	
8	Safety Modifications for Probable Maximum Flood (Ref. 2)	
9	Excerpt from Reference 5	4 pages
10	Hydraulic Design Chart 711 (Ref. 6)	
11	Polynomial fit to HDC 711 suggested design curve for submergence factor	
12	Plan, elevation, & sections for spillway (Ref. 8)	
13	Free discharge coefficient vs. Head	
14	Free discharge submergence factor vs. submergence ratio	
15	Overflow parameters for navigation locks	15 pages
16	Overflow parameters for spillway piers	3 pages
17	Overflow parameters for north embankment and flood wall	4 pages
18	Overflow parameters for south embankment	3 pages
19	Polynomial fit to tailwater rating curve in Attachment 5	
20	Orifice flow through a spillway bay	4 pages
21- 49	See listing of electronic attachments on page 5	

**NPG COMPUTER INPUT FILE  
STORAGE INFORMATION SHEET**

Document CDQ000020080011

Rev. 0

Plant: GEN

Subject:

Initial Dam Rating Curve, Guntersville

Electronic storage of the input files for this calculation is not required. Comments:

Input files for this calculation have been stored electronically and sufficient identifying information is provided below for each input file. (Any retrieved file requires re-verification of its contents before use.)

These files are electronically attached to the parent ADOBE.pdf calculation file. All files are therefore stored in an unalterable medium and are retrievable through the EDMS number for this calculation.

Attachment 21: Guntersville Rating Curves.xls

Spreadsheet for dam rating curve calculations

Attachment 22: Complete PDF copy of Reference 2

Attachment 23: Complete PDF copy of Reference 3

Attachment 24: Complete PDF copy of Reference 5

Attachments 25 through 49: Large resolution PDF files of References 1 and 7-30

Microfiche/eFiche

# TVA

<b>Calculation No.</b> CDQ000020080011	<b>Rev:</b> 1	<b>Plant:</b> GEN	<b>Page:</b> 6
<b>Subject:</b> Initial Dam Rating Curve, Guntersville		<b>Prepped</b>	A. Murr
		<b>Checked</b>	B. Bondurant

## 1. Purpose

Initial dam rating (headwater rating) curves are required as inputs to TVA's SOCH and TRBROUTE models, used in performing flood-routing calculations for the Tennessee River. The initial dam rating curves provide total dam discharge as a function of headwater elevation and are used to define the beginning conditions for hydraulic analysis. The final dam rating curve is confirmed and documented in the SOCH Probable Maximum Flood model calculation (Reference 31) by validating the headwater-tailwater relationship across the modeled dam configuration.

TVA developed methods of analysis, procedures, and computer programs for determining design basis flood levels for nuclear plant sites in the 1970's. Determination of maximum flood levels included consideration of the most severe flood conditions that may be reasonably predicted to occur at a site as a result of both severe hydrometeorological conditions and seismic activity. This process was followed to meet Nuclear Regulatory Guide 1.59. At that time, there were no computer programs available that would handle unsteady flow and dam failure analysis. As a result of this early work and method development TVA developed a runoff and stream course modeling process for the TVA reservoir system. This process provided a basis for currently licensed plants (Sequoyah Nuclear Plant, Watts Bar Nuclear Plant, and Browns Ferry Nuclear Plant). The Bellefonte Nuclear Plant (BLN) Units 1 & 2 Final Safety Analysis Report (FSAR) was also based on this process.

BLN Unit 3 & 4 Combined Operating License Application (COLA) was submitted using data and analysis that was determined for the original BLN FSAR (Unit 1 and Unit 2) and was documented in a 1998 reassessment. In 1998, the analysis process and documentation was brought under the nuclear quality assurance process for the first time. A quality assurance audit conducted by NRC staff in early 2007 raised several questions related to past work regarding design basis flood level determinations. This calculation supports a portion of the effort to improve the design basis documentation.

Preparation of all calculations supporting nuclear development and licensing are subject to TVA Standard Department Procedure NEDP-2. This standard dictates the process in which calculation are prepared, checked, verified, stored, and cross referenced in a goal to provide the highest quality nuclear design input and output possible.

Figure 1 is a plan and elevation view of Guntersville Dam (a portion of Reference 1, which is included as Attachment 1). A photograph is included as Attachment 2. For headwaters in the normal operating range, discharge is passed through the turbines or the spillway. The spillway consists of eighteen spillway bays, each with leaf gates to control discharge. If, as during a probable maximum flood (PMF) event, headwater rises above the normal operating range, discharge may pass also over the navigation locks, the tops of the spillway piers, the south embankment, and the north embankment. Discharge is not expected to pass over the north and south embankments, however, because their top elevations were raised in 1996 as part of the dam safety modification program. The modifications were designed to ensure that the embankments would not be overtopped during a PMF event (Reference 2). Nevertheless, the rating curve developed in this calculation includes headwater elevations above the tops of the modified embankments because overflow may occur in some flood-routing simulations. Potential breaching of overtopped embankments is conservatively ignored for plant sites upstream of the Guntersville dam. Flood-routing simulations downstream of Guntersville must consider the potential impact of breached embankments on the dam rating curve.


The initial dam rating curve is based on the current configuration of Guntersville Dam as defined on the current design drawings. The purpose of this calculation does not evaluate the design loading conditions for the dam or embankments.

Revision 0 discussed the dam rating curve results with a conservative assumption for tailwater, as tailored to the Bellefonte Nuclear Plant. However, in this Revision 1, the conservative tailwater assumption is taken out.




TVA

Calculation No. CDQ000020080011	Rev: 0	Plant: GEN	Page: 7
Subject: Initial Dam Rating Curve, Guntersville		Prepped	G. Schohl
		Checked	JBM

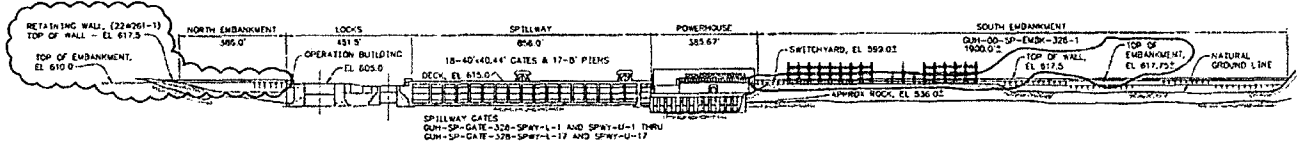

DOWNSTREAM ELEVATION

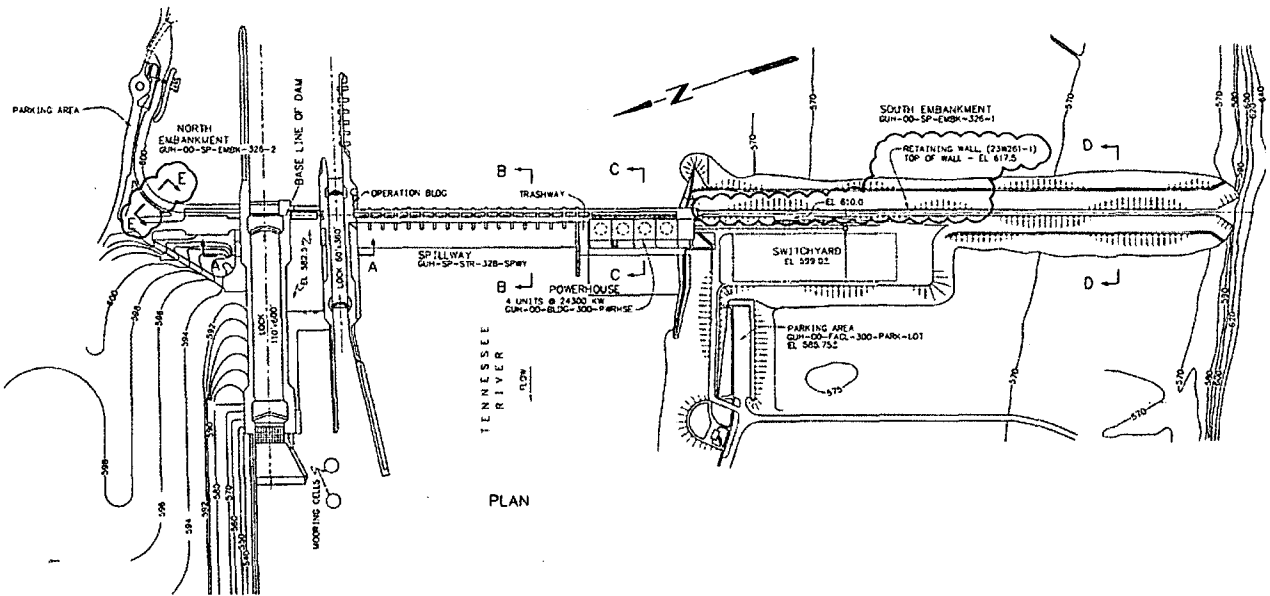

PLAN

Figure 1 – Guntersville Dam, General Plan and Elevation (Ref. 1).

**TVA**

<b>Calculation No.</b> CDQ000020080011	<b>Rev: 1</b>	<b>Plant: GEN</b>	<b>Page: 8</b>
<b>Subject:</b> Initial Dam Rating Curve, Guntersville		<b>Prepped</b>	A. Murr
		<b>Checked</b>	B. Bondurant

**2. References**

1. TVA drawing no: 10W200, R11 (Attachments 1 and 25)
2. TVA Water Control Project Manual (Blue Book) for Guntersville Dam, TVA River Operations, April, 2000 (Attachment 22).
3. "Guntersville Dam Spillway Discharge Tables," River Operations, Tennessee Valley Authority, 2004, RIMS No. L58 081211 804 (Attachment 23).
4. "Hydraulic Design Criteria," USACE (U. S. Army Engineer Waterways Experiment Station), Eighteenth issue, Vicksburg, MS, 1988.
5. "Discharge Coefficients for Spillways at TVA Dams," Kenneth W. Kirkpatrick, Paper No. 2855, Transactions of the American Society of Civil Engineers, vol. 22, pp. 190-210, 1957 (relevant pages included as Attachment 9, complete paper included as Attachment 24).
6. Hydraulic Design Chart 711 (HDC 711) from Reference 4 (Attachment 10 in this calculation).
7. TVA drawing no: 47K2900, R0 (Attachments 4-1 and 26)
8. TVA drawing no: 51N241, R8 (Attachments 12 and 27)
9. TVA drawing no: 22W263-1, R1 (Attachments 15-9 and 28)
10. TVA drawing no: 22W263-5, R1 (Attachments 15-10 and 29)
11. TVA drawing no: 51N222, R8 (Attachments 15-6 and 30)
12. TVA drawing no: 51N226, R5 (Attachments 15-7 and 31)
13. TVA drawing no: 61N250, R3 (Attachments 15-8 and 32)
14. TVA drawing no: 61N430, R3 (Attachments 15-11 and 33)
15. TVA drawing no: 61W256, R4 (Attachments 15-12 and 34)
16. TVA drawing no: 02-L349-3/1.3 (Attachments 15-13 and 35)
17. TVA drawing no: 23W261-1, R2 (Attachments 16-2 and 36)
18. TVA drawing no: 46W300, R6 (Attachments 16-3 and 37)
19. TVA drawing no: 64W204, R4 (Attachments 3-1 and 38)
20. TVA drawing no: 64W504-1, R1 (Attachments 3-2 and 39)
21. TVA drawing no: 02-L349-20/1.12, R12 (Attachments 15-14 and 40)
22. TVA drawing no: 02-L349-20/56, R6 (Attachments 15-15 and 41)
23. TVA drawing no: 22W260-1, R1 (Attachments 17-2 and 42)
24. TVA drawing no: 22W261-1, R1 (Attachments 17-3 and 43)
25. TVA drawing no: 22W261-6, R1 (Attachments 17-4 and 44)
26. TVA drawing no: 23W260-1, R2 (Attachments 18-2 and 45)
27. TVA drawing no: 23W262-1, R1 (Attachments 18-3 and 46)
28. TVA drawing no: 14W301, R5 (Attachments 20-2 and 47)
29. TVA drawing no: 14N310, R3 (Attachments 20-3 and 48)
30. TVA drawing no: 51W217, R5 (Attachments 20-4 and 49)
31. "SOCH Probable Maximum Flood Model Validation," CDQ000020080053
32. "Dam Spillway Gate/Outlet Open Configuration for Flood Analyses," Tennessee Valley Authority, May 29, 2009 (EDMS No. L58 090529 80Q)
33. "Dam Lock Gate Technical Evaluation for the PMF," Tennessee Valley Authority, (EDMS No. L58090908001)

# TVA

<b>Calculation No.</b> CDQ000020080011	<b>Rev:</b> 1	<b>Plant:</b> GEN	<b>Page:</b> 9
<b>Subject:</b> Initial Dam Rating Curve, Guntersville		<b>Prepped</b>	A. Murr
		<b>Checked</b>	B. Bondurant

## 3. Assumptions & Methodology

The initial dam rating curve developed in this calculation, which are applicable for any conditions in which all spillway gates are fully open, will be used in simulations of probable maximum flood events. Consequently, the rating curve has been calculated well above the normal operating range and several feet above the top of the dam.

### 3.1 Assumptions

3.1.1 Assumption: The tailwater rating curve provided in Attachment 5 by the TVA River Operations Risk Section, is acceptable for use in development of the initial dam rating curve.

Technical Justification: The final tailwater curve is validated in the unsteady SOCH PMF calculation (Reference 31) by ensuring consistency with the headwater-tailwater relationship across the modeled dam configuration. This calculation provides the initial dam rating curve for the SOCH PMF calculation.

3.1.2 Assumption: All spillway gates will be set to the maximum openings specified in the spillway discharge tables.

Technical Justification: TVA maintains that all discharge outlets (spillways gates, sluice gates, and valves) for projects in the reservoir system can be placed in the fully open position for the passage of water when and as needed. See "Dam Spillway Gate/Outlet Open Configuration for Flood Analysis" (Reference 32) for further explanation.

3.1.3 Assumption: The upper gates of the main and auxiliary navigation locks will not fail when overflowed.

Technical Justification: See "Dam Lock Gate Technical Evaluation for the PMF" (Reference 33).

3.1.4 Assumption: The fully raised spillway gate leaves are assumed to remain in their design stored open position for the evaluation of Probable Maximum Flood (PMF) conditions upstream of Guntersville Dam. For the evaluation of PMF conditions downstream of Guntersville, Dam, the fully raised spillway gate leaves are assumed to retain position but deform under hydrostatic loads during the PMF and, as a result, not provide flow resistance above the gate rail slots.

Technical Justification: In the fully raised position, the spillway gate leaves do not have lateral support for the portion of the gates extending above the gate rail slots. As a result, the gates will potentially deform plastically under the hydrostatic flexural loads during the PMF, resulting in decreased flow resistance for headwater elevations above the gate rail slots. Assuming the gates maintain the design stored open condition under PMF conditions will conservatively result in higher headwater at the Guntersville Dam and higher flood elevations at upstream locations. Consequently, the design stored open position will be used for evaluation of flood impacts upstream of Guntersville Dam. For evaluations of PMF impacts downstream of the Guntersville Dam, the spillway gates will conservatively be assumed to maintain the design stored open position but fail plastically in flexure under hydrostatic load and provide no flow resistance above the gate rail slots. This assumption will result in conservatively higher flood elevations at downstream locations and will be used for evaluation of flood impacts downstream of Guntersville dam.

3.1.5 Assumption: The maximum headwater elevation at the Guntersville Dam will not exceed 624 feet.

Technical Justification: The maximum headwater is based on very conservative estimations of the maximum PMF elevation at the dam. This assumption is validated in the SOCH PMF analysis in development of the final dam rating curve in the SOCH PMF calculation.

### 3.2 Unverified Assumptions (UVA)

None.

# TVA

Calculation No. CDQ000020080011	Rev: 0	Plant: GEN	Page: 10
Subject: Initial Dam Rating Curve, Guntersville		Prepped	G. Schohl
		Checked	JBM

## 3.3 Methodology

Discharges past the dam are computed as “free” discharge or “orifice” discharge. Free discharge refers to free surface overflow and is computed using a weir-type equation as follows (Reference 4 shows weir flow equations for overflow discharges):

$$Q_f = C_f L H_c^{1.5} \quad (1)$$

in which  $Q_f$  = free discharge (cfs),  $C_f$  = free discharge coefficient ( $\text{ft}^{0.5}/\text{s}$  -- may vary with HW),  $L$  = length of overflowing section (ft),  $H_c$  = head on crest (ft) = HW -  $Z_c$ , HW = headwater elevation (ft), and  $Z_c$  = top, or crest, elevation of overflowing section (ft). This equation is modified to account for tailwater submergence as follows:

$$Q_{fs} = Q_f S_f \quad (2)$$

in which  $Q_{fs}$  = “corrected” free discharge (cfs) and  $S_f$  = tailwater submergence factor (dimensionless -- varies between 0 and 1).  $S_f$  varies with  $d/H_c$  where  $d$  = TW -  $Z_c$  (ft) and TW = tailwater elevation (ft).

With all gate leaves fully raised, flow through the Guntersville spillway is free discharge for all headwater elevations below  $Z_o$ , the elevation of the bottom of the upstream crane girder (see Attachments 12 and 20-1). The discharge coefficient,  $C_f$ , for free discharge over a spillway crest varies with head,  $H_c$  and the submergence factor,  $S_f$ , varies with submergence ratio,  $d/H_c$  (Reference 4 provides these kinds of data). For the Guntersville spillway crest, the relationships  $C_f(H_c)$  and  $S_f(d/H_c)$  were determined from a physical model study (Reference 5; relevant pages included as Attachment 9). The crest length,  $L$ , and crest elevation,  $Z_c$ , are shown on TVA drawings (e.g., Reference 1).

The physical model used to measure spillway discharge included several bays and the piers between them. Consequently, pier contraction effects are implicitly included in the discharge coefficients derived from the model test data.

Under the assumption that all spillway gates are fully open, the two end bays (first and last) are the only spillway bays subject to end contraction effects. These effects, which may reduce discharge through these two bays by a few percent, are neglected in this calculation. Neglecting this minor effect has negligible impact on the dam rating curve.

For headwater elevations above  $Z_o$  (608.8 feet [4.1.5]), flow through the spillway bays is treated as orifice discharge. Data indicating the headwater elevation at which the overflowing nappe would first touch the bottom of the girder are not available. Also, data indicating the relationship between headwater elevation, tailwater elevation, and discharge for this condition are not available. Because the discharge is very much affected by submergence at headwaters this high, which means that it is more controlled by the difference in elevation between the headwater and tailwater than by the difference in elevation between the headwater and the spillway crest, the following approach for predicting spillway discharge is adequate for headwaters above  $Z_o$ :

$$Q_o = C_o (Z_o - Z_c) L \sqrt{2g(HW - TW)} \quad (3)$$

in which  $C_o$  = discharge coefficient determined by imposing the condition that the orifice discharge (Equation 3) is equal to the free discharge affected by submergence (Equation 2) when the headwater elevation is equal to  $Z_o$ . Since  $C_o$  depends on TW when HW= $Z_o$ , it is determined as part of the overall calculation and cannot be computed ahead of time.

Flows over the the navigation locks, the tops of the spillway piers, the south embankment, and the north embankment are computed as free discharge. Values of the discharge coefficient,  $C_f$ , and the submergence factor,  $S_f$ , are estimated using Hydraulic Design Chart 711 (Reference 6) which is included as Attachment 10. Length,  $L$ , and crest elevation,  $Z_c$ , in each case is determined from TVA drawings (all relevant drawings are defined as References).

**TVA**

<b>Calculation No.</b> CDQ000020080011	<b>Rev: 0</b>	<b>Plant: GEN</b>	<b>Page: 11</b>
<b>Subject:</b> Initial Dam Rating Curve, Guntersville		<b>Prepped</b>	<b>G. Schohl</b>
		<b>Checked</b>	<b>JBM</b>

The upper plot of HDC 711 (Reference 6) shows that  $C_f$  is about 2.65 for very broad crests ( $H_1/B < 0.4$  where  $H_1 = H_c$  and  $B =$  streamwise length of the crest) and gradually increases to 3.1, the maximum value for a "broad-crested" weir, as  $H_1/B$  increases to about 1.2. As  $H_1/B$  increases above 1.2,  $C_f$  continues to increase as the weir transitions from broad-crested to sharp-crested at about  $H_1/B = 2.0$ . Since the estimation of discharge over the top of various sections of a dam and its embankments is an approximation, small variations in  $C_f$  with  $H_c$  are not modeled and the effects of end contractions are neglected. A single representative value for  $C_f$  within the range of its variation is used for all headwater elevations included in the rating. Neglecting minor variations in  $C_f$  values and end contractions has negligible impact on the dam rating curve.

The lower plot of HDC 711 shows several curves of  $C_g/C_f$  (equivalent to  $S_f$ ) versus  $H_2/H_1$  (equivalent to  $d/H_c$ ). As illustrated in Attachment 11, the curve labeled "suggested for design (broad crests)" is well-represented by the following polynomial:

$$S_f = 1.0 + 0.023\sigma - 5.0259\sigma^2 + 18.266\sigma^3 - 44.658\sigma^4 \quad \text{for } 0 \leq \sigma \leq 0.37 \quad \text{broad crest} \quad (4)$$

in which  $\sigma = d/H_c - 0.6$ . According to this relationship, submergence affects discharge over a broad-crested weir for  $d/H_c > 0.6$ .

# TVA

<b>Calculation No.</b> CDQ000020080011	<b>Rev:</b> 0	<b>Plant:</b> GEN	<b>Page:</b> 12
<b>Subject:</b> Initial Dam Rating Curve, Guntersville		<b>Prepped</b>	G. Schohl
		<b>Checked</b>	JBM

## 4. Design Input

Sect.	Input Parameter	Source	Symbol	Value
4.1	<b>Spillway crest parameters</b>			
4.1.1	Crest length	18 40-foot wide bays; Ref. 1 or Ref. 8	L	720 feet
4.1.2	Crest elevation	Ref. 1 or Ref. 8	$Z_c$	555 feet
4.1.3	Free discharge coefficient	Ref. 5 presents discharge parameters for several TVA spillways determined from model test data, and $C_f$ vs. $H_c$ for Guntersville is plotted in Fig. 3c. Points scaled from Fig. 3c plus four points added by visual extrapolation are fit by a polynomial. $C_f$ is needed to $H_c=69$ feet (headwater limit for rating tables, 624 feet [4.7], minus crest elevation, 555 feet [4.1.2]) for the rating curve. The extrapolation is arbitrary but the extrapolated values of $C_f$ are expected to be within plus or minus 0.05, or 1.5 percent, of the true values.	$C_f(H_c)$	Polynomial Equation given in Att. 13
4.1.4	Submergence factor for free discharge	Ref. 5 presents discharge parameters for several TVA spillways determined from model test data, and $S_f$ vs. $d/H_c$ for Guntersville is plotted in Fig. 7b. Points scaled from Fig. 7b are fit by the equation given in Att. 14.	$S_f(d/H_c)$	Equation given in Att. 14
4.1.5	Headwater elevation above which orifice discharge is computed.	Paragraph 4.15	$Z_o$	608.8 feet
4.2	<b>Main and Auxiliary Lock Gate Overflow</b>			
4.2.1	Discharge coefficient	Justification in Att. 15	$C_f$	3.2
4.2.2	Overflow elevation	Justification in Att. 15	$Z_c$	598.3 feet
4.2.3	Overflow length	Determined in Att. 15	L	170 feet
4.3	<b>Auxiliary Lock Walls Overflow</b>			
4.3.1	Discharge coefficient	Justification in Att. 15	$C_f$	2.9
4.3.2	Overflow elevation	Ref. 1	$Z_c$	600 feet
4.3.3	Overflow length	Determined in Att. 15	L	75.5 feet
4.4	<b>Main Lock Walls Overflow</b>			
4.4.1	Discharge coefficient	Justification in Att. 15	$C_f$	2.8
4.4.2	Overflow elevation	Ref. 1	$Z_c$	605 feet
4.4.3	Overflow length	Determined in Att. 15	L	159 feet
4.5	<b>Sloped Section of Dam Between Locks Overflow</b>			
4.5.1	Discharge coefficient	Justification in Att. 15	$C_f$	2.9
4.5.2	Overflow elevation	Ref. 8	$Z_c$	602.5 feet
4.5.3	Overflow length	Determined in Att. 15	L	60 feet
4.6	<b>Spillway piers Overflow</b>			
4.6.1	Discharge coefficient	Justification in Att. 16	$C_f$	2.65
4.6.2	Overflow elevation	Ref. 1 and Ref. 8	$Z_c$	615 feet
4.6.3	Overflow length	Determined in Att. 16	L	162.5 feet
4.7	<b>Upper limit on headwater elevation for rating</b>	Three feet above the maximum elevation predicted by a preliminary SOCH simulation for the 100 percent runoff assumption [3.2.4].	$HW_{max}$	624 feet
4.8	<b>Tailwater Rating Curve</b>			
4.8.1	TW vs. total discharge, Q	Paragraph 4.14	TW(Q)	Equation 5

**TVA**

<b>Calculation No.</b> CDQ000020080011	<b>Rev:</b> 0	<b>Plant:</b> GEN	<b>Page:</b> 13
<b>Subject:</b> Initial Dam Rating Curve, Guntersville		<b>Prepped</b>	G. Schohl
		<b>Checked</b>	JBM

Sect.	Input Parameter	Source	Symbol	Value
4.9	<b>North Embankment Flood Wall Overflow</b>			
4.9.1	Discharge coefficient	Justification in Att. 17	$C_f$	3.12
4.9.2	Overflow elevation	Determined in Att. 17	$Z_c$	617.5 feet
4.9.3	Overflow length	Determined in Att. 17	L	500 feet
4.10	<b>North Embankment Sloped Section Overflow</b>			
4.10.1	Discharge coefficient	Justification in Att. 17	$C_f$	2.65
4.10.2	Overflow elevation	Determined in Att. 17	$Z_c$	621 feet
4.10.3	Overflow length	Determined in Att. 17	L	30 feet
4.11	<b>South Embankment Overflow</b>			
4.11.1	Discharge coefficient	Justification in Att. 18	$C_f$	2.94
4.11.2	Overflow elevation	Determined in Att. 18	$Z_c$	617.5 feet
4.11.3	Overflow length	Determined in Att. 18	L	1890 feet

**4.12 Upper Lock Gates**

Both upper gates include a walkway on top supported by a steel frame attached to the gate. The areas between the walkways and the tops of the gates are essentially open and will allow flow to pass if the gates are overtopped (somewhat visible in Attachment 2). Since flow will pass over the miter gates when the headwater rises above them, and the walkways may not survive PMF overflow, the overflow elevation for each gate is established as the top of the miter gate rather than the elevation of the walkway.

The overflow elevation for the upper gate of the main lock is 599.4 (Attachment 3-1). The overflow elevation for the upper gate of the auxiliary lock is 597.1 feet (Attachment 3-2). For calculation convenience, the average of these two elevations, 598.3 feet, is used for both gates. Use of the average elevation for both gates has no significant impact on the rating curve.

**4.13 Turbine Discharge**

Guntersville Dam has four turbines (see Attachment 1). The turbines will be operated during a PMF until the tailwater or headwater reaches a level at which electrical components will get wet, excessive vibration occurs, or the gross head (headwater elevation minus tailwater elevation) becomes too small for power generation.

The turbines are expected to be operated for maximum capacity, with the wicket gates open as far as possible. Attachment 4-1 provides discharge curves for Unit 4 (all four units are similar; see Attachment 4-2). Linear extrapolation of the "maximum power" curve indicates that generator output (power) is less than or equal to zero for gross heads smaller than about 10 feet. The rating curve calculation results (Figure 2) indicate that gross heads during the PMF without the turbines running are less than 9 feet throughout the entire headwater elevation range. Therefore, the turbines at Guntersville will not be operated under conditions in which the dam rating curve is applicable, and turbine discharge is not included in the rating curve.

The turbines at Guntersville were rehabilitated and upgraded a few years ago (see Attachment 4-3). Attachment 4-1 includes points taken from preliminary operating characteristics (see Attachment 4-4) for the upgraded Unit 4. The upgraded unit delivers slightly more power at all gross heads than the previous unit. Extrapolation of the maximum power curve for the upgraded unit, using the previous maximum power curve as a guide, indicates that generator output is less than zero for gross heads smaller than about 9 feet, verifying that turbine discharge is zero for the dam rating curve.

## TVA

<b>Calculation No.</b> CDQ000020080011	<b>Rev: 1</b>	<b>Plant: GEN</b>	<b>Page: 14</b>
<b>Subject: Initial Dam Rating Curve, Guntersville</b>		<b>Prepped</b>	<b>A. Murr</b>
		<b>Checked</b>	<b>B. Bondurant</b>

### 4.14 Tailwater rating curve

The tailwater rating curve used in this calculation was developed from the curves shown in Attachment 5-1. The blue curve on the plot was computed for steady-state conditions with no backwater effects from downstream water levels (data listed in Attachment 5-2). The pink curve on the plot was computed for steady-state conditions with the water level at Decatur Alabama (end of the tailwater, start of the main reservoir) at 557 feet, the highest downstream water level considered for the plot in Attachment 5-3 which illustrates backwater effects (data listed in Attachment 5-4). Since higher tailwater means less discharge from Guntersville Dam, which is conservative for computing flood levels at the Bellefonte site, the rating curve for this calculation follows the pink curve for discharges less than 350,000 cfs (rather than a curve corresponding to lower downstream water levels) and the blue curve for larger discharges. As noted previously, the dam rating curve developed in this calculation is the initial curve used in developing the initial SOCH PMF model. The final dam rating curve, including the validated headwater-tailwater relationship, is confirmed and documented in Reference 31.

Attachment 19 lists data points taken from Attachments 5-2 and 5-4 and shows a polynomial fit to the result. Attachment 19 also lists tailwater values (column 3) computed from discharge values (column 1) using the polynomial. The polynomial used for the rating curve calculations is as follows:

$$TW = 554.89 + 0.11085Q_a - 1.157 \times 10^{-4} Q_a^2 + 7.335 \times 10^{-8} Q_a^3 - 1.788 \times 10^{-11} Q_a^4 \quad (5)$$

in which  $Q_a = Q/0.9$  and  $Q$  = total discharge past the dam in cfs divided by 1000 ("1000 cfs").

### 4.15 Spillway orifice discharge

Discharge through a spillway bay for headwater elevation 608.8 feet, the elevation of the bottom of the upstream crane girder (see Attachment 20-4), is depicted in Attachment 20-1. For this and lower headwaters, the flow is free discharge affected by tailwater submergence. The tailwater elevation indicated in Attachment 20-1 is from the rating curve results in section 6 for headwater elevation 608.8 feet.

For headwater elevations above 608.8 feet, the discharge is orifice discharge controlled by the opening between the bottom of the crane girder and the spillway crest, and by the difference between the headwater and tailwater elevations. As shown in Attachment 20-1, the bottom of the crane girder is the control elevation because the bottoms of the stored spillway gate leaves are both higher. As also shown in Attachment 20-1, the tops of the stored spillway gate leaves are above the maximum headwater elevation considered for the rating curve. Consequently, flow will not pass over the tops of the stored spillway gates for any headwater elevations considered for the rating curve. The stored gate leaves are expected to remain in place under flow [3.1.4].

## 5. Special Requirements/Limiting Conditions

The assumptions limit this dam rating curve to SOCH PMF analyses for nuclear facilities upstream of Guntersville Dam. These assumptions are conservative for determining PMF levels at the Watts Bar, Sequoyah, and Bellefonte sites. However, for determining PMF levels at the Browns Ferry site, these assumptions are not conservative and should be reevaluated.



# TVA

<b>Calculation No.</b> CDQ000020080011	<b>Rev:</b> 0	<b>Plant:</b> GEN	<b>Page:</b> 15
<b>Subject:</b> Initial Dam Rating Curve, Gunterville		<b>Prepped</b>	G. Schohl
		<b>Checked</b>	JBM

## 6. Calculations

The calculations consist of computing spillway and overflow discharges (from Equations 1 and 2) for a list of headwater elevations ranging from 555 feet, the spillway crest elevation, to 624 feet [4.7], which is 6.5 feet above the top elevations of the north and south embankments. The dam rating curve is a plot of headwater elevation versus total dam discharge.

Discharge passes through the spillway section first and then the various overflow sections as headwater rises above their crest elevations. Total discharge, given in "1000 cfs" is the sum of all discharges in cfs past the dam divided by 1000.

### 6.1 Dam Rating Curve

Figure 2 shows the spreadsheet calculations for the dam rating curve (spreadsheet included as Attachment 21). The final result, the rating curve, is defined by the first two columns, HW vs. Total Discharge. The third column (TW) gives the tailwater associated with the "Total Discharge" from the tailwater rating curve polynomial fit [4.8.1].

Spillway discharge is computed in the next five columns,  $H_c$ ,  $C_f$ ,  $d/H_c$ ,  $S_f$ , and  $Q_{fs}$ . Free discharge occurs for headwater elevations below 608.8 feet [4.1.5] and orifice discharge occurs for headwater elevations above 608.8 feet. The transition point is indicated by a double horizontal line. Above the line, the listed discharge coefficient is  $C_f$  [4.1.3] and below the line the listed discharge coefficient is  $C_o$ , computed as described in section [3.3]. Column  $Q_{fs}/Q_o$  is the spillway discharge computed from Equation 2 for free discharge and from Equation 3 for orifice discharge. Tailwater affects the spillway discharge for headwater elevations above 557 feet ( $S_f < 1.0$ ,  $d/H_c > 0.3$ ) as indicated by the single horizontal line. Discharges above the horizontal line are not affected by tailwater submergence. Discharges below the horizontal line and above the double horizontal line are reduced (multiplied by  $S_f$ ) by tailwater submergence. The effect of tailwater submergence on discharges below the double horizontal line is included implicitly in Equation 3. The effects of tailwater submergence make it necessary to iterate through different tailwater elevations until the total computed discharge fits the tailwater rating curve [4.8.1]. Figure 2 shows the final results of this process but does not show the iteration steps. The results are readily checked by computing the individual discharges, adding them up to compute total discharge, and then making sure the listed tailwater and total discharge agree with the tailwater rating curve.

The column following the spillway discharge column shows " $C_f$ =", " $Z_c$ =", and " $L$ =" in three rows to indicate the meaning of the values included in those rows in the "Overflow Discharge" columns:

The next six columns compute discharge over the upper miter gates and the auxiliary lock walls. Columns for  $d/H_c$  and  $S_f$  are included because these discharges are affected by tailwater ( $d/H_c > 0.6$ ) for some headwater elevations. Submergence factor,  $S_f$ , is computed from Equation 4. The overflow discharges are computed using Equation 2. The overflow discharge coefficients  $C_f$  ([4.2.1], [4.3.1]), elevations  $Z_c$  ([4.2.2], [4.3.2]), and lengths  $L$  ([4.2.3], [4.3.3]) are indicated in the three rows above the computed discharges.

The next six columns compute discharge over the sloped section of the dam between the locks, the main lock walls, the spillway piers, the north embankment, the north embankment sloped section, and the south embankment. The overflow discharge coefficient  $C_f$  ([4.5.1], [4.4.1], [4.6.1], [4.9.1], [4.10.1], [4.11.1]), elevation  $Z_c$  ([4.5.2], [4.4.2], [4.6.2], [4.9.2], [4.10.2], [4.11.2]), and length  $L$  ([4.5.3], [4.4.3], [4.6.3], [4.9.3], [4.10.3], [4.11.3]) in each case is indicated in the three rows above the computed discharge. These discharges, all computed using Equation 1, are not affected by tailwater submergence. This is verified in the last column, which shows  $d/H_c$  remaining less than 0.6 [3.3] for the sloped section of the dam between the locks, which has the lowest overflow elevation of this group.

Calculation No. CDQ000020080011	Rev: 0	Plant: GEN	Page: 16
Subject: Initial Dam Rating Curve, Gunterville		Prepped	G. Schohl
		Checked	JBM

Spillway Parameters										Overflow Discharge, $Q_f$ in cfs										
L = 720 feet																				
Z <sub>c</sub> = 555 feet																				
Q		Spillway								Upper		Aux.		Main		North				
Total		TW		feet				cfs		Lock	Lock	Mid-	Lock	Spill	North	Emb.	Slope	Emb.	South	Upper
HW	1000 cfs	feet	H <sub>c</sub>	C <sub>f</sub>	C <sub>o</sub>	d/H <sub>c</sub>	S <sub>f</sub>	Q <sub>16</sub>	Q <sub>0</sub>	Gates	Walls	Sect.	Walls	Piers	Emb.	30	1890	Gates	Lock	
555	0.00	554.89	0	2.834			1		0											
557	5.89	555.54	2	2.893	0.27		1		5892											
559	16.92	556.73	4	2.949	0.43	0.996			16919											
561	31.32	558.25	6	3.002	0.54	0.986			31324											
563	48.22	559.97	8	3.051	0.62	0.970			48222											
565	66.97	561.82	10	3.098	0.68	0.950			66971											
567	87.15	563.72	12	3.141	0.73	0.927			87150											
569	108.54	565.65	14	3.182	0.76	0.904			108536											
571	131.03	567.59	16	3.220	0.79	0.883			131028											
573	154.59	569.52	18	3.256	0.81	0.864			154590											
575	179.26	571.45	20	3.289	0.82	0.846			179261											
577	205.09	573.36	22	3.320	0.83	0.831			205086											
579	232.16	575.25	24	3.349	0.84	0.819			232159											
581	260.53	577.13	26	3.376	0.85	0.808			260533											
583	290.34	578.99	28	3.401	0.86	0.800			290338											
585	321.66	580.82	30	3.425	0.86	0.794			321662											
587	354.59	582.64	32	3.447	0.86	0.789			354592											
589	389.23	584.42	34	3.467	0.87	0.786			389231											
591	425.68	586.18	36	3.486	0.87	0.785			425680											
592	444.62	587.05	37	3.495	0.87	0.785			444619											
593	464.03	587.91	38	3.504	0.87	0.785			464034											
594	483.90	588.77	39	3.513	0.87	0.786			483901											
595	504.30	589.62	40	3.521	0.87	0.786			504301											
596	525.16	590.46	41	3.529	0.86	0.787			525159											
597	546.50	591.29	42	3.536	0.86	0.789			546502											
598	568.36	592.12	43	3.544	0.86	0.790			568356											
599	590.83	592.94	44	3.551	0.86	0.791			590507											
600	614.07	593.77	45	3.558	0.86	0.793			612867	1206										
602.5	675.30	595.86	48	3.574	0.86	0.795			669757	4682	865									
605	740.71	597.95	50	3.590	0.86	0.797			728136	9434	2448	688								
607	796.30	599.64	52	3.601	0.86	0.797			775362	13960	4055	1661	1259							
608.8	848.51	601.19	54	3.611	0.86	0.797			818238	18509	5716	2751	3298							
611	899.58	602.67	56	0.954					856113	24621	7988	4312	6543							
613	946.49	604.00	58	0.954					889568	30660	10263	5920	10074							
615	993.71	605.33	60	0.954					922096	37126	12720	7690	14078							
617.5	1053.87	607.01	63	0.954					960592	45767	16029	10108	19675	1702					0.454	
619	1096.41	608.18	64	0.954					975538	51234	18133	11662	23321	3445	2866		0	10208	0.477	
620	1127.91	609.04	65	0.954					981784	54991	19583	12738	25864	4815	6166		0	21964	0.495	
622	1196.46	610.88	67	0.954					988925	62766	22593	14983	31205	7975	14892		80	53043	0.531	
624	1271.74	612.84	69	0.954					990924	70876	25743	17346	36871	11627	25852		413	92083	0.566	

Figure 2 – Calculations for Dam Rating Curve

**TVA**

<b>Calculation No.</b> CDQ000020080011	<b>Rev: 1</b>	<b>Plant: GEN</b>	<b>Page: 17</b>
<b>Subject:</b> Initial Dam Rating Curve, Guntersville		<b>Prepped</b>	<b>A. Murr</b>
		<b>Checked</b>	<b>B. Bondurant</b>

**7. Results/Conclusions**

For convenience, the dam rating results, separate from the calculation details provided above, are tabulated as total discharge in 1000 cfs vs. headwater elevation in feet in Figure 3. The dam rating curve (along with the tailwater rating curve) is plotted in Figure 4.

The initial dam rating curve developed in this calculation provides Guntersville total dam discharge vs. headwater elevation for use in TVA's SOCH and TRBROUTE models for simulation conditions satisfying the assumptions in [3.1 and 3.2]. In particular, all gate leaves must be removed from the spillway bays and placed in their stored positions.

The assumptions limit this dam rating curve to SOCH PMF analyses for nuclear facilities upstream of Guntersville Dam. These assumptions are conservative for determining PMF levels at the Watts Bar, Sequoyah, and Bellefonte sites. However, for determining PMF levels at the Browns Ferry site, these assumptions are not conservative and should be reevaluated.

**TVA**

<b>Calculation No.</b> CDQ000020080011	<b>Rev: 0</b>	<b>Plant: GEN</b>	<b>Page: 18</b>
<b>Subject:</b> Initial Dam Rating Curve, Guntersville		<b>Prepped</b>	G. Schohl
		<b>Checked</b>	JBM

Results Using Given	
TW Rating	
	Total
	Discharge
HW	1000 cfs
555	0.00
557	5.89
559	16.92
561	31.32
563	48.22
565	66.97
567	87.15
569	108.54
571	131.03
573	154.59
575	179.26
577	205.09
579	232.16
581	260.53
583	290.34
585	321.66
587	354.59
589	389.23
591	425.68
592	444.62
593	464.03
594	483.90
595	504.30
596	525.16
597	546.50
598	568.36
599	590.83
600	614.07
602.5	675.30
605	740.71
607	796.30
608.8	848.51
611	899.58
613	946.49
615	993.71
617.5	1053.87
619	1096.41
620	1127.91
622	1196.46
624	1271.74

Figure 3 – Dam Rating Results

Attachment 2

Calculation No: CDQ000020080011

Source: Reference 2


# GUNTERSVILLE DAM



September 1999

Attachment 3-1  
 Source: Reference 19


Calculation No: CDQ00020080011

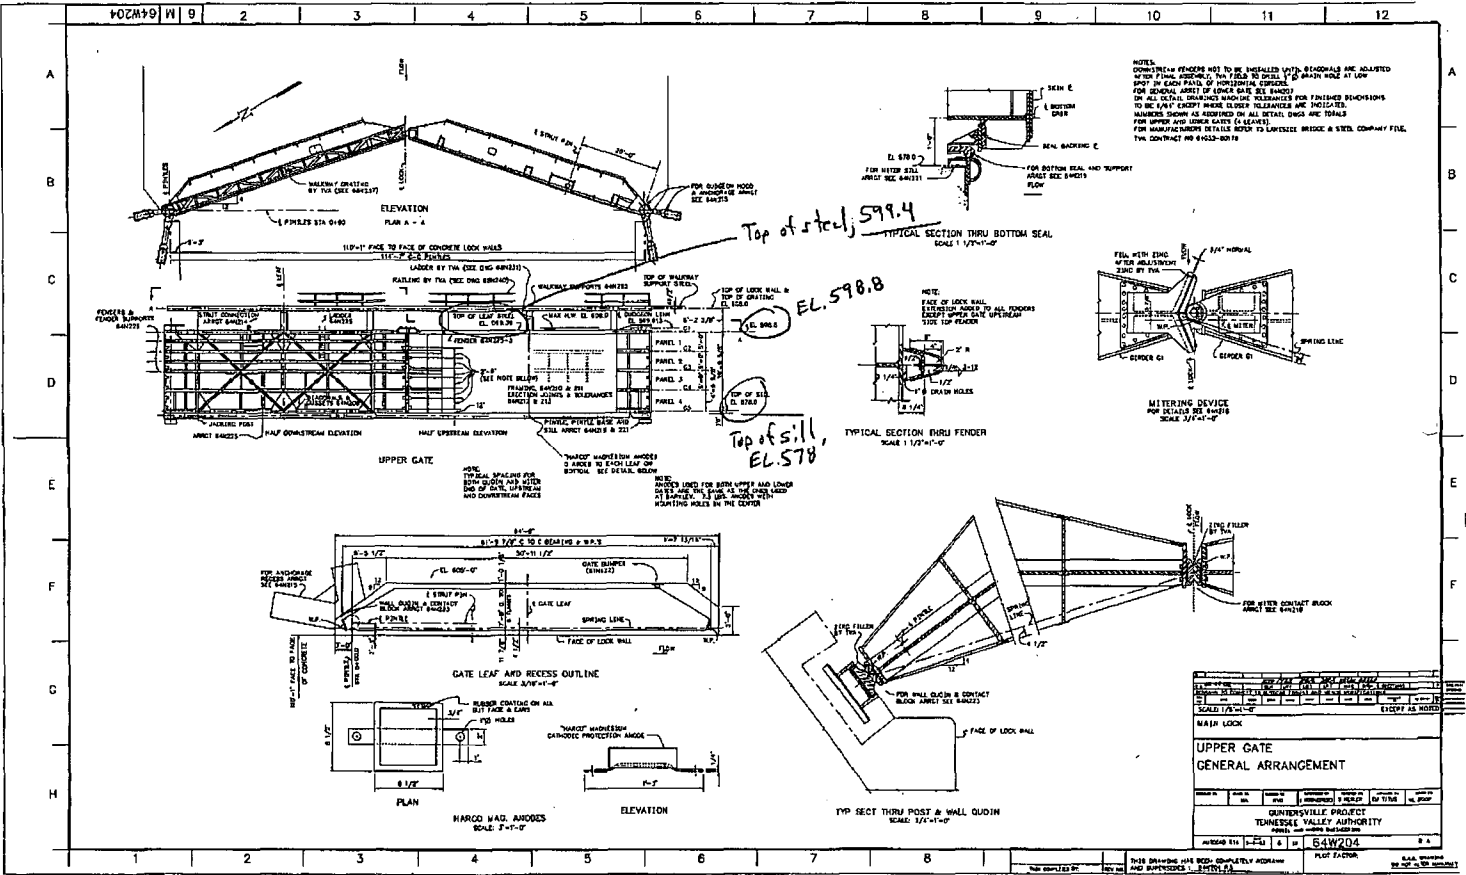

Attachment 3-2

Source: Reference 20

Calculation No: CDQ00020080011

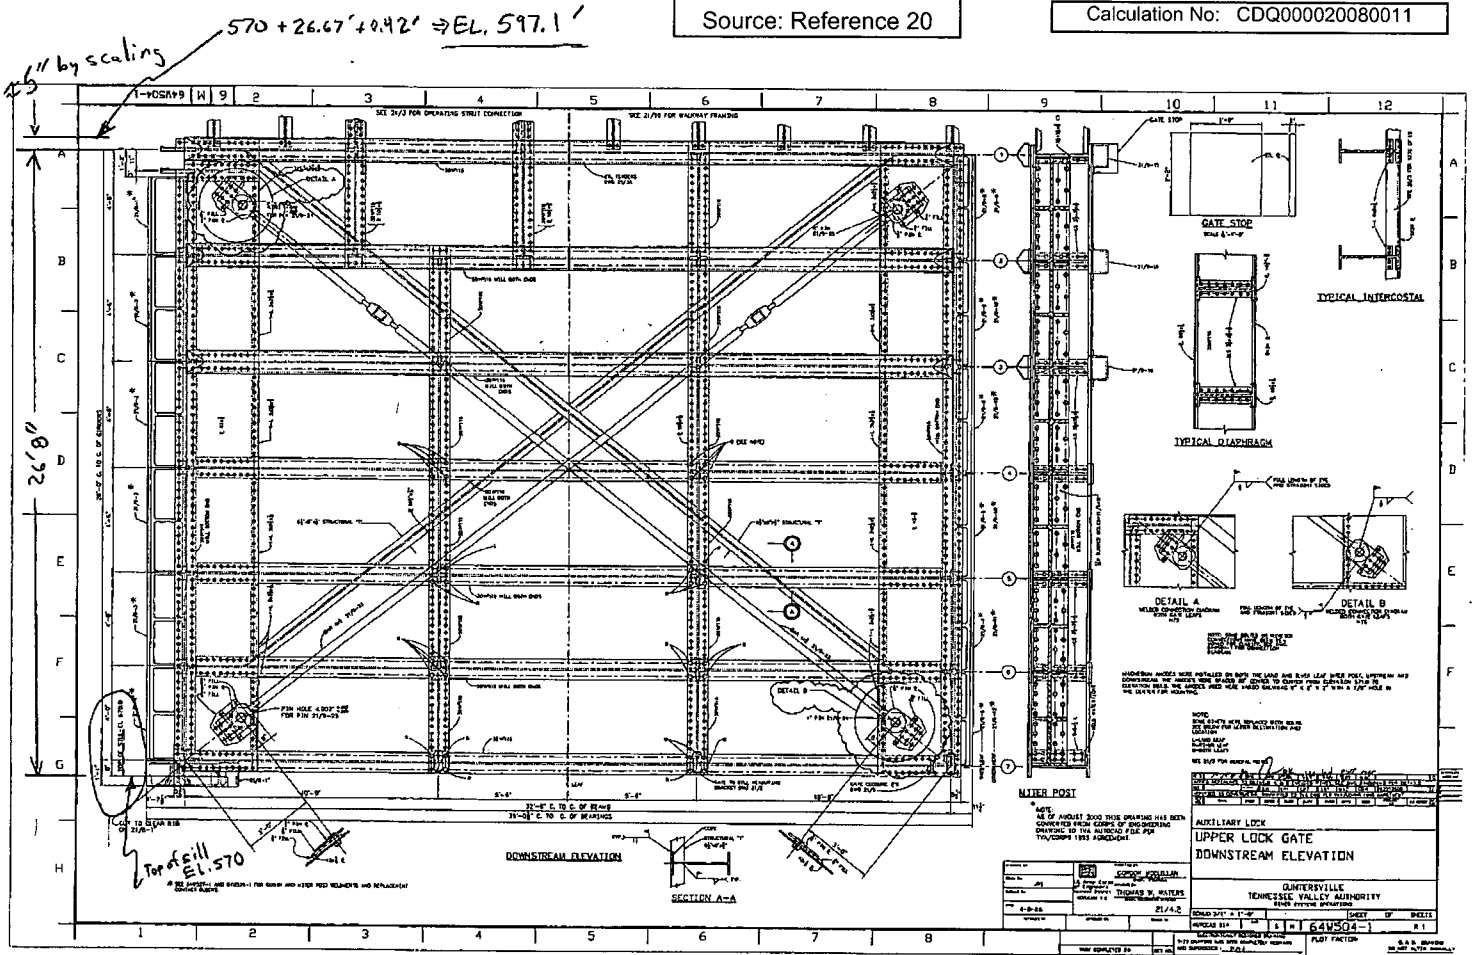

$570 + 26.67' + 0.42' \Rightarrow EL. 597.1'$


26.67

Top of sill EL. 570

DOWNSTREAM ELEVATION

SECTION A-A

MITER POST

UPPER LOCK GATE  
DOWNSTREAM ELEVATION


TENNESSEE VALLEY AUTHORITY  
SHEET 1 OF 1  
648504  
PLIST FACTOR

S. S. BRADEN

Attachment 4-1

Source: Reference 7

Calculation No: CDQ000020080011

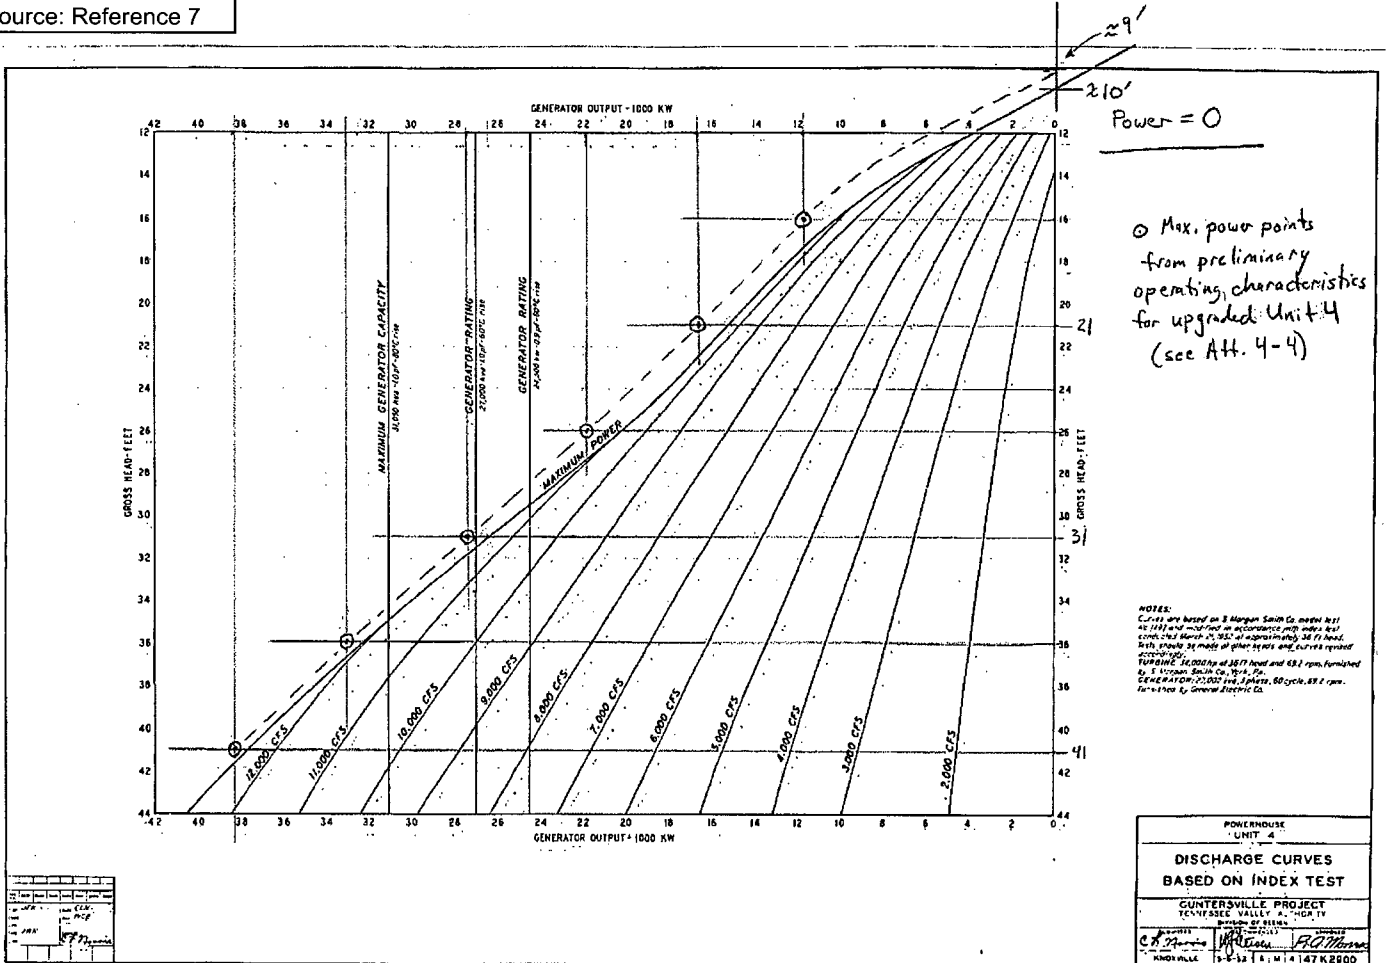





April 2000

Source: Reference 2

Guntersville 25

POWER FACILITIES (CONT.)

## GENERATORS (CONT.)

## Flywheel effect (tested):

Units 1-3.....	85,920,000 lb-ft <sup>2</sup>
Unit 4.....	92,770,000 lb-ft <sup>2</sup>

## Thrust bearing:

Units 1-3.....	Kingsbury, dia. 87 in., max. load 1000 tons
Unit 4.....	GE, dia. 100 in., max. load 1000 tons

Neutral reactor.....	1.0 ohm, 6000 A, 1 min
----------------------	------------------------

## Exciters:

Main.....	250 kW, 250 V
Pilot.....	15 kW, 250 V

## Weight of heaviest crane lift, rotor:

Units 1-3.....	230 tons
Unit 4.....	232.5 tons

Diameter over air housing, less trim.....	556 in.
---	---------


Diameter of stator bore.....	396 in.
------------------------------	---------

## Top of pilot exciter:


Above stator soleplates.....	146.75 in.
Above generator floor.....	104 in.

## GENERATOR AND TURBINE MODERNIZATION

Guntersville Units 1 through 4 will be rehabilitated and upgraded. Work on Unit 4 was started in March 2000 and is expected to be completed in late summer 2000. Work on Units 1, 2, and 3 is scheduled to start in March and complete in July of 2001, 2002 and 2003 respectively. Major items include installation of new stainless steel runners; new main and pilot exciters; new transformers on 3 of 4 banks; new stainless steel throat ring; rewedged stators; reinsulated rotor poles; new turbine guide bearings; rehabilitated wicket gates with new greaseless bushings throughout; rehabilitated shift ring; new or rehabilitated cooling water piping, valves, and strainers; rehabilitated generator brake system; and upgrade or rehabilitation of various other unit components.

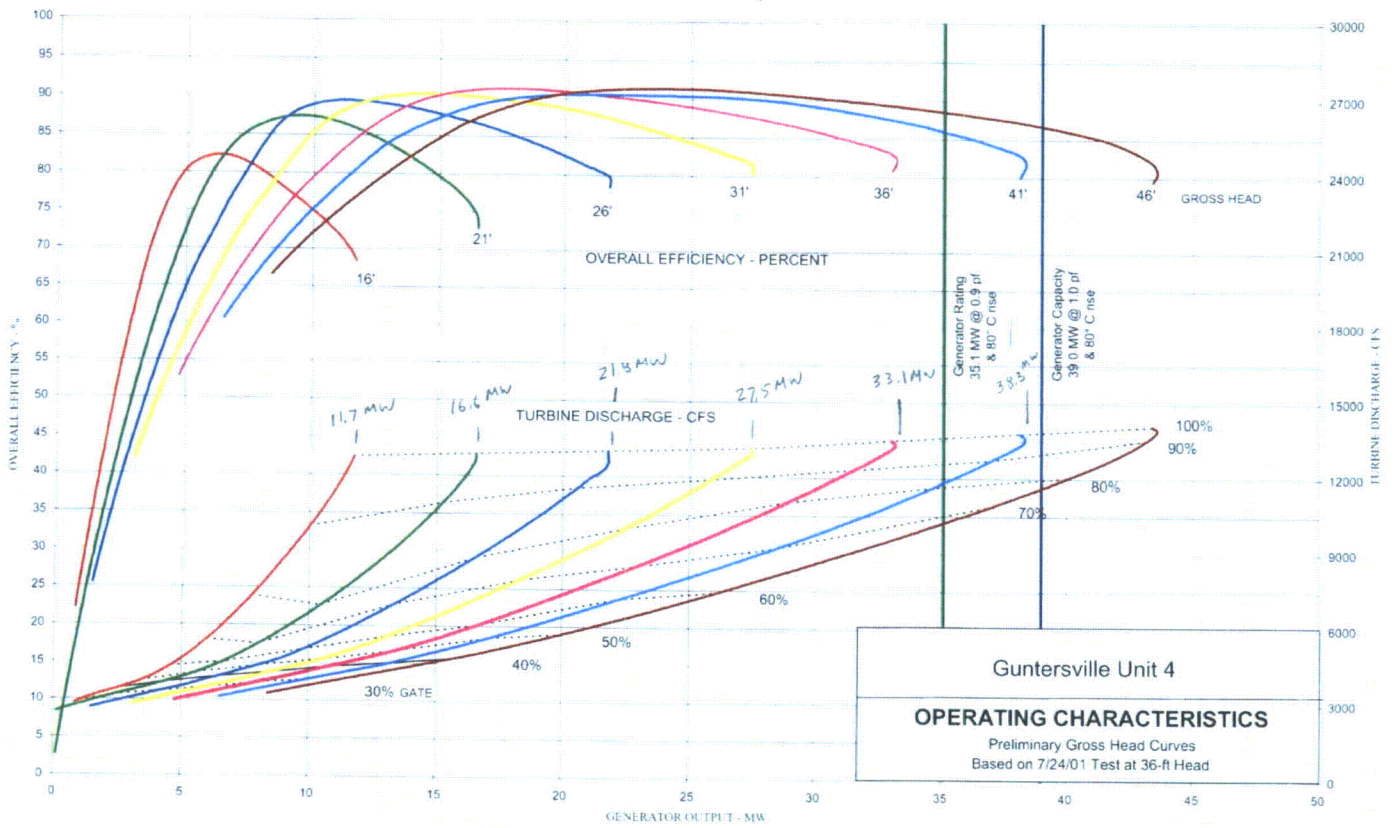

### Guntersville Steady-State Tailwater Rating

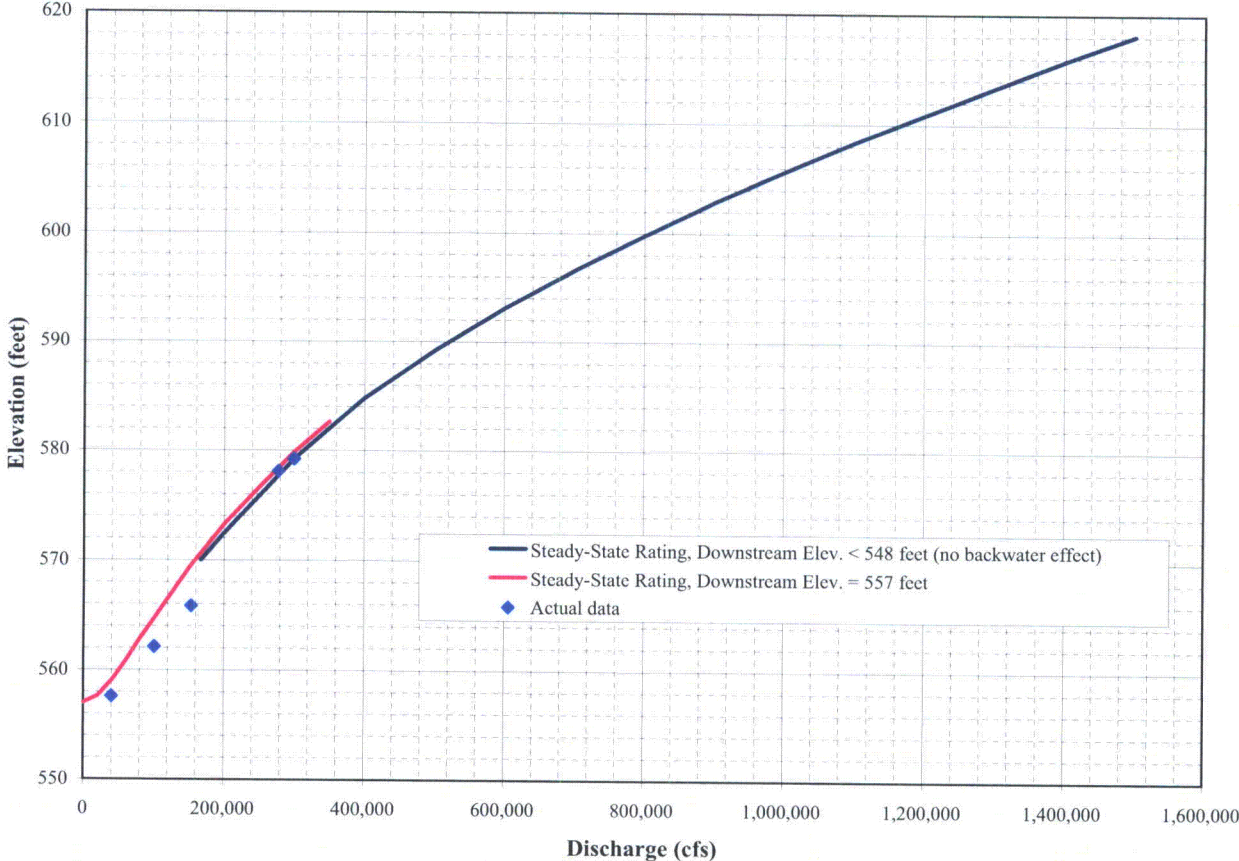

Source: TVA River Operations  
Flood Risk Section

**Guntersville Steady-State Tailwater Rating  
(no downstream elevation effects)**

<u>Elevation</u>	<u>Discharge</u>	
570.0	167,000	
572.4	200,000	
579.2	300,000	
584.8	400,000	
589.2	500,000	
593.1	600,000	
596.6	700,000	
599.8	800,000	
602.9	900,000	
605.7	1,000,000	PMF
608.4	1,100,000	
610.9	1,200,000	
615.8	1,400,000	
618.1	1,500,000	

**TW at Max. Q During Floods**

<u>Elevation</u>	<u>Discharge</u>	<u>Frequency</u>
577.9	260,000	10
580.0	287,000	50
581.1	305,000	100
583.9	362,000	500
587.0	595,400	MPF
610.9	1,000,000	PMF

**Headwater Elev. 556  
Flood Control Section 1951**

<u>Discharge</u>	<u>Elevation</u>
0	556.0
50,000	559.5
100,000	564.9
200,000	573.9
300,000	580.7
400,000	586.8
500,000	592.1
600,000	597.1

**Based on 1978 plot Book # 106-96.01**


<u>Elevation</u>	<u>Discharge</u>
557	0
557.6	20000
559	40000
560.8	60000
562.8	80000
564.6	100000
569.3	150000
573.2	200000
576.6	250000
579.8	300000
582.6	350000

**Actual data**

<u>Elevation</u>	<u>Discharge</u>
557.6	39900
562.1	101000
565.8	153400
578.1	278000
579.2	300000

Source: TVA River Operations  
Flood Risk Section

### Guntersville Tailwater Rating

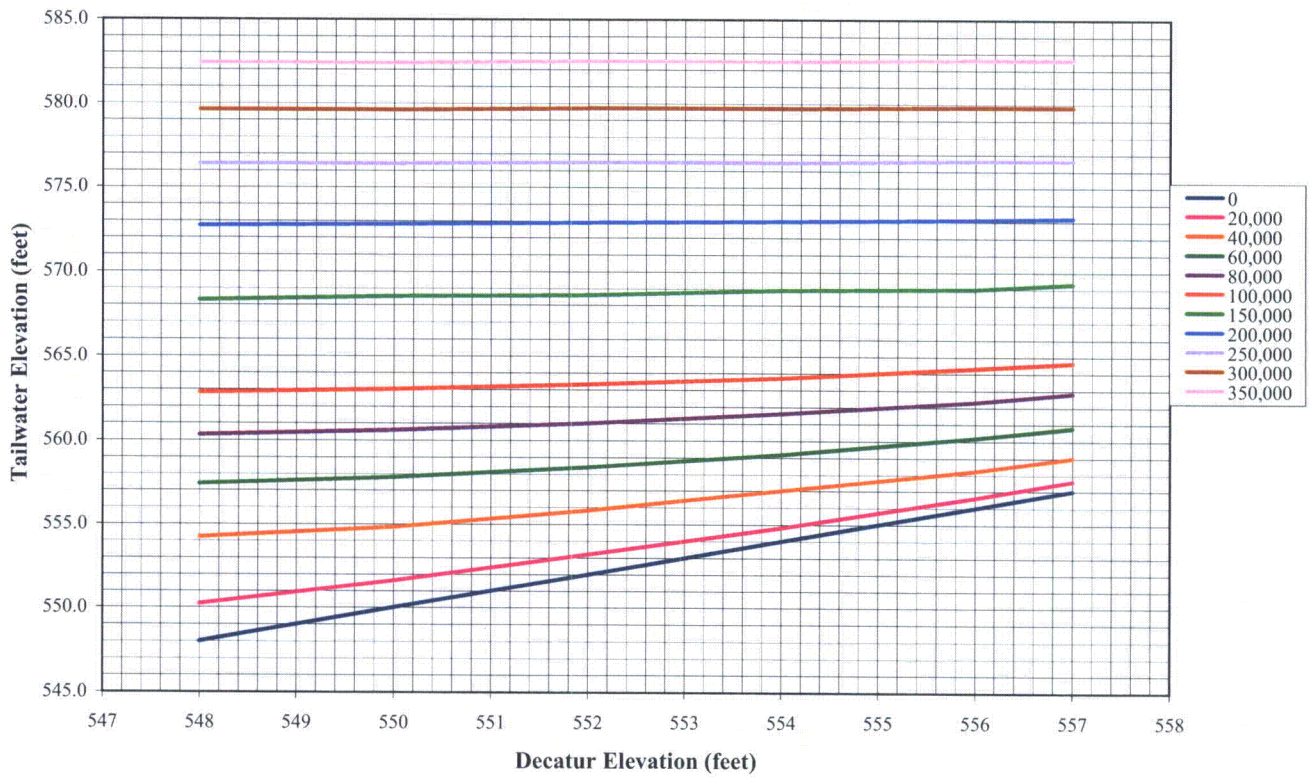

## Guntersville Tailwater Rating -- Effects of Reservoir Elevation Downstream (at Decatur, AL)

Decatur				Decatur				Decatur			
<u>Q*1000</u>	<u>Q</u>	<u>Elev.</u>	<u>TW</u>	<u>Q*1000</u>	<u>Q</u>	<u>Elev.</u>	<u>TW</u>	<u>Q*1000</u>	<u>Q</u>	<u>Elev.</u>	<u>TW</u>
0	0	548	548.0	80	80,000	548	560.3	250	250,000	548	576.4
0	0	550	550.0	80	80,000	550	560.6	250	250,000	550	576.4
0	0	552	552.0	80	80,000	552	561.0	250	250,000	552	576.5
0	0	554	554.0	80	80,000	554	561.6	250	250,000	554	576.5
0	0	556	556.0	80	80,000	556	562.3	250	250,000	556	576.6
0	0	557	557.0	80	80,000	557	562.8	250	250,000	557	576.6
20	20,000	548	550.2	100	100,000	548	562.8	300	300,000	548	579.6
20	20,000	550	551.6	100	100,000	550	563.0	300	300,000	550	579.6
20	20,000	552	553.2	100	100,000	552	563.3	300	300,000	552	579.7
20	20,000	554	554.8	100	100,000	554	563.7	300	300,000	554	579.7
20	20,000	556	556.6	100	100,000	556	564.3	300	300,000	556	579.8
20	20,000	557	557.6	100	100,000	557	564.6	300	300,000	557	579.8
40	40,000	548	554.2	150	150,000	548	568.3	350	350,000	548	582.4
40	40,000	550	554.8	150	150,000	550	568.5	350	350,000	550	582.4
40	40,000	552	555.8	150	150,000	552	568.6	350	350,000	552	582.5
40	40,000	554	557.0	150	150,000	554	568.9	350	350,000	554	582.5
40	40,000	556	558.2	150	150,000	556	569.0	350	350,000	556	582.6
40	40,000	557	559.0	150	150,000	557	569.3	350	350,000	557	582.6
60	60,000	548	557.4	200	200,000	548	572.7				
60	60,000	550	557.8	200	200,000	550	572.8				
60	60,000	552	558.4	200	200,000	552	572.9				
60	60,000	554	559.2	200	200,000	554	573.0				
60	60,000	556	560.2	200	200,000	556	573.1				
60	60,000	557	560.8	200	200,000	557	573.2				

Source: TVA River Operations  
Flood Risk Section

Attachment 6

Source: Reference 4

Calculation No: CDQ000020080011

## GUNTERSVILLE DAM SPILLWAY GATE ARRANGEMENTS

Arrangement Number	Gate Number																	
	1	2	3	4	5	6	7	8	9	10	11	12	13	14	15	16	17	18
61	5	5	9	9	9	U	U	9	U	U	9	9	9	9	9	-	-	-
62	5	5	9	9	9	U	U	9	U	U	9	9	9	9	9	-	-	-
63	5	5	9	9	9	U	U	9	U	U	9	9	9	9	9	-	-	-
64	5	5	9	9	9	U	U	9	U	U	9	9	9	9	9	-	-	-
65	5	5	9	9	9	U	U	9	U	U	9	9	9	9	9	-	-	-
66	5	5	9	9	9	U	U	9	U	U	9	9	9	9	9	5	-	-
67	5	5	9	9	9	U	U	9	U	U	9	9	9	9	9	9	-	-
68	5	5	9	9	9	U	U	9	U	U	9	9	9	9	9	9	-	-
69	5	5	9	9	9	U	U	9	U	U	9	9	9	9	9	9	-	-
70	5	5	9	9	9	U	U	9	U	U	9	9	9	9	9	9	-	-
71	5	5	9	9	9	U	U	9	U	U	9	9	9	9	9	9	-	-
72	5	5	9	9	9	U	U	9	U	U	9	9	9	9	9	9	-	-
73	5	5	9	9	9	U	U	9	U	U	9	9	9	9	9	9	-	-
74	U	U	U	U	U	U	U	U	U	U	U	U	U	U	U	U	U	U

116	-	L	L	L	L	L	L	L	L	L	L	L	L	L	L	L	L	L
117	U	L	L	L	L	L	L	L	L	L	L	L	L	L	L	L	L	L
118	L	L	L	L	L	L	L	L	L	L	L	L	L	L	L	L	L	L
119	L	L	L	L	L	L	L	L	L	L	L	L	L	L	L	L	L	L
120	L	L	L	L	L	L	L	L	L	L	L	L	L	L	L	L	L	L


### GATE OPENING LEGEND

Gate openings are shown in the vertical columns under each Gate Number as follows:

- |                            |                            |
|----------------------------|----------------------------|
| 1 - Upper leaf open 1 foot | 9 - Upper leaf open 9 feet |
| 3 - Upper leaf open 3 feet | U - Upper leaf out         |
| 5 - Upper leaf open 5 feet | L - Lower leaf out         |



### GUNTERSVILLE DAM

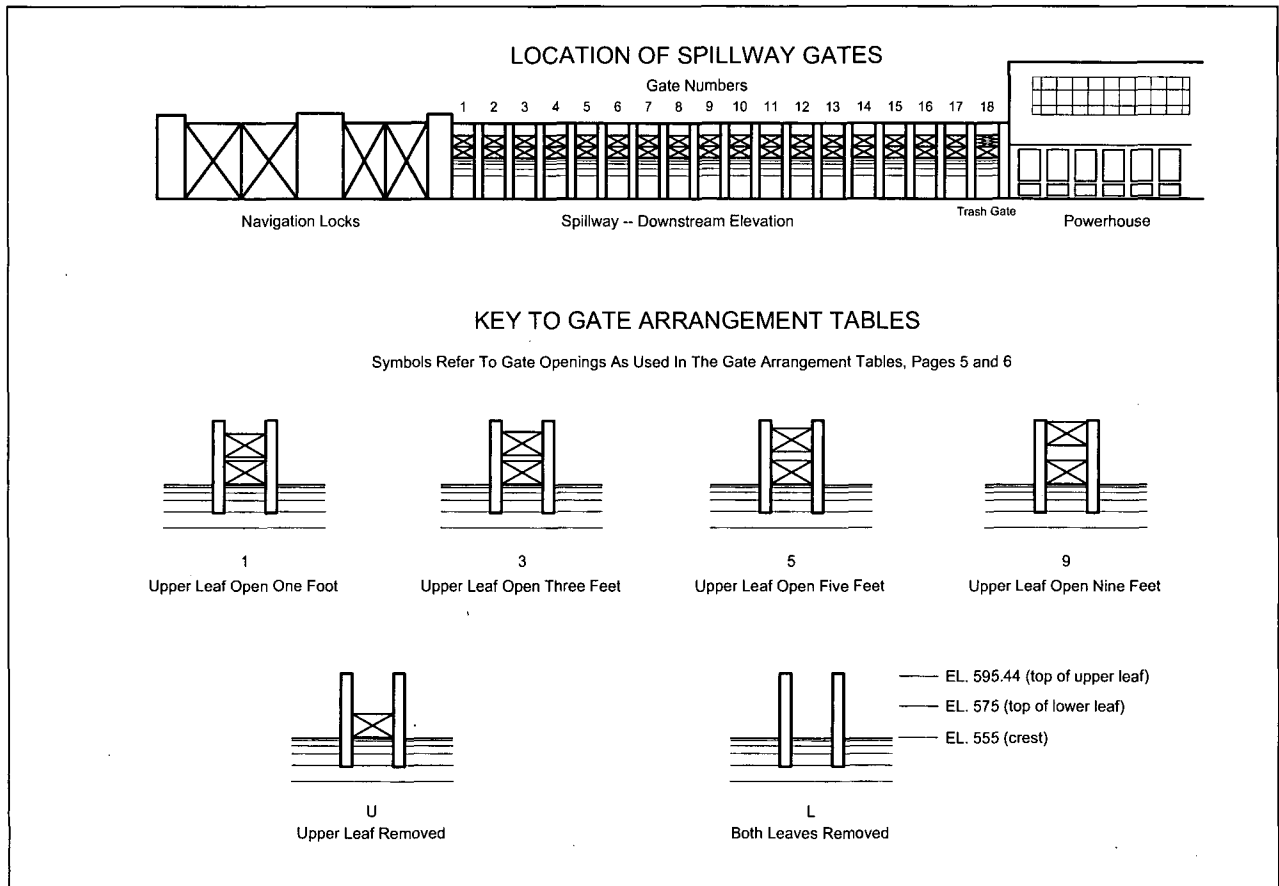

Calculation No. CDQ000020080011	Rev: 0	Plant: GEN	Page: 19
Subject: Initial Dam Rating Curve, Guntersville		Prepped	G. Schohl
		Checked	JBM

### Guntersville Dam Rating Curve









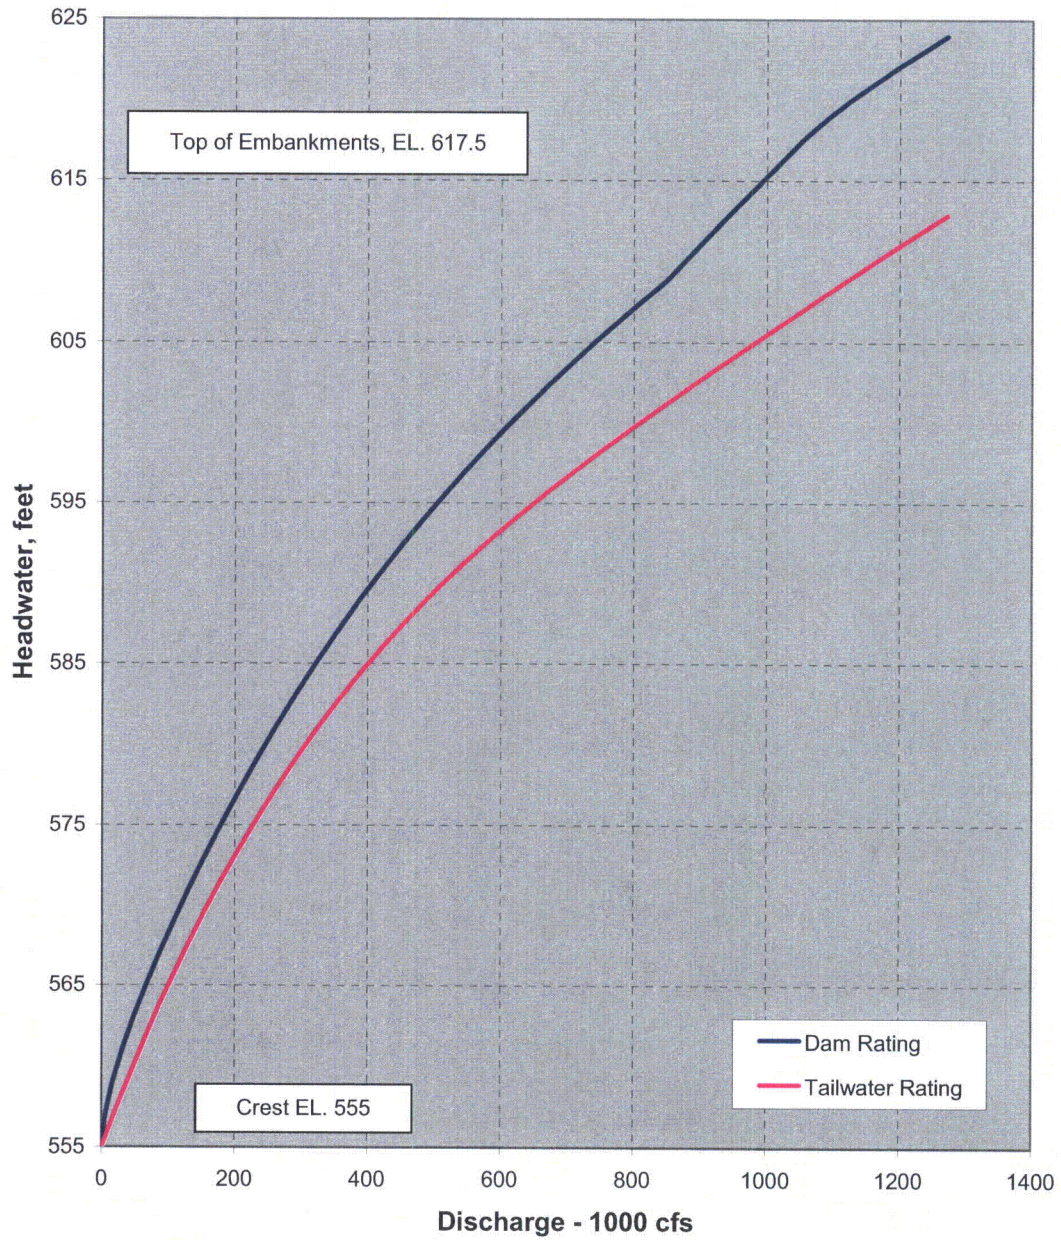


Figure 4 – Dam Rating Curve

00ZM01 90 2 3 Calculation No: CDQ000020080011 7

Attachment 1

Source: Reference 1

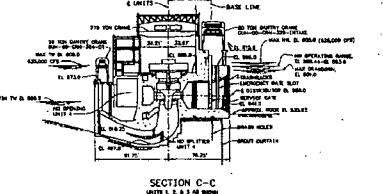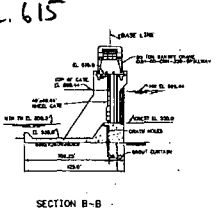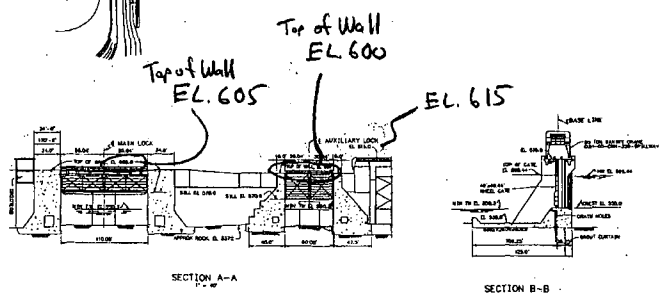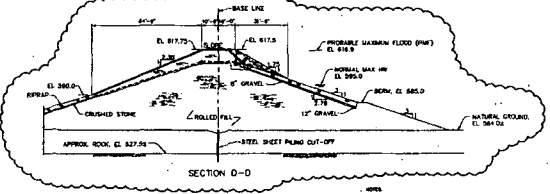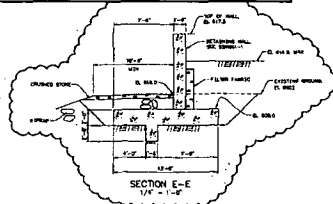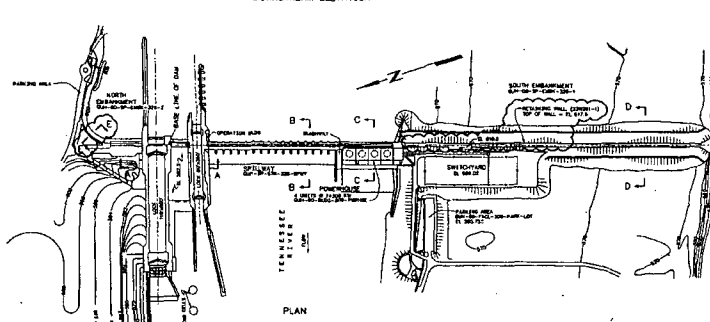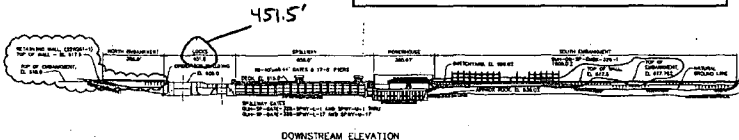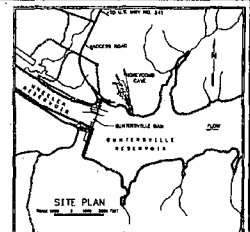



**GENERAL PLAN ELEVATION AND SECTIONS**

TENNESSEE VALLEY AUTHORITY







# GUNTERSVILLE DAM



September 1999

Guntersville WCP Manual  
Attachment 22

### RESERVOIR OPERATION OVERVIEW

Guntersville is a multipurpose main river project, one of 9 such projects located on the Tennessee River which provides a navigable waterway from the mouth of the river at Paducah, Kentucky, to the source of the river at Knoxville, Tennessee, some 652 river miles apart. Construction started in 1935, the dam was closed in 1939, the original lock went into operations at that time, and three hydroelectric units went into production later that year. A fourth hydroelectric unit was later authorized and went into production in 1952. A larger, modern lock was completed in 1965.


In addition to serving as a vital navigation link on the Tennessee River, Guntersville provides limited flood reduction benefits for downstream locations, and also contributes hydroelectric generation. Under normal conditions, the annual pool elevation only varies by about 2 feet at Guntersville, due to original design considerations. Guntersville Reservoir is fed by releases from TVA's Nickajack Dam in addition to unregulated inflows from the 2,580 square mile local drainage area.

Table of Contents

Guntersville Reservoir Vicinity Map.....	5
Figure 1: Installation of Kaplan Turbine (photo).....	6
Figure 2: Dam and Powerhouse Construction (photo).....	6
General Plans, Elevations, and Sections of Dam (from TVA drawing 10N200) and Main Lock (from TVA drawing 61N250):	
Figure 3: Dam General Plan and Downstream Elevation.....	7
Figure 4: Dam Sections A-A and B-B.....	8
Figure 5: Dam Sections C-C and D-D.....	9
Figure 6: Main Lock General Plan.....	10
Figure 7: Main Lock Elevation B-B.....	11
Figure 8: Main Lock Key Plan and Sections A-A, E-E, H-H, J-J, and F-F.....	12
Figure 9: Main Lock Sections C-C, D-D and G-G.....	13
Location.....	14
Chronology.....	14
Project Cost.....	15
Streamflow.....	15
Reservoir.....	16
Tailwater.....	16
Head (Gross).....	17
Reservoir Adjustments.....	17
Navigation Facilities:	
Navigation Channel.....	17
Navigation Lock.....	18
Auxiliary Lock.....	18
Figure 10: Navigation and Auxiliary Locks (photo).....	19
Dam.....	20
Figure 11: View of Spillway Gates-looking upstream (photo).....	21
Power Facilities:	
Intakes.....	22
Powerhouse.....	22
Figure 12: View of Powerhouse (photo).....	23
Hydraulic Turbines.....	24
Generators.....	24-25
Generator & Turbine Modernization.....	25
Transmission Plant.....	26
Figure 13: Single Line Diagram of Main Connections.....	26
Figure 14: View of Switchyard (photo).....	27
Transmission Plant Data.....	28
Electric Controls.....	29
Reservoir and Power Data.....	30
Turbine Discharge Tests.....	31
Unit 4 Operating Characteristics.....	32
Unit 4 Discharge Curves.....	33

Table of Contents (Cont.)

Spill Compilations .....	34-37
Maximum and Minimum Elevations .....	38-39
Average Weekly CFS .....	40
Annual Operating Cycle .....	41
Reservoir Areas and Volumes .....	42
Safety Modications for Probable Maximum Flood .....	43
Construction Data:	
Housing Facilities .....	44
Personnel .....	44
Quantities .....	44-45
Dam Construction Plant Layout .....	46
Schedules:	
Dam .....	47
Main Lock .....	48
Unit 4 .....	49

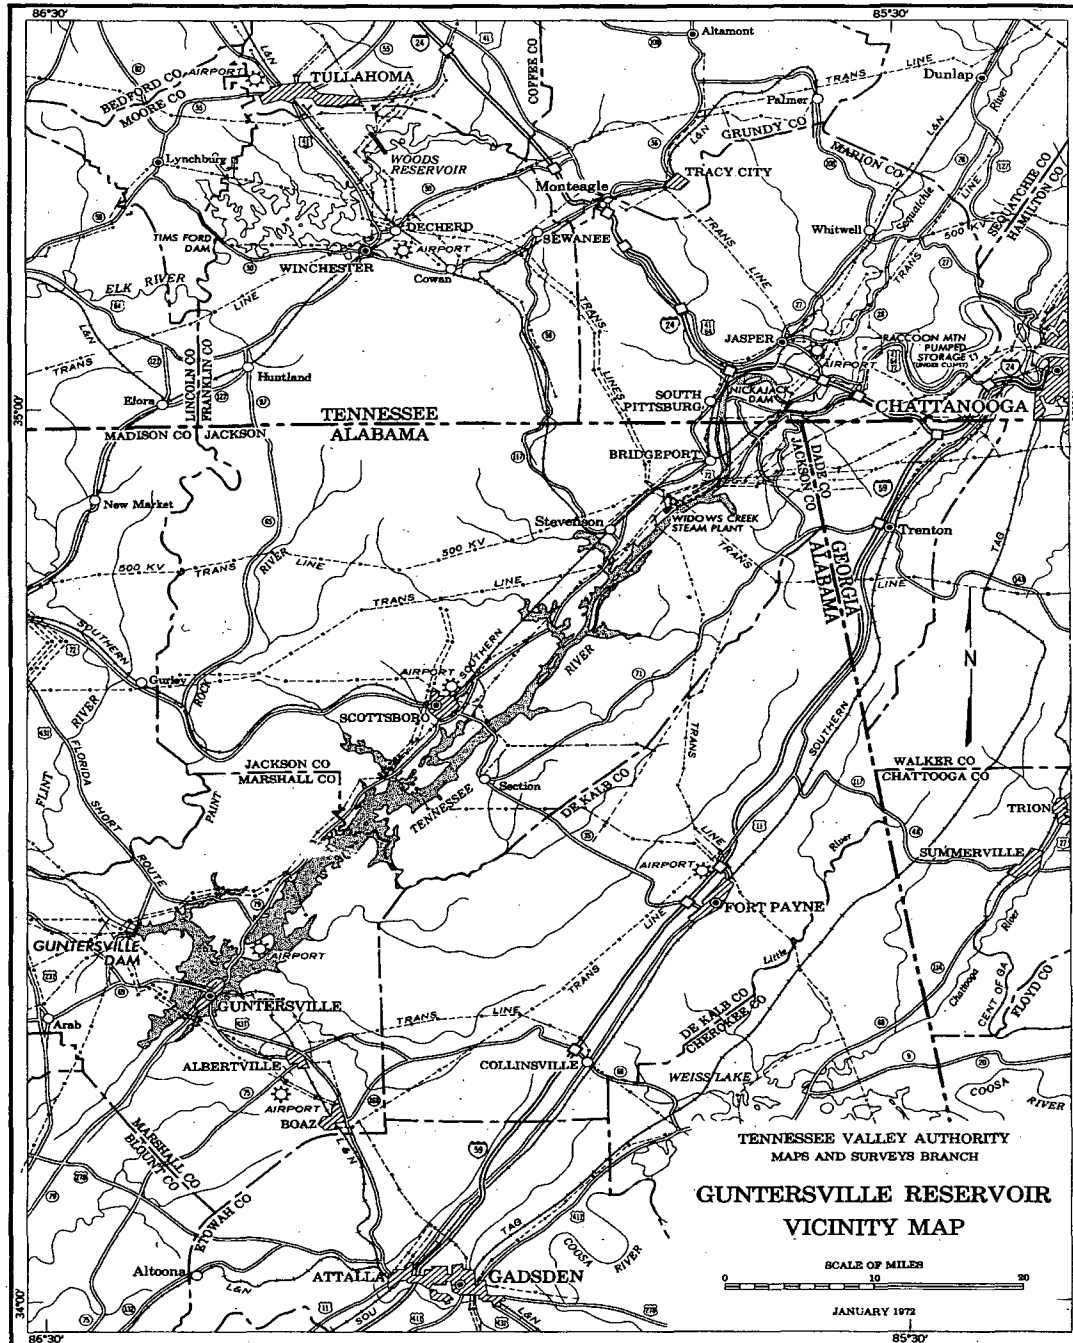



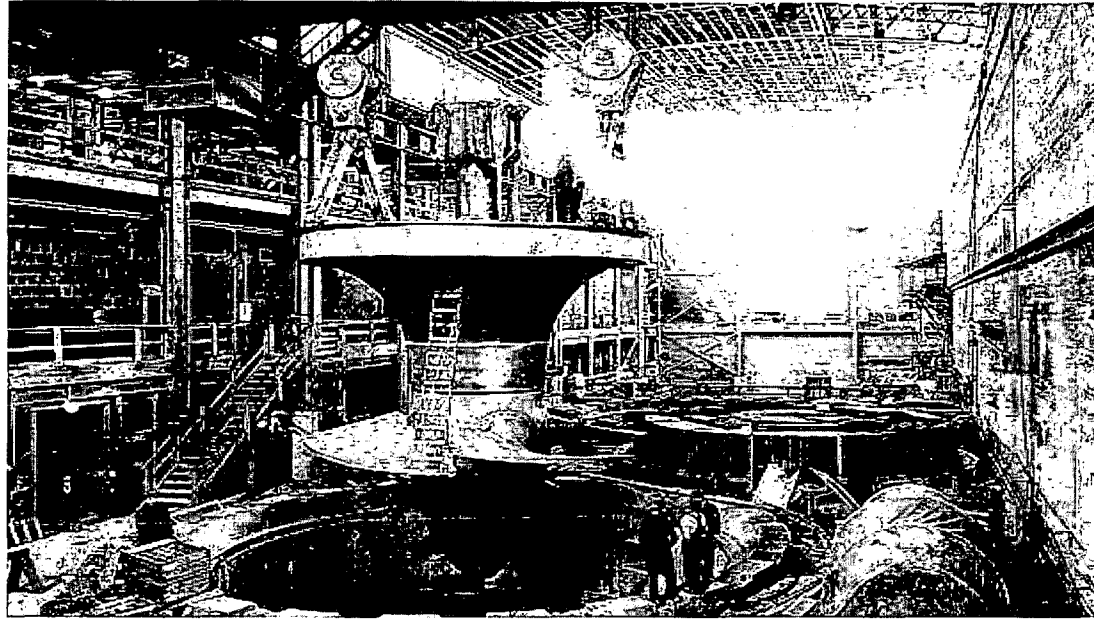


FIGURE 1 - Installation of Kaplan turbine, 1938


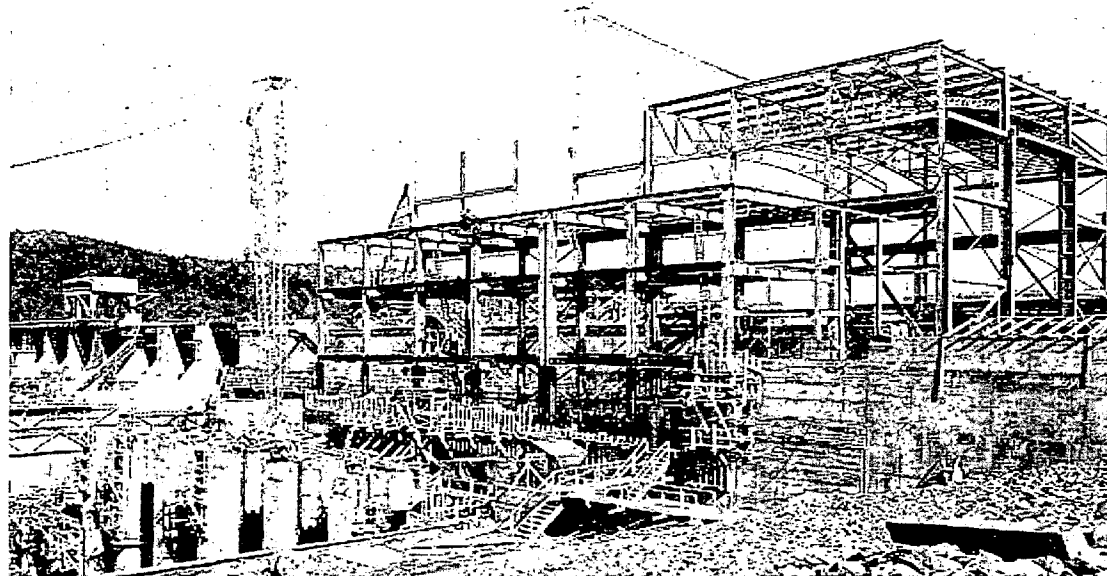


FIGURE 2 - Dam and Powerhouse Construction, 1938

FIGURE 3 - General plan and downstream elevation

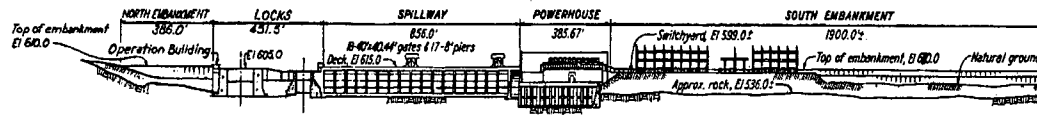

DOWNSTREAM ELEVATION



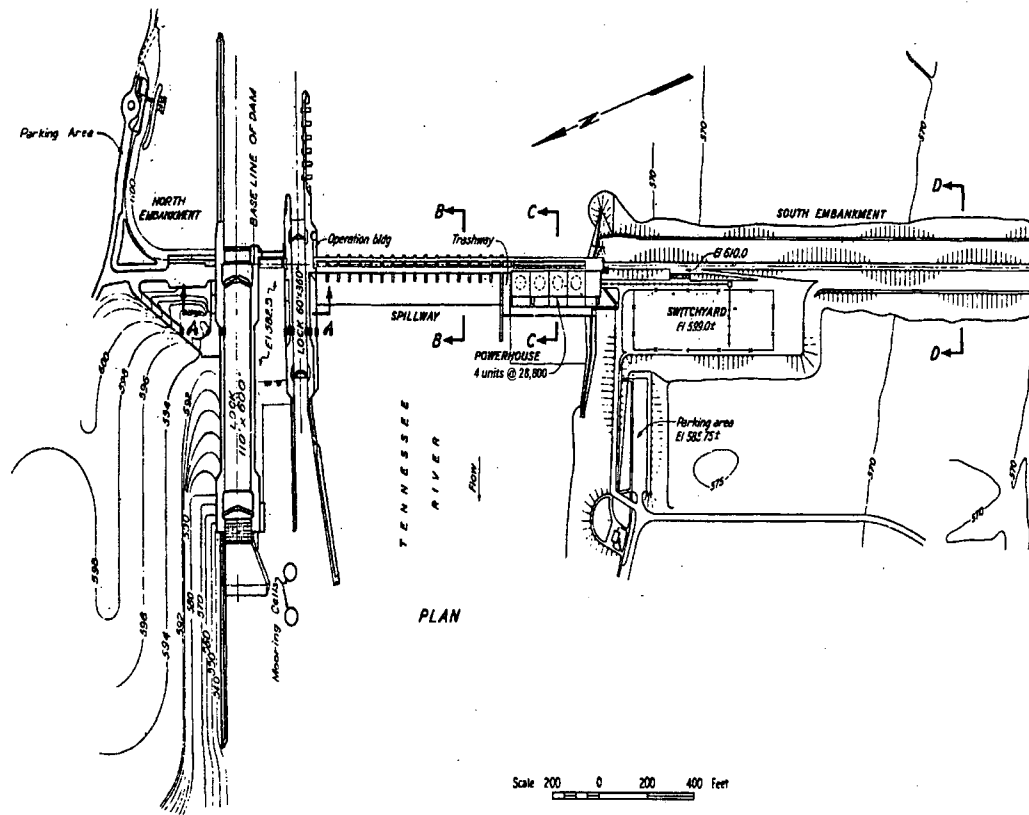


FIGURE 4 - Sections A-A and B-B

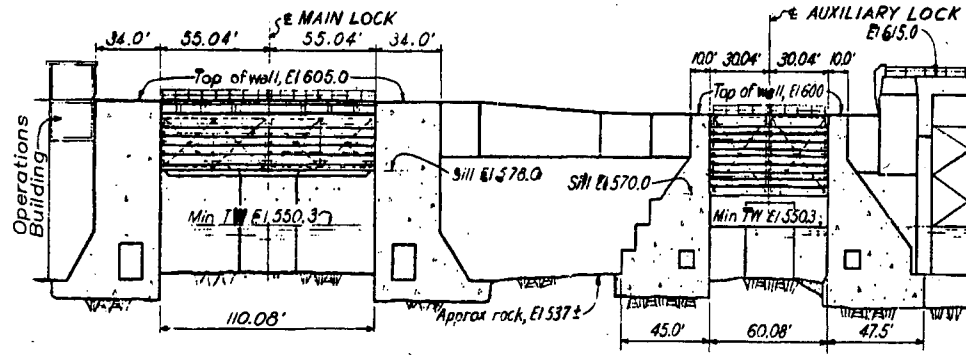


SECTION A-A

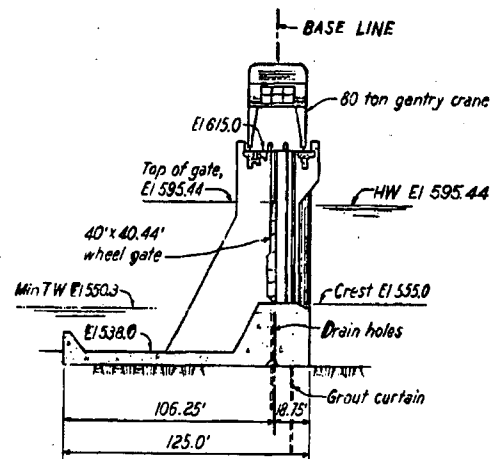


SECTION B-B



FIGURE 5 - Sections C-C and D-D

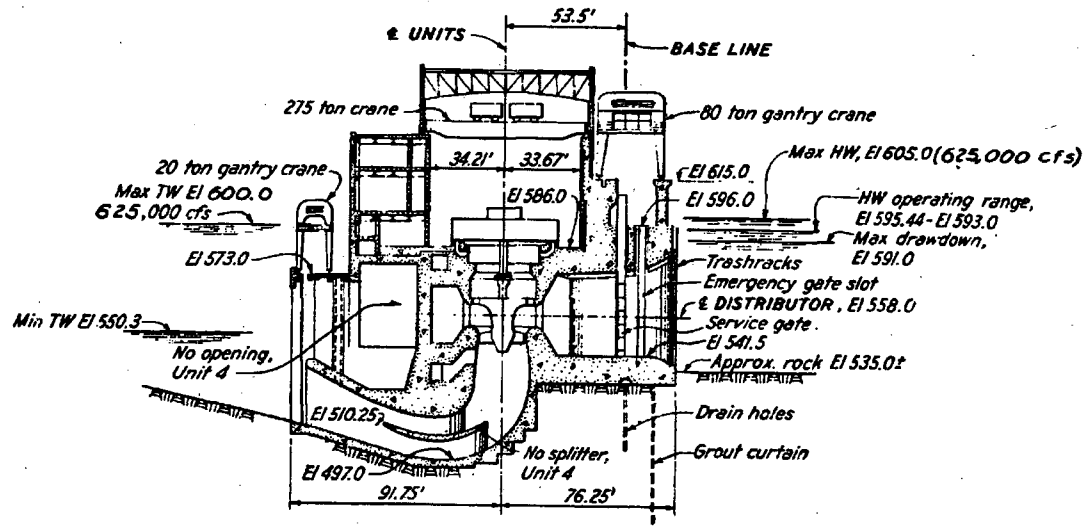

SECTION C-C  
UNITS 1, 2, & 3 AS SHOWN  
UNIT 4 AS SHOWN & NOTED

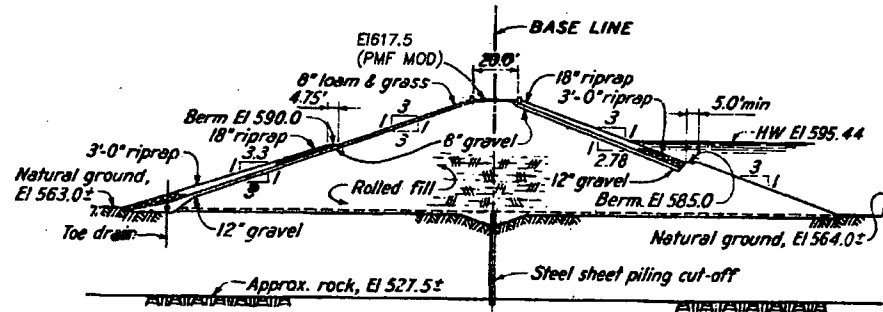

SECTION D-D

Scale 40 0 40 80 Feet

SECTIONS

FIGURE 6 - Main Lock General Plan


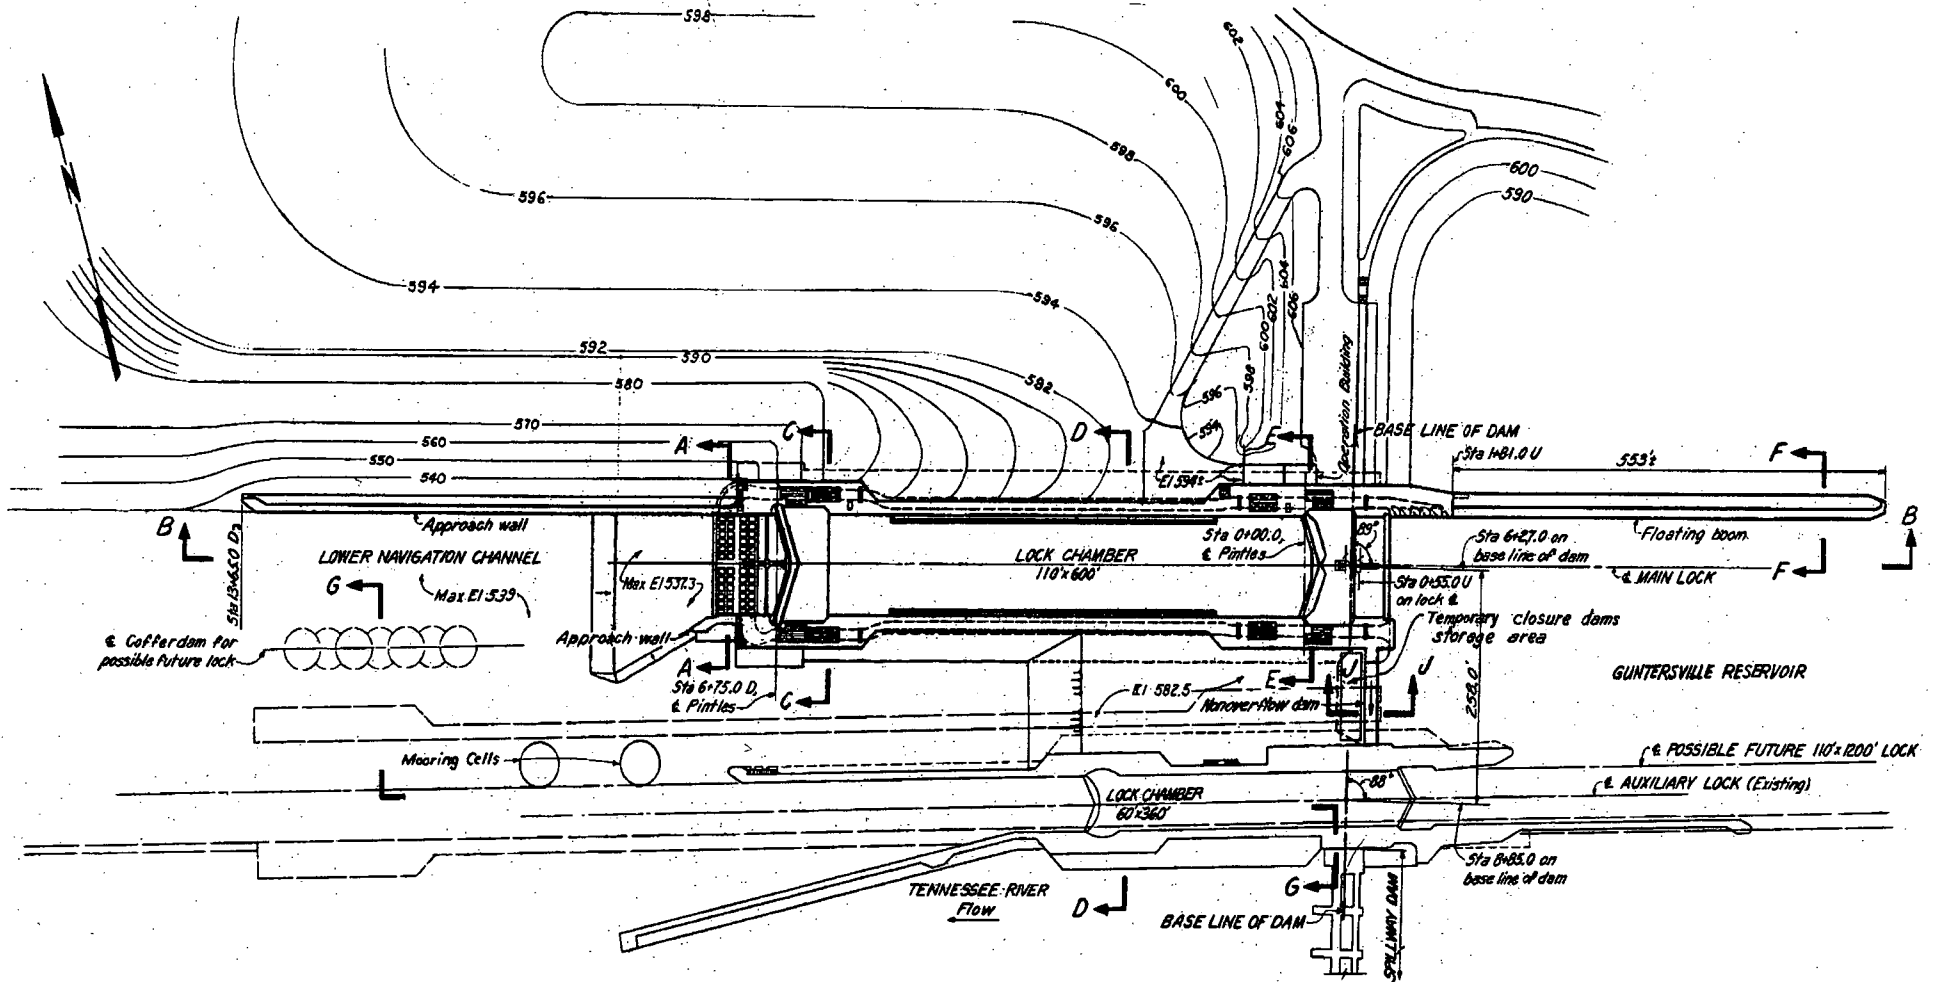


FIGURE 7 - Main Lock Elevation B-B

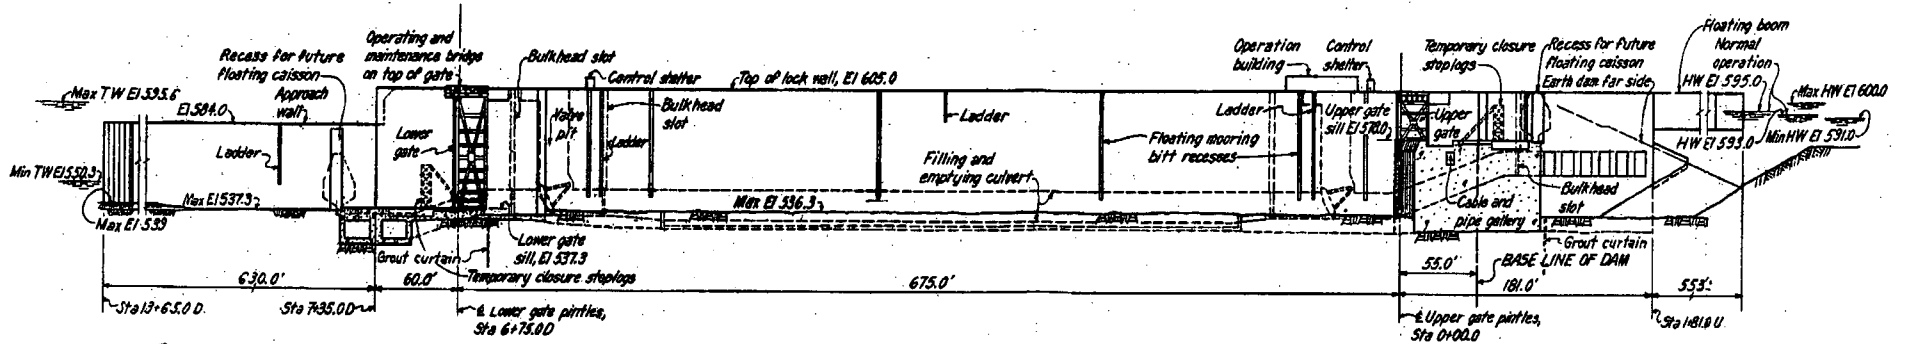

ELEVATION B-B

FIGURE 8 - Main Lock Key Plan and Sections A-A, E-E, H-H, J-J, and F-F









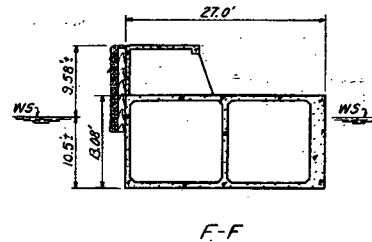


FIGURE 9 - Main Lock Sections C-C, D-D, and G-G

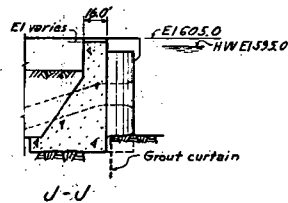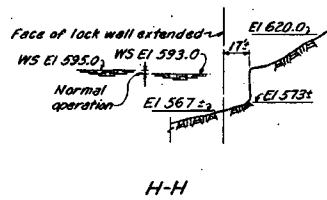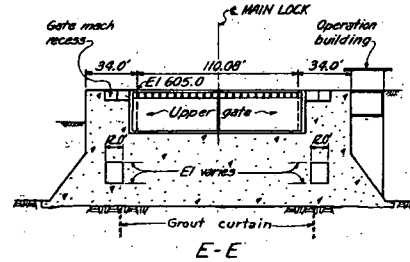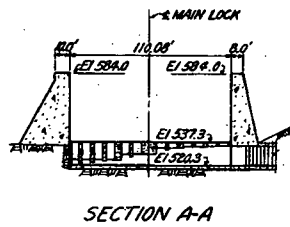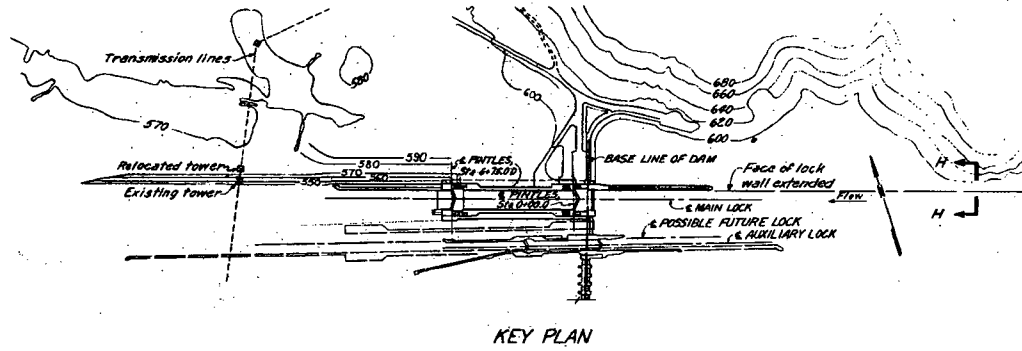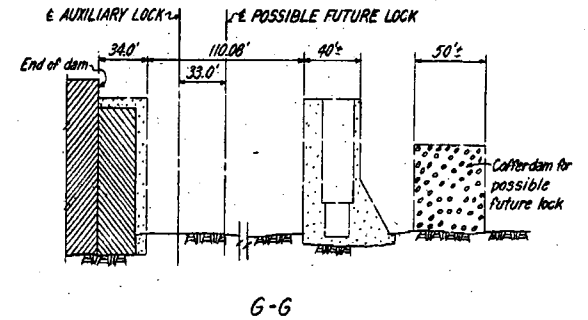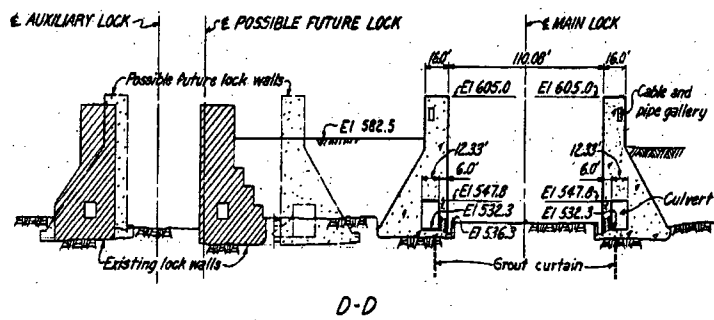

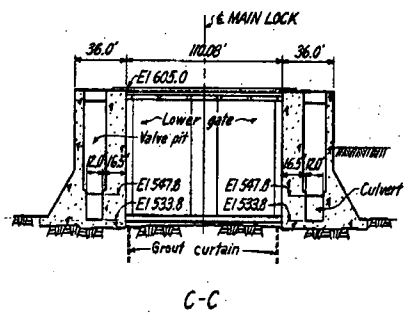

## GUNTERSVILLE PROJECT

### SUMMARY OF PRINCIPAL FEATURES

#### NOTE:

Elevations are based on the U.S.C. & G.S. 1929 General Adjustment.

#### LOCATION

On Tennessee River at river mile 349.0; in Marshall County, Alabama; 75.7 miles downstream from Nickajack Dam; 74.1 miles upstream from Wheeler Dam; 11 miles northwest of Guntersville, Alabama; 65 air miles north of Birmingham, Alabama; 75 air miles southwest of Chattanooga, Tennessee; 10.5 miles from railroad siding at Guntersville on Louisville & Nashville Railroad.

#### CHRONOLOGY

Exploration of site started .....	July 1935
Initial appropriation by Congress .....	August 12, 1935
Authorized by TVA Board of Directors .....	November 27, 1935
Construction started .....	December 4, 1935
First excavation .....	March 26, 1936
Started driving cofferdam No. 1 .....	April 23, 1936
Cofferdam No. 1 unwatered .....	July 14, 1936
First concrete (in lock) .....	September 21, 1936
Cofferdam No. 2 construction started .....	March 20, 1937
Lock placed in temporary operation .....	May 24, 1937
Cofferdam No. 2 unwatered .....	July 16, 1937
Cofferdam No. 3 unwatered .....	February 2, 1938
Dam closure .....	January 16, 1939
Lock placed in permanent operation .....	January 24, 1939
Reservoir filled to el. 593.75 and discharge of normal flow began .....	January 27, 1939
Unit 1 in commercial operation .....	August 1, 1939
Unit 2 in commercial operation .....	October 13, 1939
Unit 3 in commercial operation .....	December 26, 1939
Unit 4 authorized by TVA Board of Directors .....	June 28, 1949
Unit 4 in commercial operation .....	March 24, 1952
Main lock:	
Authorized by TVA Board of Directors .....	January 12, 1961
Initial appropriation by Congress .....	October 24, 1962
Construction started .....	March 4, 1963
First concrete placed .....	October 31, 1963
Initial public lock passage .....	June 30, 1965
Safety Modifications for Probable Maximum Flood	
construction completed .....	June 30, 1995

PROJECT COST

Initial project, including	
lock and 3 units .....	\$ 33,188,040
Addition of unit 4 .....	4,678,704
Addition of main lock .....	16,415,876
Safety Modification for Probable Maximum Flood .....	<u>37,329,070</u>
Total, including switchyard .....	\$ 91,611,690

STREAMFLOW

Drainage area at dam: .....	24,450 sq. miles
Uncontrolled (below Nickajack Dam) .....	2,580 sq. miles
Maximum known flood at dam site:	
Natural (1867) .....	419,000 cfs
Regulated (March 1973) .....	314,200 cfs
Average unregulated flow at dam site,	
(1903-1999) .....	41,100 cfs
Minimum daily natural flow at dam site	
(1925), approx .....	3,600 cfs

RESERVOIR

Counties affected: State of Alabama ..... Marshall  
 State of Tennessee ..... Marion

## Reservoir land at May 1996:

Fee simple ..... 91,070 ac.  
 Easements ..... 1,068 ac.  
 Total ..... 92,138 ac.  
 Transferred ..... 4,329 ac.

## Operating levels at dam:

Probable maximum flood elevation ..... el. 614.0  
 500 Year flood elevation ..... el. 595.9  
 100 Year flood elevation ..... el. 595.8  
 TVA Flood Risk Profile ..... el. 597.0\*  
 Maximum used for design (625,000 cfs) ..... el. 605.0  
 Top of gates (area 70,200 ac.) ..... el. 595.44  
 Winter Flood Guide Level ..... el. 593.0  
 Summer Flood Level ..... el. 595.0

Backwater, length to Nickajack Dam ..... 75.7 miles

## Shoreline, length at normal maximum pool level:

Main shore ..... 786 miles  
 Islands ..... 163 miles  
 Total ..... 949 miles  
 Original river area (to Nickajack Dam) ..... 12,065 ac.

## Storage (flat pool assumption):

## Total volume:

At top of gates (el. 595.44) ..... 1,052,000 ac.-ft  
 At normal maximum pool (el. 595.0) ..... 1,018,000 ac.-ft  
 At normal minimum pool (el. 593.0) ..... 879,700 ac.-ft  
 Controlled flood storage, January 1 to  
 April 1 (el. 595.44-593) ..... 172,300 ac.-ft

\* TVA Flood Risk Profile Elevation is the elevation of the 500 Year flood that has been adjusted for surcharge at the dam. Surcharge is the ability to raise the water level behind the dam above the top-of-gates elevation (when in the closed position) without causing damage to the project.

TAILWATER

Maximum used for design (625,000 cfs) ..... el. 600.0  
 Maximum known flood (1867) ..... el. 590.1  
 Full plant operation (4 units) ..... el. 554.5  
 One unit operating at best efficiency ..... el. 551.1  
 Minimum level ..... el. 550.3

HEAD (Gross)

Maximum static (el. 595.44-550.3) .....	45.14 ft
Normal operating range .....	16 to 43 ft
Average operating .....	37 ft

RESERVOIR ADJUSTMENTS

(Initial Project)

Clearing (below el. 595) .....	24,426 ac.
Drainage of isolated pools .....	229,114 cu.yd
Preparation of sailing line .....	472 ac.
Highways:	
Access (dam to Alabama. Highway 1, also south access; bituminous surface on crushed stone base) .....	7.4 miles
State .....	15.8 miles
County .....	44.7 miles
Tertiary .....	20.3 miles
Total .....	88.2 miles
Railroads .....	5.7 miles
Bridge adjustments (highway 6,317 ft; railroad 417 ft) .....	44 bridges
Concrete box culverts .....	84
Families relocated .....	1,182
Graves .....	193 agreements; 68 removals
Utilities adjusted or constructed .....	42.9 miles

NAVIGATION FACILITIES

## NAVIGATION CHANNEL

Length of channel for 9-ft navigable depth (to Nickajack Dam) .....	73.4 sailing miles
Minimum flat pool to maintain 9-ft navigable depth .....	el. 593.0
Length of dredged navigable channel:	
Below lock .....	8.0 miles
Upper end of pool .....	9.0 miles

NAVIGATION FACILITIES (CONT.)

NAVIGATION LOCKS (See Figure 10)

MAIN LOCK

Location..... Right (north) bank  
 Lock chamber, clear ..... 110 by 600 ft  
 Lift (maximum), el. 550.3 to el. 595.4 ..... Approx. 45 ft  
 Gate sills ..... Upper, el. 578.0; lower, el. 537.3  
 Minimum depth over sills ..... 13.0 ft  
 Upstream river approach wall ..... Floating boom 553 ft long  
 with approx. 9.5 ft freeboard  
 Top of chamber walls ..... el. 605  
 Top of downstream approach walls ..... el. 584.0  
 Filling and emptying system ..... Multiple-port type, 416 8-in.  
 dia. ports in each wall  
 Estimated lockage time (checking  
 to regaining speed) ..... 40 min  
 Provision for future lock ..... Planned so that a 110-ft-wide  
 lock can be constructed in place of  
 present 60-ft-wide auxiliary lock  
 Lock gate top ..... Upper , el.599.38; lower, el.599.38  
 Lock gate height ..... Upper , 21.89 ft; lower, 62.59 ft

AUXILIARY LOCK (See Figure 10)

Location..... At right (north)end of spillway  
 Lock chamber, clear ..... 60 by 360 ft  
 Lift: Maximum (el. 550-595) ..... 45 ft  
 Normal (el. 556-595) ..... 39 ft  
 Guard (gate) sills ..... Upper, el.578.0; lower, el.538.2  
 Minimum depth over sills ..... Upper, el.13.0 ft; lower, 12.1 ft  
 Top of upper guide and guard walls ..... el.600.0  
 Top of chamber walls ..... el.600.0  
 Top of lower guide and guard walls ..... el.578.0  
 Estimated lockage time (checking to  
 regaining speed) ..... 35 min  
 Lock gate top ..... Upper, el. 597.11; lower, el. 597.64  
 Lock gate height ..... Upper, 27.94 ft; lower, 60.64 ft

FIGURE 10 - Navigation and Auxillary Locks, September 1999



DAM

Material and type..... Concrete gravity spillway; concrete  
powerhouse intake; navigation  
locks; impervious rolled earthfill  
embankments

Lengths:

Spillway (See Figure 11) .....	856 ft
Powerhouse intake and service bay .....	386 ft
Navigation locks .....	451 ft

Earth embankments:

Left (south) bank .....	1,900 ft
Right (north) bank .....	386 ft
Total .....	3,979 ft

Maximum height, foundation to deck level .....

94 ft
-------

Maximum width at base:

Spillway section only, pier .....	72 ft
Including apron .....	125 ft

Deck level .....

el. 615.0
-----------

Top of earth embankments .....

el. 610.0
-----------

Outlet facilities (Figure 11):

Spillway clear opening (18 openings at 40 ft) .....	720 ft
Spillway crest level .....	el. 555.0

Crest gates .....

18 fixed-wheel lift gates, 40 ft wide, 40.44 ft high; separated by 8-ft- thick piers
---

Trash gate .....

Top half of one crest gate consists of 3 sections for operation as trash gate
--

Traveling cranes .....

Two 80-ton gantries, one with auxiliary 10-ton trash boom hoist
---

Spillway capacity:

HW el. 605.0 (design level) .....	650,000 cfs
HW el. 595.44 (top of gates) .....	478,000 cfs

Foundation .....

Bangor limestone
------------------

FIGURE 11 - View of Spillway Gates (looking upstream), September 1999





POWER FACILITIES

## INTAKES

Number ..... 4 (each with 3 bays)  
 Dimensions of one  
     rack opening ..... 22 ft 11 in. wide by 46 ft high  
 Gross area at racks ..... 3,160 sq. ft per unit  
 Gates ..... 2 sets of 1 wheel and 2 slide gates,  
                     17 ft 8 in. clear opening by 38 ft  
                     2-1/2 in. high  
 Crane ..... Same 80-ton gantry as used for spillway

## POWERHOUSE (See Figure 12)

Generating capacity, 4-unit total ..... 115,200 kW  
 Type of construction ..... Enclosed, reinforced concrete,  
                                     structural steel and brick  
 Principal outside dimensions  
     including service bay ..... 386 ft long by 168 ft wide  
   by 166 ft high  
 Service bay ..... 70 by 144 ft  
 Draft tubes:  
     Type ..... Elbow, 3 openings, with horizontal  
                                     splitter; splitter omitted in  
                                     unit 4  
     Horizontal length (center  
       line of turbine to downstream face) ..... 85.0 ft  
     Vertical distance from distributor  
       centerline to draft tube floor ..... 61.0 ft  
 Net area at outlet opening ..... 1,350 sq. ft  
 Gates ..... 1 set of 3 sliding type,  
                     25 ft 6 in. high by 18  
                     ft clear opening in 2  
                     sections  
 Crane ..... One 20-ton gantry and lifting beam  
 Erecting crane ..... 275-ton capacity; two 137-1/2-ton  
                                     main hooks and two 25-ton  
                                     auxiliary hooks

FIGURE 12 - View of Powerhouse, September 1999



POWER FACILITIES (CONT.)

## HYDRAULIC TURBINES

Number..... 4  
 Manufacturer..... S. Morgan Smith Co. (now Allis-Chalmers  
 Manufacturing Co.)  
 Type..... Kaplan adjustable-blade propeller  
 Rated capacity (each)..... 34,000 hp at 36-ft net head  
 Rated speed..... 69.2 r/min  
 Maximum runaway speed..... 189 r/min  
 Specific speed at rating..... 145  
 Value of sigma at rating..... 1.05  
 Diameter of runner..... 265 in.  
 Diameter of guide vane circle..... 318.375 in.  
 Diameter of lower pit..... 30.0 ft  
 Spacing of turbines,  
 center to center of units..... 78 ft  
 Draft tubes (see Powerhouse)..... Elbow type  
 Governors..... Woodward, cabinet actuator type  
 Heaviest assembly to be lifted by crane..... 446,000 lb

## GENERATORS

Number..... 4  
 Manufacturer..... Generator Electric Co.  
 Type..... Enclosed , water-cooled , vertical-shaft  
 Rating: Units 1, 2, 3, 4; original  
 rating..... 27,000 kVA, 24,300 kW, 1129 A, 60  
 degrees C rise, 0.9 pf, 13.8 kV,  
 3 phase, 60 Hz  
 Capacity: Units 1, 2, 3, 4; original  
 capacity..... 31,050 kVA, 27,945 kW, 1298 A,  
 80 degrees C rise  
 Units 1-4 rewound and rerated:  
 Rating units 1-4:  
 Unit 1 - Jan 1979..... 32,000 Kva , 28,800 kW  
 Unit 2 - July 1979..... 1339 A, 60 degrees C  
 Unit 3 - Dec 1974..... rise, 0.9 pf, 13.8 kV  
 Unit 4 - 1978..... 3 phase, 60 Hz  
 Efficiency (original values):  
 Unit 1 (tested):  
 At rated kVA, 1.0 pf..... 96.50 percent  
 At 75% kVA, 0.9 pf..... 97.05 percent  
 Units 2-4 (guaranteed):  
 At rated kVA, 1.0 pf..... 96.50 percent  
 At 75% kVA, 0.9 pf..... 97.05 percent

POWER FACILITIES (CONT.)

## GENERATORS (CONT.)

Flywheel effect (tested):  
 Units 1-3..... 85,920,000 lb-ft<sup>2</sup>  
 Unit 4..... 92,770,000 lb-ft<sup>2</sup>

Thrust bearing:  
 Units 1-3..... Kingsbury, dia. 87 in., max. load 1000 tons  
 Unit 4..... GE, dia. 100 in., max. load 1000 tons

Neutral reactor..... 1.0 ohm, 6000 A, 1 min

Exciters:  
 Main..... 250 kW, 250 V  
 Pilot..... 15 kW, 250 V

Weight of heaviest crane lift, rotor:  
 Units 1-3..... 230 tons  
 Unit 4..... 232.5 tons

Diameter over air housing, less trim..... 556 in.  
 Diameter of stator bore..... 396 in.

Top of pilot exciter:  
 Above stator soleplates..... 146.75 in.  
 Above generator floor..... 104 in.

## GENERATOR AND TURBINE MODERNIZATION

Guntersville Units 1 through 4 will be rehabilitated and upgraded. Work on Unit 4 was started in March 2000 and is expected to be completed in late summer 2000. Work on Units 1, 2, and 3 is scheduled to start in March and complete in July of 2001, 2002 and 2003 respectively. Major items include installation of new stainless steel runners; new main and pilot exciters; new transformers on 3 of 4 banks; new stainless steel throat ring; rewedged stators; reinsulated rotor poles; new turbine guide bearings; rehabilitated wicket gates with new greaseless bushings throughout; rehabilitated shift ring; new or rehabilitated cooling water piping, valves, and strainers; rehabilitated generator brake system; and upgrade or rehabilitation of various other unit components.

POWER FACILITIES (CONT.)

TRANSMISSION PLANT

Step-up transformers (7/2000):

- 4 1-3 phase, 2-winding transformers, banks 1 to 4; each rated 13.8-161 kV, 40,000 kVA self-cooled, 53,000 kVA forced-air cooled; ABB

Intersystem transformers:

- 2 banks of 3 single-phase, 2-winding autotransformers, banks 11 and 12; each bank rated 154/11.5 kV, 22,500 kVA self-cooled, 30,000 kVA forced-air-cooled on 154/11.5-kV windings; 5000 kVA selfcooled, 6667 kVA forced-air-cooled on 11.5-kV windings; 154-kV load ratio control; General Electric
- 1 bank of 3 (plus 1 spare) single-phase, 3-winding transformers, bank 13, rated 110-46 kV, 20,000 kVA self-cooled, 26,667 kVA forced-air-cooled, 12.45 kV, full-capacity tertiary; Moloney

161-kV circuit breakers:

- 3 1200-A, 5,000,000-kVA, 5/60-Hz, sol, Westinghouse
- 6 1200-A, 5,000,000-kVA, 5/20-Hz, pneu, Westinghouse
- 1 1200-A, 5,000,000-kVA, 3/20-Hz, pneu, Westinghouse

115-kV circuit breakers:

- 4 600-A, 1,000,000-kVA, 8-Hz, sol, Allis-Chalmers

46-kV circuit breakers:

- 1 600-A, 500,000-kVA, 8/30-Hz, sol, Allis-Chalmers
- 1 600-A, 500,000-kVA, 8/20-Hz, pneu, Allis-Chalmers

12.5-kV circuit breakers:

- 1 600-A, 250,000-kVA, 8-Hz, sol, General Electric

Structures (See Figure 14):

- 8 161-kV switchyard bays, 38 ft wide
- 4 115-kV switchyard bays, 38 ft wide
- 6 46-kV switchyard bays; 5 at 21 ft wide, 1 at 19 ft wide
- 4 12-kV switchyard bays
- 8 transformer structures

FIGURE 13 - SINGLE LINE DIAGRAM OF MAIN CONNECTIONS


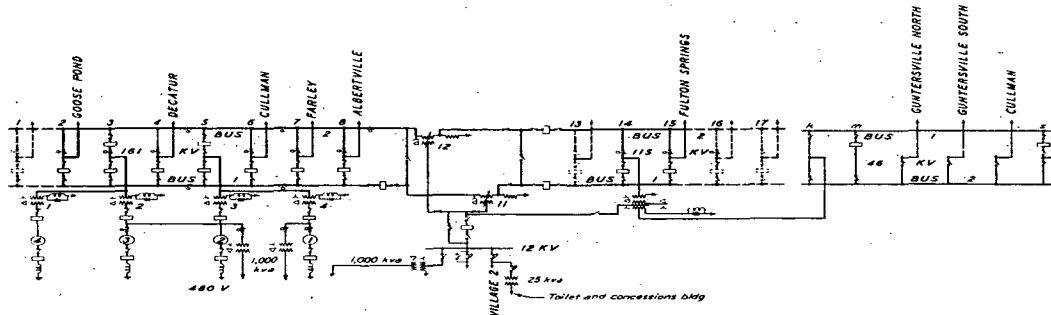


FIGURE 14 - View of Switchyard

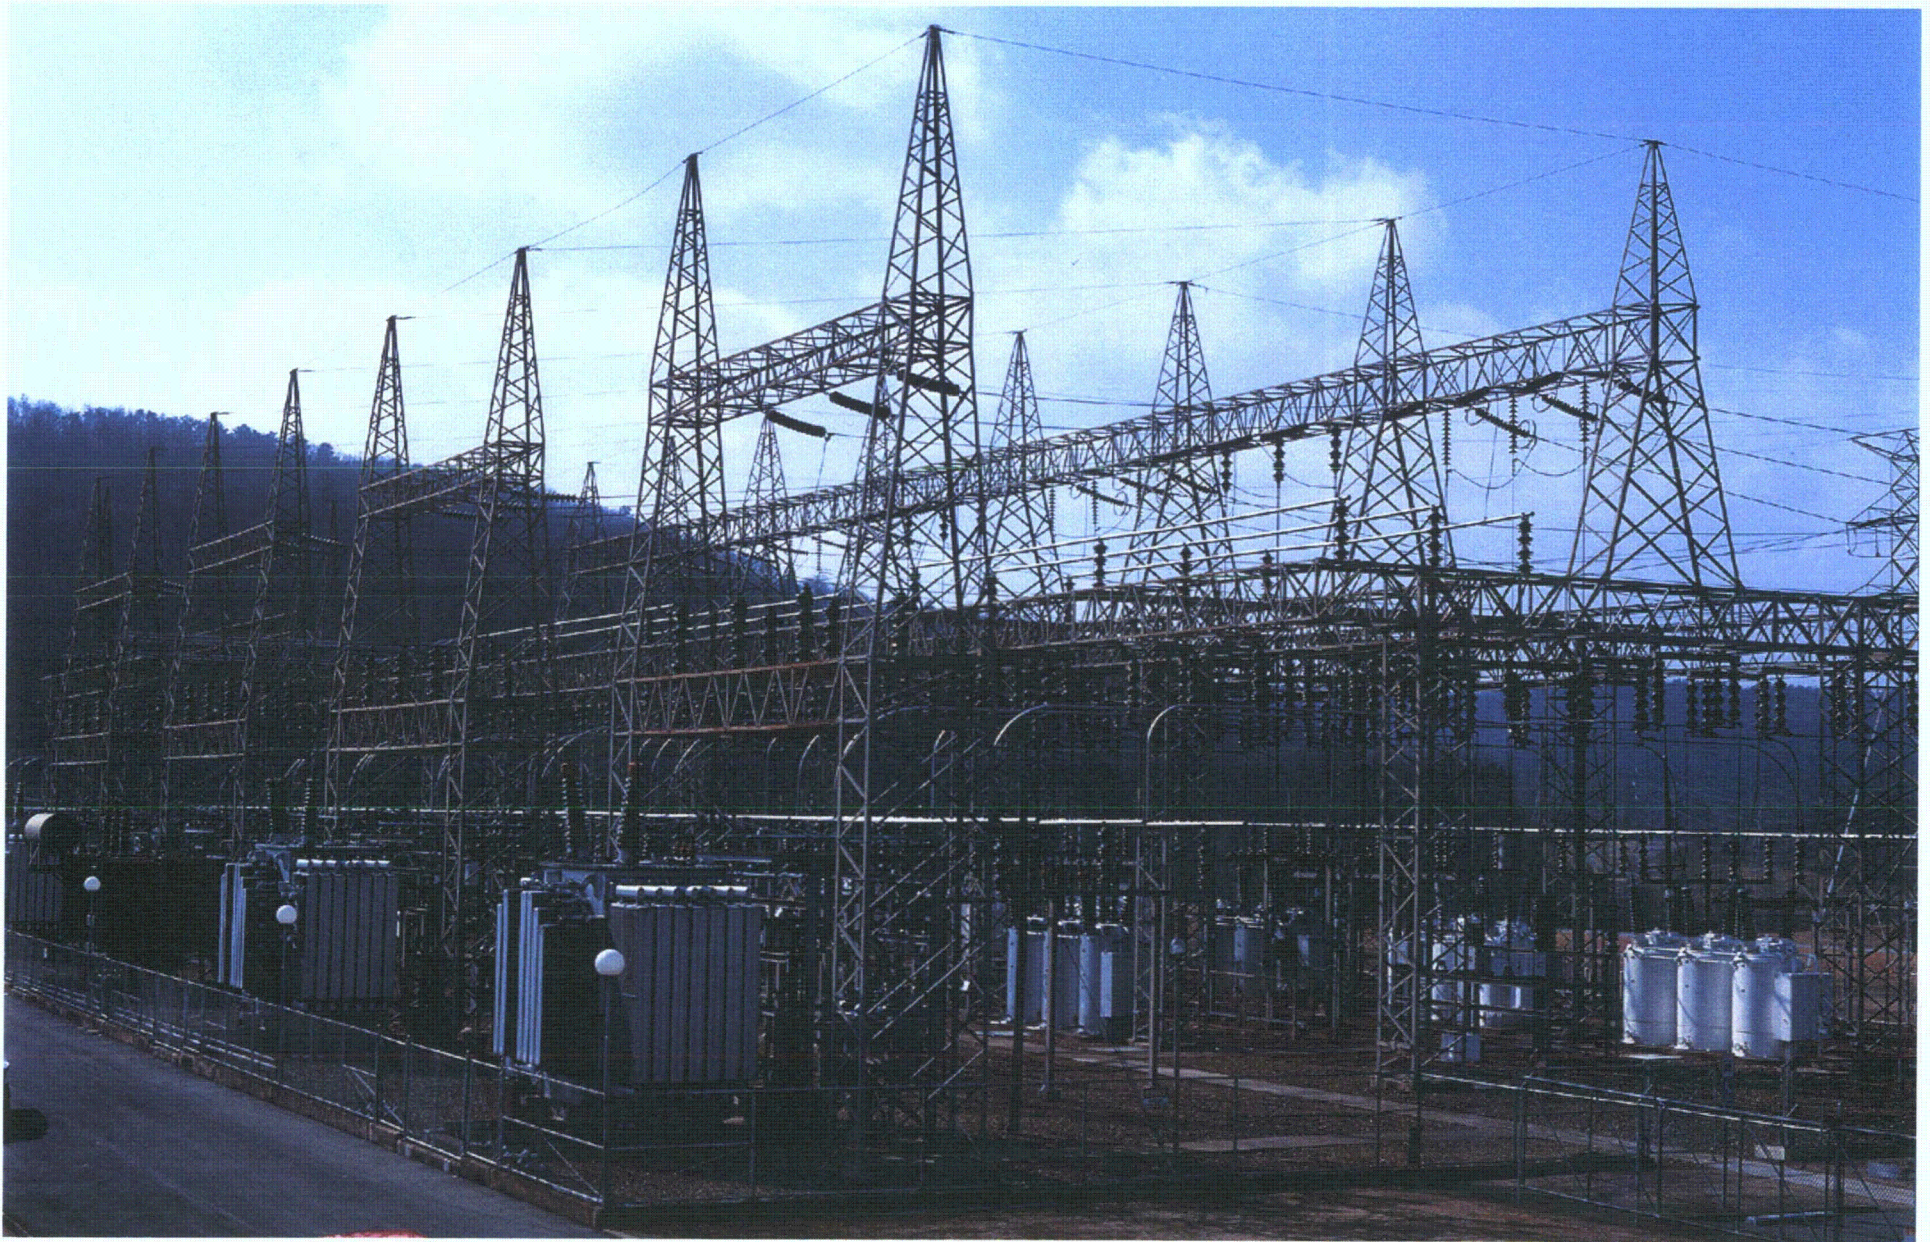

**TRANSMISSION PLANT DATA**

Location	Phase	Serial Number	MVA Rating		Voltage kV	Cooling	Tap Changer	Oil Preservation System	Oil Volume Gal.	Configuration	Impedance %			Contract Number	Manufacturer	Yr of Manuf
			55 deg	65 deg							H-X	H-Y	X-Y			
Bank 1	3	2351354	24/32	N/A	161/13.2	OA/FA	DETC	Gas-Blanketed	8425	Wye/Delta	10.59	N/A	N/A	TV-25055	Westinghouse	1939
Bank 2	3	3641714	39/52/65	72.8	161/13.8/6.9	OA/FA/FA	DETC	Conservator	8052	Wye/Wye/Wye	6.83	7.00	5.52	80K6-823678-1	Ferranti-Packard	1982
Bank 3	3	2480856	24/32	N/A	161/13.2	OA/FA	DETC	Gas-Blanketed	8425	Wye/Delta	10.38	N/A	N/A	TV-58211	Westinghouse	1939
Bank 4		Removed														
Bank 11A	1	5694180	7.5/10	N/A	154/115/11.5	OA/FA	DETC	Gas-Blanketed	9730	Wye/Wye/Delta	5.49	49.70	42.20	TV-18681	General Electric	1938
Bank 11B	1	5694181	7.5/10	N/A	154/115/11.5	OA/FA	DETC	Gas-Blanketed	9730	Wye/Wye/Delta	5.46	49.80	42.40	TV-18681	General Electric	1938
Bank 11C	1	5694182	7.5/10	N/A	154/115/11.5	OA/FA	DETC	Gas-Blanketed	9730	Wye/Wye/Delta	5.51	51.20	43.70	TV-18681	General Electric	1938
Bank 12A	1	5694183	7.5/10	N/A	154/115/11.5	OA/FA	DETC	Gas-Blanketed	9730	Wye/Wye/Delta	5.49	49.70	42.10	TV-19681	General Electric	1938
Bank 12B	1	6908127	7.5/10	N/A	154/115/11.5	OA/FA	DETC	Gas-Blanketed	9730	Wye/Wye/Delta	5.52	10.93	9.27	TV-65516	General Electric	1942
Bank 12C	1	6908128	7.5/10	N/A	154/115/11.5	OA/FA	DETC	Gas-Blanketed	9730	Wye/Wye/Delta	5.57	10.93	9.30	TV-65516	General Electric	1942
Bank 13A	1	568446	6.67/8.9	N/A	110/46/12.45	OA/FA	DETC	Gas-Blanketed	4940	Wye/Wye/Delta	9.58	14.57	3.60	TV-25022	Moloney	1938
Bank 13B	1	568445	6.67/8.9	N/A	110/46/12.45	OA/FA	DETC	Gas-Blanketed	4940	Wye/Wye/Delta	9.52	14.45	3.59	TV-25022	Moloney	1938
Bank 13C	1	568444	6.67/8.9	N/A	110/46/12.45	OA/FA	DETC	Gas-Blanketed	4940	Wye/Wye/Delta	9.67	14.60	3.56	TV-25022	Moloney	1938
Bank 13S	1	837499	6.67/8.9	N/A	110/46/12.45	OA/FA	DETC	Gas-Blanketed	4800	Wye/Wye/Delta	9.81	14.56	3.66	TV-90870	Moloney	1947

Note: H=High voltage winding  
 Y=Tertiary winding  
 X=Low voltage winding

POWER FACILITIES (CONT.)

ELECTRIC CONTROLS

From control room in powerhouse:


Guntersville generators, transformers, switchyard, sources of  
auxiliary power, unit auxiliaries, and starting of turbines  
by direct control

Cullman substation by supervisory control.



RESERVOIR AND POWER DATA


Elevation (feet)	Area (acre*1000)	Volume (ac-ft*1000)	Potential Eis (gWh)	Gross Head (feet)	TW Elevation (feet)	Best Efficiency			Maximum Sustainable		
						Plant Output (mW)	Turbine Discharge (cfs)	kW/CFS	Plant Output (mW)	Turbine Discharge (cfs)	kW/CFS
596	72.38	1088.7	239.9	40.0	556	130.0	48,000	2.71	130.0	48,000	2.71
595	68.98	1018.0	223.4	39.0	556	127.8	48,600	2.63	127.8	48,600	2.63
594	65.68	950.7	207.7	38.0	556	125.6	49,200	2.56	125.6	49,200	2.56
593	62.54	886.6	192.9	37.0	556	123.4	49,800	2.48	123.4	49,800	2.48
592	59.56	825.5	178.9	36.0	556	121.2	50,400	2.41	121.2	50,400	2.41
596	72.38	1088.7	236.9	37.0	559	123.4	49,800	2.48	123.4	49,800	2.48
595	68.98	1018.0	220.6	36.0	559	121.2	50,400	2.41	121.2	50,400	2.41
594	65.68	950.7	205.1	35.0	559	119.0	51,000	2.33	119.0	51,000	2.33
593	62.54	886.6	190.4	34.0	559	114.0	50,600	2.25	114.0	50,600	2.25
592	59.56	825.5	176.5	33.0	559	109.0	50,200	2.17	109.0	50,200	2.17

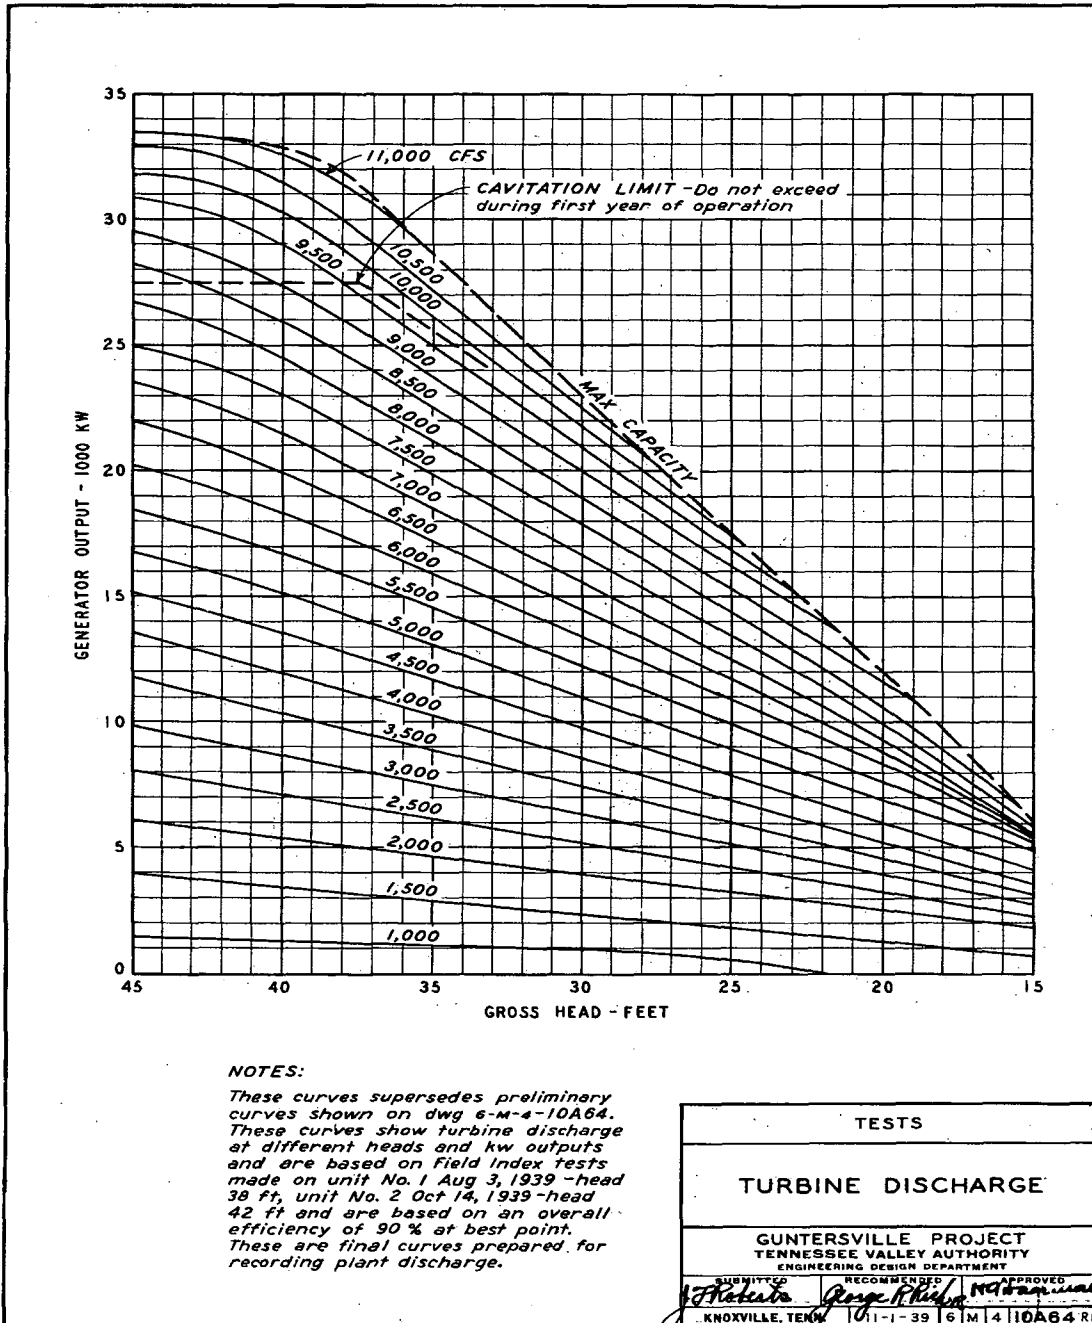

**NOTES:**


These curves supersede preliminary curves shown on dwg 6-M-4-10A64. These curves show turbine discharge at different heads and kw outputs and are based on field index tests made on unit No. 1 Aug 3, 1939 - head 38 ft, unit No. 2 Oct 14, 1939 - head 42 ft and are based on an overall efficiency of 90% at best point. These are final curves prepared for recording plant discharge.

TESTS		
TURBINE DISCHARGE		
GUNTERSVILLE PROJECT TENNESSEE VALLEY AUTHORITY ENGINEERING DESIGN DEPARTMENT		
SUBMITTED <i>J. H. Hester</i>	RECOMMENDED <i>Roger R. Hester</i>	APPROVED <i>McGowan</i>
KNOXVILLE, TENN. 11-1-39 6 M 4 10A64 RI		

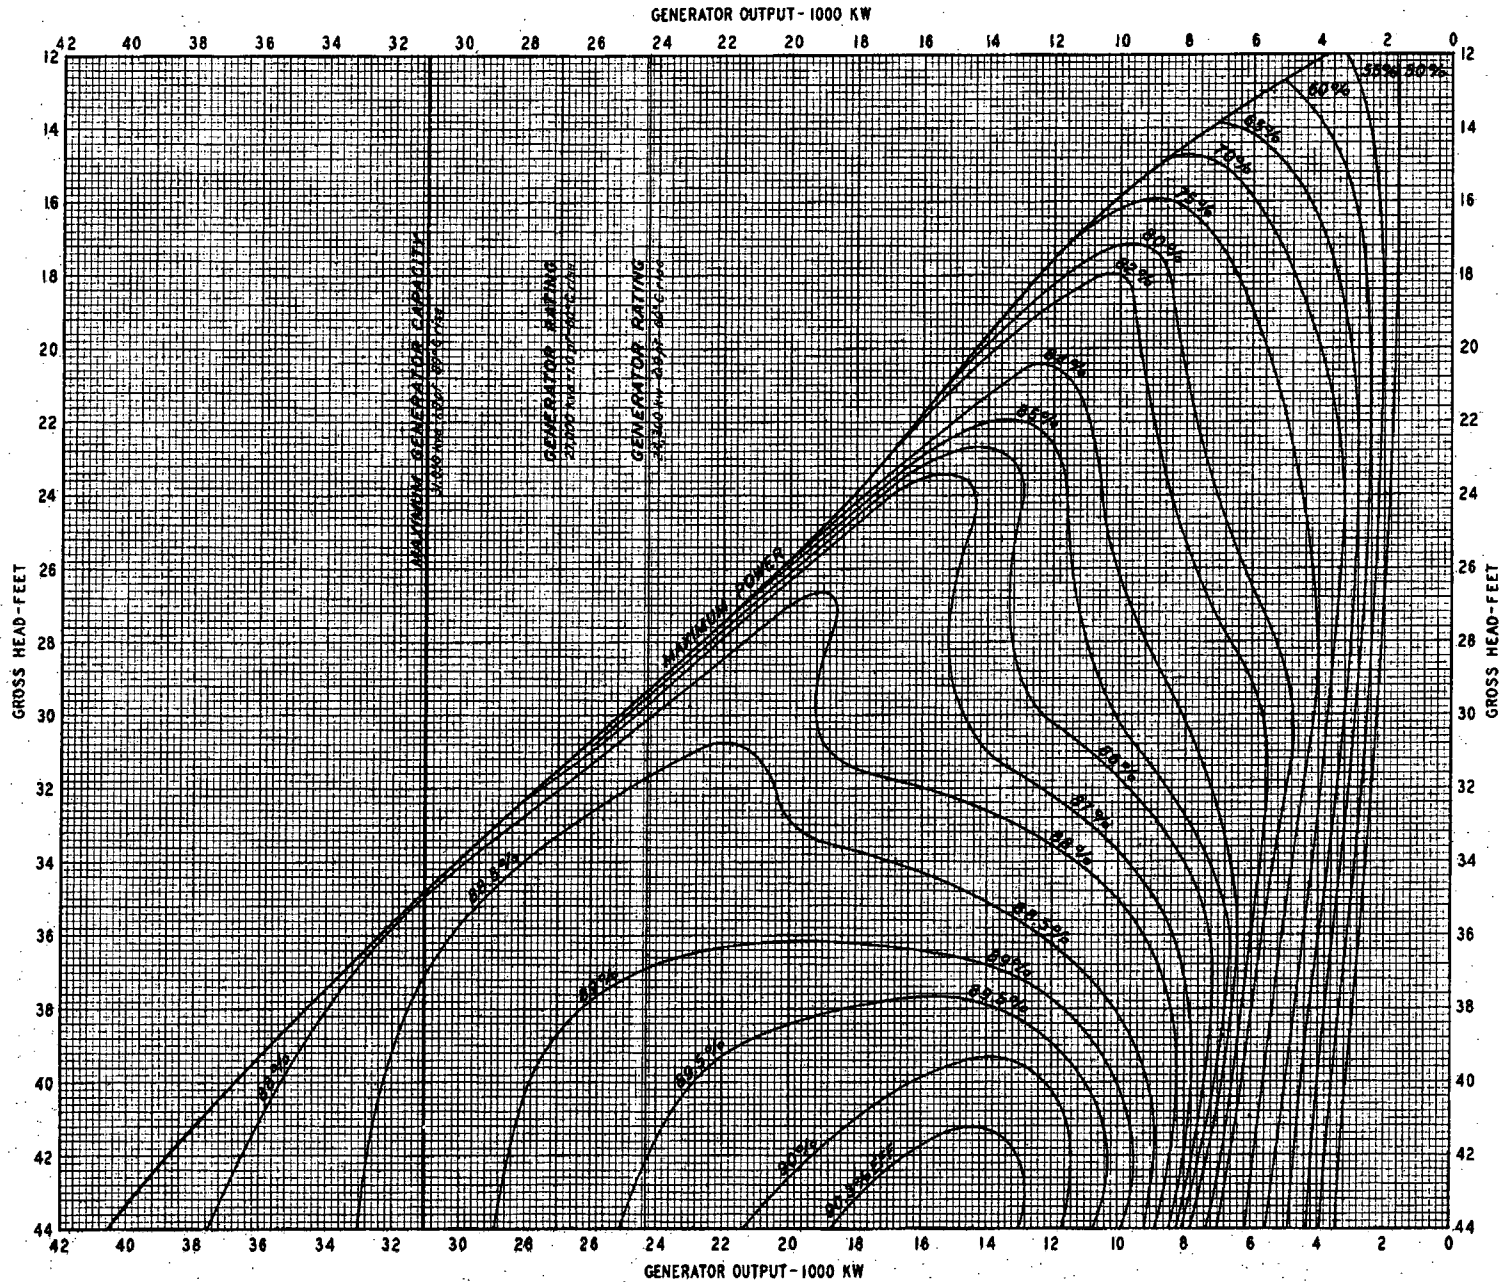

Curves are based on S. Morgan Smith Co. model test No. 1497 and modified in accordance with index test conducted March 21, 1952 at approximately 3677 head.

POWERHOUSE UNIT 4			
<b>OPERATING CHARACTERISTICS OF 27,000 KVA GENERATING UNIT</b>			
GUNTSVILLE PROJECT TENNESSEE VALLEY AUTHORITY			
DIVISION OF DESIGN			
SUBMITTED <i>C. L. Morris</i>	RECOMMENDED <i>R. A. ...</i>	APPROVED <i>F. A. ...</i>	
KNOXVILLE	5-8-52	6 M 4	47K290I

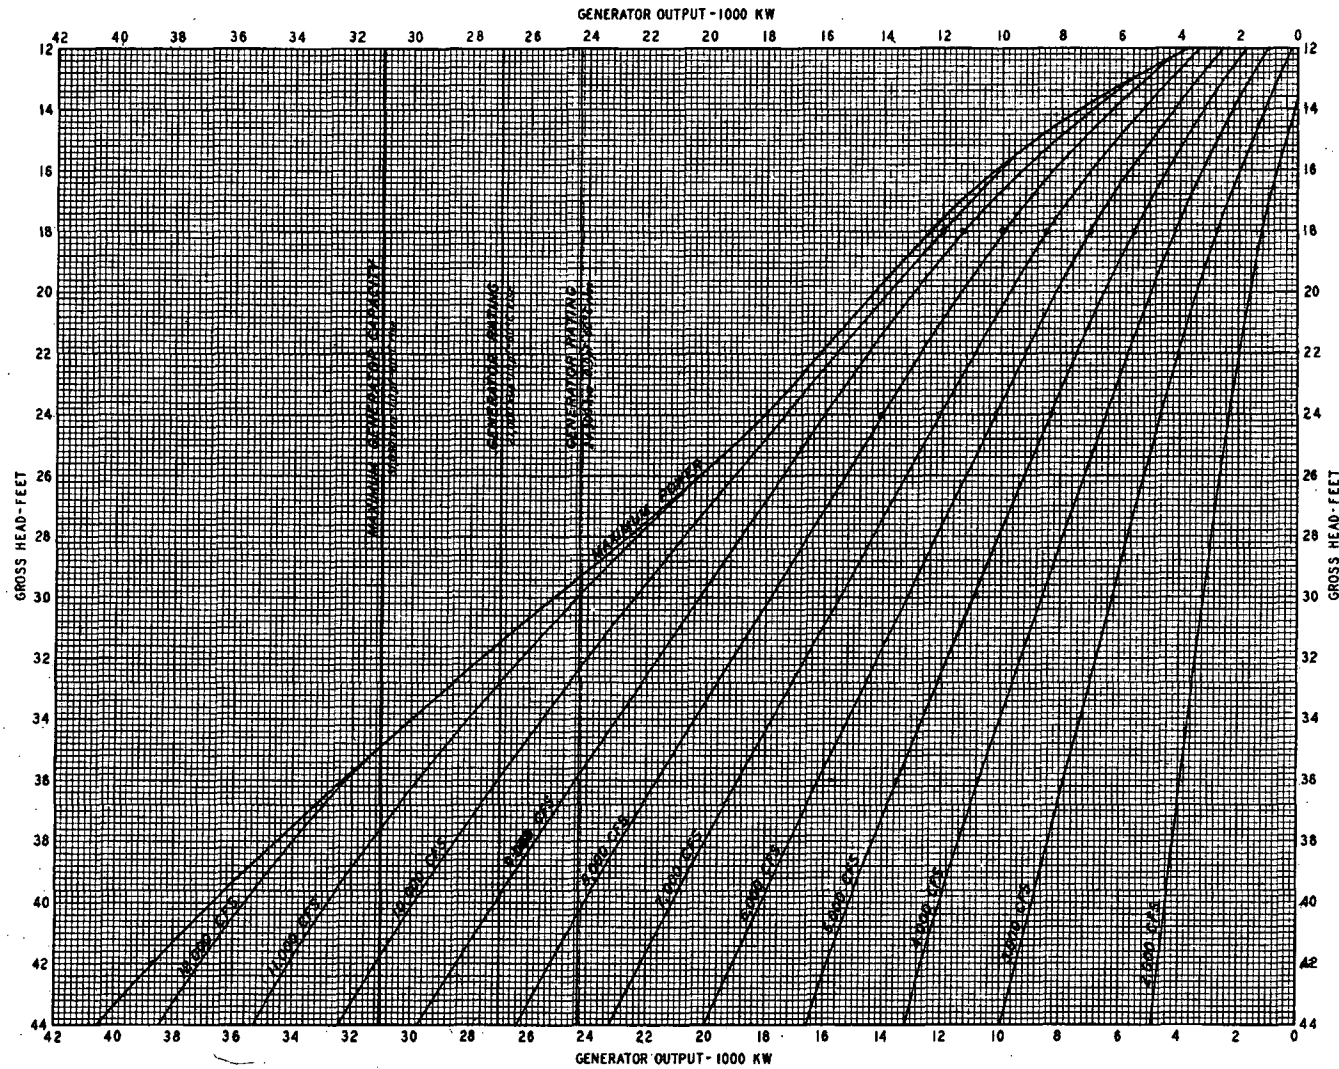

*Curves are based on S. Morgan Smith Co. model test No. 1481 and modified in accordance with index test conducted March 21, 1952 at approximately 36 ft head.*

POWERHOUSE UNIT 4			
<b>DISCHARGE CURVES BASED ON INDEX TEST</b>			
GUNTERSVILLE PROJECT TENNESSEE VALLEY AUTHORITY DIVISION OF DESIGN			
SUBMITTED <i>C. P. ...</i>	DESIGNED <i>W. ...</i>	APPROVED <i>F. O. ...</i>	
KNOXVILLE	5-5-52	8 M 4	47K2900

Guntersville Spill Compilation

Year	Maximum Average Daily Discharge Turbine + Spill	Date	Number of Periods	Total Days	Volumes are average daily in day-second-feet, except as shown Maximum spill, date of maximum, and number of days of spill in each spill period, in this order. "Total Days" is for calendar year and does not always equal the sum of the days in periods because of extension of periods into adjacent years. All spill is through the spillway. Maximum hourly average discharge to date was 314,200 cfs at 5 p.m. on 3/18/73. *Instantaneous value from monthly report graphs (approximate).
1939	*210000	2/17	4	251	210000---2/17---190; 36000---8/9---2; 15000---8/16---4; 27000---8/22---54
1940	*77000	2/20	8	94	50000---2/20---29; 50000---3/15---12; 2000---3/25---2; 35000---3/31---9; 18000---4/15---6; 48000---4/21---17; 39625---8/15---10; 38600---9/1---9
1941	58008	4/7	6	41	18150---1/4-7---7; 17600---3/16---4; 5938---3/21---3; 263---3/24---2; 29258---4/7---9; 25000---7/10---16
1942	219466	12/31	7	78	15850---2/19---3; 71700---3/22---18; 12100---3/29---3; 6500---7/14&15---4; 15958---8/10---4; 41700---8/25-27---14; 11297---10/19---2
1943	223808	1/1	7	105	200500---1/1---79; 85354---3/22---18; 41350---4/23---20; 12000---5/13---10; 4813---7/29---2; 8179---8/3---4; 4542---9/3---2
1944	198975	3/31	8	108	6800---1/4---4; 88200---2/29---37; 63525---3/21---7; 165975---3/31---48; 4850---5/23---3; 7604---9/30---1; 13375---12/19---4; 52500---12/31---38
1945	130000	2/20	14	165	3400---2/6---3; 97000---2/20---37; 18462---3/24---8; 14200---4/3---5; 42150---4/29---26; 6500---6/20---4; 8075---8/2---3; 9350---8/9---4; 3250---8/17---2; 8116---8/24---2; 5850---8/30---3; 1625---9/7---2; 1050---9/12---2; 3366---11/24---2
1946	258728	1/9	25	221	232662---1/9---112; 7162---3/30---2; 1375---4/1---1; 3925---4/11---2; 6219---4/28---2; 14350---5/5---4; 68781---5/18---8; 21158---6/6---4; 1960---6/12---4; 10829---6/19---4; 8500---6/27---3; 6300---7/4&5---3; 12819---7/10---3; 4962---7/18---3; 10700---7/23-25---5; 8400---7/31---3; 10600---8/7---4; 9500---8/14---4; 12000---8/20---3; 4900---8/28---3; 7850---9/19---3; 4000---10/1---5; 2200---10/12---6; 8200---10/31---9; 19300---11/12---33
1947	212316	1/22	3	103	176431---1/22---108; 4898---4/14---1; 7582---12/23---10
1948	242265	2/15	5	133	6733---1/7---2; 8622---1/16---8; 3187---1/29---3; 206702---2/15---64; 42331---4/10---13
1949	233363	1/7	13	237	197800---1/7---109; 9006---3/19---7; 55890---4/1---10; 31245---5/2---5; 89279---7/19---15; 9060---8/3---4; 6333---8/11---4; 9659---8/18---3; 7871---8/24---4; 9185---9/1---5; 11705---10/11---42; 22995---10/20---6; 5298---10/27---3
1950	190850	2/11	5	213	155287---2/11---153; 3747---6/5---2; 9242---7/30---5; 50560---9/11---16; 6283---10/9---65
1951	206700	3/30	5	145	180258---3/30---134; 3800---4/15---3; 26600---4/22---12; 8100---11/20---5; 127000---2/23---78
1952	155300	3/12	2	83	5300---2/24---5; 121000---3/12---26
1953	135400	2/23	5	43	33000---1/10---6; 4500---1/24&25---2; 89500---2/23---29; 9500---5/5---4; 3500---5/20---2

Guntersville Spill Compilation

Year	Maximum Average Daily Discharge Turbine + Spill	Date	Number of Periods	Total Days	Volumes are average daily in day-second-feet, except as shown Maximum spill, date of maximum, and number of days of spill in each spill period, in this order. "Total Days" is for calendar year and does not always equal the sum of the days in periods because of extension of periods into adjacent years. All spill is through the spillway. Maximum hourly average discharge to date was 314,200 cfs at 5 p.m. on 3/18/73. *Instantaneous value from monthly report graphs (approximate).
1954	223400	1/24	3	23	181600---1/24---16; 4500---3/2&3---2; 7700---3/5---2
1955	149200	3/24	5	30	52800---1/1---7; 34000---2/9---7; 28100---2/24---4; 104700---3/24---13; 9700---4/7---2
1956	193200	2/5	9	58	150300---2/5---10; 7200---2/14&15---2; 70800---2/21---17; 7900---3/9---4; 68600---3/18---10; 7600---4/6---2; 29500---4/17---5; 64900---12/15---6; 9400---12/23&24---2
1957	252700	2/2	4	92	211700---2/2---37; 5300---3/10---3; 14900---4/7---5; 188900---11/20---54
1958	144900	4/30	5	44	8600---1/4---2; 8000---1/27---5; 36900---2/7---12; 99100---4/30---5; 37200---5/11---13
1959	120400	12/21	3	36	69900---1/24---5; 10500---2/17---2; 74400---12/21---29
1960	106100	3/4	3	38	13300---1/8---16; 42300---2/21---11; 60000---3/4---11
1961	219300	12/20	2	50	161800---2/25---29; 177400---12/20---23
1962	225900	2/26	6	83	34600---1/8---9; 3300---1/16---2; 7100---1/20---3; 176600---1/29---23; 183600---2/26---34; 70100---4/12---10
1963	254000	3/16	4	34	15700---2/5---4; 3400---2/11---2; 213800---3/16---22; 80100---4/30---6
1964	156600	3/16	10	98	28200---1/11---5; 36300---1/27---7; 27100---2/18---5; 45600---3/8---4; 112900---3/16---18; 97200---4/9---14; 54200---5/3---10; 8500---12/1---3; 7900---12/7---6; 23600---12/14---21
1965	218700	3/29	6	43	3600---1/4---4; 51400---1/13---12; 49800---2/13---9; 6700---3/2---1; 7100---3/7---2; 177200---3/29---15
1966	141300	2/16	4	33	97900---2/16---8; 25500---3/7---7; 10300---5/4---3; 19600---12/13---13
1967	167000	12/22	8	96	21100---1/1---6; 39200---2/22---12; 63200---3/10---11; 3500---6/5---1; 95700---7/9---10; 9000---8/4---3; 18900---11/4---16; 123900---12/22---65
1968	164900	1/12	2	30	12000---3/15---2; 4700---5/18---2
1969	181500	12/31	3	33	49400---1/21---6; 134900---2/3---19; 28300---5/20---6
1970	207600	1/1	6	34	163800---1/1---14; 14500---2/4---5; 7200---2/19---1; 38800---4/4---5; 84100---4/29---7; 9000---12/25---4
1971	121700	2/7	5	64	55800---1/25---6; 74600---2/7---14; 63500---3/1---18; 30600---5/14---5; 63900---12/8---21
1972	162500	12/13	7	118	89100---1/13---39; 11000---2/22---7; 69300---3/4&5---15; 18900---3/30---6; 22300---4/23---3; 34400---5/16---8; 116200---12/13---53
1973	304400	3/19	5	155	53400---2/15---33; 262300---3/19---24; 57300---4/28---19; 147300---5/31---24; 22100---6/18---7

Guntersville Spill Compilation

Year	Maximum Average Daily Discharge Turbine + Spill	Date	Number of Periods	Total Days	Volumes are average daily in day-second-feet, except as shown Maximum spill, date of maximum, and number of days of spill in each spill period, in this order. "Total Days" is for calendar year and does not always equal the sum of the days in periods because of extension of periods into adjacent years. All spill is through the spillway. Maximum hourly average discharge to date was 314,200 cfs at 5 p.m. on 3/18/73. *Instantaneous value from monthly report graphs (approximate).
1974	189600	1/15	7	104	144700---1/15---99; 3600---3/11---2; 63800---3/23---8; 53100---4/6---14; 16700---5/25---6; 17400---6/1---3; 5800---9/7---2
1975	205300	3/15	5	117	72800---2/19---68; 161500---3/15---34; 17700---5/20---5; 26200---9/24---3; 13800---11/15-16---8
1976	89000	1/3	6	53	39300---1/3---16; 11700---1/16&17---7; 25500---1/29---12; 10600---2/21---5; 26500---7/5---5; 12000---12/15---12
1977	204700	4/6	7	104	8200---1/2---1; 28800---1/11-12---11; 66900---3/14---7; 158800---4/6---17; 28600---10/11---4; 19400---10/27---7
1978	130700	1/29	5	63	81300---1/29---96; 32700---3/15---11; 22000---5/8---3; 15600---5/12---3; 18400---12/10---5
1979	195500	3/5	13	188	53200---1/3---19; 80000---1/24---16; 151000---3/5---23; 21400---3/29---10; 89400---4/14---14; 4100---4/26---2; 20200---5/4---3; 37600---5/25---5; 80300---6/2---13; 8000---7/12---2; 57700---7/27---18; 45800---9/29---22; 51800---11/12---43
1980	218300	3/22	6	70	49900---1/27---25; 41600---3/9---8; 174700---3/22---20; 51200---4/14---6; 11900---5/17---2; 13900---5/26---9
1981	49000	2/13	0	0	
1982	170100	1/4	6	117	125300---1/4---17; 75300---2/18---44; 43400---3/16&18---19; 12000---8/18---3; 5500---9/15---2; 106400---12/2---38
1983	153500	5/21	12	92	9600---1/12---3; 7700---1/19---2; 34700---2/6---17; 100100---4/7---10; 8200---4/20---3; 12000---4/23-26---5; 108900---5/21---14; 14600---6/7---6; 70100---11/29---4; 85500---12/4---7; 22200---12/14---5; 41800---12/30-31---14
1984	243900	5/9	9	72	31400---2/16---5; 28000---2/29---9; 19600---3/23-24---5; 16400---3/30-31---5; 5700---4/6---2; 212000---5/9---31; 11900---6/5-6---4; 9200---8/1-3---5; 5545---11/29---2
1985	106016	2/2	2	14	58935---2/2---10; 18538---2/13---4
1986	96185	11/28	3	43	21975---2/20---7; 49830---11/28---10; 23070---12/12---26
1987	140558	2/28	2	42	54444---1/20---24; 95442---2/28---18
1988	112335	1/21	1	6	64687---1/21---6
1989	187040	10/1	10	169	94485---1/14---15; 16162---2/8---3; 10657---2/14---4; 74114---3/7---23; 12313---4/11---4; 16947---5/11---2; 155671---6/23---35; 141533---10/1---25; 5649---10/25---9; 44702---11/18---49
1990	250905	12/24	7	111	197045---2/17---85; 6019---5/4---2; 25623---5/11---5; 11898---5/16---3; 6177---5/22---2; 3784---6/9---4; 208154---12/24---34

Guntersville Spill Compilation

Year	Maximum Average Daily Discharge Turbine + Spill	Date	Number of Periods	Total Days	Volumes are average daily in day-second-feet, except as shown Maximum spill, date of maximum, and number of days of spill in each spill period, in this order. "Total Days" is for calendar year and does not always equal the sum of the days in periods because of extension of periods into adjacent years. All spill is through the spillway. Maximum hourly average discharge to date was 314,200 cfs at 5 p.m. on 3/18/73. *Instantaneous value from monthly report graphs (approximate).
1991	214599	2/21	7	105	83360---1/3---34; 169838---2/21---30; 57817---4/2---11; 2006---5/2---2; 18883---5/6---3; 13666---6/25---4; 146283---12/4---42
1992	125584	12/29	6	66	75946---1/7---42; 11632---1/15---3; 29388---2/28---9; 8216---11/7---5; 34022---11/26---5; 77240---12/27&29---37
1993	160242	3/25	6	70	65185---1/1---37; 40996---1/26---9; 6109---2/26---2; 33293---3/9---14; 114502---3/25---14; 30918---12/8---9
1994	251768	3/28	8	129	165731---2/12---68; 205954---3/28---34; 17511---6/30---4; 5803---7/12---2; 11035---7/31---6; 16660---11/30---4; 21790---12/5&6---6; 21870---12/13---5
1995	149003	10/6	6	70	76886---1/18---21; 91933---2/17---16; 81985---3/9---13; 1235---10/3---1; 103628---10/6---4; 32500---11/9---15;
1996	176475	1/30	7	17	130317---1/30---51; 79815---3/7---14; 5510---3/23---4; 22080---4/22---3; 27640---6/13---7; 5510---9/8---6; 78219---12/5---32
1997	170493	3/5	11	119	70777---1/30---42; 123295---3/5---31; 94317---5/4---10; 50756---6/2---5; 5569---6/7---6; 98379---6/18---6; 17568---6/23---4; 11767---7/3---2; 22208---10/28---4; 13347---11/5---4; 13509---11/11---5
1998	210552	4/21	5	113	84198---1/9---55; 46410---3/11---9; 25387---3/22---8; 165713---4/22---29; 34775---6/12---12
1999	122818	5/7	5	46	65524---1/25---25; 24262---3/9---8; 31337---3/14---3; 73424---5/7---5; 29300---7/15---5



ANNUAL MAXIMUM AND MINIMUM ELEVATIONS, IN ORDER OF MAGNITUDE

RIVER SCHEDULING  
TVA OPERATED RESERVOIR SYSTEM  
ANNUAL MAXIMUM AND MINIMUM ELEVATIONS, IN ORDER OF MAGNITUDE  
FROM DATE OF RESERVOIR CLOSURE THROUGH 1999

## GUNTERSVILLE

MAXIMUM					MINIMUM				
ORDER	ELEVATION	YEAR	MONTH	DAY	ORDER	ELEVATION	YEAR	MONTH	DAY
1	596.29	1944	MAR.	2	1	567.20 *	1939	JAN.	16
2	595.86	1942	DEC.	28	2	590.65	1968	NOV.	12
3	595.77	1997	MAY	3	3	590.85	1964	NOV.	19
4	595.72	1973	MAR.	18	4	591.65	1953	SEP.	8
5	595.69	1963	APR.	29	5	591.90	1975	OCT.	4
6	595.68	1995	OCT.	5	6	591.90	1976	SEP.	27
7	595.65	1946	APR.	10	7	591.90	1978	SEP.	17
8	595.60	1949	MAY	1	8	591.95	1974	OCT.	5
9	595.57	1945	APR.	28	9	591.98	1977	SEP.	25
10	595.56	1950	JUNE	5	10	592.00	1940	DEC.	10
11	595.55	1941	JULY	11	11	592.00	1983	JULY	23
12	595.53	1984	APR.	25	12	592.00	1987	JUNE	25
13	595.49	1948	APR.	10	13	592.02	1982	NOV.	12
14	595.49	1951	APR.	23	14	592.06	1944	FEB.	7
15	595.49	1953	MAY	2	15	592.22	1980	OCT.	6
16	595.49	1958	APR.	29	16	592.32	1989	JUNE	2
17	595.48	1990	FEB.	16	17	592.33	1965	JAN.	1
18	595.46	1966	MAY	4	18	592.35	1970	NOV.	9
19	595.45	1960	MAY	13	19	592.37	1981	OCT.	18
20	595.45	1968	MAY	4	20	592.39	1948	OCT.	12
21	595.45	1976	JULY	5	21	592.39	1950	JAN.	31
22	595.45	1982	JAN.	3	22	592.39	1956	FEB.	25
23	595.45	1991	JUNE	15	23	592.40	1979	SEP.	13
24	595.44	1957	MAY	13	24	592.41	1949	JAN.	18
25	595.44	1961	APR.	15	25	592.43	1971	OCT.	26
26	595.43	1971	APR.	25	26	592.45	1945	FEB.	28
27	595.42	1969	MAY	20	27	592.55	1952	MAR.	4
28	595.42	1989	SEP.	30	28	592.55	1955	SEP.	16
29	595.41	1943	MAY	15	29	592.56	1951	JAN.	3
30	595.41	1947	APR.	14	30	592.57	1946	JAN.	15
31	595.41	1954	APR.	18	31	592.60 †	1941	MAR.	3
32	595.41	1993	MAY	7	32	592.60	1961	DEC.	23
33	595.40	1959	MAY	26	33	592.60	1962	MAR.	20
34	595.40	1972	APR.	23	34	592.62	1973	DEC.	13
35	595.40	1983	MAY	23	35	592.62	1990	DEC.	30
36	595.39	1956	APR.	17	36	592.63	1954	FEB.	1
37	595.39	1999	JUNE	26	37	592.65	1947	FEB.	1
38	595.38	1955	JULY	11	38	592.65	1969	APR.	22
39	595.38	1964	APR.	9	39	592.70	1958	DEC.	7
40	595.38	1965	APR.	19	40	592.70	1960	FEB.	5
41	595.37	1988	APR.	19	41	592.70	1963	FEB.	26
42	595.37	1994	JUNE	20	42	592.70	1967	DEC.	10
43	595.35	1962	APR.	14	43	592.73	1957	AUG.	23
44	595.35	1967	APR.	28	44	592.75	1943	FEB.	5
45	595.34	1996	JAN.	7	45	592.76	1966	FEB.	10
46	595.33	1987	MAY	24	46	592.76	1972	FEB.	24
47	595.31	1974	JAN.	13	47	592.77	1984	FEB.	12
48	595.30	1970	APR.	22	48	592.78	1959	AUG.	14
49	595.30	1979	APR.	13	49	592.85	1985	JAN.	1
50	595.30	1980	MAR.	21	50	592.85	1991	JAN.	16
51	595.30	1985	APR.	18	51	592.87	1995	JAN.	4
52	595.29	1952	JUNE	15	52	592.88	1998	NOV.	10
53	595.28	1940	APR.	4	53	592.89	1986	AUG.	10
54	595.23	1992	NOV.	24	54	592.90	1988	MAR.	1
55	595.21	1939	JULY	3	55	592.92	1999	DEC.	4

ANNUAL MAXIMUM AND MINIMUM ELEVATIONS, IN ORDER OF MAGNITUDE (CONT.)

RIVER SCHEDULING  
TVA OPERATED RESERVOIR SYSTEM  
ANNUAL MAXIMUM AND MINIMUM ELEVATIONS, IN ORDER OF MAGNITUDE  
FROM DATE OF RESERVOIR CLOSURE THROUGH 1999

## GUNTERSVILLE

MAXIMUM					MINIMUM				
ORDER	ELEVATION	YEAR	MONTH	DAY	ORDER	ELEVATION	YEAR	MONTH	DAY
56	595.20	1998	JULY	19	56	592.95	1992	FEB.	13
57	595.18	1975	OCT.	20	57	592.96	1994	DEC.	23
58	595.16	1986	MAY	31	58	592.96	1996	DEC.	17
59	595.15	1977	MAR.	14	59	592.98 *	1942	NOV.	12
60	595.15	1978	JULY	3	60	592.98	1993	DEC.	25
61	595.10	1981	APR.	30	61	593.01	1997	DEC.	17

\* CLOSURE  
% MIDNIGHT ELEVATION  
TOP-OF-GATES ELEVATION 595.44

AVERAGE WEEKLY CFS


MAXIMUM, MINIMUM, MEDIAN, AND MEAN  
Adjusted Flow by Weeks  
Guntersville  
Years = 1903-1999


WEEK ENDING	WEEK NO.	MAXIMUM YR	MINIMUM YR	MEDIAN	MEAN
JAN 7	1	232,000 1949	7,920 1940	51,000	64,800
JAN 14	2	268,000 1946	8,130 1981	52,500	62,100
JAN 21	3	339,000 1947	10,900 1981	51,700	60,700
JAN 28	4	215,000 1962	7,700 1940	58,300	69,800
FEB 4	5	429,000 1957	7,810 1940	56,300	70,600
FEB 11	6	208,000 1957	12,900 1934	58,000	71,500
FEB 18	7	294,000 1948	12,000 1934	60,300	75,500
FEB 25	8	247,000 1961	10,800 1934	65,400	76,000
MAR 4	9	215,000 1997	13,200 1941	64,100	73,200
MAR 11	10	255,000 1917	22,900 1986	69,800	79,400
MAR 18	11	361,000 1973	20,600 1931	65,800	83,700
MAR 25	12	287,000 1980	17,600 1988	64,800	75,200
APR 1	13	377,000 1994	17,200 1988	62,800	81,900
APR 8	14	343,000 1977	17,800 1910	60,900	74,000
APR 15	15	199,000 1936	15,200 1986	53,100	64,600
APR 22	16	292,000 1998	14,100 1986	48,600	56,000
APR 29	17	139,000 1958	11,200 1986	47,900	50,600
MAY 6	18	150,000 1984	9,130 1986	40,500	49,700
MAY 13	19	304,000 1984	9,570 1986	38,700	46,300
MAY 20	20	96,100 1946	11,300 1941	35,800	39,700
MAY 27	21	141,000 1983	7,620 1941	30,700	36,200
JUN 3	22	147,000 1973	7,980 1988	26,300	34,500
JUN 10	23	133,000 1909	4,230 1988	25,900	32,800
JUN 17	24	130,000 1989	4,000 1988	24,600	29,500
JUN 24	25	139,000 1989	3,900 1986	23,300	26,400
JUL 1	26	70,800 1928	3,160 1988	20,900	24,100
JUL 8	27	110,000 1989	4,360 1988	20,200	25,000
JUL 15	28	150,000 1916	6,190 1970	19,600	26,300
JUL 22	29	120,000 1916	4,080 1986	18,700	25,200
JUL 29	30	104,000 1938	4,320 1986	18,900	23,600
AUG 5	31	72,100 1971	1,580 1986	17,900	21,400
AUG 12	32	57,900 1942	4,020 1957	18,200	20,000
AUG 19	33	151,000 1920	3,930 1954	16,700	21,200
AUG 26	34	97,700 1920	4,250 1987	15,600	19,100
SEP 2	35	55,400 1950	4,020 1953	13,600	17,500
SEP 9	36	103,000 1928	1,720 1998	13,200	16,400
SEP 16	37	58,300 1928	2,470 1954	13,200	15,200
SEP 23	38	47,200 1920	3,120 1999	11,800	14,400
SEP 30	39	102,000 1989	4,200 1954	11,700	16,300
OCT 7	40	134,000 1989	3,770 1986	11,200	18,400
OCT 14	41	80,800 1906	2,320 1987	11,600	15,000
OCT 21	42	71,200 1975	3,160 1954	12,000	15,700
OCT 28	43	62,700 1977	3,300 1998	12,900	16,500
NOV 4	44	109,000 1918	3,290 1954	13,500	18,300
NOV 11	45	153,000 1977	2,710 1953	14,100	20,200
NOV 18	46	160,000 1957	4,480 1953	14,600	22,600
NOV 25	47	157,000 1957	6,050 1954	20,200	28,900
DEC 2	48	202,000 1948	6,630 1956	21,700	34,000
DEC 9	49	142,000 1991	5,900 1987	30,100	35,700
DEC 16	50	222,000 1972	6,960 1939	30,800	41,600
DEC 23	51	231,000 1961	6,450 1958	29,700	44,800
DEC 31	52	210,000 1926	8,000 1965	45,000	53,200

AVERAGE FLOW: 1903 - 1999 = 41100 CFS

RIVER SYSTEM OPERATIONS

### ANNUAL OPERATING CYCLE

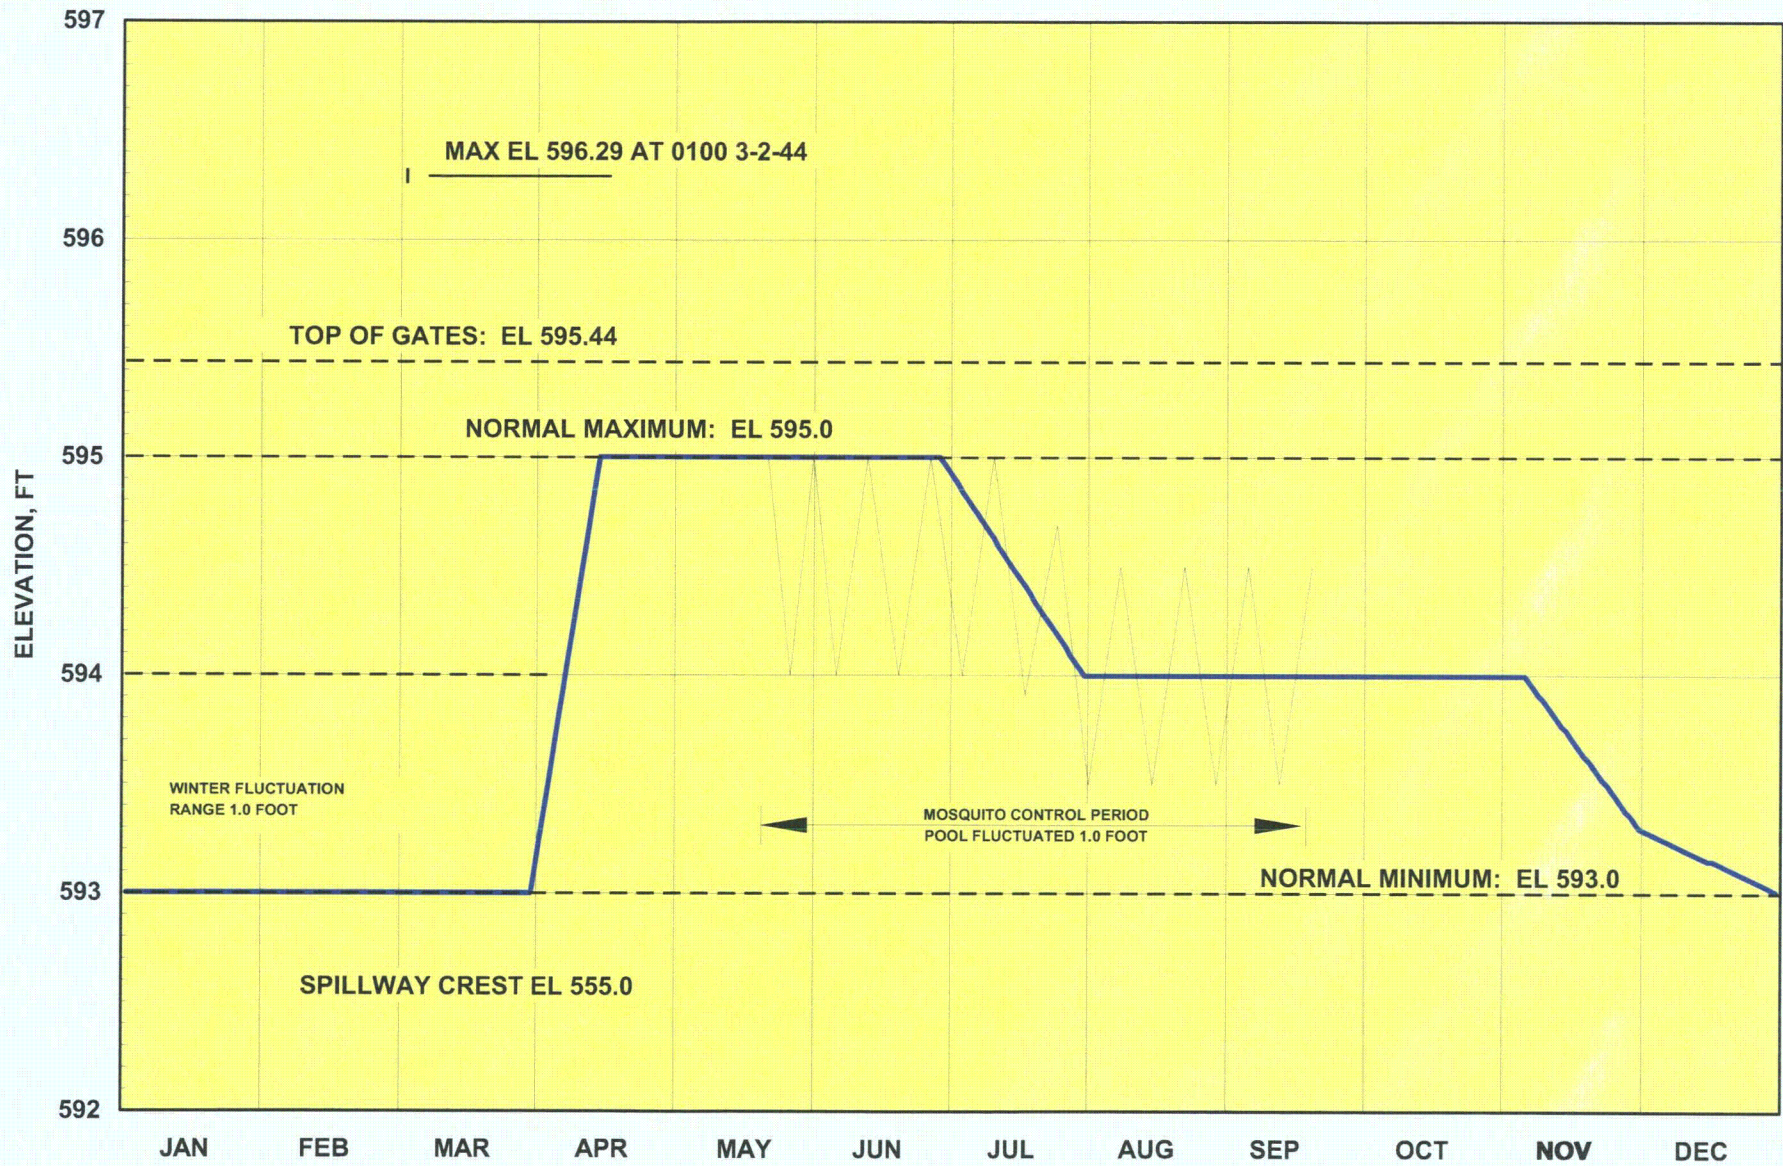

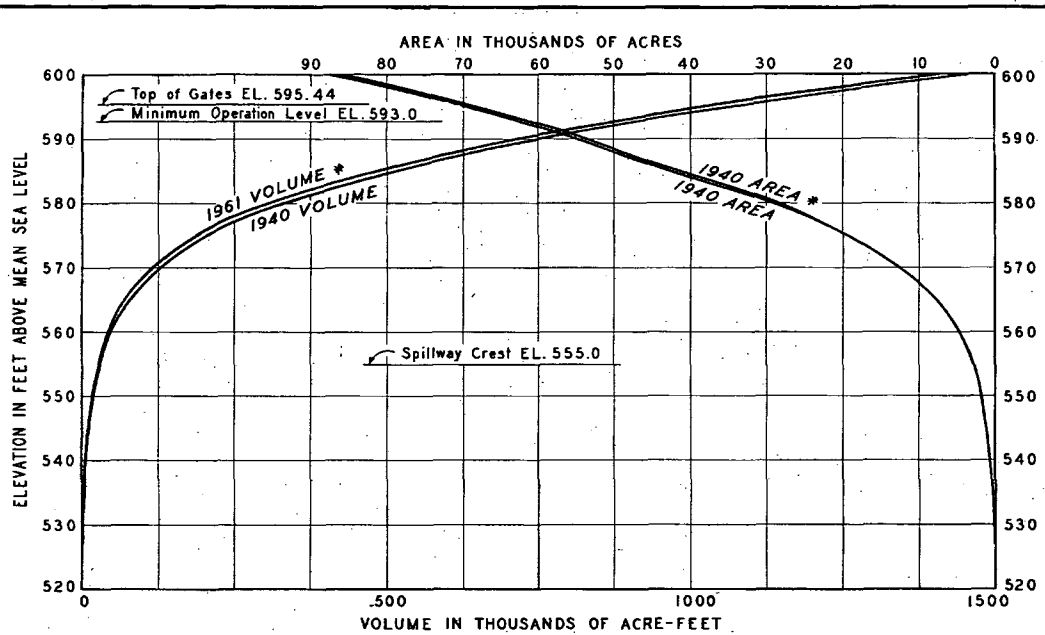

ELEV FT	1940 AREA AC	VOLUME				1940 AREA* AC	VOLUME*	
		1940 AC-FT	1947 AC-FT	1956 AC-FT	1961 AC-FT		1940 AC-FT	1961 AC-FT
600	87,700	1,436,000	1,440,000	1,432,000	1,423,000	86,800	1,438,000	1,406,000
595.44	71,200	1,097,000	1,081,000	1,073,000	1,064,000	70,200	1,065,000	1,052,000
595	69,100	1,063,000	1,046,000	1,039,000	1,030,000	67,900	1,050,000	1,018,000
590	54,500	752,000	735,000	728,000	719,000	53,600	745,000	712,000
585	42,600	510,000	492,000	487,000	477,000	41,800	506,000	474,000
580	29,100	330,000	316,000	311,000	301,000	28,700	330,000	301,000
570	12,400	127,000	121,000	117,000	113,000	12,400	127,000	113,000
560	4,480	46,800	44,000	40,800	39,100	4,480	46,800	39,100
550	1,800	17,650	16,600	14,500	14,400	1,800	17,650	14,800
540	880	4,470	4,220	3,210	3,910	880	4,470	3,910
530	15	25	14	2	0	15	25	0
526.6	0	0	0	0	0	0	0	0

NOTES:

Reservoir areas at elevation 580 and above were measured on navigation maps, scale 1"=2,000' showing field located contours at elevations 580, 585, 590, 595 and 600. Supplementary measurements were made on TVA land maps, scale 1"=500' with field located contours at elevations 595 and 600. Contours were drawn at 10' intervals and made to conform to elevations on TVA sediment range cross sections located at five to ten mile intervals. The 1940 volume was computed by the contour method. Volumes of sediment on succeeding dates were computed by the constant factor method.

Elevations are referred to the USC & GS 1929 General Adjustment.

Area of original river within reservoir = 12,065 acres.

Drainage area at dam = 24,450 square miles.

Dam closure January 16, 1939.

\*Adjusted due to closure of Nickajack Dam Dec. 14, 1967, reducing length of Guntersville Reservoir by 6.4 miles.

## SAFETY MODIFICATIONS FOR PROBABLE MAXIMUM FLOOD

### Chronology

Safety analysis studies for Guntersville Dam for the Probable Maximum Flood (PMF) were started in August 1984 and completed in February 1993. Final design started in April 1993. Onsite construction began in 1994 and was completed on June 30, 1995.

### Cost of Modification

Design costs for the capital safety modifications to Guntersville Dam were approximately \$5,460,000. Construction costs were approximately \$31,869,070. The total project cost was approximately \$37.3 million. This did not include costs for dam safety evaluation studies which resulted in the modifications.

### Controlling Features

The embankments at Guntersville Dam were modified in order to safely pass the probable maximum flood. The embankments were raised to an elevation of 617.5 from the lowest embankment elevation of 610.0. The modifications to the south embankment consisted of a cantilever concrete wall, impervious earthfill embankment, and a stoplog system at the powerhouse. The modifications to the north embankment consisted of a cantilever concrete wall, sheet pile cells/wall cutoff, and a structural slab. These PMF modifications will prevent overtopping and erosion of the embankments and thus prevent breach and failure of the dam.

CONSTRUCTION DATAHOUSING FACILITIES  
(Initial Project)

Permanent houses built..... None  
 Semipermanent houses built..... 36  
 Dormitories built:  
     Staff (52 capacity)..... 1  
     Men (360 total capacity)..... 6  
     Women (25 capacity)..... 1  
 Public buildings constructed included a cafeteria (192 seats),  
 hospital (18 beds), two community and recreation buildings, and gas  
 station.

PERSONNEL  
Initial Project

	<u>Total</u>	Dam Construction		
		<u>Only</u>	<u>Unit 4</u>	<u>Main Lock</u>
Peak employed	3,500	1,800	180	560*
Total man-hours	13,824,356	7,468,771	556,985	2,002,320
Number of injuries	524	204	8	25
Days lost	41,578	27,548	279	7,757
Fatalities	3	3	0	0
Accident frequency	37.9	27.3	14.4	12.49
Accident severity	3,008	3,688	501	3,874

\*Approximate.

## QUANTITIES

	<u>Initial Project</u>	<u>Unit 4</u>
Dam, lock, and power facilities:		
Earth excavation	409,000 cu. yd	
Rock excavation	129,000 cu. yd	
Earthfill	836,500 cu. yd	
Riprap	38,400 cu. yd	
Concrete	295,700 cu. yd	12,940 cu. yd
Reinforcing steel	4,600 tons	430 tons
Structural steel, powerhouse	1,206 tons	
Formwork	1,500,000 sq. ft	83,680 sq. ft
Highway and railroad:		
Excavation	2,150,000 cu. yd	



CONSTRUCTION DATA (CONT.)

## QUANTITIES (CONT.)

## Main lock:

Earth excavation.....	981,000	cu. yd
Rock excavation.....	55,600	cu. yd
Dredging.....	177,000	cu. yd
Rolled fill.....	104,000	cu. yd
Backfill.....	83,000	cu. yd
Concrete.....	205,500	cu. yd
Reinforcing steel.....	1,600	tons
Formwork.....	783,000	sq. ft



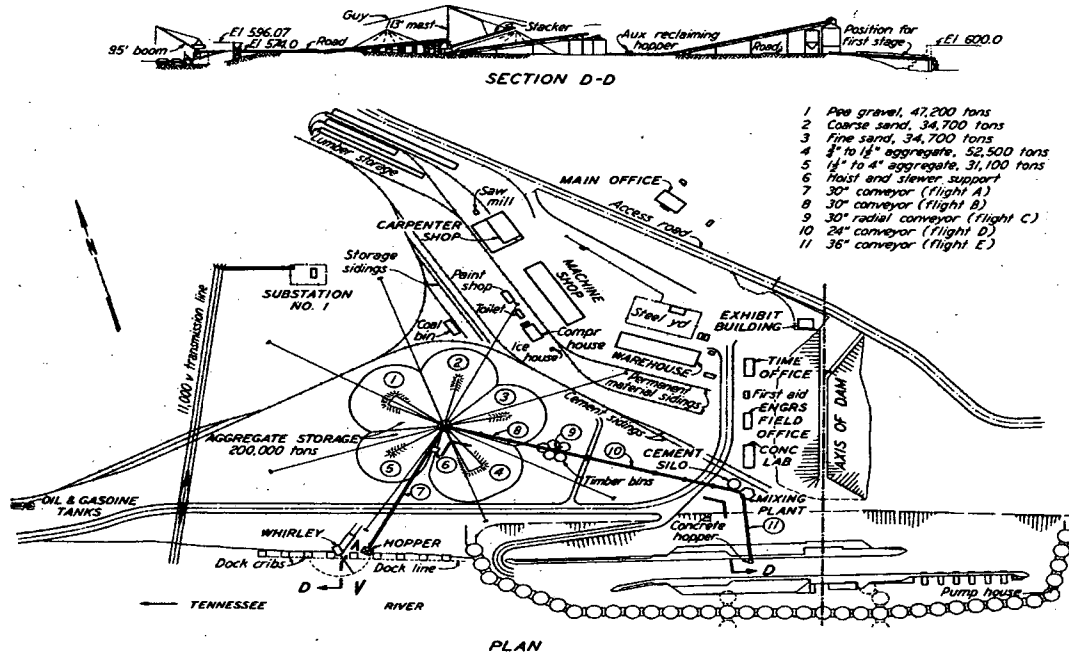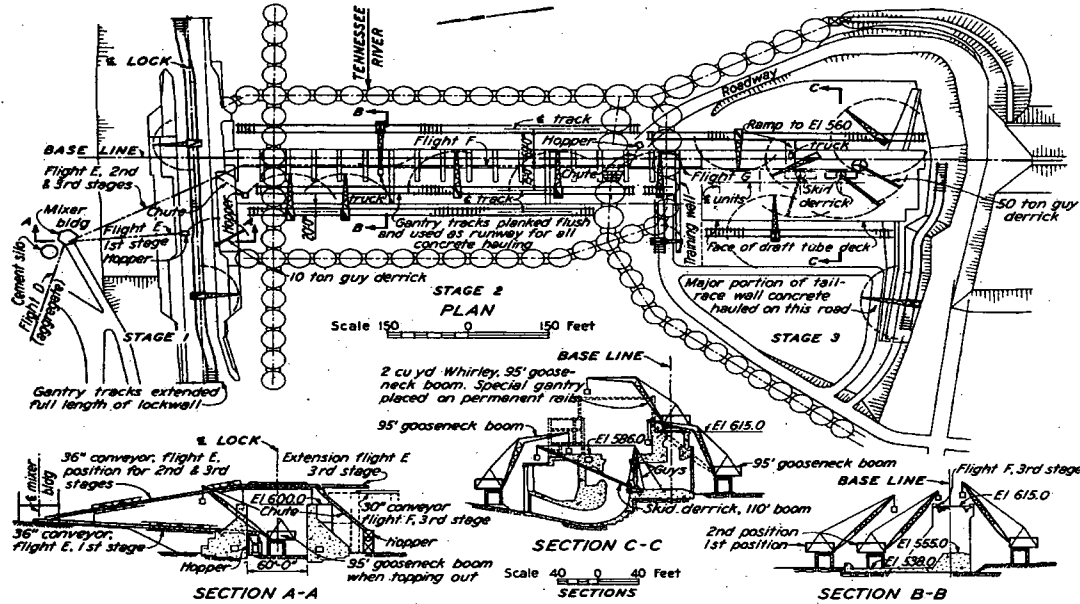

- 2 Coarse sand, 34,700 tons
- 3 Fine sand, 34,700 tons
- 4 3/4" to 1 1/2" aggregate, 52,500 tons
- 6 Hoist and slewer support
- 7 30" conveyor (Flight A)
- 8 30" conveyor (Flight B)
- 9 30" radial conveyor (Flight C)
- 10 24" conveyor (Flight D)
- 11 36" conveyor (Flight E)

CONSTRUCTION PLANT LAYOUT

STAGES	NQ	ITEM OR EQUIPMENT	1936												1937												1938												1939												1940															
			J	F	M	A	M	J	J	A	S	O	N	D	J	F	M	A	M	J	J	A	S	O	N	D	J	F	M	A	M	J	J	A	S	O	N	D	J	F	M	A	M	J	J	A	S	O	N	D	J	F	M	A	M	J	J	A	S	O	N	D				
CONSTRUCTION PLANT & SERVICES	A	ACCESS ROADS AND RAILROADS	STAGE 1												STAGE 2												STAGE 3																																							
	B	CAMP AND PLANT BUILDINGS	
	C	MIXER PLANT, AGGREGATE AND CONCRETE HANDLING FACILITIES	
EARTH FILL DAM	NORTH SIDE	21	STRIPPING AND GRUBBING	
		25	PREPARING & GROUTING FOUNDATION	
		26	CUTOFF WALL, SHEET PILING	
	SOUTH SIDE	27	CUTOFF WALL, SHEET PILING	
		29	EARTH EMBANKMENT, ROLLED	
		31	RIP RAP	
CONCRETE - LOCK - SPILLWAY - POWERHOUSE	STAGE NO. 1	LOCK	1	COFFERDAM ERECTION	
			2	COFFERDAM FILL	
	STAGE NO. 2	15 BAYS SPILLWAY	SPILLWAY	3	FOUNDATION EXCAVATION - EARTH	
				4	FOUNDATION EXCAVATION - ROCK	
	STAGE NO. 3	3 BAYS SPILLWAY & TRAINING WALL	POWERHOUSE	5	PREPARING & GROUTING FOUNDATION	
				6	CONCRETE	
	INSTALLATION GATES & MACHINERY	STAGE NO. 1	LOCK	7	CONCRETE - LOCK MITER SILL	
				10	INSTALLATION OF EMBEDDED PARTS	
		STAGE NO. 2	15 BAYS SPILLWAY	SPILLWAY	19	REMOVAL OF COFFERDAM	
GENERAL		STAGE NO. 1	LOCK	18	BACKFILL	
				19	REMOVAL OF COFFERDAM	
		STAGE NO. 2	15 BAYS SPILLWAY	SPILLWAY	41	LOCK GATES & OPERATING MECHANISM	
					42	GATES - SPILLWAY	
	STAGE NO. 3	3 BAYS SPILLWAY & TRAINING WALL	POWERHOUSE	43	GATES - INTAKE	
				44	GATES - DRAFT TUBE	
	GENERAL	STAGE NO. 1	LOCK	47	SPILLWAY DECK GIRDERS	
				48	TRASH RACKS	
		STAGE NO. 2	15 BAYS SPILLWAY	SPILLWAY	61	CRANE NO.1 - SPILLWAY GATES	
					62	CRANE NO.2 - INTAKE & SPILLWAY GATES	
STAGE NO. 3		3 BAYS SPILLWAY & TRAINING WALL	POWERHOUSE	63	CRANE - POWER HOUSE	
				64	CRANE - DRAFT TUBE GATES	
GENERAL		STAGE NO. 1	LOCK	73	TURBINES	
				74	GENERATORS	
		STAGE NO. 2	15 BAYS SPILLWAY	SPILLWAY	75	SWITCHBOARD & ELECTRICAL EQUIPMENT	
					76	MECHANICAL EQUIPMENT	
	STAGE NO. 3	3 BAYS SPILLWAY & TRAINING WALL	POWERHOUSE	77	POWER HOUSE STRUCTURAL STEEL	
				91	LAND ACQUISITION (Started taking Options Apr. 1, 1935)	
	GENERAL	STAGE NO. 1	LOCK	92	RESERVOIR CLEARING	
				93	BACKWATER PROTECTION	
		STAGE NO. 2	15 BAYS SPILLWAY	SPILLWAY	94	HIGHWAY & RAILROAD RELOCATION (R.R. Starts Feb 1, 1938)	
					95	FAMILY REMOVAL & CEMETERY RELOCATION	
STAGE NO. 3		3 BAYS SPILLWAY & TRAINING WALL	POWERHOUSE	96	UTILITIES	
				97	FILLING RESERVOIR	
STAGE NO. 1		LOCK	LOCK	98	SWITCHING STRUCTURE & TRANSMISSION LINES	
				99	CLEANUP & REMOVAL	
STAGE NO. 2		15 BAYS SPILLWAY	SPILLWAY	100	RIVER DREDGING	

CONSTRUCTION SCHEDULE



ITEM	1950												1951												1952					
	M	A	M	J	J	A	S	O	N	D	J	F	M	A	M	J	J	A	S	O	N	D	J	F	M	A				
1 Construction plant	█				1																									
2 Erect deck crane	2	█																												
3 Install gates-Unwater					3	█																								
4 Concrete substructure							4	█																						
5 Structural steel														5	█															
6 Trashracks																		6	█											
7 Concrete superstructure														7	█															
8 Switchyard addition														8	█															
9 Temporary end wall erection		9	█																											
10 End wall removal					10	█																								
11 Structural tile																			11		█									
12 Roof																					12		█							
13 Brick																						13		█						
14 Glazing and sash																							14		█					
15 Glazed tile																							15		█					
16 Plaster																						16		█						
17 Draft tube liner	█		17																											
18 Embedded parts		18	█																											
19 Turbine erection																							19		█					
20 Generator room ceiling																							20		█					
21 Generator																							21		█					
22 Electrical auxiliary														22	█															
23 Cofferdam removal																							23		█					
24 Remove deck crane																							24		█					
25 Painting																							25		█					
26 Cleanup and plant removal																							26		█					

Commercial operation 3-24-52 →

CONSTRUCTION SCHEDULE - UNIT 4

L58 081211 804

TENNESSEE VALLEY AUTHORITY  
RIVER SYSTEM OPERATIONS & ENVIRONMENT  
RIVER OPERATIONS

---

**GUNTERSVILLE DAM**

**SPILLWAY DISCHARGE TABLES**

---

**MARCH 2004**

Guntersville Spillway Discharge Tables  
Attachment 23

# CONTENTS

	Page
Instructions for Use of Tables.....	2
Location of Spillway Gates and Key to Gate Openings .....	4
Spillway Gate Arrangement Tables .....	5
Spillway Discharge Tables .....	7
Gate 18 Trash Discharge.....	104

Tailwater Range	Page	Tailwater Range	Page
Up to 572.5.....	7	583.51 to 584.50 .....	74
572.51 to 573.50 .....	13	584.51 to 585.50 .....	77
573.51 to 574.50 .....	19	585.51 to 586.50 .....	80
574.51 to 575.50 .....	25	586.51 to 587.50 .....	83
575.51 to 576.50 .....	31	587.51 to 588.50 .....	86
576.51 to 577.50 .....	37	588.51 to 589.50 .....	89
577.51 to 578.50 .....	43	589.51 to 590.50 .....	92
578.51 to 579.50 .....	49	590.51 to 591.50 .....	95
579.51 to 580.50 .....	55	591.51 to 592.50 .....	97
580.51 to 581.50 .....	61	592.51 to 593.50 .....	99
581.51 to 582.50 .....	66	593.51 to 594.50 .....	101
582.51 to 583.50 .....	71	594.51 to 595.50 .....	103

## INSTRUCTIONS FOR USE OF TABLES

### 1. Tables Update

These tables supersede the tables issued in February 1948 and revised in July 1974. The tables were revised to increase the maximum headwater elevation covered in the tables from 597 feet to 600 feet. They were revised also to reflect the discharge values obtained from SPILLQ, which is a computer code used in TVA software for monitoring spill discharges and determining gate arrangements.

### 2. Purpose of Tables

These tables provide a means for setting required spillway discharges and for determining the discharge when a specific arrangement of gates is in use. Discharge through a gate depends on the headwater and tailwater elevations and is affected by the discharge of the adjacent gates, particularly when the lower leaf is removed. The tabulated discharges are based on test results from scale models.

The specific gate arrangements in the tables were determined by considering the best conditions for navigation below the dam and erosion below the spillway apron. In addition, the specified arrangements minimize travel of the gantry crane used for manipulating the gates, under the assumption that only one crane is available for spillway gate operation.

### 3. Range of Tables

The tables cover the complete range of operating conditions. Discharges range from 0 to 610,000 cubic feet per second. Headwater elevations range from 590 feet to 600 feet. Tailwater elevations range from the minimum possible elevation to elevation 595.5 feet. The range of discharges for each tailwater elevation is ample to cover all operations. The tables do not include discharges for tailwater elevations at which such discharges could never occur (500,000 cubic feet per second with tailwater elevation below 572.5 feet, for example).

### 4. Arrangement of Tables

The tables show spillway discharges in cubic feet per second for each 0.2 foot of headwater elevation and for various ranges of tailwater elevation.

Headwater elevations in 0.2-foot increments are shown at the top of each column. The headwater and tailwater range is shown at the bottom of each page. The first tailwater range covers all tailwater elevations up to and including elevation 572.5 feet. Discharges in this tailwater range are given for headwater elevations between 590 feet and 600 feet, which requires 6 pages in the tables. The next tailwater range is from elevation

572.51 feet to 573.50 feet, requiring another 6 pages. Other tables cover tailwater ranges up to elevation 595.50 feet.

The discharge is tabulated under the headwater elevations for specific arrangements of gate openings, which are indicated by number in the left and right columns of each page. The numbered arrangements are defined in the table of Spillway Gate Arrangements on pages 5 and 6. Reference to this table and to the drawing showing the location of the gates on page 4 will determine the gate opening to which each gate is to be set for any particular discharge given in the tables.

### 5. Discharge Intervals

The tables have been prepared so that the incremental discharge between tabulated values for consecutive gate arrangements is generally less than 5 percent of the tabulated discharge. The differences between tabulated discharges caused by a change of one increment in headwater elevation are generally 1 percent or less. The differences in discharges caused by a change in tailwater elevation are also generally 1 percent or less. These limits are exceeded in some cases near the extreme ends of the tables where operation is relatively infrequent. In general it is possible to set any required discharge within about 2-1/2 percent and to know the actual discharge for any given set of conditions within 1 percent. These tolerances are considered acceptable and therefore it will not be necessary to interpolate between values given in these tables.

When the exact headwater elevation does not appear in the tables, the discharge for the headwater elevation closest to it is used. For example, the column headed 594.2 is used for actual headwater elevations between 594.10 feet and 594.29 feet inclusive. When the actual headwater elevation is exactly halfway between tabular values, the larger value is used.

### 6. Use of Tables

The tables can be used in two ways: (1) to determine the arrangement of gates needed to pass a required discharge at a given headwater and tailwater elevation, and (2) to determine the discharge for a given arrangement of gates and headwater and tailwater elevation.

In setting up any required gate arrangement from the condition of all gates closed, or in passing from one gate arrangement to another, the desired gate openings may be set in any convenient order without setting up all intervening gate arrangements. Temporary undesirable conditions that may result while the change is being made should cause no permanent harm since the entire change will usually take no more than a few hours.

Example 1 -- What gate arrangement is necessary to pass a discharge of 110,000 cubic feet per second with the headwater at elevation 594.43 feet and the tailwater at elevation 567.18 feet?

The first step is to determine which pages of the tables include this tailwater within their tailwater range. Referring to the contents page, we find that tailwater range "Up to 572.5" is found on pages 7 to 12. Within those pages, pages 9 and 10 cover headwater elevations between 594 feet and 598 feet. The headwater elevation closest to 594.43 feet is 594.4 feet. In the column with this heading on page 10, the discharge closest to 110,000 cubic feet per second is 109,600 cubic feet per second and the corresponding gate arrangement is number 57. Reference to the table of gate arrangements on page 5 shows that the gates should be opened as follows: gates 1 and 2 opened to 5 feet, gates 3 through 16 opened to 9 feet, and gates 17 and 18 closed.

After the gates are opened, changes in the headwater elevation or tailwater elevation may require changes in the gate arrangement to maintain the desired discharge. For example, if the headwater should fall to 594.29 feet, the discharge will be found in the column headed 594.2. In this column the discharge closest to 110,000 cubic feet per second is 108,800 cubic feet per second for gate arrangement 57. Accordingly, no change in gate arrangement would be necessary. It may be seen further that the gate arrangement would not be changed until the headwater elevation fell to 593.89 feet or below. For headwater elevation 593.8 feet, gate arrangement 58 will give the discharge closest to 110,000 cubic feet per second. To change to gate arrangement 58 from gate arrangement 57, it is necessary to remove the upper leaf of gate 6.

Example 2 -- The effect of a change in tailwater elevation is shown by this example. Suppose it is required to discharge 250,000 cubic feet per second with the headwater elevation at 593.64 feet and the tailwater elevation at 579.32 feet. The pages to be used are those marked "Tailwater 578.51 to 579.50." The headwater elevation closest to 593.64 feet is 593.6 feet. In the column headed 593.6 on page 49 the discharge closest to 250,000 cubic feet per second is 252,200 cubic feet per second at gate arrangement 89. Referring to the table of gate arrangements, page 6, it is found that gates 4 and 18 are closed, gate 17 is opened to 9 feet, gates 1, 2, 3, 5, 7, 9, 11, 13, 14, 15, and 16 have their upper leaves removed, and gates 6, 8, 10, and 12 have both the upper and lower leaves removed. If operation under these conditions causes the tailwater to fall to elevation

577.8 feet, the set of pages marked "Tailwater 577.51 to 578.50" are used. At the same headwater elevation the discharge closest to 250,000 cubic feet per second is 245,600 cubic feet per second for gate arrangement 87. To change to gate arrangement 87 from gate arrangement 89, it is necessary to remove the upper leaf of gate 4 and replace the lower leaf of gate 6.

Example 3 -- Suppose the operating records show that the headwater is at elevation 594.30 feet, the tailwater is at elevation 562.2 feet, and gate arrangement 52 is in use. The first part of the table marked "Tailwater Up to 572.5" is applicable. The headwater is found on page 9, which is marked "Headwater 594 to 598." The elevation given is exactly halfway between elevations 594.2 feet and 594.4 feet. The larger value, 594.4 feet, should be used. In the column headed 594.4, opposite gate arrangement 52, the discharge is found to be 94,750 cubic feet per second.

## 7. Trash Gate


Gate 18 differs from the other spillway gates in that the upper half is divided into three separate sections that can be removed as necessary to pass trash. Because operation of Gate 18 for trash removal is independent of normal spilling operations, the discharge through Gate 18 that occurs during trash removal is not included in the spillway discharge tables. The trash removal discharge, which is given in the tables on page 104, must always be added to the discharge obtained from the spillway discharge tables to obtain the total spillway discharge.

When Gate 18 is opened as part of normal spilling operations (gate arrangements 113 through 120), its discharge is included in the spillway discharge tables. The discharge that occurs when Gate 18 is closed but overflowing (headwater elevation greater than 595.44 feet) is also included in the spillway discharge tables. In these cases, no additional discharge should be added to the discharge obtained from the spillway discharge tables.

Because the discharge over Gate 18 when it is closed and the headwater elevation is greater than 595.44 feet is already included in the spillway tables, the trash gate discharges on page 104 reflect only the added discharge due to removing gate sections.




# GUNTERSVILLE DAM

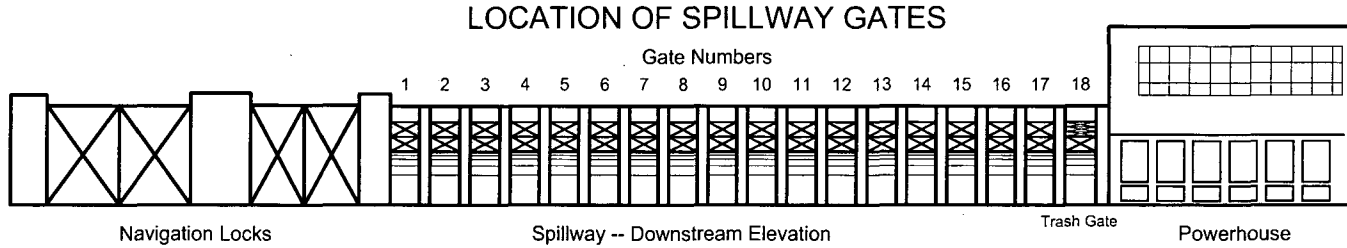

### KEY TO GATE ARRANGEMENT TABLES

Symbols Refer To Gate Openings As Used In The Gate Arrangement Tables, Pages 5 and 6

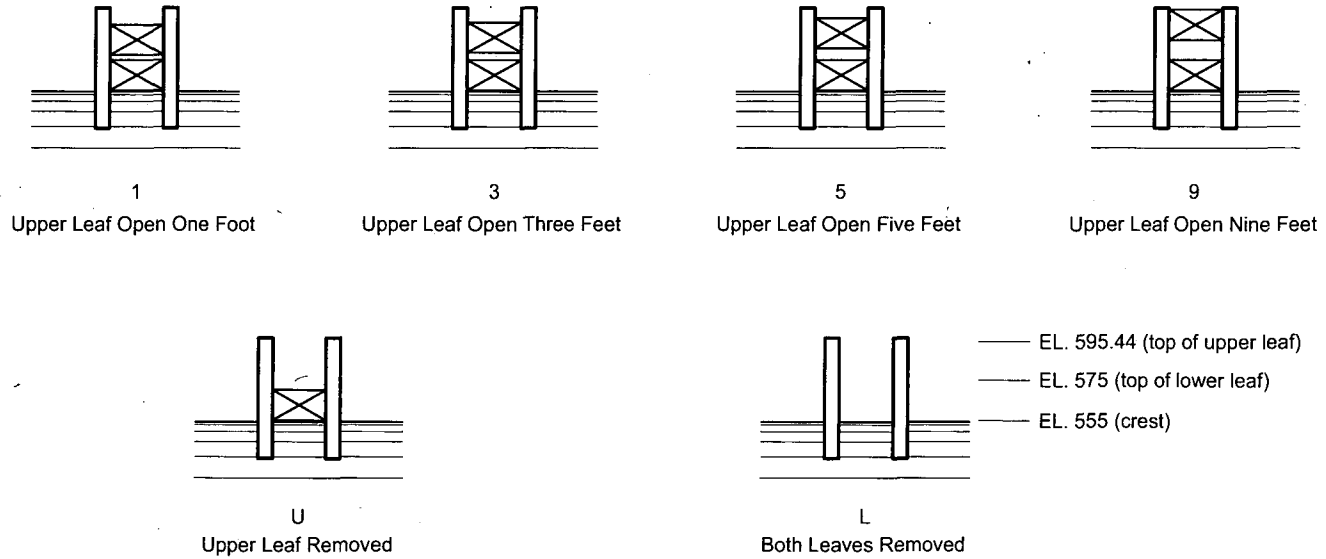

# GUNTERSVILLE DAM SPILLWAY GATE ARRANGEMENTS

Arrangement Number	Gate Number																	
	1	2	3	4	5	6	7	8	9	10	11	12	13	14	15	16	17	18
1	-	-	-	-	-	1	-	-	-	-	-	-	-	-	-	-	-	-
2	-	-	-	-	-	3	-	-	-	-	-	-	-	-	-	-	-	-
3	-	-	-	-	-	3	1	-	-	-	-	-	-	-	-	-	-	-
4	-	-	-	-	-	3	3	-	-	-	-	-	-	-	-	-	-	-
5	-	-	-	-	-	3	3	-	-	-	1	-	-	-	-	-	-	-
6	-	-	-	-	-	3	3	-	-	-	-	3	-	-	-	-	-	-
7	-	-	-	-	-	3	3	-	-	-	-	3	1	-	-	-	-	-
8	-	-	-	-	-	3	3	-	-	-	-	3	3	-	-	-	-	-
9	-	-	-	-	-	3	3	-	-	-	-	3	3	-	-	1	-	-
10	-	-	-	-	-	3	3	-	-	-	-	3	3	-	-	3	-	-
11	-	-	-	-	-	3	3	-	-	-	-	3	3	-	1	3	-	-
12	-	-	-	-	-	3	3	-	-	-	-	3	3	-	3	3	-	-
13	-	-	-	-	-	3	3	-	-	1	-	3	3	-	3	3	-	-
14	-	-	-	-	-	3	3	-	-	3	-	3	3	-	3	3	-	-
15	-	-	-	-	-	3	3	-	1	3	-	3	3	-	3	3	-	-
16	-	-	-	-	-	3	3	-	3	3	-	3	3	-	3	3	-	-
17	-	-	-	1	-	3	3	-	3	3	-	3	3	-	3	3	-	-
18	-	-	-	3	-	3	3	-	3	3	-	3	3	-	3	3	-	-
19	-	1	-	3	-	3	3	-	3	3	-	3	3	-	3	3	-	-
20	-	3	-	3	-	3	3	-	3	3	-	3	3	-	3	3	-	-
21	-	3	-	5	-	3	3	-	3	3	-	3	3	-	3	3	-	-
22	-	3	-	5	-	3	3	-	3	3	-	3	3	-	3	3	-	-
23	-	3	-	5	-	5	5	-	3	3	-	3	3	-	3	3	-	-
24	-	3	-	5	-	5	5	-	5	5	-	3	3	-	3	3	-	-
25	-	3	-	5	-	5	5	-	5	5	-	3	3	-	3	3	-	-
26	-	3	-	5	-	5	5	-	5	5	-	5	3	-	3	3	-	-
27	-	3	-	5	-	5	5	-	5	5	-	5	5	-	3	3	-	-
28	-	3	-	5	-	5	5	-	5	5	-	5	5	-	5	3	-	-
29	-	3	-	5	-	5	5	-	5	5	-	5	5	-	5	5	-	-
30	-	3	-	5	-	5	5	1	5	5	-	5	5	-	5	5	-	-

Arrangement Number	Gate Number																	
	1	2	3	4	5	6	7	8	9	10	11	12	13	14	15	16	17	18
31	-	-	-	5	-	5	5	-	5	5	3	5	5	-	5	5	-	-
32	-	3	-	5	-	5	5	-	5	5	5	5	5	-	5	5	-	-
33	-	3	-	5	-	5	5	1	5	5	5	5	5	-	5	5	-	-
34	-	3	-	5	-	5	5	3	5	5	5	5	5	-	5	5	-	-
35	-	3	-	5	-	5	5	5	5	5	5	5	5	-	5	5	-	-
36	-	3	-	5	1	5	5	5	5	5	5	5	5	-	5	5	-	-
37	-	3	-	5	3	5	5	5	5	5	5	5	5	-	5	5	-	-
38	-	3	-	5	5	5	5	5	5	5	5	5	5	-	5	5	-	-
39	3	3	-	5	5	5	5	5	5	5	5	5	5	-	5	5	-	-
40	3	3	3	5	5	5	5	5	5	5	5	5	5	-	5	5	-	-
41	3	3	5	5	5	5	5	5	5	5	5	5	5	-	5	5	-	-
42	3	3	5	9	5	5	5	5	5	5	5	5	5	-	5	5	-	-
43	3	3	5	9	5	9	9	5	5	5	5	5	5	-	5	5	-	-
44	3	3	5	9	5	9	9	5	5	5	5	5	5	-	5	5	-	-
45	3	3	5	9	5	9	9	5	5	9	9	5	5	-	5	5	-	-
46	3	3	5	9	5	9	9	5	5	9	9	5	9	-	5	5	-	-
47	3	3	5	9	5	9	9	5	5	9	9	5	9	-	5	5	-	-
48	3	3	5	9	5	9	9	5	5	9	9	5	9	-	5	5	-	-
49	3	3	5	9	5	9	9	5	5	9	9	5	9	-	5	5	-	-
50	3	3	5	9	5	9	9	5	5	9	9	5	9	-	5	5	-	-
51	3	3	5	9	5	9	9	5	5	9	9	5	9	-	9	9	-	-
52	3	3	5	9	5	9	9	5	5	9	9	5	9	-	9	9	-	-
53	3	3	5	9	5	9	9	5	5	9	9	5	9	-	9	9	-	-
54	3	3	5	9	5	9	9	5	5	9	9	5	9	-	9	9	-	-
55	3	3	5	9	5	9	9	5	5	9	9	5	9	-	9	9	-	-
56	5	5	5	9	9	9	9	9	9	9	9	9	9	-	9	9	-	-
57	5	5	9	9	9	9	9	9	9	9	9	9	9	-	9	9	-	-
58	5	5	9	9	9	9	9	9	9	9	9	9	9	-	9	9	-	-
59	5	5	9	9	9	9	9	9	9	9	9	9	9	-	9	9	-	-
60	5	5	9	9	9	U	U	9	U	9	9	9	9	-	9	9	-	-

### GATE OPENING LEGEND

Gate openings are shown in the vertical columns under each Gate Number as follows:

- |                            |                            |
|----------------------------|----------------------------|
| 1 - Upper leaf open 1 foot | 9 - Upper leaf open 9 feet |
| 3 - Upper leaf open 3 feet | U - Upper leaf out         |
| 5 - Upper leaf open 5 feet | L - Lower leaf out         |

## GUNTERSVILLE DAM SPILLWAY GATE ARRANGEMENTS

Arrange- ment Number	Gate Number																	
	1	2	3	4	5	6	7	8	9	10	11	12	13	14	15	16	17	18
61	5	5	9	9	9	U	U	9	U	U	9	9	9	9	9	-	-	
62	5	5	9	9	9	U	U	9	U	U	9	9	9	9	9	-	-	
63	5	5	9	9	9	U	U	9	U	U	9	9	9	9	9	-	-	
64	5	5	9	9	9	U	U	9	U	U	9	9	9	9	9	-	-	
65	5	5	9	9	9	U	U	9	U	U	9	9	9	9	9	-	-	
66	5	5	9	9	9	U	U	9	U	U	9	9	9	9	9	5	-	-
67	5	5	9	9	9	U	U	9	U	U	9	9	9	9	9	9	-	-
68	5	5	9	9	9	U	U	9	U	U	9	9	9	9	9	9	-	-
69	5	5	9	9	9	U	U	9	U	U	9	9	9	9	9	9	-	-
70	5	5	9	9	9	U	U	9	U	U	9	9	9	9	9	9	-	-
71	5	5	9	9	U	U	U	U	U	U	U	U	U	U	U	9	-	-
72	5	5	U	U	U	U	U	U	U	U	U	U	U	U	U	9	-	-
73	5	U	U	U	U	U	U	U	U	U	U	U	U	U	U	9	-	-
74	U	U	U	U	U	U	U	U	U	U	U	U	U	U	U	9	-	-
75	U	U	U	U	U	U	U	U	U	U	U	U	U	U	U	9	-	-
76	U	U	U	U	-	U	U	9	U	U	U	U	U	U	U	9	-	-
77	U	U	U	U	U	U	U	U	U	U	U	U	U	U	U	9	-	-
78	U	U	U	U	U	U	U	U	U	U	U	U	U	U	U	9	-	-
79	U	U	U	U	U	U	U	U	U	U	U	U	U	U	U	9	-	-
80	U	U	U	U	U	U	U	U	U	U	U	U	U	U	U	9	-	-
81	U	U	U	U	-	U	U	9	U	U	U	U	U	U	U	9	-	-
82	U	U	U	U	U	U	U	U	U	U	U	U	U	U	U	9	-	-
83	U	U	U	U	U	U	U	U	U	U	U	U	U	U	U	9	-	-
84	U	U	U	U	U	U	U	U	U	U	U	U	U	U	U	9	-	-
85	U	U	-	U	U	U	U	U	U	U	U	U	U	U	U	9	-	-
86	U	U	-	U	U	U	U	U	U	U	U	U	U	U	U	9	-	-
87	U	U	U	U	U	U	U	U	U	U	U	U	U	U	U	9	-	-
88	U	U	U	U	U	U	U	U	U	U	U	U	U	U	U	9	-	-
89	U	U	U	U	U	U	U	U	U	U	U	U	U	U	U	9	-	-
90	U	U	U	U	U	U	U	U	U	U	U	U	U	U	U	9	-	-

Arrange- ment Number	Gate Number																	
	1	2	3	4	5	6	7	8	9	10	11	12	13	14	15	16	17	18
91	U	U	U	L	U	L	U	L	U	L	L	L	L	U	U	9	-	-
116	-	L	L	L	L	L	L	L	L	L	L	L	L	L	L	U	U	U
117	U	L	L	L	L	L	L	L	L	L	L	L	L	L	L	U	U	U
118	L	L	L	L	L	L	L	L	L	L	L	L	L	L	L	U	U	U
119	L	L	L	L	L	L	L	L	L	L	L	L	L	L	L	U	U	U
120	L	L	L	L	L	L	L	L	L	L	L	L	L	L	L	U	U	U

### GATE OPENING LEGEND

Gate openings are shown in the vertical columns under each Gate Number as follows:

- |                            |                            |
|----------------------------|----------------------------|
| 1 - Upper leaf open 1 foot | 9 - Upper leaf open 9 feet |
| 3 - Upper leaf open 3 feet | U - Upper leaf out         |
| 5 - Upper leaf open 5 feet | L - Lower leaf out         |

**GUNTERSVILLE DAM  
SPILLWAY DISCHARGE  
IN CUBIC FEET PER SECOND**

**HEADWATER ELEVATION**

G.A.U.G.E. RANGE MENT	HEADWATER ELEVATION																				G.A.U.G.E. RANGE MENT	
	590.0	590.2	590.4	590.6	590.8	591.0	591.2	591.4	591.6	591.8	592.0	592.2	592.4	592.6	592.8	593.0	593.2	593.4	593.6	593.8		594.0
1	900	910	920	920	930	930	940	940	950	950	960	970	970	980	980	990	990	1,000	1,000	1,010	1,010	1
2	2,380	2,400	2,420	2,430	2,450	2,470	2,480	2,500	2,510	2,530	2,550	2,560	2,580	2,590	2,610	2,620	2,640	2,650	2,670	2,680	2,700	2
3	3,290	3,310	3,330	3,360	3,380	3,400	3,420	3,440	3,460	3,490	3,510	3,530	3,550	3,570	3,590	3,610	3,630	3,650	3,670	3,690	3,710	3
4	4,770	4,800	4,840	4,870	4,900	4,930	4,970	5,000	5,030	5,060	5,090	5,120	5,150	5,180	5,210	5,240	5,270	5,300	5,330	5,360	5,390	4
5	5,670	5,710	5,750	5,790	5,830	5,870	5,900	5,940	5,980	6,020	6,050	6,090	6,120	6,160	6,200	6,230	6,270	6,300	6,340	6,370	6,400	5
6	7,150	7,200	7,250	7,300	7,350	7,400	7,450	7,500	7,540	7,590	7,640	7,680	7,730	7,780	7,820	7,870	7,910	7,960	8,000	8,040	8,090	6
7	8,060	8,110	8,170	8,220	8,280	8,330	8,390	8,440	8,490	8,550	8,600	8,650	8,700	8,750	8,800	8,850	8,900	8,950	9,000	9,050	9,100	7
8	9,540	9,610	9,670	9,740	9,800	9,870	9,930	10,000	10,060	10,120	10,180	10,250	10,310	10,370	10,430	10,490	10,550	10,610	10,670	10,730	10,780	8
9	10,440	10,510	10,590	10,660	10,730	10,800	10,870	10,940	11,010	11,080	11,140	11,210	11,280	11,350	11,410	11,480	11,540	11,610	11,670	11,730	11,780	9
10	11,920	12,010	12,090	12,170	12,250	12,330	12,420	12,500	12,570	12,650	12,730	12,810	12,880	12,960	13,040	13,110	13,190	13,260	13,330	13,410	13,480	10
11	12,830	12,920	13,000	13,090	13,180	13,270	13,350	13,440	13,520	13,610	13,690	13,770	13,860	13,940	14,020	14,100	14,180	14,260	14,340	14,410	14,490	11
12	14,310	14,410	14,510	14,610	14,700	14,800	14,900	15,000	15,090	15,180	15,280	15,370	15,460	15,550	15,640	15,730	15,820	15,910	16,000	16,090	16,180	12
13	15,210	15,320	15,420	15,530	15,630	15,730	15,840	15,940	16,040	16,140	16,240	16,340	16,430	16,530	16,630	16,720	16,820	16,910	17,000	17,100	17,190	13
14	16,690	16,810	16,930	17,040	17,160	17,270	17,380	17,490	17,600	17,710	17,820	17,930	18,040	18,150	18,250	18,360	18,460	18,560	18,670	18,770	18,870	14
15	17,600	17,720	17,840	17,960	18,080	18,200	18,320	18,440	18,550	18,670	18,780	18,900	19,010	19,120	19,230	19,340	19,450	19,560	19,670	19,780	19,880	15
16	19,080	19,210	19,340	19,480	19,610	19,740	19,860	19,990	20,120	20,240	20,370	20,490	20,620	20,740	20,860	20,980	21,100	21,220	21,330	21,450	21,570	16
17	19,980	20,120	20,260	20,400	20,530	20,670	20,800	20,940	21,070	21,200	21,330	21,460	21,590	21,710	21,840	21,970	22,090	22,210	22,340	22,460	22,580	17
18	21,460	21,610	21,760	21,910	22,060	22,200	22,350	22,490	22,630	22,770	22,920	23,050	23,190	23,330	23,470	23,600	23,740	23,870	24,000	24,130	24,260	18
19	22,360	22,520	22,680	22,830	22,980	23,140	23,290	23,430	23,580	23,730	23,880	24,020	24,160	24,310	24,450	24,590	24,730	24,870	25,000	25,140	25,280	19
20	23,850	24,010	24,180	24,340	24,510	24,670	24,830	24,990	25,150	25,310	25,460	25,620	25,770	25,920	26,070	26,220	26,370	26,520	26,670	26,810	26,960	20
21	25,170	25,350	25,530	25,700	25,880	26,050	26,220	26,390	26,560	26,730	26,900	27,060	27,230	27,390	27,550	27,710	27,870	28,030	28,190	28,350	28,500	21
22	26,490	26,680	26,870	27,060	27,250	27,430	27,620	27,800	27,980	28,160	28,340	28,510	28,690	28,860	29,030	29,210	29,380	29,540	29,710	29,880	30,040	22
23	27,820	28,020	28,220	28,420	28,620	28,810	29,010	29,200	29,390	29,580	29,770	29,960	30,150	30,330	30,510	30,700	30,880	31,060	31,230	31,410	31,590	23
24	29,140	29,350	29,560	29,780	29,990	30,190	30,400	30,600	30,810	31,010	31,210	31,410	31,600	31,800	31,990	32,190	32,380	32,570	32,760	32,940	33,130	24
25	30,460	30,690	30,910	31,130	31,350	31,570	31,790	32,010	32,220	32,430	32,640	32,850	33,060	33,270	33,470	33,680	33,880	34,080	34,280	34,480	34,670	25
26	31,790	32,020	32,260	32,490	32,720	32,960	33,180	33,410	33,640	33,860	34,080	34,300	34,520	34,740	34,950	35,170	35,380	35,590	35,800	36,010	36,220	26
27	33,110	33,360	33,600	33,850	34,090	34,340	34,580	34,820	35,050	35,290	35,520	35,750	35,980	36,210	36,430	36,660	36,880	37,100	37,320	37,540	37,760	27
28	34,440	34,690	34,950	35,210	35,460	35,720	35,970	36,220	36,470	36,710	36,960	37,200	37,440	37,680	37,910	38,150	38,380	38,620	38,850	39,070	39,300	28
29	35,760	36,030	36,300	36,560	36,830	37,100	37,360	37,620	37,880	38,140	38,390	38,650	38,900	39,150	39,390	39,640	39,880	40,130	40,370	40,610	40,840	29
30	36,660	36,940	37,210	37,490	37,760	38,030	38,300	38,570	38,830	39,090	39,350	39,610	39,870	40,120	40,380	40,630	40,880	41,120	41,370	41,610	41,860	30
31	38,140	38,430	38,710	39,000	39,280	39,560	39,840	40,120	40,400	40,670	40,940	41,210	41,470	41,740	42,000	42,260	42,520	42,780	43,030	43,290	43,540	31
32	39,470	39,770	40,060	40,360	40,650	40,950	41,240	41,520	41,810	42,090	42,380	42,660	42,930	43,210	43,480	43,750	44,020	44,290	44,560	44,820	45,080	32
33	40,370	40,680	40,980	41,280	41,580	41,880	42,170	42,470	42,760	43,050	43,340	43,620	43,900	44,190	44,460	44,740	45,020	45,290	45,560	45,830	46,090	33
34	41,850	42,170	42,480	42,790	43,100	43,410	43,720	44,020	44,330	44,630	44,920	45,220	45,510	45,800	46,090	46,380	46,660	46,940	47,220	47,500	47,780	34
35	43,180	43,500	43,820	44,150	44,470	44,790	45,110	45,430	45,740	46,050	46,360	46,670	46,970	47,270	47,570	47,870	48,160	48,450	48,750	49,030	49,320	35
36	44,080	44,410	44,740	45,070	45,400	45,730	46,050	46,370	46,690	47,010	47,320	47,630	47,940	48,250	48,550	48,850	49,150	49,450	49,750	50,040	50,330	36
37	45,560	45,900	46,240	46,580	46,920	47,260	47,590	47,930	48,260	48,580	48,910	49,230	49,550	49,860	50,180	50,490	50,800	51,110	51,410	51,720	52,020	37
38	46,890	47,240	47,590	47,940	48,290	48,640	48,990	49,330	49,670	50,010	50,340	50,680	51,000	51,330	51,660	51,980	52,300	52,620	52,930	53,250	53,560	38
39	49,270	49,640	50,010	50,380	50,740	51,110	51,470	51,830	52,180	52,540	52,890	53,240	53,580	53,920	54,260	54,600	54,940	55,270	55,600	55,930	56,260	39
40	51,650	52,040	52,420	52,810	53,190	53,580	53,950	54,330	54,700	55,070	55,430	55,800	56,160	56,520	56,870	57,220	57,570	57,920	58,270	58,610	58,950	40
41	52,980	53,380	53,770	54,170	54,560	54,960	55,350	55,730	56,110	56,490	56,870	57,250	57,620	57,990	58,350	58,720	59,080	59,430	59,790	60,140	60,490	41
42	55,330	55,750	56,170	56,590	57,010	57,420	57,830	58,240	58,650	59,060	59,470	59,870	60,270	60,670	61,060	61,450	61,840	62,230	62,610	62,990	63,370	42
43	57,670	58,120	58,560	59,010	59,450	59,880	60,320	60,750	61,190	61,630	62,070	62,500	62,930	63,350	63,770	64,190	64,610	65,020	65,430	65,840	66,240	43
44	60,020	60,490	60,960	61,430	61,890	62,350	62,800	63,260	63,730	64,200	64,660	65,120	65,580	66,030	66,480	66,930	67,370	67,810	68,250	68,680	69,120	44
45	62,370	62,860	63,350	63,840	64,330	64,810	65,290	65,780	66,270	66,750	67,230	67,710	68,190	68,670	69,150	69,630	70,110	70,580	71,050	71,520	71,990	45
46	64,720	65,240	65,750	66,260	66,770	67,280	67,770	68,290	68,810	69,340	69,860	70,370	70,890	71,400	71,900	72,400	72,900	73,400	73,890	74,380	74,860	46
47	67,060	67,610	68,150	68,680	69,210	69,740	70,260	70,800	71,350	71,910	72,460	73,000	73,540	74,080	74,610	75,140	75,670	76,190	76,710	77,220	77,740	47
48	69,410	69,980	70,540	71,100	71,650	72,200	72,750	73,310	73,870	74,440	75,000	75,560	76,120	76,680	77,240	77,800	78,350	78,900	79,450	80,000	80,550	48
49	71,760	72,350	72,940	73,520	74,100	74,670	75,250	75,820	76,													

# GUNTERVILLE DAM SPILLWAY DISCHARGE IN CUBIC FEET PER SECOND

GANGWAY ELEVATION	HEADWATER ELEVATION																		GANGWAY ELEVATION			
	590.0	590.2	590.4	590.6	590.8	591.0	591.2	591.4	591.6	591.8	592.0	592.2	592.4	592.6	592.8	593.0	593.2	593.4		593.6	593.8	594.0
56	89,850	90,620	91,370	92,120	92,860	93,600	94,320	95,090	95,890	96,700	97,490	98,290	99,070	99,850	100,600	101,400	102,200	102,900	103,700	104,400	105,200	56
57	92,200	92,990	93,770	94,540	95,300	96,060	96,810	97,600	98,430	99,270	100,100	100,900	101,700	102,500	103,300	104,100	104,900	105,700	106,500	107,300	108,100	57
58	94,120	95,020	95,910	96,790	97,670	98,540	99,400	100,300	101,300	102,200	103,100	104,100	105,000	105,900	106,900	107,800	108,700	109,600	110,500	111,400	112,300	58
59	96,040	97,040	98,040	99,040	100,000	101,000	102,000	103,000	104,100	105,100	106,200	107,200	108,300	109,300	110,400	111,400	112,500	113,500	114,500	115,500	116,600	59
60	97,950	99,070	100,200	101,300	102,400	103,500	104,600	105,700	106,900	108,100	109,200	110,400	111,600	112,800	113,900	115,100	116,200	117,400	118,500	119,700	120,800	60
61	99,870	101,100	102,300	103,500	104,800	106,000	107,200	108,400	109,700	111,000	112,300	113,600	114,900	116,200	117,400	118,700	120,000	121,200	122,500	123,800	125,100	61
62	101,800	103,100	104,400	105,800	107,100	108,400	109,800	111,100	112,500	113,900	115,300	116,800	118,200	119,600	121,000	122,400	123,700	125,100	126,500	127,900	129,300	62
63	103,700	105,100	106,600	108,000	109,500	110,900	112,400	113,900	115,400	116,900	118,400	119,900	121,400	123,000	124,500	126,000	127,500	129,000	130,500	132,000	133,600	63
64	105,600	107,200	108,700	110,300	111,800	113,400	115,000	116,600	118,200	119,800	121,500	123,100	124,700	126,400	128,000	129,600	131,300	132,900	134,500	136,200	137,800	64
65	107,500	109,200	110,900	112,500	114,200	115,900	117,600	119,300	121,000	122,800	124,500	126,300	128,000	129,800	131,500	133,300	135,000	136,800	138,500	140,300	142,100	65
66	111,200	112,900	114,600	116,300	118,000	119,700	121,400	123,200	124,900	126,700	128,500	130,300	132,100	133,900	135,600	137,400	139,200	140,900	142,700	144,500	146,300	66
67	113,600	115,300	117,000	118,700	120,500	122,200	123,900	125,700	127,500	129,300	131,100	132,900	134,700	136,500	138,300	140,100	141,900	143,700	145,500	147,400	149,200	67
68	115,500	117,300	119,200	121,000	122,800	124,700	126,500	128,400	130,300	132,200	134,100	136,100	138,000	139,900	141,900	143,800	145,700	147,600	149,500	151,500	153,400	68
69	117,400	119,400	121,300	123,200	125,200	127,100	129,100	131,100	133,100	135,200	137,200	139,200	141,300	143,300	145,400	147,400	149,500	151,500	153,600	155,600	157,700	69
70	119,300	121,400	123,400	125,500	127,500	129,600	131,700	133,800	135,900	138,100	140,200	142,400	144,600	146,800	148,900	151,100	153,200	155,400	157,600	159,700	161,900	70
71	121,300	123,400	125,600	127,700	129,900	132,100	134,300	136,500	138,800	141,000	143,300	145,600	147,900	150,200	152,400	154,700	157,000	159,300	161,600	163,900	166,200	71
72	123,200	125,400	127,700	130,000	132,300	134,600	136,900	139,200	141,600	144,000	146,300	148,700	151,100	153,600	156,000	158,300	160,700	163,200	165,600	168,000	170,400	72
73	127,400	129,800	132,200	134,600	137,100	139,500	142,000	144,500	147,000	149,500	152,000	154,500	157,100	159,700	162,200	164,700	167,300	169,800	172,400	175,000	177,600	73
74	131,700	134,200	136,800	139,300	141,900	144,500	147,100	149,700	152,300	155,000	157,600	160,300	163,000	165,700	168,400	171,100	173,800	176,500	179,200	181,900	184,700	74
75	133,600	136,200	138,900	141,600	144,200	146,900	149,600	152,400	155,100	157,900	160,700	163,500	166,300	169,200	172,000	174,800	177,600	180,400	183,200	186,100	188,900	75
76	136,700	139,100	141,500	144,000	146,400	148,900	151,400	153,900	156,400	159,000	161,600	164,200	166,800	169,400	172,000	174,600	177,200	179,800	182,400	185,000	187,600	76
77	142,800	145,200	147,700	150,200	152,700	155,200	157,800	160,300	162,900	165,500	168,100	170,700	173,400	176,000	178,600	181,200	183,900	186,500	189,200	191,800	194,500	77
78	144,700	147,200	149,800	152,400	155,100	157,700	160,400	163,000	165,700	168,400	171,200	173,900	176,600	179,400	182,200	184,900	187,600	190,400	193,200	196,000	198,800	78
79	150,700	153,400	156,100	158,800	161,500	164,300	167,000	169,800	172,500	175,300	178,100	180,900	183,800	186,600	189,500	192,400	195,300	198,200	201,100	203,000	205,900	79
80	152,600	155,400	158,100	160,900	163,700	166,500	169,300	172,200	175,000	177,900	180,800	183,700	186,600	189,500	192,500	195,400	198,300	201,200	204,200	207,100	210,100	80
81	155,700	158,200	160,800	163,300	165,900	168,500	171,100	173,700	176,300	178,900	181,500	184,100	186,700	189,300	192,000	194,600	197,200	199,800	202,400	205,000	207,600	81
82	161,800	164,300	166,900	169,500	172,100	174,700	177,300	180,000	182,600	185,300	188,000	190,700	193,400	196,100	198,800	201,500	204,200	206,900	209,600	212,300	215,000	82
83	163,700	166,400	169,100	171,800	174,500	177,300	180,000	182,800	185,600	188,400	191,200	194,100	196,900	199,800	202,700	205,500	208,400	211,200	214,100	217,000	219,900	83
84	171,700	174,500	177,400	180,200	183,100	186,000	188,900	191,900	194,900	197,900	200,900	203,900	206,900	210,000	213,000	216,000	219,000	222,100	225,100	228,200	231,300	84
85	174,700	177,400	180,000	182,700	185,300	188,000	190,700	193,400	196,200	198,900	201,700	204,500	207,300	210,200	213,100	216,000	218,900	221,800	224,700	227,600	230,500	85
86	182,700	185,500	188,300	191,100	194,000	196,800	199,700	202,600	205,500	208,400	211,300	214,300	217,300	220,200	223,200	226,200	229,100	232,100	235,100	238,100	241,100	86
87	190,700	193,600	196,600	199,600	202,600	205,600	208,600	211,700	214,800	217,900	221,000	224,100	227,200	230,300	233,500	236,600	239,800	242,900	246,100	249,300	252,500	87
88	193,800	196,500	199,200	202,000	204,800	207,600	210,400	213,200	216,100	218,900	221,800	224,700	227,600	230,500	233,400	236,300	239,200	242,100	245,000	247,900	250,800	88
89	201,700	204,600	207,500	210,500	213,400	216,400	219,300	222,300	225,300	228,400	231,400	234,500	237,600	240,600	243,700	246,800	249,900	253,000	256,100	259,200	262,300	89
90	209,700	212,800	215,800	218,900	222,000	225,200	228,300	231,500	234,600	237,800	241,000	244,300	247,500	250,800	254,000	257,300	260,500	263,800	267,100	270,400	273,700	90
92	220,800	223,800	226,800	229,800	232,900	235,900	239,000	242,100	245,200	248,400	251,500	254,700	257,900	261,100	264,300	267,400	270,600	273,800	277,000	280,200	283,500	92
93	228,700	231,900	235,100	238,300	241,500	244,700	248,000	251,200	254,500	257,800	261,100	264,500	267,800	271,200	274,600	277,900	281,300	284,600	288,000	291,400	294,900	93
95	242,400	245,500	248,600	251,700	254,900	258,000	261,200	264,400	267,600	270,800	274,100	277,300	280,600	283,900	287,200	290,400	293,700	297,000	300,300	303,600	307,000	95
96	250,300	253,600	256,900	260,200	263,500	266,800	270,100	273,500	276,900	280,300	283,700	287,100	290,600	294,000	297,500	300,900	304,400	307,900	311,300	314,800	318,300	96
98	264,000	267,200	270,400	273,600	276,900	280,100	283,400	286,700	290,000	293,300	296,600	300,000	303,400	306,700	310,100	313,500	316,800	320,200	323,600	327,000	330,500	98
99	271,900	275,300	278,700	282,100	285,500	288,900	292,300	295,800	299,300	302,800	306,300	309,800	313,300	316,900	320,400	324,000	327,500	331,100	334,600	338,200	341,800	99
101	285,600	289,000	292,200	295,500	298,900	302,200	305,600	309,000	312,400	315,800	319,200	322,600	326,100	329,600	333,000	336,500	340,000	343,400	346,900	350,400	354,000	101
102	293,600	297,000	300,500	304,000	307,500	311,000	314,500	318,100	321,700	325,200	328,800	332,400	336,100	339,700	343,300	347,000	350,600	354,300	358,000	361,600	365,300	102
104	307,200	310,600	314,000	317,400	320,900	324,300	327,800	331,200	334,700	338,200	341,800	345,300	348,800	352,400	356,000	359,500	363,100	366,700	370,300	374,000	377,600	104
105	315																					

**GUNTERVILLE DAM  
SPILLWAY DISCHARGE  
IN CUBIC FEET PER SECOND**

GATE ARRANGEMENT	HEADWATER ELEVATION																				GATE ARRANGEMENT	
	594.0	594.2	594.4	594.6	594.8	595.0	595.2	595.4	595.6	595.8	596.0	596.2	596.4	596.6	596.8	597.0	597.2	597.4	597.6	597.8		598.0
0*	0	0	0	0	0	0	0	0	160	530	1,030	1,640	2,320	3,080	3,910	4,810	5,760	6,770	7,840	8,950	10,110	0*
1	1,010	1,020	1,020	1,030	1,030	1,040	1,040	1,050	1,200	1,560	2,040	2,610	3,260	4,000	4,810	5,680	6,620	7,620	8,670	9,770	10,920	1
2	2,700	2,710	2,720	2,740	2,750	2,770	2,780	2,790	2,960	3,330	3,810	4,390	5,060	5,790	6,590	7,440	8,360	9,320	10,340	11,410	12,520	2
3	3,710	3,730	3,750	3,770	3,790	3,800	3,820	3,840	4,000	4,350	4,820	5,370	6,000	6,700	7,480	8,320	9,220	10,170	11,180	12,230	13,320	3
4	5,390	5,420	5,450	5,480	5,510	5,530	5,560	5,590	5,760	6,120	6,590	7,150	7,790	8,490	9,260	10,080	10,950	11,880	12,850	13,860	14,920	4
5	6,400	6,440	6,470	6,510	6,540	6,570	6,600	6,640	6,800	7,150	7,590	8,130	8,730	9,410	10,150	10,950	11,810	12,720	13,680	14,690	15,750	5
6	8,090	8,130	8,170	8,220	8,260	8,300	8,340	8,380	8,560	8,910	9,370	9,910	10,520	11,200	11,930	12,710	13,550	14,430	15,350	16,320	17,330	6
7	9,100	9,150	9,200	9,240	9,290	9,340	9,380	9,430	9,600	9,940	10,370	10,890	11,460	12,110	12,820	13,590	14,410	15,280	16,190	17,140	18,130	7
8	10,780	10,840	10,900	10,960	11,010	11,070	11,120	11,180	11,360	11,700	12,150	12,670	13,260	13,900	14,600	15,350	16,140	16,980	17,860	18,780	19,730	8
9	11,800	11,860	11,920	11,980	12,040	12,110	12,170	12,230	12,400	12,730	13,150	13,640	14,200	14,820	15,490	16,230	17,000	17,830	18,690	19,600	20,540	9
10	13,480	13,550	13,620	13,690	13,760	13,830	13,900	13,970	14,160	14,500	14,930	15,430	15,990	16,610	17,270	17,990	18,740	19,530	20,370	21,230	22,140	10
11	14,490	14,570	14,650	14,720	14,800	14,870	14,950	15,020	15,200	15,520	15,930	16,400	16,930	17,520	18,170	18,860	19,600	20,380	21,200	22,060	22,960	11
12	16,180	16,260	16,350	16,430	16,520	16,600	16,690	16,770	16,960	17,290	17,700	18,190	18,720	19,310	19,950	20,620	21,330	22,090	22,870	23,690	24,540	12
13	17,190	17,280	17,370	17,460	17,550	17,640	17,730	17,820	18,000	18,320	18,700	19,170	19,700	20,290	20,940	21,640	22,380	23,160	23,980	24,840	25,740	13
14	18,870	18,970	19,070	19,170	19,270	19,370	19,470	19,560	19,760	20,080	20,480	20,940	21,460	22,020	22,620	23,260	23,930	24,640	25,380	26,150	26,950	14
15	19,880	19,990	20,090	20,200	20,300	20,410	20,510	20,610	20,800	21,110	21,510	21,970	22,480	23,040	23,640	24,280	24,960	25,680	26,440	27,240	28,080	15
16	21,570	21,680	21,800	21,910	22,020	22,140	22,250	22,360	22,560	22,870	23,260	23,700	24,190	24,720	25,290	25,890	26,530	27,210	27,930	28,690	29,500	16
17	22,580	22,700	22,820	22,940	23,060	23,170	23,290	23,410	23,600	23,900	24,300	24,740	25,230	25,760	26,330	26,940	27,590	28,280	29,010	29,780	30,600	17
18	24,260	24,390	24,520	24,650	24,780	24,900	25,030	25,150	25,360	25,670	26,040	26,460	26,920	27,430	27,960	28,530	29,120	29,740	30,390	31,060	31,760	18
19	25,280	25,410	25,540	25,680	25,810	25,940	26,070	26,200	26,400	26,690	27,080	27,510	27,980	28,490	29,040	29,630	30,260	30,930	31,630	32,360	33,130	19
20	26,960	27,100	27,250	27,390	27,530	27,670	27,810	27,950	28,160	28,460	28,820	29,220	29,660	30,130	30,630	31,160	31,720	32,300	32,900	33,520	34,160	20
21	28,500	28,660	28,810	28,960	29,110	29,260	29,410	29,560	29,780	30,090	30,460	30,870	31,320	31,800	32,310	32,850	33,410	34,000	34,610	35,250	35,900	21
22	30,040	30,210	30,370	30,530	30,700	30,860	31,010	31,170	31,400	31,720	32,100	32,520	32,980	33,470	33,990	34,540	35,110	35,710	36,330	36,970	37,630	22
23	31,590	31,760	31,940	32,110	32,280	32,450	32,620	32,790	33,020	33,350	33,740	34,170	34,640	35,140	35,670	36,230	36,810	37,420	38,050	38,700	39,370	23
24	33,130	33,310	33,500	33,680	33,860	34,040	34,220	34,400	34,640	34,990	35,380	35,820	36,300	36,810	37,350	37,920	38,510	39,120	39,760	40,420	41,100	24
25	34,670	34,870	35,060	35,250	35,440	35,630	35,820	36,010	36,270	36,620	37,030	37,470	37,960	38,480	39,030	39,610	40,210	40,830	41,480	42,150	42,840	25
26	36,220	36,420	36,620	36,830	37,030	37,230	37,430	37,620	37,890	38,250	38,670	39,130	39,620	40,150	40,710	41,290	41,900	42,540	43,200	43,870	44,570	26
27	37,760	37,970	38,190	38,400	38,610	38,820	39,030	39,240	39,510	39,880	40,310	40,780	41,280	41,820	42,390	42,980	43,600	44,250	44,910	45,600	46,310	27
28	39,300	39,530	39,750	39,970	40,190	40,410	40,630	40,850	41,130	41,510	41,950	42,430	42,940	43,490	44,070	44,670	45,300	45,950	46,630	47,320	48,040	28
29	40,840	41,080	41,310	41,550	41,780	42,010	42,230	42,460	42,760	43,150	43,590	44,080	44,600	45,160	45,750	46,360	47,000	47,660	48,340	49,050	49,780	29
30	41,860	42,100	42,340	42,570	42,810	43,040	43,280	43,510	43,800	44,170	44,600	45,040	45,510	46,010	46,540	47,100	47,690	48,310	48,950	49,610	50,290	30
31	43,400	43,640	43,880	44,120	44,360	44,600	44,840	45,080	45,450	45,840	46,270	46,740	47,240	47,760	48,300	48,870	49,470	50,090	50,730	51,390	52,080	31
32	44,940	45,180	45,420	45,660	45,900	46,140	46,380	46,620	46,970	47,340	47,770	48,170	48,600	49,060	49,550	50,070	50,610	51,170	51,750	52,350	52,970	32
33	46,480	46,720	46,960	47,200	47,440	47,680	47,920	48,160	48,500	48,880	49,290	49,730	50,190	50,680	51,190	51,720	52,270	52,840	53,430	54,040	54,670	33
34	47,780	48,050	48,330	48,600	48,870	49,130	49,400	49,660	49,980	50,360	50,790	51,250	51,730	52,240	52,770	53,320	53,890	54,470	55,070	55,690	56,320	34
35	49,320	49,610	49,890	50,170	50,450	50,730	51,000	51,280	51,600	52,000	52,430	52,900	53,390	53,910	54,450	55,010	55,590	56,180	56,790	57,420	58,060	35
36	50,860	51,170	51,480	51,790	52,100	52,410	52,720	53,030	53,400	53,820	54,290	54,790	55,290	55,810	56,340	56,890	57,460	58,040	58,640	59,260	59,900	36
37	52,400	52,720	53,040	53,360	53,680	54,000	54,320	54,640	55,000	55,400	55,840	56,310	56,790	57,290	57,810	58,350	58,910	59,490	60,090	60,710	61,350	37
38	53,940	54,270	54,600	54,930	55,260	55,590	55,920	56,250	56,600	57,000	57,440	57,910	58,390	58,890	59,410	59,940	60,490	61,060	61,650	62,260	62,890	38
39	55,480	55,820	56,160	56,500	56,840	57,180	57,520	57,860	58,200	58,590	59,020	59,480	59,970	60,480	60,990	61,520	62,070	62,640	63,220	63,820	64,440	39
40	58,950	59,290	59,630	59,960	60,290	60,620	60,950	61,270	61,620	62,010	62,410	62,820	63,250	63,690	64,140	64,600	65,070	65,540	66,030	66,510	67,010	40
41	60,490	60,840	61,190	61,530	61,870	62,210	62,550	62,890	63,240	63,640	64,050	64,480	64,920	65,360	65,820	66,290	66,770	67,250	67,740	68,240	68,740	41
42	63,370	63,740	64,120	64,490	64,870	65,240	65,610	65,980	66,360	66,750	67,150	67,570	68,000	68,440	68,890	69,350	69,820	70,290	70,770	71,260	71,760	42
43	66,240	66,640	67,040	67,440	67,830	68,230	68,620	69,000	69,410	69,860	70,320	70,800	71,290	71,790	72,300	72,820	73,350	73,880	74,420	74,970	75,520	43
44	69,120	69,540	69,970	70,390	70,820	71,230	71,650	72,060	72,500	72,970	73,460	73,960	74,480	75,010	75,540	76,080	76,640	77,190	77,760	78,330	78,910	44
45	71,990	72,450	72,900	73,350	73,800	74,240	74,680	75,120	75,580	76,080	76,600	77,130	77,670	78,220	78,780	79,350	79,930	80,510	81,100	81,700	82,300	45
46	74,860	75,350	75,830	76,300	76,780	77,250	77,720	78,180	78,670	79,190	79,730	80,290	80,860	81,430	82,020	82,610	83,210	83,820	84,440	85,060	85,690	46
47	77,740	78,250	78,750	79,260	79,760	80,250	80,750	81,240	81,760	82,300	82,870	83,450	84,040	84,650	85,260	85,880	86,500	87,140	87,780	88,420	89,080	47
48	80,610	81,150	81,680	82,210	82,740	83,260	83,780	84,300	84,840	85,410	8											

## GUNTERSVILLE DAM SPILLWAY DISCHARGE IN CUBIC FEET PER SECOND

GAUGE ELEVATION	HEADWATER ELEVATION																			GAUGE ELEVATION		
	594.0	594.2	594.4	594.6	594.8	595.0	595.2	595.4	595.6	595.8	596.0	596.2	596.4	596.6	596.8	597.0	597.2	597.4	597.6		597.8	598.0
55	102,100	102,800	103,500	104,200	105,000	105,700	106,400	107,100	107,800	108,500	109,200	110,000	110,800	111,500	112,300	113,100	113,800	114,600	115,400	116,200	116,900	55
56	105,200	105,900	106,700	107,400	108,100	108,800	109,600	110,300	111,000	111,800	112,500	113,300	114,100	114,900	115,600	116,400	117,200	118,000	118,800	119,600	120,400	56
57	108,100	108,800	109,600	110,300	111,100	111,900	112,600	113,300	114,100	114,900	115,700	116,500	117,300	118,100	118,900	119,700	120,500	121,300	122,100	123,000	123,800	57
58	112,300	113,200	114,100	115,000	115,900	116,700	117,600	118,500	119,400	120,300	121,200	122,100	123,000	124,000	125,000	126,000	127,000	128,000	129,000	130,000	130,700	58
59	116,600	117,600	118,600	119,600	120,600	121,600	122,600	123,600	124,700	125,700	126,800	127,800	128,900	130,000	131,100	132,200	133,300	134,400	135,500	136,600	137,700	59
60	120,800	122,000	123,100	124,200	125,400	126,500	127,700	128,800	130,000	131,100	132,300	133,500	134,700	135,900	137,200	138,400	139,600	140,900	142,100	143,400	144,600	60
61	125,100	126,300	127,600	128,900	130,100	131,400	132,700	133,900	135,200	136,500	137,900	139,200	140,500	141,900	143,300	144,600	146,000	147,400	148,800	150,200	151,600	61
62	129,300	130,700	132,100	133,500	134,900	136,300	137,700	139,100	140,500	142,000	143,400	144,900	146,400	147,900	149,400	150,900	152,400	153,900	155,400	157,000	158,500	62
63	133,600	135,100	136,600	138,100	139,700	141,200	142,700	144,200	145,800	147,400	149,000	150,600	152,200	153,800	155,500	157,100	158,800	160,400	162,100	163,800	165,500	63
64	137,800	139,500	141,100	142,800	144,400	146,100	147,700	149,400	151,100	152,800	154,500	156,300	158,000	159,800	161,600	163,300	165,100	166,800	168,600	170,400	172,200	64
65	142,100	143,800	145,600	147,400	149,200	151,000	152,700	154,500	156,400	158,200	160,100	161,900	163,800	165,700	167,700	169,600	171,500	173,500	175,400	177,400	179,400	65
66	146,300	148,100	149,900	151,700	153,500	155,300	157,100	159,000	160,800	162,600	164,500	166,400	168,200	170,100	172,000	173,900	175,800	177,700	179,600	181,600	183,500	66
67	149,200	151,000	152,800	154,600	156,500	158,300	160,200	162,000	163,900	165,700	167,600	169,500	171,400	173,300	175,200	177,200	179,100	181,000	183,000	184,900	186,900	67
68	153,400	155,400	157,300	159,300	161,200	163,200	165,200	167,200	169,200	171,200	173,200	175,200	177,200	179,300	181,300	183,400	185,500	187,600	189,600	191,700	193,800	68
69	157,700	159,700	161,800	163,900	166,000	168,100	170,200	172,300	174,400	176,600	178,700	180,900	183,100	185,200	187,400	189,600	191,900	194,100	196,300	198,500	200,800	69
70	161,900	164,100	166,300	168,500	170,800	173,000	175,200	177,500	179,700	182,000	184,300	186,600	188,900	191,200	193,500	195,900	198,200	200,600	203,000	205,400	207,700	70
71	166,200	168,500	170,800	173,200	175,500	177,900	180,200	182,600	185,000	187,400	189,800	192,300	194,700	197,200	199,600	202,100	204,600	207,100	209,600	212,200	214,700	71
72	170,400	172,900	175,300	177,800	180,300	182,800	185,300	187,800	190,300	192,800	195,400	197,900	200,500	203,100	205,700	208,400	211,000	213,600	216,300	219,000	221,600	72
73	177,600	180,200	182,800	185,400	188,000	190,700	193,300	196,000	198,600	201,300	204,100	206,800	209,500	212,300	215,100	217,900	220,700	223,500	226,300	229,100	232,000	73
74	184,700	187,400	190,200	193,000	195,700	198,500	201,400	204,200	207,000	209,900	212,700	215,600	218,500	221,500	224,400	227,400	230,300	233,300	236,300	239,300	242,300	74
75	188,900	191,800	194,700	197,600	200,500	203,400	206,400	209,300	212,300	215,300	218,300	221,300	224,400	227,400	230,500	233,600	236,700	239,800	242,900	246,100	249,300	75
77	194,500	197,200	199,900	202,600	205,300	208,000	210,800	213,500	216,300	219,100	221,900	224,800	227,700	230,600	233,500	236,400	239,300	242,300	245,300	248,300	251,300	77
78	198,800	201,600	204,400	207,200	210,100	212,900	215,800	218,700	221,600	224,500	227,500	230,500	233,500	236,500	239,600	242,600	245,700	248,800	251,900	255,100	258,200	78
79	205,900	208,700	211,600	214,500	217,400	220,300	223,200	226,100	229,100	232,100	235,100	238,100	241,100	244,100	247,200	250,200	253,300	256,400	259,500	262,600	265,800	79
80	210,100	213,100	216,100	219,100	222,100	225,200	228,200	231,300	234,400	237,500	240,600	243,700	246,900	250,100	253,300	256,500	259,700	262,900	266,200	269,400	272,700	80
82	215,700	218,500	221,300	224,100	226,900	229,800	232,600	235,500	238,400	241,300	244,300	247,200	250,200	253,200	256,200	259,300	262,300	265,400	268,500	271,600	274,700	82
83	219,900	222,900	225,800	228,700	231,700	234,700	237,600	240,600	243,700	246,700	249,800	252,900	256,000	259,100	262,200	265,300	268,400	271,500	274,600	277,700	281,000	83
84	231,300	234,400	237,500	240,600	243,800	246,900	250,100	253,300	256,500	259,700	262,900	266,200	269,400	272,700	276,000	279,300	282,700	286,000	289,400	292,800	296,200	84
86	241,100	244,200	247,200	250,300	253,300	256,400	259,500	262,600	265,700	268,900	272,100	275,300	278,600	281,800	285,100	288,400	291,700	295,000	298,400	301,700	305,100	86
87	252,500	255,700	258,900	262,200	265,400	268,700	271,900	275,200	278,500	281,900	285,200	288,600	292,000	295,400	298,800	302,200	305,700	309,100	312,600	316,100	319,600	87
89	262,300	265,500	268,800	271,800	275,000	278,200	281,400	284,600	287,800	291,100	294,400	297,700	301,100	304,500	308,000	311,400	314,900	318,400	321,900	325,400	328,900	89
90	273,700	277,000	280,300	283,700	287,000	290,400	293,800	297,200	300,600	304,100	307,500	311,000	314,500	318,000	321,500	325,100	328,700	332,200	335,800	339,400	343,100	90
92	283,500	286,700	290,000	293,300	296,600	299,900	303,200	306,500	309,900	313,300	316,700	320,200	323,600	327,100	330,600	334,100	337,700	341,200	344,800	348,400	352,000	92
93	294,900	298,300	301,700	305,200	308,700	312,200	315,700	319,200	322,700	326,300	329,800	333,400	337,000	340,700	344,300	348,000	351,600	355,300	359,000	362,800	366,500	93
95	307,000	310,300	313,700	317,100	320,400	323,800	327,300	330,700	334,100	337,600	341,100	344,600	348,200	351,800	355,400	359,000	362,600	366,200	369,900	373,600	377,300	95
96	318,300	321,900	325,400	329,000	332,500	336,100	339,700	343,300	346,900	350,600	354,200	357,900	361,600	365,300	369,000	372,800						96
98	330,500	333,900	337,400	340,800	344,300	347,800	351,300	354,800	358,300	361,900	365,500	369,100										98
99	341,800	345,500	349,100	352,700	356,400	360,000	363,700	367,400	371,100													99
101	354,000	357,500	361,000	364,600	368,200	371,700																101
102	365,300	369,000	372,800																			102

HEADWATER 594 to 598  
TAILWATER Up to 572.5

# GUNTERSVILLE DAM SPILLWAY DISCHARGE IN CUBIC FEET PER SECOND

GATE ARRANGEMENT	HEADWATER ELEVATION																				GATE ARRANGEMENT	
	598.0	598.2	598.4	598.6	598.8	599.0	599.2	599.4	599.6	599.8	600.0	600.2	600.4	600.6	600.8	601.0	601.2	601.4	601.6	601.8		602.0
0*	10, 110	11, 320	12, 570	13, 860	15, 200	16, 580	18, 000	19, 450	20, 940	22, 470	24, 030											0*
1	10, 920	12, 120	13, 360	14, 650	15, 980	17, 350	18, 760	20, 210	21, 690	23, 210	24, 770											1
2	12, 520	13, 670	14, 860	16, 110	17, 400	18, 740	20, 130	21, 550	23, 020	24, 520	26, 060											2
4	14, 920	16, 020	17, 160	18, 350	19, 610	20, 910	22, 260	23, 660	25, 090	26, 570	28, 080											4
6	17, 330	18, 370	19, 450	20, 600	21, 810	23, 080	24, 400	25, 760	27, 170	28, 610	30, 100											6
8	19, 730	20, 720	21, 750	22, 840	24, 010	25, 240	26, 530	27, 860	29, 240	30, 660	32, 130											8
10	22, 140	23, 070	24, 040	25, 080	26, 210	27, 410	28, 660	29, 960	31, 310	32, 710	34, 150											10
12	24, 540	25, 420	26, 330	27, 330	28, 420	29, 580	30, 800	32, 070	33, 390	34, 760	36, 170											12
14	26, 950	27, 770	28, 630	29, 570	30, 620	31, 740	32, 930	34, 170	35, 460	36, 810	38, 190											14
16	29, 350	30, 130	30, 920	31, 810	32, 820	33, 910	35, 060	36, 270	37, 540	38, 850	40, 220											16
18	31, 760	32, 480	33, 220	34, 060	35, 020	36, 080	37, 200	38, 380	39, 610	40, 900	42, 240											18
20	34, 160	34, 830	35, 510	36, 300	37, 230	38, 240	39, 330	40, 480	41, 690	42, 950	44, 260											20
21	35, 900	36, 570	37, 260	38, 050	38, 970	39, 960	41, 030	42, 150	43, 320	44, 550	45, 820											21
22	37, 630	38, 320	39, 020	39, 810	40, 710	41, 690	42, 720	43, 820	44, 960	46, 140	47, 370											22
23	39, 370	40, 060	40, 770	41, 560	42, 450	43, 410	44, 420	45, 480	46, 590	47, 740	48, 930											23
24	41, 100	41, 800	42, 520	43, 310	44, 190	45, 130	46, 120	47, 150	48, 230	49, 340	50, 490											24
25	42, 840	43, 550	44, 270	45, 060	45, 930	46, 850	47, 820	48, 820	49, 860	50, 930	52, 040											25
26	44, 570	45, 290	46, 030	46, 820	47, 670	48, 570	49, 510	50, 490	51, 490	52, 530	53, 600											26
27	46, 310	47, 030	47, 780	48, 570	49, 410	50, 290	51, 210	52, 150	53, 130	54, 130	55, 150											27
28	48, 040	48, 780	49, 530	50, 320	51, 150	52, 020	52, 910	53, 820	54, 760	55, 720	56, 710											28
29	49, 780	50, 520	51, 280	52, 080	52, 890	53, 740	54, 600	55, 490	56, 400	57, 320	58, 260											29
31	52, 180	52, 870	53, 580	54, 320	55, 100	55, 900	56, 740	57, 590	58, 470	59, 370	60, 290											31
32	53, 920	54, 620	55, 330	56, 070	56, 840	57, 630	58, 430	59, 260	60, 110	60, 970	61, 840											32
34	56, 320	56, 970	57, 630	58, 310	59, 040	59, 790	60, 570	61, 360	62, 180	63, 010	63, 870											34
35	58, 060	58, 710	59, 380	60, 070	60, 780	61, 510	62, 270	63, 030	63, 810	64, 610	65, 420											35
37	60, 460	61, 060	61, 670	62, 310	62, 980	63, 680	64, 400	65, 140	65, 890	66, 660	67, 440											37
38	62, 200	62, 810	63, 420	64, 060	64, 730	65, 400	66, 100	66, 800	67, 520	68, 260	69, 000											38
39	64, 600	65, 160	65, 720	66, 310	66, 930	67, 570	68, 230	68, 910	69, 600	70, 300	71, 020											39
40	67, 010	67, 510	68, 010	68, 550	69, 130	69, 740	70, 360	71, 010	71, 670	72, 350	73, 050											40
41	68, 740	69, 250	69, 770	70, 300	70, 870	71, 460	72, 060	72, 680	73, 310	73, 950	74, 600											41
42	72, 130	72, 660	73, 200	73, 770	74, 360	74, 970	75, 600	76, 240	76, 890	77, 560	78, 230											42
43	75, 520	76, 080	76, 640	77, 230	77, 850	78, 480	79, 130	79, 800	80, 480	81, 170	81, 870											43
44	78, 910	79, 490	80, 080	80, 690	81, 330	81, 990	82, 670	83, 360	84, 060	84, 780	85, 500											44
45	82, 300	82, 910	83, 520	84, 160	84, 820	85, 510	86, 210	86, 920	87, 650	88, 390	89, 130											45
46	85, 690	86, 320	86, 960	87, 620	88, 310	89, 020	89, 740	90, 480	91, 230	91, 990	92, 770											46
47	89, 080	89, 730	90, 400	91, 080	91, 800	92, 530	93, 280	94, 040	94, 820	95, 600	96, 400											47
48	92, 470	93, 150	93, 840	94, 550	95, 290	96, 040	96, 820	97, 600	98, 400	99, 210	100, 000											48
49	95, 860	96, 560	97, 280	98, 010	98, 770	99, 560	100, 400	101, 200	102, 000	102, 800	103, 700											49
50	100, 000	100, 700	101, 300	102, 000	102, 700	103, 400	104, 200	104, 900	105, 700	106, 500	107, 200											50
51	103, 400	104, 100	104, 800	105, 500	106, 200	107, 000	107, 700	108, 500	109, 300	110, 100	110, 900											51
52	106, 800	107, 500	108, 200	108, 900	109, 700	110, 500	111, 300	112, 100	112, 900	113, 700	114, 500											52
53	110, 200	110, 900	111, 600	112, 400	113, 200	114, 000	114, 800	115, 600	116, 500	117, 300	118, 100											53
54	113, 600	114, 300	115, 100	115, 900	116, 700	117, 500	118, 300	119, 200	120, 000	120, 900	121, 800											54
55	116, 900	117, 700	118, 500	119, 300	120, 200	121, 000	121, 900	122, 700	123, 600	124, 500	125, 400											55
56	120, 400	121, 200	122, 000	122, 800	123, 600	124, 400	125, 300	126, 100	126, 900	127, 700	128, 500											56
57	123, 800	124, 600	125, 500	126, 300	127, 100	128, 000	128, 800	129, 600	130, 500	131, 300	132, 200											57
58	130, 700	131, 700	132, 700	133, 700	134, 700	135, 600	136, 600	137, 600	138, 600	139, 600	140, 600											58
59	137, 700	138, 800	139, 900	141, 100	142, 200	143, 300	144, 500	145, 600	146, 800	147, 900	149, 100											59
60	144, 600	145, 900	147, 200	148, 400	149, 700	151, 000	152, 300	153, 600	154, 900	156, 200	157, 500											60
61	151, 600	153, 000	154, 400	155, 800	157, 300	158, 700	160, 100	161, 600	163, 100	164, 500	166, 000											61
62	158, 500	160, 100	161, 600	163, 200	164, 800	166, 400	168, 000	169, 600	171, 200	172, 800	174, 400											62
63	165, 500	167, 200	168, 900	170, 600	172, 300	174, 100	175, 800	177, 600	179, 300	181, 100	182, 900											63
64	172, 400	174, 300	176, 100	178, 000	179, 900	181, 800	183, 700	185, 600	187, 500	189, 400	191, 400											64
65	179, 400	181, 400	183, 400	185, 400	187, 400	189, 400	191, 500	193, 600	195, 600	197, 700	199, 800											65
66	183, 500	185, 500	187, 400	189, 400	191, 300	193, 300	195, 300	197, 300	199, 400	201, 400	203, 400											66

MARCH 2004

\* Arrangement "0" indicates that all spillway gates are closed.  
Discharge is spillway gate and trash gate overflow.

HEADWATER 598 to 602  
TAILWATER Up to 572.5



# GUNTERSVILLE DAM SPILLWAY DISCHARGE IN CUBIC FEET PER SECOND

RANGE- MENT	HEADWATER ELEVATION																				RANGE- MENT	
	598.0	598.2	598.4	598.6	598.8	599.0	599.2	599.4	599.6	599.8	600.0	600.2	600.4	600.6	600.8	601.0	601.2	601.4	601.6	601.8		602.0
67	186,900	188,900	190,800	192,800	194,800	196,800	198,900	200,900	202,900	205,000	207,000											67
68	193,800	196,000	198,100	200,200	202,400	204,500	206,700	208,900	211,100	213,300	215,500											68
69	200,800	203,100	205,300	207,600	209,900	212,200	214,500	216,900	219,200	221,600	223,900											69
70	207,700	210,100	212,600	215,000	217,400	219,900	222,400	224,900	227,400	229,900	232,400											70
71	214,700	217,200	219,800	222,400	225,000	227,600	230,200	232,900	235,500	238,200	240,900											71
72	221,600	224,300	227,000	229,700	232,500	235,300	238,100	240,900	243,700	246,500	249,300											72
73	232,000	234,800	237,700	240,600	243,500	246,500	249,400	252,400	255,400	258,400	261,400											73
74	242,300	245,300	248,400	251,400	254,500	257,700	260,800	264,000	267,100	270,300	273,500											74
75	249,300	252,400	255,600	258,800	262,100	265,300	268,600	271,900	275,300	278,600	282,000											75
77	251,300	254,300	257,300	260,400	263,500	266,600	269,700	272,900	276,100	279,200	282,400											77
78	258,200	261,400	264,600	267,800	271,000	274,300	277,600	280,900	284,200	287,500	290,900											78
79	265,800	268,900	272,100	275,200	278,400	281,700	284,900	288,200	291,500	294,800	298,100											79
80	272,700	276,000	279,300	282,600	286,000	289,400	292,800	296,200	299,600	303,100	306,600											80
82	274,700	277,900	281,000	284,200	287,400	290,600	293,900	297,200	300,400	303,700	307,100											82
83	281,700	285,000	288,300	291,600	294,900	298,300	301,700	305,100	308,600	312,000	315,500											83
84	296,200	299,600	303,000	306,400	309,900	313,400	316,900	320,500	324,000	327,600	331,200											84
86	305,100	308,500	311,900	315,400	318,800	322,300	325,900	329,400	333,000	336,500	340,100											86
87	319,600	323,100	326,700	330,200	333,800	337,400	341,100	344,700	348,400	352,100	355,800											87
89	328,600	332,100	335,600	339,200	342,800	346,400	350,000	353,700	357,300	361,000	364,700											89
90	343,100	346,700	350,400	354,000	357,700	361,500	365,200	369,000	372,800													90
92	352,000	355,700	359,300	363,000	366,700	370,400	374,200															92
93	366,500	370,300	374,000																			93

HEADWATER 598 to 602  
TAILWATER Up to 572.5

MARCH 2004

**GUNTERVILLE DAM  
SPILLWAY DISCHARGE  
IN CUBIC FEET PER SECOND**

GAUGE- PIVOT - FEET	HEADWATER ELEVATION																			TAILWATER PIVOT - FEET		
	590.0	590.2	590.4	590.6	590.8	591.0	591.2	591.4	591.6	591.8	592.0	592.2	592.4	592.6	592.8	593.0	593.2	593.4	593.6		593.8	594.0
1	900	910	920	920	930	930	940	940	950	950	960	970	970	980	980	990	990	1,000	1,000	1,010	1,010	1,010
2	2,380	2,400	2,420	2,430	2,450	2,470	2,480	2,500	2,510	2,530	2,550	2,560	2,580	2,590	2,610	2,620	2,640	2,650	2,670	2,680	2,700	2,700
3	3,290	3,310	3,330	3,360	3,380	3,400	3,420	3,440	3,460	3,490	3,510	3,530	3,550	3,570	3,590	3,610	3,630	3,650	3,670	3,690	3,710	3,710
4	4,770	4,800	4,840	4,870	4,900	4,930	4,970	5,000	5,030	5,060	5,090	5,120	5,150	5,180	5,210	5,240	5,270	5,300	5,330	5,360	5,390	5,390
5	5,670	5,710	5,750	5,790	5,830	5,870	5,900	5,940	5,980	6,020	6,050	6,090	6,120	6,160	6,200	6,230	6,270	6,300	6,340	6,370	6,400	6,400
6	7,150	7,200	7,250	7,300	7,350	7,400	7,450	7,500	7,540	7,590	7,640	7,680	7,730	7,780	7,820	7,870	7,910	7,960	8,000	8,040	8,090	8,090
7	8,060	8,110	8,170	8,220	8,280	8,330	8,390	8,440	8,490	8,550	8,600	8,650	8,700	8,750	8,800	8,850	8,900	8,950	9,000	9,050	9,100	9,100
8	9,540	9,610	9,670	9,740	9,800	9,870	9,930	10,000	10,060	10,120	10,180	10,250	10,310	10,370	10,430	10,490	10,550	10,610	10,670	10,730	10,780	10,780
9	10,440	10,510	10,590	10,660	10,730	10,800	10,870	10,940	11,010	11,080	11,140	11,210	11,280	11,350	11,410	11,480	11,540	11,610	11,670	11,730	11,800	11,800
10	11,920	12,010	12,090	12,170	12,250	12,330	12,420	12,500	12,570	12,650	12,730	12,810	12,880	12,960	13,040	13,110	13,190	13,260	13,330	13,410	13,480	13,480
11	12,830	12,920	13,000	13,090	13,180	13,270	13,350	13,440	13,520	13,610	13,690	13,770	13,860	13,940	14,020	14,100	14,180	14,260	14,340	14,410	14,490	14,490
12	14,310	14,410	14,510	14,610	14,700	14,800	14,900	15,000	15,090	15,180	15,280	15,370	15,460	15,550	15,640	15,730	15,820	15,910	16,000	16,090	16,180	16,180
13	15,210	15,320	15,420	15,530	15,630	15,730	15,840	15,940	16,040	16,140	16,240	16,340	16,430	16,530	16,630	16,720	16,820	16,910	17,000	17,100	17,190	17,190
14	16,690	16,810	16,930	17,040	17,160	17,270	17,380	17,490	17,600	17,710	17,820	17,930	18,040	18,150	18,250	18,360	18,460	18,560	18,670	18,770	18,870	18,870
15	17,600	17,720	17,840	17,960	18,080	18,200	18,320	18,440	18,550	18,670	18,780	18,900	19,010	19,120	19,230	19,340	19,450	19,560	19,670	19,780	19,880	19,880
16	19,080	19,210	19,340	19,480	19,610	19,740	19,860	19,990	20,120	20,240	20,370	20,490	20,620	20,740	20,860	20,980	21,100	21,220	21,330	21,450	21,570	21,570
17	19,980	20,120	20,260	20,400	20,530	20,670	20,800	20,940	21,070	21,200	21,330	21,460	21,590	21,710	21,840	21,970	22,090	22,210	22,340	22,460	22,580	22,580
18	21,460	21,610	21,760	21,910	22,060	22,200	22,350	22,490	22,630	22,770	22,920	23,050	23,190	23,330	23,470	23,600	23,740	23,870	24,000	24,130	24,260	24,260
19	22,360	22,520	22,680	22,830	22,980	23,140	23,290	23,430	23,580	23,730	23,880	24,020	24,160	24,310	24,450	24,590	24,730	24,870	25,000	25,140	25,280	25,280
20	23,850	24,010	24,180	24,340	24,510	24,670	24,830	24,990	25,150	25,310	25,460	25,620	25,770	25,920	26,070	26,220	26,370	26,520	26,670	26,810	26,960	26,960
21	25,170	25,350	25,530	25,700	25,880	26,050	26,220	26,390	26,560	26,730	26,900	27,060	27,230	27,390	27,550	27,710	27,870	28,030	28,190	28,350	28,500	28,500
22	26,490	26,680	26,870	27,060	27,250	27,430	27,620	27,800	27,980	28,160	28,340	28,510	28,690	28,860	29,030	29,210	29,380	29,540	29,710	29,880	30,040	30,040
23	27,820	28,020	28,220	28,420	28,620	28,810	29,010	29,200	29,390	29,580	29,770	29,960	30,150	30,330	30,510	30,700	30,880	31,060	31,230	31,410	31,590	31,590
24	29,140	29,350	29,560	29,780	29,990	30,190	30,400	30,600	30,810	31,010	31,210	31,410	31,600	31,800	31,990	32,190	32,380	32,570	32,760	32,940	33,130	33,130
25	30,460	30,690	30,910	31,130	31,350	31,570	31,790	32,010	32,220	32,430	32,650	32,860	33,060	33,270	33,470	33,680	33,880	34,080	34,280	34,480	34,670	34,670
26	31,790	32,020	32,260	32,490	32,720	32,960	33,180	33,410	33,640	33,860	34,080	34,300	34,520	34,740	34,950	35,170	35,380	35,590	35,800	36,010	36,220	36,220
27	33,110	33,360	33,600	33,850	34,090	34,340	34,580	34,820	35,050	35,290	35,520	35,750	35,980	36,210	36,430	36,660	36,880	37,100	37,320	37,540	37,760	37,760
28	34,440	34,690	34,950	35,210	35,460	35,720	35,970	36,220	36,470	36,710	36,960	37,200	37,440	37,680	37,910	38,150	38,380	38,620	38,850	39,070	39,300	39,300
29	35,760	36,030	36,300	36,560	36,830	37,100	37,360	37,620	37,880	38,140	38,390	38,650	38,900	39,150	39,390	39,640	39,880	40,130	40,370	40,610	40,840	40,840
30	36,660	36,940	37,210	37,490	37,760	38,030	38,300	38,570	38,830	39,090	39,350	39,610	39,870	40,120	40,380	40,630	40,880	41,120	41,370	41,610	41,860	41,860
31	38,140	38,430	38,710	39,000	39,280	39,560	39,840	40,120	40,400	40,670	40,940	41,210	41,470	41,740	42,000	42,260	42,520	42,780	43,030	43,290	43,540	43,540
32	39,470	39,770	40,060	40,360	40,650	40,950	41,240	41,520	41,810	42,090	42,380	42,660	42,930	43,210	43,480	43,750	44,020	44,290	44,560	44,820	45,080	45,080
33	40,370	40,680	40,980	41,280	41,580	41,880	42,170	42,470	42,760	43,050	43,340	43,620	43,900	44,190	44,460	44,740	45,020	45,290	45,560	45,830	46,090	46,090
34	41,850	42,170	42,480	42,790	43,100	43,410	43,720	44,020	44,330	44,630	44,920	45,220	45,510	45,800	46,090	46,380	46,660	46,940	47,220	47,500	47,780	47,780
35	43,180	43,500	43,820	44,150	44,470	44,790	45,110	45,430	45,740	46,050	46,360	46,670	46,970	47,270	47,570	47,870	48,160	48,450	48,750	49,030	49,320	49,320
36	44,080	44,410	44,740	45,070	45,400	45,730	46,050	46,370	46,690	47,010	47,320	47,630	47,940	48,250	48,550	48,850	49,150	49,450	49,750	50,040	50,330	50,330
37	45,560	45,900	46,240	46,580	46,920	47,260	47,590	47,930	48,260	48,580	48,910	49,230	49,550	49,860	50,180	50,490	50,800	51,110	51,410	51,720	52,020	52,020
38	46,890	47,240	47,590	47,940	48,290	48,640	48,990	49,330	49,670	50,010	50,340	50,680	51,000	51,330	51,660	51,980	52,300	52,620	52,930	53,250	53,560	53,560
39	49,270	49,640	50,010	50,380	50,740	51,110	51,470	51,830	52,180	52,540	52,890	53,240	53,580	53,920	54,260	54,600	54,940	55,270	55,600	55,930	56,260	56,260
40	51,650	52,040	52,420	52,810	53,190	53,580	53,950	54,330	54,700	55,070	55,430	55,800	56,160	56,520	56,870	57,220	57,570	57,920	58,270	58,610	58,950	58,950
41	52,980	53,380	53,770	54,170	54,560	54,960	55,350	55,730	56,110	56,490	56,870	57,250	57,620	57,990	58,350	58,720	59,080	59,430	59,790	60,140	60,490	60,490
42	55,330	55,750	56,170	56,590	57,010	57,420	57,830	58,240	58,650	59,060	59,470	59,870	60,270	60,670	61,070	61,450	61,840	62,230	62,610	62,990	63,370	63,370
43	57,670	58,120	58,560	59,010	59,450	59,890	60,320	60,750	61,190	61,630	62,070	62,500	62,930	63,350	63,770	64,190	64,610	65,020	65,430	65,840	66,240	66,240
44	60,020	60,490	60,960	61,430	61,890	62,350	62,800	63,260	63,730	64,200	64,660	65,120	65,580	66,030	66,480	66,930	67,370	67,810	68,250	68,680	69,120	69,120
45	62,370	62,860	63,350	63,840	64,330	64,810	65,290	65,780	66,270	66,750	67,230	67,710	68,190	68,670	69,150	69,620	70,100	70,570	71,050	71,530	71,990	71,990
46	64,720	65,240	65,750	66,260	66,770	67,280	67,770	68,290	68,810	69,340	69,860	70,370	70,890	71,400	71,900	72,400	72,900	73,400	73,890	74,380	74,860	74,860
47	67,060	67,610	68,150	68,680	69,210	69,740	70,260	70,800	71,350	71,910	72,460	73,000	73,540	74,080	74,610	75,140	75,670	76,190	76,710	77,220	77,740	77,740
48	69,410	69,980	70,540	71,100	71,650	72,200	72,750	73,310	73,890	74,480	75,050	75,630	76,200	76,760	77,320	77,880	78,430	78,98				

## GUNTERSVILLE DAM SPILLWAY DISCHARGE IN CUBIC FEET PER SECOND

GAGE NUMBER	HEADWATER ELEVATION																				GAGE NUMBER	
	590.0	590.2	590.4	590.6	590.8	591.0	591.2	591.4	591.6	591.8	592.0	592.2	592.4	592.6	592.8	593.0	593.2	593.4	593.6	593.8		594.0
56	89,850	90,620	91,370	92,120	92,860	93,600	94,320	95,090	95,890	96,700	97,490	98,290	99,070	99,850	100,600	101,400	102,200	102,900	103,700	104,400	105,200	56
57	92,200	92,990	93,770	94,540	95,300	96,060	96,810	97,600	98,430	99,270	100,100	100,900	101,700	102,500	103,300	104,100	104,900	105,700	106,500	107,300	108,100	57
58	94,120	95,020	95,910	96,790	97,670	98,540	99,400	100,300	101,300	102,200	103,100	104,100	105,000	105,900	106,900	107,800	108,700	109,600	110,500	111,400	112,300	58
59	96,040	97,040	98,040	99,040	100,000	101,000	102,000	103,000	104,100	105,100	106,200	107,200	108,300	109,300	110,400	111,400	112,500	113,500	114,500	115,500	116,600	59
60	97,950	99,070	100,200	101,300	102,400	103,500	104,600	105,700	106,900	108,100	109,200	110,400	111,600	112,800	113,900	115,100	116,200	117,400	118,500	119,700	120,800	60
61	99,870	101,100	102,300	103,500	104,800	106,000	107,200	108,400	109,700	111,000	112,300	113,600	114,900	116,200	117,400	118,700	120,000	121,200	122,500	123,800	125,100	61
62	101,800	103,100	104,400	105,800	107,100	108,400	109,800	111,100	112,500	113,900	115,300	116,800	118,200	119,600	121,000	122,400	123,700	125,100	126,500	127,900	129,300	62
63	103,700	105,100	106,600	108,000	109,500	110,900	112,400	113,900	115,400	116,900	118,400	119,900	121,400	123,000	124,500	126,000	127,500	129,000	130,500	132,000	133,600	63
64	105,600	107,200	108,700	110,300	111,800	113,400	115,000	116,600	118,200	119,800	121,500	123,100	124,700	126,400	128,000	129,600	131,300	132,900	134,500	136,200	137,800	64
65	107,500	109,200	110,900	112,500	114,200	115,900	117,600	119,300	121,000	122,800	124,500	126,300	128,000	129,800	131,500	133,300	135,000	136,800	138,500	140,300	142,100	65
66	111,200	112,900	114,600	116,300	118,000	119,700	121,400	123,200	124,900	126,700	128,500	130,300	132,100	133,900	135,600	137,400	139,200	140,900	142,700	144,500	146,300	66
67	113,600	115,300	117,000	118,700	120,500	122,200	123,900	125,700	127,500	129,300	131,100	132,900	134,700	136,500	138,300	140,100	141,900	143,700	145,500	147,400	149,200	67
68	115,500	117,300	119,200	121,000	122,800	124,700	126,500	128,400	130,300	132,200	134,100	136,000	138,000	139,900	141,900	143,800	145,700	147,600	149,500	151,500	153,400	68
69	117,400	119,400	121,300	123,200	125,200	127,100	129,100	131,100	133,100	135,200	137,200	139,200	141,300	143,300	145,400	147,400	149,500	151,500	153,600	155,600	157,700	69
70	119,300	121,400	123,400	125,500	127,500	129,600	131,700	133,800	135,900	138,100	140,200	142,400	144,600	146,800	148,900	151,100	153,200	155,400	157,600	159,700	161,900	70
71	121,300	123,400	125,600	127,700	129,900	132,100	134,300	136,500	138,800	141,000	143,300	145,600	147,900	150,200	152,400	154,700	157,000	159,300	161,600	163,900	166,200	71
72	123,200	125,400	127,700	130,000	132,300	134,600	136,900	139,200	141,600	144,000	146,300	148,700	151,100	153,600	156,000	158,300	160,700	163,200	165,600	168,000	170,400	72
73	127,400	129,800	132,200	134,600	137,100	139,500	142,000	144,500	147,000	149,500	152,000	154,500	157,100	159,700	162,200	164,700	167,300	169,800	172,400	175,000	177,600	73
74	131,700	134,200	136,800	139,300	141,900	144,500	147,100	149,700	152,300	155,000	157,600	160,300	163,000	165,700	168,400	171,100	173,800	176,500	179,200	181,900	184,700	74
75	133,600	136,200	138,900	141,600	144,200	146,900	149,600	152,400	155,100	157,900	160,700	163,500	166,300	169,200	172,000	174,800	177,600	180,400	183,200	186,100	188,900	75
76	136,700	139,100	141,500	144,000	146,400	148,900	151,400	153,900	156,400	158,900	161,400	164,000	166,500	169,100	171,600	174,200	176,800	179,400	182,000	184,600	187,200	76
77	142,700	145,200	147,700	150,200	152,700	155,200	157,700	160,300	162,900	165,500	168,100	170,700	173,300	176,000	178,600	181,200	183,900	186,500	189,200	191,800	194,500	77
78	144,600	147,200	149,800	152,400	155,000	157,600	160,300	163,000	165,700	168,400	171,100	173,900	176,600	179,400	182,200	185,000	187,800	190,600	193,200	195,900	198,700	78
79	150,700	153,300	156,000	158,600	161,300	164,000	166,700	169,400	172,200	174,900	177,700	180,500	183,300	186,100	188,900	191,700	194,500	197,300	200,200	203,000	205,900	79
80	152,600	155,400	158,100	160,900	163,700	166,500	169,300	172,100	175,000	177,900	180,800	183,700	186,600	189,500	192,500	195,400	198,300	201,200	204,200	207,100	210,100	80
81	155,700	158,200	160,700	163,300	165,800	168,400	171,000	173,600	176,300	178,900	181,600	184,300	187,000	189,700	192,400	195,100	197,800	200,500	203,200	206,000	208,700	81
82	161,700	164,300	166,900	169,500	172,100	174,700	177,300	180,000	182,700	185,400	188,200	190,900	193,600	196,400	199,100	201,800	204,600	207,300	210,100	212,900	215,700	82
83	163,600	166,300	169,000	171,700	174,500	177,200	180,000	182,800	185,600	188,400	191,200	194,100	196,900	199,800	202,600	205,500	208,400	211,200	214,100	217,000	219,900	83
84	171,600	174,500	177,300	180,200	183,100	186,000	188,900	191,900	194,900	197,800	200,800	203,900	206,900	209,900	213,000	216,000	219,000	222,100	225,100	228,200	231,300	84
85	174,700	177,300	179,900	182,600	185,300	188,000	190,700	193,400	196,100	198,900											85	
86	182,600	185,400	188,200	191,100	193,900	196,800	199,600	202,500	205,400	208,300	211,300	214,200	217,200	220,200	223,200	226,100	229,100	232,100	235,100	238,100	241,100	86
87	190,600	193,600	196,500	199,500	202,500	205,500	208,600	211,600	214,700	217,800	220,900	224,000	227,200	230,300	233,500	236,600	239,700	242,900	246,100	249,300	252,500	87
88	193,700	196,400	199,200	201,900	204,700	207,500	210,300	213,100	216,000	218,800											88	
89	201,600	204,500	207,400	210,400	213,300	216,300	219,300	222,300	225,300	228,300	231,400	234,400	237,500	240,600	243,700	246,700	249,800	252,900	256,000	259,100	262,300	89
90	209,600	212,700	215,700	218,800	221,900	225,100	228,200	231,400	234,600	237,800	241,000	244,200	247,500	250,700	254,000	257,200	260,500	263,700	267,000	270,300	273,600	90
92	220,600	223,600	226,700	229,700	232,700	235,800	238,900	242,000	245,100	248,300	251,400	254,600	257,800	261,000	264,200	267,400	270,600	273,800	277,000	280,200	283,400	92
93	228,600	231,800	235,000	238,200	241,400	244,600	247,900	251,100	254,400	257,700	261,100	264,400	267,800	271,100	274,500	277,800	281,200	284,600	288,000	291,400	294,800	93
95	242,200	245,300	248,400	251,600	254,700	257,900	261,100	264,300	267,500	270,700	274,000	277,200	280,500	283,800	287,100	290,400	293,600	296,900	300,300	303,600	306,900	95
96	250,200	253,400	256,700	260,000	263,300	266,700	270,000	273,400	276,800	280,200	283,600	287,000	290,500	294,000	297,400	300,800	304,300	307,800	311,300	314,800	318,300	96
98	263,800	267,000	270,200	273,400	276,700	280,000	283,200	286,500	289,800	293,200	296,500	299,900	303,200	306,600	310,000	313,400	316,700	320,100	323,500	327,000	330,400	98
99	271,800	275,100	278,500	281,900	285,300	288,700	292,200	295,700	299,100	302,600	306,100	309,700	313,200	316,800	320,300	323,900	327,400	331,000	334,600	338,100	341,800	99
101	285,400	288,700	292,000	295,300	298,700	302,000	305,400	308,800	312,200	315,600	319,100	322,500	326,000	329,400	332,900	336,400	339,800	343,300	346,800	350,300	353,900	101
102	293,300	296,800	300,300	303,800	307,300	310,800	314,400	317,900	321,500	325,100	328,700	332,300	335,900	339,600	343,200	346,900	350,500	354,200	357,800	361,500	365,200	102
104	306,900	310,300	313,800	317,200	320,600	324,100	327,600	331,100	334,600	338,100	341,600	345,100	348,700	352,300	355,800	359,400	362,900	366,500	370,100	373,700	377,300	104
105	314,900	318,500	322,100	325,700	329,300	332,900	336,500	340,200	343,800	347,500	351,200	354,900	358,700								105	
106	321,200	324,600	328,100																			

# GUNTERSVILLE DAM SPILLWAY DISCHARGE IN CUBIC FEET PER SECOND

ARRANGEMENT	HEADWATER ELEVATION																				ARRANGEMENT	
	594.0	594.2	594.4	594.6	594.8	595.0	595.2	595.4	595.6	595.8	596.0	596.2	596.4	596.6	596.8	597.0	597.2	597.4	597.6	597.8		598.0
0*	0	0	0	0	0	0	0	0	160	530	1,030	1,640	2,320	3,080	3,910	4,810	5,760	6,770	7,840	8,950	10,110	0*
1	1,010	1,020	1,020	1,030	1,030	1,040	1,050	1,060	1,230	1,590	2,080	2,660	3,320	4,060	4,880	5,760	6,710	7,710	8,760	9,860	11,010	1
2	2,700	2,710	2,720	2,740	2,750	2,770	2,800	2,830	3,010	3,400	3,910	4,510	5,190	5,940	6,750	7,630	8,560	9,530	10,550	11,610	12,720	2
3	3,710	3,730	3,750	3,770	3,790	3,800	3,850	3,900	4,080	4,460	4,950	5,530	6,180	6,910	7,720	8,580	9,510	10,460	11,470	12,520	13,620	3
4	5,390	5,420	5,450	5,480	5,510	5,530	5,600	5,670	5,870	6,270	6,780	7,380	8,050	8,790	9,590	10,450	11,360	12,290	13,260	14,270	15,330	4
5	6,400	6,440	6,470	6,510	6,540	6,570	6,650	6,730	6,940	7,330	7,820	8,400	9,050	9,770	10,560	11,400	12,300	13,220	14,180	15,180	16,210	5
6	8,090	8,130	8,170	8,220	8,260	8,300	8,400	8,500	8,730	9,140	9,650	10,250	10,920	11,650	12,430	13,270	14,160	15,040	15,970	16,940	17,940	6
7	9,100	9,150	9,200	9,240	9,290	9,340	9,450	9,560	9,800	10,200	10,700	11,270	11,910	12,620	13,390	14,220	15,100	15,980	16,890	17,850	18,840	7
8	10,780	10,840	10,900	10,960	11,010	11,070	11,200	11,330	11,590	12,010	12,530	13,120	13,780	14,500	15,270	16,090	16,950	17,800	18,680	19,600	20,550	8
9	11,800	11,860	11,920	11,980	12,040	12,110	12,250	12,400	12,650	13,070	13,570	14,140	14,780	15,480	16,230	17,040	17,900	18,730	19,600	20,510	21,450	9
10	13,480	13,550	13,620	13,690	13,760	13,830	14,000	14,170	14,440	14,860	15,400	15,990	16,650	17,350	18,110	18,910	19,750	20,560	21,390	22,260	23,160	10
11	14,490	14,570	14,650	14,720	14,800	14,870	15,050	15,230	15,510	15,940	16,440	17,020	17,640	18,330	19,070	19,860	20,700	21,490	22,310	23,170	24,060	11
12	16,180	16,260	16,350	16,430	16,520	16,600	16,800	17,000	17,300	17,740	18,270	18,860	19,510	20,210	20,950	21,730	22,550	23,310	24,100	24,920	25,780	12
13	17,190	17,280	17,370	17,460	17,550	17,640	17,850	18,060	18,370	18,800	19,410	20,080	20,800	21,570	22,380	23,230	24,090	24,980	25,890	26,820	27,770	13
14	18,870	18,970	19,070	19,170	19,270	19,370	19,600	19,830	20,160	20,610	21,140	21,730	22,370	23,060	23,790	24,550	25,350	26,070	26,810	27,580	28,390	14
15	19,880	19,990	20,090	20,200	20,300	20,410	20,650	20,900	21,220	21,670	22,260	22,900	23,590	24,340	25,140	25,980	26,820	27,700	28,610	29,540	30,490	15
16	21,570	21,680	21,800	21,910	22,020	22,140	22,400	22,660	23,010	23,480	24,020	24,610	25,240	25,910	26,620	27,370	28,140	28,930	29,720	30,540	31,390	16
17	22,580	22,700	22,820	22,940	23,060	23,170	23,450	23,730	24,080	24,540	25,100	25,710	26,360	27,050	27,780	28,540	29,330	30,140	30,970	31,820	32,690	17
18	24,260	24,390	24,520	24,650	24,780	24,900	25,200	25,500	25,870	26,350	26,890	27,480	28,100	28,770	29,460	30,190	30,940	31,700	32,480	33,280	34,100	18
19	25,280	25,410	25,540	25,680	25,810	25,940	26,250	26,560	26,940	27,410	27,970	28,580	29,230	29,920	30,640	31,390	32,160	32,950	33,760	34,580	35,420	19
20	26,960	27,100	27,250	27,390	27,530	27,670	28,000	28,330	28,730	29,220	29,760	30,350	30,970	31,620	32,300	33,010	33,740	34,440	35,160	35,900	36,660	20
21	28,500	28,660	28,810	28,960	29,110	29,260	29,610	29,960	30,370	30,880	31,440	32,040	32,680	33,340	34,040	34,760	35,510	36,280	37,070	37,880	38,700	21
22	30,040	30,210	30,370	30,530	30,700	30,860	31,220	31,580	32,010	32,540	33,110	33,730	34,380	35,070	35,780	36,520	37,280	38,060	38,860	39,680	40,510	22
23	31,590	31,760	31,940	32,110	32,280	32,450	32,830	33,210	33,660	34,190	34,790	35,420	36,090	36,790	37,520	38,270	39,050	39,840	40,640	41,450	42,270	23
24	33,130	33,310	33,500	33,680	33,860	34,040	34,440	34,840	35,300	35,850	36,460	37,110	37,800	38,510	39,260	40,030	40,820	41,620	42,430	43,250	44,080	24
25	34,670	34,870	35,060	35,250	35,440	35,630	36,050	36,460	36,940	37,510	38,140	38,800	39,500	40,240	41,000	41,780	42,590	43,400	44,220	45,050	45,890	25
26	36,220	36,420	36,620	36,830	37,030	37,230	37,660	38,090	38,580	39,170	39,810	40,490	41,210	41,960	42,730	43,540	44,360	45,190	46,020	46,860	47,710	26
27	37,760	37,970	38,190	38,400	38,610	38,820	39,270	39,710	40,230	40,830	41,490	42,190	42,920	43,680	44,470	45,290	46,130	46,980	47,840	48,710	49,580	27
28	39,300	39,530	39,750	39,970	40,190	40,410	40,880	41,340	41,870	42,490	43,160	43,880	44,630	45,410	46,210	47,040	47,900	48,780	49,670	50,570	51,470	28
29	40,840	41,080	41,310	41,550	41,780	42,010	42,490	42,970	43,510	44,150	44,840	45,570	46,330	47,130	47,950	48,800	49,670	50,560	51,460	52,370	53,280	29
30	41,860	42,100	42,340	42,570	42,810	43,040	43,540	44,030	44,580	45,210	45,840	46,510	47,220	47,970	48,740	49,540	50,360	51,190	52,030	52,880	53,740	30
31	43,540	43,790	44,040	44,280	44,530	44,770	45,290	45,800	46,370	47,020	47,710	48,440	49,200	49,980	50,790	51,620	52,470	53,320	54,180	55,050	55,920	31
32	45,080	45,340	45,600	45,860	46,110	46,370	46,900	47,420	48,010	48,670	49,390	50,130	50,910	51,710	52,530	53,370	54,240	55,110	55,980	56,860	57,740	32
33	46,090	46,360	46,620	46,890	47,150	47,400	47,950	48,490	49,080	49,730	50,430	51,170	51,940	52,740	53,560	54,390	55,240	56,090	56,950	57,810	58,680	33
34	47,780	48,050	48,330	48,600	48,870	49,130	49,700	50,260	50,870	51,540	52,260	53,000	53,770	54,560	55,370	56,190	57,040	57,890	58,740	59,590	60,450	34
35	49,320	49,610	49,890	50,170	50,450	50,730	51,310	51,880	52,510	53,200	53,930	54,690	55,480	56,280	57,110	57,950	58,810	59,670	60,540	61,410	62,280	35
36	50,330	50,620	50,910	51,200	51,480	51,760	52,360	52,950	53,580	54,260	54,990	55,760	56,570	57,400	58,240	59,100	59,970	60,840	61,710	62,580	63,450	36
37	52,020	52,320	52,610	52,910	53,200	53,490	54,110	54,720	55,370	56,070	56,810	57,590	58,340	59,140	59,950	60,770	61,600	62,430	63,260	64,090	64,920	37
38	53,560	53,870	54,180	54,480	54,780	55,090	55,720	56,340	57,010	57,730	58,480	59,260	60,080	60,920	61,780	62,620	63,470	64,320	65,170	66,020	66,870	38
39	56,260	56,580	56,900	57,220	57,540	57,850	58,520	59,180	59,870	60,600	61,350	62,130	62,910	63,710	64,520	65,340	66,170	67,000	67,830	68,660	69,490	39
40	58,950	59,290	59,630	59,960	60,290	60,620	61,320	62,010	62,720	63,470	64,230	65,000	65,780	66,570	67,360	68,160	68,970	69,780	70,590	71,400	72,210	40
41	60,490	60,840	61,190	61,530	61,870	62,210	62,930	63,640	64,370	65,130	65,900	66,690	67,490	68,290	69,100	69,920	70,740	71,570	72,390	73,210	74,030	41
42	63,370	63,740	64,120	64,490	64,850	65,220	65,990	66,750	67,530	68,340	69,160	70,000	70,850	71,700	72,560	73,430	74,300	75,170	76,040	76,910	77,780	42
43	66,240	66,640	67,040	67,440	67,830	68,230	69,040	69,860	70,690	71,550	72,430	73,320	74,210	75,120	76,040	76,940	77,870	78,780	79,690	80,600	81,510	43
44	69,120	69,540	69,970	70,390	70,820	71,230	72,100	72,970	73,860	74,760	75,690	76,630	77,580	78,530	79,490	80,460	81,430	82,400	83,370	84,340	85,310	44
45	71,990	72,450	72,900	73,350	73,800	74,240	75,160	76,070	77,010	77,970	78,950	79,940	80,940	81,950	82,960	83,970	84,990	86,000	87,010	88,020	89,030	45
46	74,860	75,350	75,830	76,300	76,780	77,250	78,220	79,180	80,170	81,190	82,210	83,260	84,300	85,360	86,420	87,490	88,550	89,610	90,670	91,730	92,790	46
47	77,740	78,250	78,750	79,260	79,760	80,250	81,280	82,290	83,330	84,400	85,480	86,570	87,670	88,770	89,880	91,000	92,120	93,240	94,360	95,480	96,600	47
48	80,610	81,150	81,680	82,210	82,740	83,260	84,340	85,400	86,490	87,610	88,740	89,880	9									

# GUNTERSVILLE DAM SPILLWAY DISCHARGE IN CUBIC FEET PER SECOND

AVERAGE- HEIGHT- FEET	HEADWATER ELEVATION																				AVERAGE- HEIGHT- FEET	
	594.0	594.2	594.4	594.6	594.8	595.0	595.2	595.4	595.6	595.8	596.0	596.2	596.4	596.6	596.8	597.0	597.2	597.4	597.6	597.8		598.0
55	102,100	102,800	103,500	104,200	105,000	105,700	107,100	108,500	110,000	111,400	112,900	114,300	115,800	117,200	118,700	120,200	121,600	122,500	123,300	124,100	124,900	55
56	105,200	105,900	106,700	107,400	108,100	108,800	110,300	111,800	113,200	114,700	116,200	117,700	119,200	120,700	122,200	123,700	125,200	126,100	126,900	127,700	128,500	56
57	108,100	108,800	109,600	110,300	111,100	111,900	113,400	114,900	116,400	117,900	119,500	121,000	122,600	124,100	125,600	127,200	128,700	129,700	130,500	131,400	132,200	57
58	112,300	113,200	114,100	115,000	115,900	116,700	118,300	119,900	121,500	123,200	124,800	126,400	128,100	129,700	131,300	133,000	134,600	135,700	136,700	137,700	138,700	58
59	116,600	117,600	118,600	119,600	120,600	121,600	123,300	125,000	126,700	128,400	130,100	131,800	133,600	135,300	137,000	138,800	140,500	141,700	142,900	144,000	145,200	59
60	120,800	122,000	123,100	124,200	125,400	126,500	128,300	130,100	131,800	133,600	135,400	137,300	139,100	140,900	142,700	144,600	146,400	147,700	149,000	150,300	151,600	60
61	125,100	126,300	127,600	128,900	130,100	131,400	133,300	135,100	137,000	138,900	140,800	142,700	144,600	146,500	148,400	150,400	152,300	153,800	155,200	156,600	158,100	61
62	129,300	130,700	132,100	133,500	134,900	136,300	138,200	140,200	142,100	144,100	146,100	148,100	150,100	152,100	154,100	156,100	158,200	159,800	161,400	163,000	164,600	62
63	133,600	135,100	136,600	138,100	139,700	141,200	143,200	145,200	147,300	149,300	151,400	153,500	155,600	157,700	159,800	161,900	164,100	165,800	167,600	169,300	171,000	63
64	137,800	139,500	141,100	142,800	144,400	146,100	148,200	150,300	152,400	154,600	156,700	158,900	161,100	163,300	165,500	167,700	170,000	171,900	173,700	175,600	177,500	64
65	142,100	143,800	145,600	147,400	149,200	151,000	153,100	155,300	157,600	159,800	162,100	164,300	166,600	168,900	171,200	173,500	175,800	177,900	179,900	181,900	184,000	65
66	146,300	148,100	149,900	151,700	153,500	155,300	157,600	159,800	162,100	164,300	166,600	168,900	171,200	173,500	175,800	178,100	180,400	182,400	184,400	186,400	188,400	66
67	149,200	151,000	152,800	154,600	156,500	158,300	160,600	162,900	165,200	167,500	169,800	172,200	174,500	176,900	179,300	181,600	184,000	186,000	188,000	190,000	192,100	67
68	153,400	155,400	157,300	159,300	161,200	163,200	165,600	168,000	170,400	172,800	175,200	177,600	180,100	182,500	184,900	187,400	189,900	192,000	194,200	196,400	198,500	68
69	157,700	159,700	161,800	163,900	166,000	168,100	170,600	173,000	175,500	178,000	180,500	183,000	185,600	188,100	190,600	193,200	195,800	198,100	200,400	202,700	205,000	69
70	161,900	164,100	166,300	168,500	170,800	173,000	175,500	178,100	180,700	183,200	185,800	188,400	191,100	193,700	196,300	199,000	201,600	204,100	206,500	209,000	211,500	70
71	166,200	168,500	170,800	173,200	175,500	177,900	180,500	183,100	185,800	188,500	191,200	193,900	196,600	199,300	202,000	204,800	207,500	210,100	212,700	215,300	217,900	71
72	170,400	172,900	175,300	177,800	180,300	182,800	185,500	188,200	191,000	193,700	196,500	199,300	202,100	204,900	207,700	210,600	213,400	216,200	218,900	221,600	224,400	72
73	177,600	180,200	182,800	185,400	188,000	190,700	193,500	196,400	199,300	202,200	205,100	208,000	211,000	213,900	216,900	219,900	222,900	225,800	228,700	231,600	234,600	73
74	184,700	187,400	190,200	193,000	195,700	198,500	201,500	204,500	207,600	210,600	213,700	216,700	219,800	222,900	226,000	229,200	232,300	235,400	238,500	241,600	244,700	74
75	188,900	191,800	194,700	197,600	200,500	203,400	206,500	209,600	212,700	215,800	219,000	222,100	225,300	228,500	231,700	235,000	238,200	241,400	244,700	247,900	251,200	75
77	194,500	197,200	199,900	202,600	205,300	208,000	210,900	213,900	216,800	219,800	222,800	225,800	228,900	231,900	235,000	238,100	241,200	244,300	247,400	250,400	253,500	77
78	198,700	201,600	204,400	207,200	210,100	212,900	215,900	218,900	222,000	225,000	228,100	231,200	234,400	237,500	240,700	243,900	247,100	250,300	253,500	256,800	260,000	78
79	205,900	208,700	211,600	214,500	217,400	220,300	223,400	226,500	229,600	232,800	235,900	239,100	242,300	245,500	248,800	252,000	255,300	258,500	261,700	264,900	268,100	79
80	210,100	213,100	216,100	219,100	222,100	225,200	228,400	231,600	234,800	238,000	241,300	244,500	247,800	251,100	254,500	257,800	261,200	264,500	267,800	271,200	274,600	80
82	215,700	218,500	221,300	224,100	226,900	229,800	232,800	235,800	238,900	242,000	245,100	248,200	251,400	254,600	257,800	261,000	264,200	267,400	270,500	273,700	276,900	82
83	219,900	222,800	225,800	228,700	231,700	234,600	237,800	240,900	244,000	247,200	250,400	253,600	256,900	260,200	263,400	266,800	270,100	273,400	276,700	280,000	283,400	83
84	231,300	234,400	237,500	240,600	243,800	246,900	250,200	253,500	256,800	260,200	263,500	266,900	270,300	273,700	277,200	280,600	284,100	287,500	291,000	294,500	297,900	84
86	241,100	244,100	247,200	250,200	253,300	256,400	259,600	262,800	266,100	269,400	272,700	276,000	279,400	282,800	286,200	289,600	293,000	296,400	299,900	303,300	306,800	86
87	252,500	255,700	258,900	262,100	265,400	268,600	272,000	275,500	278,900	282,300	285,800	289,300	292,800	296,400	299,900	303,500	307,000	310,600	314,200	317,700	321,300	87
89	262,300	265,400	268,600	271,700	274,900	278,100	281,400	284,800	288,100	291,500	295,000	298,400	301,900	305,400	308,900	312,400	316,000	319,500	323,000	326,600	330,200	89
90	273,600	276,900	280,300	283,600	287,000	290,400	293,900	297,400	301,000	304,500	308,100	311,700	315,300	319,000	322,600	326,300	330,000	333,600	337,300	341,000	344,700	90
92	283,400	286,700	290,000	293,200	296,500	299,900	303,300	306,700	310,200	313,700	317,300	320,800	324,400	328,000	331,600	335,300	338,900	342,500	346,200	349,900	353,500	92
93	294,800	298,200	301,700	305,100	308,600	312,100	315,700	319,400	323,000	326,700	330,400	334,100	337,800	341,600	345,300	349,100	352,900	356,700	360,500	364,300	368,100	93
95	306,900	310,300	313,600	317,000	320,400	323,800	327,300	330,800	334,400	338,000	341,600	345,200	348,900	352,600	356,300	360,000	363,700	367,400	371,200	374,900	378,700	95
96	318,300	321,800	325,300	328,900	332,500	336,000	339,700	343,500	347,200	351,000	354,700	358,500	362,300	366,200	370,000	373,900	377,800	381,600				96
98	330,400	333,800	337,300	340,800	344,200	347,700	351,300	354,900	358,600	362,200	365,900	369,700	373,400	377,200	380,900							98
99	341,800	345,400	349,000	352,700	356,300	360,000	363,800	367,600	371,400	375,200												99
101	353,900	357,400	361,000	364,500	368,100	371,700																101
102	365,200	368,900	372,700	376,400	380,200																	102
104	377,300	381,000																				104

HEADWATER 594 to 598  
TAILWATER 572.51 to 573.50

MARCH 2004

# GUNTERSVILLE DAM SPILLWAY DISCHARGE IN CUBIC FEET PER SECOND

SPILLWAY ARRANGEMENT	HEADWATER ELEVATION																				TAILWATER ELEVATION	
	598.0	598.2	598.4	598.6	598.8	599.0	599.2	599.4	599.6	599.8	600.0	600.2	600.4	600.6	600.8	601.0	601.2	601.4	601.6	601.8		602.0
0*	10, 110	11, 320	12, 570	13, 860	15, 200	16, 580	18, 000	19, 450	20, 940	22, 470	24, 030											0*
1	11, 010	12, 210	13, 450	14, 740	16, 070	17, 440	18, 850	20, 290	21, 780	23, 300	24, 860											1
2	12, 720	13, 870	15, 070	16, 310	17, 610	18, 950	20, 340	21, 760	23, 220	24, 730	26, 270											2
4	15, 330	16, 430	17, 570	18, 760	20, 020	21, 330	22, 680	24, 070	25, 510	26, 980	28, 500											4
6	17, 940	18, 990	20, 070	21, 210	22, 430	23, 700	25, 020	26, 380	27, 790	29, 240	30, 730											6
8	20, 550	21, 540	22, 570	23, 660	24, 840	26, 070	27, 360	28, 690	30, 070	31, 500	32, 960											8
10	23, 160	24, 100	25, 070	26, 110	27, 250	28, 450	29, 700	31, 000	32, 360	33, 750	35, 190											10
12	25, 780	26, 660	27, 570	28, 560	29, 660	30, 820	32, 040	33, 310	34, 640	36, 010	37, 420											12
14	28, 390	29, 220	30, 070	31, 010	32, 070	33, 190	34, 380	35, 630	36, 920	38, 270	39, 660											14
16	31, 000	31, 770	32, 570	33, 460	34, 480	35, 570	36, 720	37, 940	39, 200	40, 520	41, 890											16
18	33, 610	34, 330	35, 070	35, 910	36, 890	37, 940	39, 060	40, 250	41, 490	42, 780	44, 120											18
20	36, 220	36, 890	37, 570	38, 360	39, 300	40, 310	41, 400	42, 560	43, 770	45, 040	46, 350											20
21	38, 030	38, 700	39, 400	40, 190	41, 110	42, 110	43, 180	44, 300	45, 480	46, 710	47, 980											21
22	39, 840	40, 520	41, 230	42, 020	42, 930	43, 910	44, 950	46, 050	47, 190	48, 380	49, 620											22
23	41, 650	42, 340	43, 060	43, 850	44, 750	45, 710	46, 720	47, 790	48, 900	50, 060	51, 250											23
24	43, 450	44, 160	44, 880	45, 680	46, 560	47, 510	48, 500	49, 540	50, 620	51, 730	52, 890											24
25	45, 260	45, 980	46, 710	47, 510	48, 380	49, 300	50, 270	51, 280	52, 330	53, 410	54, 520											25
26	47, 070	47, 800	48, 540	49, 330	50, 190	51, 100	52, 050	53, 030	54, 040	55, 080	56, 150											26
27	48, 880	49, 610	50, 370	51, 160	52, 010	52, 900	53, 820	54, 770	55, 750	56, 750	57, 790											27
28	50, 690	51, 430	52, 190	52, 990	53, 830	54, 700	55, 590	56, 510	57, 460	58, 430	59, 420											28
29	52, 500	53, 250	54, 020	54, 820	55, 640	56, 490	57, 370	58, 260	59, 170	60, 100	61, 050											29
31	55, 110	55, 810	56, 520	57, 270	58, 050	58, 870	59, 710	60, 570	61, 450	62, 360	63, 280											31
32	56, 920	57, 630	58, 350	59, 100	59, 870	60, 670	61, 480	62, 310	63, 170	64, 030	64, 920											32
34	59, 530	60, 180	60, 850	61, 550	62, 280	63, 040	63, 820	64, 630	65, 450	66, 290	67, 150											34
35	61, 340	62, 000	62, 680	63, 370	64, 100	64, 840	65, 600	66, 370	67, 160	67, 960	68, 780											35
37	63, 950	64, 560	65, 180	65, 820	66, 510	67, 210	67, 940	68, 680	69, 440	70, 220	71, 010											37
38	65, 760	66, 380	67, 000	67, 650	68, 320	69, 010	69, 710	70, 430	71, 150	71, 900	72, 650											38
39	68, 370	68, 930	69, 500	70, 100	70, 730	71, 380	72, 050	72, 740	73, 440	74, 150	74, 880											39
40	70, 980	71, 490	72, 010	72, 550	73, 140	73, 760	74, 390	75, 050	75, 720	76, 410	77, 110											40
41	72, 790	73, 310	73, 830	74, 380	74, 960	75, 550	76, 170	76, 790	77, 430	78, 080	78, 750											41
42	76, 460	77, 000	77, 550	78, 130	78, 730	79, 350	79, 990	80, 640	81, 310	81, 980	82, 670											42
43	80, 130	80, 700	81, 280	81, 880	82, 500	83, 150	83, 820	84, 490	85, 180	85, 880	86, 600											43
44	83, 800	84, 400	85, 000	85, 620	86, 280	86, 950	87, 640	88, 340	89, 060	89, 790	90, 520											44
45	87, 470	88, 090	88, 720	89, 370	90, 050	90, 750	91, 460	92, 190	92, 930	93, 690	94, 450											45
46	91, 140	91, 790	92, 440	93, 120	93, 830	94, 550	95, 290	96, 040	96, 810	97, 590	98, 380											46
47	94, 810	95, 490	96, 170	96, 870	97, 600	98, 350	99, 110	99, 890	100, 700	101, 500	102, 300											47
48	98, 480	99, 180	99, 890	100, 600	101, 400	102, 100	102, 900	103, 700	104, 600	105, 400	106, 200											48
49	102, 200	102, 900	103, 600	104, 400	105, 100	105, 900	106, 800	107, 600	108, 400	109, 300	110, 200											49
50	106, 600	107, 300	107, 900	108, 600	109, 400	110, 100	110, 900	111, 600	112, 400	113, 200	114, 000											50
51	110, 200	111, 000	111, 700	112, 400	113, 100	113, 900	114, 700	115, 500	116, 300	117, 100	117, 900											51
52	113, 900	114, 600	115, 400	116, 100	116, 900	117, 700	118, 500	119, 300	120, 200	121, 000	121, 900											52
53	117, 600	118, 300	119, 100	119, 900	120, 700	121, 500	122, 400	123, 200	124, 100	124, 900	125, 800											53
54	121, 300	122, 000	122, 800	123, 600	124, 500	125, 300	126, 200	127, 000	127, 900	128, 800	129, 700											54
55	124, 900	125, 700	126, 500	127, 400	128, 200	129, 100	130, 000	130, 900	131, 800	132, 700	133, 600											55
56	128, 500	129, 400	130, 200	131, 000	131, 900	132, 700	133, 500	134, 400	135, 200	136, 100	136, 900											56
57	132, 200	133, 100	133, 900	134, 800	135, 600	136, 500	137, 400	138, 200	139, 100	140, 000	140, 800											57
58	138, 700	139, 700	140, 700	141, 700	142, 700	143, 700	144, 800	145, 800	146, 800	147, 800	148, 900											58
59	145, 200	146, 300	147, 500	148, 600	149, 800	151, 000	152, 100	153, 300	154, 500	155, 700	156, 900											59
60	151, 600	152, 900	154, 200	155, 500	156, 900	158, 200	159, 500	160, 900	162, 200	163, 600	164, 900											60
61	158, 100	159, 500	161, 000	162, 500	163, 900	165, 400	166, 900	168, 400	169, 900	171, 400	172, 900											61
62	164, 600	166, 200	167, 800	169, 400	171, 000	172, 700	174, 300	176, 000	177, 600	179, 300	181, 000											62
63	171, 000	172, 800	174, 500	176, 300	178, 100	179, 900	181, 700	183, 500	185, 300	187, 100	189, 000											63
64	177, 500	179, 400	181, 300	183, 200	185, 200	187, 100	189, 100	191, 000	193, 000	195, 000	197, 000											64
65	184, 000	186, 000	188, 100	190, 100	192, 200	194, 300	196, 500	198, 600	200, 700	202, 900	205, 000											65
66	188, 400	190, 400	192, 400	194, 400	196, 500	198, 500	200, 600	202, 600	204, 700	206, 800	208, 900											66

MARCH 2004

\* Arrangement "0" indicates that all spillway gates are closed.  
Discharge is spillway gate and trash gate overflow.

HEADWATER 598 to 602  
TAILWATER 572.51 to 573.50

## GUNTERSVILLE DAM SPILLWAY DISCHARGE IN CUBIC FEET PER SECOND

GAGE ELEVATION	HEADWATER ELEVATION																				GAGE ELEVATION	
	598.0	598.2	598.4	598.6	598.8	599.0	599.2	599.4	599.6	599.8	600.0	600.2	600.4	600.6	600.8	601.0	601.2	601.4	601.6	601.8		602.0
67	192,100	194,100	196,100	198,200	200,200	202,300	204,400	206,500	208,600	210,700	212,800											67
68	198,500	200,700	202,900	205,100	207,300	209,500	211,800	214,000	216,300	218,600	220,800											68
69	205,000	207,300	209,700	212,000	214,400	216,800	219,200	221,600	224,000	226,400	228,900											69
70	211,500	213,900	216,400	218,900	221,400	224,000	226,600	229,100	231,700	234,300	236,900											70
71	217,900	220,600	223,200	225,800	228,500	231,200	233,900	236,700	239,400	242,200	244,900											71
72	224,400	227,200	230,000	232,800	235,600	238,500	241,300	244,200	247,100	250,000	252,900											72
73	234,600	237,500	240,500	243,400	246,400	249,500	252,500	255,600	258,700	261,800	264,900											73
74	244,700	247,800	251,000	254,100	257,300	260,500	263,700	267,000	270,300	273,500	276,800											74
75	251,200	254,400	257,700	261,000	264,400	267,700	271,100	274,500	278,000	281,400	284,900											75
77	253,500	256,600	259,700	262,900	266,000	269,300	272,500	275,700	279,000	282,200	285,500											77
78	260,000	263,200	266,500	269,800	273,100	276,500	279,900	283,300	286,700	290,100	293,600											78
79	268,100	271,300	274,600	277,800	281,100	284,500	287,800	291,200	294,600	297,900	301,300											79
80	274,600	277,900	281,300	284,700	288,200	291,700	295,200	298,700	302,300	305,800	309,400											80
82	276,900	280,100	283,400	286,600	289,900	293,200	296,500	299,900	303,300	306,600	310,000											82
83	283,400	286,700	290,100	293,500	297,000	300,400	303,900	307,400	311,000	314,500	318,100											83
84	297,900	301,400	304,900	308,500	312,000	315,600	319,300	322,900	326,500	330,200	333,900											84
86	306,800	310,200	313,700	317,300	320,800	324,400	328,000	331,600	335,300	338,900	342,600											86
87	321,300	324,900	328,600	332,200	335,900	339,600	343,300	347,100	350,800	354,600	358,400											87
89	330,200	333,800	337,400	341,000	344,600	348,300	352,100	355,800	359,500	363,300	367,100											89
90	344,700	348,400	352,200	355,900	359,700	363,500	367,400	371,200	375,100	379,000												90
92	353,500	357,300	361,000	364,700	368,500	372,300	376,100	380,000														92
93	368,100	371,900	375,800	379,700																		93
95	378,700	382,500																				95

HEADWATER 598 to 602  
TAILWATER 572.51 to 573.50

MARCH 2004

# GUNTERSVILLE DAM SPILLWAY DISCHARGE IN CUBIC FEET PER SECOND

		HEADWATER ELEVATION																				
		590.0	590.2	590.4	590.6	590.8	591.0	591.2	591.4	591.6	591.8	592.0	592.2	592.4	592.6	592.8	593.0	593.2	593.4	593.6		
1	970	980	980	990	990	1,000	1,010	1,010	1,020	1,020	1,030	1,030	1,040	1,050	1,050	1,060	1,060	1,070	1,070	1,080	1,080	1
2	2,540	2,560	2,570	2,590	2,610	2,620	2,640	2,660	2,670	2,690	2,700	2,720	2,740	2,750	2,770	2,780	2,800	2,810	2,830	2,840	2,860	2
3	3,510	3,530	3,550	3,580	3,600	3,620	3,650	3,670	3,690	3,710	3,730	3,760	3,780	3,800	3,820	3,840	3,860	3,880	3,900	3,920	3,940	3
4	5,080	5,110	5,140	5,180	5,210	5,250	5,280	5,310	5,350	5,380	5,410	5,440	5,470	5,510	5,540	5,570	5,600	5,630	5,660	5,690	5,720	4
5	6,050	6,090	6,130	6,170	6,210	6,250	6,290	6,320	6,360	6,400	6,440	6,480	6,510	6,550	6,590	6,620	6,660	6,700	6,730	6,770	6,800	5
6	7,610	7,670	7,720	7,770	7,820	7,870	7,920	7,970	8,020	8,070	8,110	8,160	8,210	8,260	8,300	8,350	8,400	8,440	8,490	8,530	8,580	6
7	8,580	8,640	8,700	8,760	8,810	8,870	8,920	8,980	9,040	9,090	9,140	9,200	9,250	9,300	9,360	9,410	9,460	9,510	9,560	9,610	9,660	7
8	10,150	10,220	10,290	10,360	10,430	10,490	10,560	10,620	10,690	10,760	10,820	10,880	10,950	11,010	11,070	11,140	11,200	11,260	11,320	11,380	11,440	8
9	11,120	11,200	11,270	11,350	11,420	11,490	11,560	11,640	11,710	11,780	11,850	11,920	11,990	12,060	12,120	12,190	12,260	12,330	12,390	12,460	12,520	9
10	12,690	12,780	12,860	12,950	13,030	13,120	13,200	13,280	13,360	13,440	13,520	13,600	13,680	13,760	13,840	13,920	14,000	14,070	14,150	14,220	14,300	10
11	13,660	13,750	13,840	13,940	14,030	14,120	14,200	14,290	14,380	14,470	14,550	14,640	14,720	14,810	14,890	14,980	15,060	15,140	15,220	15,300	15,380	11
12	15,230	15,330	15,430	15,540	15,640	15,740	15,840	15,940	16,040	16,130	16,230	16,330	16,420	16,520	16,610	16,700	16,800	16,890	16,980	17,070	17,160	12
13	16,200	16,310	16,420	16,520	16,630	16,740	16,840	16,950	17,050	17,160	17,260	17,360	17,460	17,560	17,660	17,760	17,860	17,950	18,050	18,150	18,240	13
14	17,770	17,890	18,010	18,130	18,240	18,360	18,480	18,590	18,710	18,820	18,930	19,050	19,160	19,270	19,380	19,490	19,600	19,700	19,810	19,910	20,020	14
15	18,740	18,860	18,990	19,110	19,240	19,360	19,480	19,600	19,730	19,840	19,960	20,080	20,200	20,310	20,430	20,540	20,660	20,770	20,880	20,990	21,100	15
16	20,300	20,440	20,580	20,720	20,850	20,980	21,120	21,250	21,380	21,510	21,640	21,770	21,890	22,020	22,150	22,270	22,390	22,520	22,640	22,760	22,880	16
17	21,270	21,420	21,560	21,700	21,840	21,980	22,120	22,260	22,400	22,530	22,670	22,800	22,930	23,070	23,200	23,330	23,460	23,580	23,710	23,840	23,960	17
18	22,840	23,000	23,150	23,300	23,460	23,610	23,760	23,910	24,050	24,200	24,340	24,490	24,630	24,770	24,910	25,050	25,190	25,330	25,470	25,600	25,740	18
19	23,810	23,970	24,130	24,290	24,450	24,610	24,760	24,920	25,070	25,220	25,370	25,520	25,670	25,820	25,970	26,110	26,260	26,400	26,540	26,680	26,820	19
20	25,380	25,550	25,720	25,890	26,060	26,230	26,400	26,560	26,730	26,890	27,050	27,210	27,370	27,530	27,680	27,840	27,990	28,150	28,300	28,450	28,600	20
21	26,760	26,940	27,130	27,310	27,490	27,670	27,850	28,020	28,200	28,370	28,550	28,720	28,890	29,060	29,220	29,390	29,560	29,720	29,880	30,050	30,210	21
22	28,140	28,330	28,530	28,720	28,920	29,110	29,300	29,490	29,670	29,860	30,040	30,230	30,410	30,590	30,770	30,940	31,120	31,290	31,470	31,640	31,810	22
23	29,510	29,720	29,930	30,140	30,340	30,540	30,750	30,950	31,150	31,340	31,540	31,740	31,930	32,120	32,310	32,500	32,680	32,870	33,050	33,240	33,420	23
24	30,890	31,110	31,330	31,550	31,770	31,980	32,200	32,410	32,620	32,830	33,040	33,240	33,440	33,650	33,850	34,050	34,250	34,440	34,640	34,830	35,020	24
25	32,270	32,500	32,730	32,960	33,190	33,420	33,650	33,870	34,090	34,310	34,530	34,750	34,960	35,180	35,390	35,600	35,810	36,020	36,220	36,430	36,630	25
26	33,650	33,890	34,140	34,380	34,620	34,860	35,100	35,330	35,570	35,800	36,030	36,260	36,490	36,710	36,930	37,150	37,370	37,590	37,810	38,030	38,240	26
27	35,030	35,280	35,540	35,790	36,050	36,300	36,550	36,790	37,040	37,280	37,520	37,760	38,000	38,240	38,470	38,710	38,940	39,170	39,390	39,620	39,850	27
28	36,410	36,670	36,940	37,210	37,470	37,730	38,000	38,260	38,510	38,770	39,020	39,270	39,520	39,770	40,010	40,260	40,500	40,740	40,980	41,220	41,450	28
29	37,790	38,070	38,340	38,620	38,900	39,170	39,450	39,720	39,990	40,250	40,520	40,780	41,040	41,300	41,560	41,810	42,060	42,320	42,560	42,810	43,060	29
30	38,760	39,040	39,320	39,610	39,890	40,170	40,450	40,730	41,000	41,280	41,550	41,810	42,080	42,340	42,610	42,870	43,130	43,380	43,640	43,890	44,140	30
31	40,320	40,620	40,910	41,210	41,500	41,800	42,090	42,370	42,660	42,940	43,220	43,500	43,780	44,050	44,320	44,590	44,860	45,130	45,390	45,660	45,920	31
32	41,700	42,010	42,320	42,620	42,930	43,230	43,540	43,830	44,130	44,430	44,720	45,010	45,300	45,580	45,870	46,150	46,430	46,700	46,980	47,250	47,530	32
33	42,670	42,990	43,300	43,610	43,920	44,230	44,540	44,850	45,150	45,450	45,750	46,040	46,340	46,630	46,920	47,200	47,490	47,770	48,050	48,330	48,610	33
34	44,240	44,570	44,890	45,210	45,540	45,860	46,180	46,490	46,800	47,110	47,420	47,730	48,030	48,330	48,630	48,930	49,230	49,520	49,810	50,100	50,390	34
35	45,620	45,960	46,290	46,630	46,960	47,300	47,630	47,950	48,280	48,600	48,920	49,240	49,550	49,860	50,180	50,480	50,790	51,090	51,390	51,690	51,990	35
36	46,590	46,930	47,270	47,620	47,960	48,300	48,630	48,960	49,290	49,620	49,950	50,270	50,590	50,910	51,230	51,540	51,850	52,160	52,470	52,770	53,080	36
37	48,160	48,510	48,860	49,220	49,570	49,920	50,260	50,610	50,950	51,290	51,620	51,960	52,290	52,620	52,940	53,270	53,590	53,910	54,220	54,540	54,850	37
38	49,540	49,900	50,260	50,630	50,990	51,360	51,710	52,070	52,420	52,770	53,120	53,470	53,810	54,150	54,480	54,820	55,150	55,480	55,810	56,140	56,460	38
39	52,070	52,460	52,840	53,220	53,600	53,980	54,350	54,730	55,100	55,460	55,830	56,190	56,540	56,900	57,250	57,600	57,950	58,300	58,640	58,980	59,320	39
40	54,610	55,010	55,410	55,810	56,210	56,600	56,990	57,380	57,770	58,150	58,530	58,910	59,280	59,650	60,020	60,390	60,750	61,110	61,470	61,830	62,180	40
41	55,990	56,400	56,810	57,220	57,630	58,040	58,440	58,840	59,240	59,640	60,030	60,420	60,800	61,180	61,560	61,940	62,310	62,690	63,050	63,420	63,790	41
42	58,520	58,960	59,390	59,830	60,260	60,690	61,120	61,550	61,980	62,400	62,820	63,240	63,650	64,070	64,480	64,880	65,280	65,680	66,080	66,480	66,870	42
43	61,050	61,520	61,980	62,440	62,890	63,350	63,800	64,250	64,710	65,160	65,620	66,060	66,510	66,950	67,390	67,820	68,260	68,680	69,110	69,530	69,950	43
44	63,590	64,080	64,560	65,040	65,530	66,000	66,470	66,950	67,440	67,930	68,410	68,890	69,360	69,830	70,300	70,760	71,230	71,680	72,140	72,590	73,040	44
45	66,120	66,630	67,140	67,650	68,160	68,660	69,150	69,660	70,180	70,690	71,200	71,710	72,220	72,720	73,210	73,710	74,200	74,680	75,170	75,650	76,120	45
46	68,650	69,190	69,720	70,260	70,790	71,310	71,830	72,360	72,910	73,460	74,000	74,540	75,070	75,600	76,120	76,650	77,170	77,680	78,190	78,700	79,210	46
47	71,180	71,750	72,310	72,860	73,420	73,960	74,500	75,060	75,640	76,220	76,790	77,360	77,920	78,480	79,040	79,590	80,140	80,680	81,220	81,760	82,290	47
48	73,710	74,310	74,890	75,470	76,050	76,620	77,180	77,770	78,380	78,980	79,590	80,180	80,780	81,360	81,950	82,530	83,110	83,680	84,250	84,820	85,380	48
49	76,250	76,860	77,470	78,080	78,680	79,270	79,860	80,470	81,110	81,750	82,380											



# GUNTERSVILLE DAM SPILLWAY DISCHARGE IN CUBIC FEET PER SECOND

## HEADWATER ELEVATION

GAULS- RIVER FEET	590.0	590.2	590.4	590.6	590.8	591.0	591.2	591.4	591.6	591.8	592.0	592.2	592.4	592.6	592.8	593.0	593.2	593.4	593.6	593.8	594.0	GAULS- RIVER FEET
56	95, 580	96, 380	97, 160	97, 940	98, 710	99, 480	100, 200	101, 000	101, 900	102, 700	103, 500	104, 400	105, 200	106, 000	106, 800	107, 600	108, 400	109, 200	110, 000	110, 800	111, 600	56
57	98, 110	98, 940	99, 750	100, 600	101, 300	102, 100	102, 900	103, 700	104, 600	105, 500	106, 300	107, 200	108, 000	108, 900	109, 700	110, 600	111, 400	112, 200	113, 000	113, 800	114, 700	57
58	99, 750	100, 700	101, 600	102, 500	103, 400	104, 300	105, 200	106, 200	107, 200	108, 200	109, 100	110, 100	111, 100	112, 100	113, 000	114, 000	114, 900	115, 900	116, 800	117, 700	118, 700	58
59	101, 400	102, 400	103, 500	104, 500	105, 500	106, 600	107, 600	108, 600	109, 700	110, 800	111, 900	113, 000	114, 100	115, 200	116, 300	117, 400	118, 400	119, 500	120, 600	121, 700	122, 700	59
60	103, 000	104, 200	105, 300	106, 500	107, 600	108, 800	109, 900	111, 100	112, 300	113, 500	114, 700	116, 000	117, 200	118, 400	119, 600	120, 800	122, 000	123, 200	124, 400	125, 600	126, 700	60
61	104, 700	105, 900	107, 200	108, 500	109, 700	111, 000	112, 200	113, 500	114, 900	116, 200	117, 500	118, 900	120, 200	121, 500	122, 900	124, 200	125, 500	126, 800	128, 100	129, 500	130, 800	61
62	106, 300	107, 700	109, 000	110, 400	111, 800	113, 200	114, 600	116, 000	117, 400	118, 900	120, 300	121, 800	123, 300	124, 700	126, 200	127, 600	129, 000	130, 500	131, 900	133, 400	134, 800	62
63	107, 900	109, 400	110, 900	112, 400	113, 900	115, 400	116, 900	118, 400	120, 000	121, 600	123, 100	124, 700	126, 300	127, 900	129, 400	131, 000	132, 600	134, 100	135, 700	137, 300	138, 800	63
64	109, 600	111, 200	112, 800	114, 400	116, 000	117, 600	119, 200	120, 900	122, 600	124, 200	125, 900	127, 600	129, 300	131, 000	132, 700	134, 400	136, 100	137, 800	139, 500	141, 200	142, 900	64
65	111, 200	112, 900	114, 600	116, 400	118, 100	119, 800	121, 600	123, 300	125, 100	126, 900	128, 700	130, 600	132, 400	134, 200	136, 000	137, 800	139, 600	141, 400	143, 300	145, 100	146, 900	65
66	115, 100	116, 900	118, 600	120, 400	122, 100	123, 900	125, 600	127, 400	129, 300	131, 100	132, 900	134, 800	136, 600	138, 500	140, 300	142, 200	144, 000	145, 800	147, 700	149, 500	151, 400	66
67	117, 600	119, 400	121, 200	123, 000	124, 700	126, 500	128, 300	130, 100	132, 000	133, 900	135, 700	137, 600	139, 500	141, 400	143, 200	145, 100	147, 000	148, 800	150, 700	152, 600	154, 400	67
68	119, 300	121, 200	123, 000	124, 900	126, 800	128, 700	130, 700	132, 600	134, 600	136, 500	138, 500	140, 500	142, 500	144, 500	146, 500	148, 500	150, 500	152, 500	154, 500	156, 500	158, 500	68
69	120, 900	122, 900	124, 900	126, 900	128, 900	131, 000	133, 000	135, 000	137, 100	139, 200	141, 300	143, 400	145, 500	147, 700	149, 800	151, 900	154, 000	156, 100	158, 200	160, 400	162, 500	69
70	122, 600	124, 700	126, 800	128, 900	131, 000	133, 200	135, 300	137, 500	139, 700	141, 900	144, 100	146, 400	148, 600	150, 900	153, 100	155, 300	157, 500	159, 800	162, 000	164, 300	166, 500	70
71	124, 200	126, 400	128, 600	130, 900	133, 100	135, 400	137, 600	139, 900	142, 300	144, 600	146, 900	149, 300	151, 700	154, 000	156, 400	158, 700	161, 100	163, 400	165, 800	168, 200	170, 600	71
72	125, 800	128, 100	130, 500	132, 800	135, 200	137, 600	140, 000	142, 400	144, 800	147, 300	149, 700	152, 200	154, 700	157, 200	159, 700	162, 100	164, 600	167, 100	169, 600	172, 100	174, 600	72
73	130, 000	132, 500	134, 900	137, 400	139, 900	142, 500	145, 000	147, 500	150, 100	152, 700	155, 300	158, 000	160, 600	163, 200	165, 900	168, 500	171, 100	173, 700	176, 400	179, 000	181, 700	73
74	134, 200	136, 800	139, 400	142, 000	144, 700	147, 300	150, 000	152, 700	155, 400	158, 200	160, 900	163, 700	166, 500	169, 300	172, 100	174, 800	177, 600	180, 400	183, 200	186, 000	188, 800	74
75	135, 800	138, 500	141, 200	144, 000	146, 700	149, 500	152, 300	155, 100	158, 000	160, 800	163, 700	166, 600	169, 500	172, 400	175, 300	178, 200	181, 100	184, 000	187, 000	189, 900	192, 900	75
76	138, 500	141, 000	143, 500	146, 000	148, 500	151, 100	153, 600	156, 200	158, 800	161, 400	164, 000	166, 700	169, 300	172, 000	174, 600	177, 200	179, 800	182, 500	185, 200	187, 900	190, 600	76
77	144, 900	147, 500	150, 000	152, 600	155, 200	157, 800	160, 400	163, 000	165, 700	168, 300	171, 000	173, 700	176, 400	179, 100	181, 900	184, 600	187, 300	190, 000	192, 700	195, 500	198, 200	77
78	146, 500	149, 200	151, 900	154, 600	157, 300	160, 000	162, 700	165, 500	168, 200	171, 000	173, 800	176, 700	179, 500	182, 300	185, 200	188, 000	190, 800	193, 700	196, 500	199, 400	202, 300	78
79	153, 000	155, 700	158, 400	161, 200	163, 900	166, 700	169, 500	172, 300	175, 100	178, 000	180, 800	183, 700	186, 600	189, 500	192, 400	195, 300	198, 200	201, 100	204, 000	206, 900	209, 800	79
80	154, 600	157, 500	160, 300	163, 100	166, 000	168, 900	171, 800	174, 700	177, 700	180, 700	183, 600	186, 600	189, 600	192, 700	195, 700	198, 700	201, 700	204, 700	207, 700	210, 800	213, 900	80
81	157, 300	159, 900	162, 500	165, 100	167, 800	170, 400	173, 100	175, 800	178, 500	181, 200	184, 000	186, 800	189, 600	192, 400	195, 200	198, 000	200, 800	203, 600	206, 500	209, 400	212, 300	81
82	163, 800	166, 400	169, 100	171, 700	174, 400	177, 100	179, 900	182, 600	185, 400	188, 200	191, 000	193, 800	196, 600	199, 400	202, 200	205, 000	207, 800	210, 700	213, 500	216, 400	219, 200	82
83	165, 400	168, 200	170, 900	173, 700	176, 500	179, 400	182, 200	185, 100	187, 900	190, 800	193, 700	196, 700	199, 600	202, 600	205, 500	208, 400	211, 400	214, 300	217, 300	220, 300	223, 300	83
84	173, 500	176, 400	179, 300	182, 300	185, 300	188, 300	191, 300	194, 300	197, 400	200, 500	203, 500	206, 600	209, 800	212, 900	216, 000	219, 100	222, 200	225, 300	228, 500	231, 700	234, 800	84
85	176, 100	178, 800	181, 600	184, 300	187, 000	189, 800	192, 600	195, 400	198, 200	201, 000	203, 900	206, 800	209, 700	212, 600	215, 500	218, 400	222, 200	225, 100	228, 000	231, 000	234, 000	85
86	184, 200	187, 100	190, 000	192, 900	195, 800	198, 700	201, 700	204, 700	207, 600	210, 600	213, 700	216, 700	219, 700	222, 800	225, 800	228, 900	231, 900	235, 000	238, 100	241, 200	244, 300	86
87	192, 300	195, 300	198, 400	201, 500	204, 600	207, 700	210, 800	213, 900	217, 100	220, 300	223, 500	226, 700	229, 900	233, 100	236, 400	239, 600	242, 800	246, 000	249, 300	252, 600	255, 800	87
88	195, 000	197, 800	200, 600	203, 500	206, 300	209, 200	212, 100	215, 000	217, 900	220, 800	223, 700	226, 600	229, 500	233, 400	236, 300	239, 200	242, 100	245, 000	248, 000	251, 000	254, 000	88
89	203, 100	206, 000	209, 000	212, 100	215, 100	218, 100	221, 200	224, 200	227, 300	230, 400	233, 500	236, 600	239, 700	243, 800	246, 900	249, 000	252, 100	255, 200	258, 300	262, 400	265, 500	89
90	211, 200	214, 300	217, 500	220, 600	223, 800	227, 000	230, 300	233, 500	236, 800	240, 100	243, 400	246, 700	250, 000	253, 400	256, 700	260, 000	263, 300	266, 700	270, 100	273, 400	276, 800	90
92	221, 900	225, 000	228, 100	231, 200	234, 300	237, 500	240, 700	243, 800	247, 000	250, 200	253, 500	256, 700	260, 000	263, 300	266, 500	269, 800	273, 000	276, 300	279, 600	282, 900	286, 200	92
93	230, 000	233, 200	236, 500	239, 800	243, 100	246, 400	249, 800	253, 100	256, 500	259, 900	263, 300	266, 700	270, 100	273, 600	277, 000	280, 500	283, 900	287, 400	290, 800	294, 300	297, 800	93
95	243, 300	246, 400	249, 600	252, 800	256, 100	259, 300	262, 600	265, 800	269, 100	272, 400	275, 700	279, 100	282, 400	285, 800	289, 100	292, 500	295, 800	299, 200	302, 600	306, 000	309, 400	95
96	251, 300	254, 700	258, 100	261, 400	264, 800	268, 200	271, 700	275, 100	278, 600	282, 000	285, 500	289, 100	292, 600	296, 100	299, 600	303, 200	306, 700	310, 200	313, 800	317, 400	321, 000	96
98	264, 600	267, 900	271, 200	274, 500	277, 800	281, 100	284, 500	287, 800	291, 200	294, 600	298, 000	301, 400	304, 900	308, 300	311, 800	315, 200	318, 600	322, 100	325, 600	329, 000	332, 500	98
99	272, 700	276, 100	279, 600	283, 100	286, 600	290, 100	293, 600	297, 100	300, 700	304, 200	307, 800	311, 400	315, 000</									

# GUNTERSVILLE DAM SPILLWAY DISCHARGE IN CUBIC FEET PER SECOND

GATE ARRANGEMENT	HEADWATER ELEVATION																		TAILWATER ELEVATION			
	594.0	594.2	594.4	594.6	594.8	595.0	595.2	595.4	595.6	595.8	596.0	596.2	596.4	596.6	596.8	597.0	597.2	597.4	597.6	597.8	598.0	
0*	0	0	0	0	0	0	0	0	160	530	1,030	1,640	2,320	3,080	3,910	4,810	5,760	6,770	7,840	8,950	10,110	0*
1	1,080	1,090	1,090	1,100	1,100	1,110	1,110	1,120	1,270	1,630	2,110	2,680	3,340	4,070	4,880	5,760	6,700	7,690	8,740	9,850	11,000	1
2	2,860	2,870	2,890	2,900	2,920	2,930	2,950	2,960	3,130	3,490	3,980	4,560	5,230	5,960	6,760	7,620	8,530	9,500	10,510	11,580	12,690	2
3	3,940	3,960	3,980	4,000	4,020	4,040	4,060	4,080	4,240	4,590	5,060	5,610	6,240	6,940	7,720	8,560	9,460	10,420	11,420	12,480	13,600	3
4	5,720	5,750	5,780	5,810	5,840	5,870	5,900	5,920	6,090	6,460	6,930	7,490	8,130	8,830	9,600	10,420	11,300	12,220	13,190	14,210	15,270	4
5	6,800	6,840	6,870	6,910	6,940	6,980	7,010	7,040	7,210	7,550	8,010	8,540	9,140	9,820	10,570	11,370	12,230	13,140	14,100	15,110	16,170	5
6	8,580	8,620	8,670	8,710	8,760	8,800	8,840	8,890	9,060	9,420	9,880	10,420	11,030	11,710	12,440	13,230	14,070	14,950	15,870	16,840	17,850	6
7	9,660	9,710	9,760	9,810	9,860	9,910	9,960	10,010	10,180	10,520	10,950	11,470	12,050	12,700	13,410	14,180	15,000	15,870	16,780	17,740	18,750	7
8	11,440	11,500	11,560	11,620	11,680	11,730	11,790	11,850	12,030	12,380	12,820	13,350	13,940	14,580	15,290	16,040	16,830	17,670	18,550	19,470	20,430	8
9	12,520	12,590	12,650	12,720	12,780	12,840	12,910	12,970	13,140	13,480	13,900	14,400	14,950	15,570	16,250	16,980	17,770	18,590	19,460	20,370	21,320	9
10	14,300	14,370	14,450	14,520	14,600	14,670	14,740	14,810	15,000	15,340	15,770	16,280	16,840	17,460	18,130	18,840	19,600	20,400	21,230	22,100	23,010	10
11	15,380	15,460	15,540	15,620	15,700	15,780	15,850	15,930	16,110	16,440	16,850	17,320	17,860	18,450	19,090	19,790	20,530	21,320	22,140	23,000	23,900	11
12	17,160	17,250	17,340	17,430	17,510	17,600	17,690	17,770	17,970	18,300	18,720	19,200	19,740	20,340	20,970	21,650	22,370	23,120	23,910	24,730	25,590	12
13	18,240	18,340	18,430	18,530	18,620	18,710	18,800	18,890	19,080	19,400	19,800	20,260	20,760	21,280	21,840	22,450	23,100	23,790	24,520	25,280	26,080	13
14	20,020	20,120	20,230	20,330	20,430	20,540	20,640	20,740	20,930	21,260	21,670	22,130	22,650	23,210	23,810	24,460	25,130	25,850	26,590	27,360	28,170	14
15	21,100	21,210	21,320	21,430	21,540	21,640	21,750	21,860	22,050	22,360	22,710	23,100	23,520	24,000	24,520	25,090	25,700	26,350	27,040	27,770	28,540	15
16	22,880	23,000	23,120	23,240	23,350	23,470	23,580	23,700	23,900	24,220	24,610	25,060	25,550	26,090	26,660	27,260	27,900	28,570	29,270	29,990	30,740	16
17	23,960	24,090	24,210	24,330	24,450	24,580	24,700	24,820	25,020	25,320	25,670	26,060	26,490	26,960	27,470	28,010	28,590	29,200	29,840	30,510	31,220	17
18	25,740	25,870	26,010	26,140	26,270	26,400	26,530	26,660	26,870	27,180	27,560	27,990	28,460	28,960	29,500	30,070	30,670	31,300	31,950	32,620	33,320	18
19	26,820	26,960	27,100	27,240	27,380	27,510	27,650	27,780	28,080	28,420	28,800	29,220	29,680	30,180	30,710	31,270	31,860	32,480	33,130	33,810	34,520	19
20	28,600	28,750	28,900	29,040	29,190	29,340	29,480	29,620	29,840	30,140	30,510	30,920	31,360	31,840	32,340	32,880	33,440	34,020	34,630	35,250	35,900	20
21	30,210	30,370	30,520	30,680	30,840	30,990	31,150	31,300	31,530	31,840	32,220	32,630	33,090	33,580	34,090	34,640	35,200	35,800	36,410	37,050	37,710	21
22	31,810	31,980	32,150	32,320	32,490	32,650	32,820	32,980	33,220	33,540	33,930	34,350	34,800	35,310	35,840	36,390	36,970	37,580	38,200	38,850	39,520	22
23	33,420	33,600	33,780	33,960	34,140	34,310	34,490	34,660	34,900	35,240	35,640	36,070	36,520	37,050	37,590	38,150	38,740	39,350	39,990	40,650	41,320	23
24	35,030	35,220	35,410	35,600	35,780	35,970	36,160	36,340	36,590	36,940	37,350	37,790	38,280	38,790	39,340	39,910	40,510	41,130	41,780	42,440	43,130	24
25	36,630	36,830	37,040	37,240	37,430	37,630	37,830	38,020	38,280	38,640	39,060	39,510	40,010	40,530	41,090	41,670	42,270	42,910	43,560	44,240	44,940	25
26	38,240	38,450	38,660	38,870	39,080	39,290	39,490	39,700	39,970	40,340	40,770	41,230	41,740	42,270	42,840	43,430	44,050	44,690	45,350	46,040	46,740	26
27	39,850	40,070	40,290	40,510	40,730	40,950	41,160	41,380	41,660	42,040	42,470	42,950	43,460	44,010	44,590	45,190	45,810	46,470	47,140	47,830	48,550	27
28	41,450	41,690	41,920	42,150	42,380	42,610	42,830	43,060	43,350	43,740	44,180	44,670	45,190	45,750	46,330	46,950	47,580	48,240	48,930	49,630	50,350	28
29	43,060	43,300	43,550	43,790	44,030	44,270	44,500	44,740	45,040	45,440	45,890	46,390	46,920	47,490	48,080	48,700	49,350	50,020	50,710	51,430	52,160	29
30	44,140	44,390	44,640	44,890	45,130	45,370	45,620	45,860	46,160	46,540	46,970	47,420	47,910	48,400	48,920	49,470	50,050	50,650	51,270	51,910	52,570	30
31	45,920	46,180	46,440	46,690	46,950	47,200	47,450	47,700	48,010	48,400	48,840	49,320	49,830	50,360	50,930	51,510	52,120	52,750	53,390	54,060	54,740	31
32	47,530	47,800	48,060	48,330	48,600	48,860	49,120	49,380	49,700	50,100	50,550	51,040	51,560	52,100	52,670	53,270	53,890	54,520	55,180	55,850	56,550	32
33	48,610	48,880	49,160	49,430	49,700	49,970	50,230	50,500	50,810	51,200	51,630	52,110	52,630	53,190	53,790	54,420	55,070	55,740	56,430	57,150	57,890	33
34	50,390	50,670	50,950	51,230	51,510	51,790	52,070	52,340	52,760	53,060	53,500	53,970	54,460	54,980	55,520	56,080	56,650	57,250	57,860	58,490	59,130	34
35	51,990	52,280	52,580	52,870	53,160	53,450	53,740	54,020	54,360	54,760	55,210	55,690	56,190	56,720	57,270	57,840	58,420	59,030	59,650	60,280	60,930	35
36	53,080	53,380	53,670	53,970	54,270	54,560	54,850	55,140	55,470	55,860	56,310	56,790	57,300	57,820	58,360	58,920	59,500	60,100	60,720	61,360	62,010	36
37	54,850	55,160	55,470	55,780	56,080	56,380	56,680	56,980	57,320	57,720	58,150	58,610	59,090	59,590	60,110	60,640	61,190	61,750	62,330	62,910	63,510	37
38	56,460	56,780	57,100	57,420	57,730	58,040	58,350	58,660	59,010	59,420	59,860	60,330	60,820	61,330	61,860	62,400	62,960	63,530	64,110	64,710	65,320	38
39	59,320	59,650	59,990	60,320	60,650	60,980	61,300	61,620	61,980	62,380	62,810	63,260	63,730	64,210	64,700	65,210	65,730	66,250	66,790	67,340	67,900	39
40	62,180	62,530	62,880	63,220	63,570	63,910	64,250	64,590	64,950	65,340	65,760	66,190	66,630	67,080	67,540	68,010	68,490	68,980	69,470	69,970	70,480	40
41	63,790	64,150	64,510	64,860	65,220	65,570	65,920	66,270	66,640	67,040	67,470	67,910	68,360	68,820	69,290	69,770	70,260	70,760	71,260	71,770	72,280	41
42	66,870	67,260	67,650	68,030	68,410	68,790	69,170	69,550	69,950	70,380	70,830	71,300	71,770	72,260	72,760	73,270	73,780	74,300	74,830	75,370	75,910	42
43	69,950	70,370	70,790	71,200	71,610	72,020	72,420	72,830	73,250	73,710	74,190	74,680	75,190	75,700	76,230	76,760	77,300	77,850	78,410	78,970	79,540	43
44	73,040	73,490	73,930	74,370	74,810	75,240	75,680	76,110	76,560	77,050	77,550	78,070	78,600	79,150	79,700	80,260	80,830	81,400	81,980	82,570	83,160	44
45	76,120	76,600	77,070	77,540	78,000	78,470	78,930	79,380	79,870	80,380	80,910	81,460	82,020	82,590	83,170	83,750	84,350	84,950	85,560	86,170	86,790	45
46	79,210	79,710	80,210	80,710	81,200	81,690	82,180	82,660	83,170	83,710	84,270	84,850	85,430	86,030	86,630	87,250	87,870	88,500	89,130	89,770	90,410	46
47	82,290	82,820	83,350	83,880	84,400	84,920	85,440	85,940	86,480	87,050	87,640	88,240	88,850	89,470	90,100	90,740	91,390	92,040	92,700	93,370	94,040	47
48	85,380	85,940	86,490	87,050	87,590	88,140	88															

# GUNTERSVILLE DAM SPILLWAY DISCHARGE IN CUBIC FEET PER SECOND

DISCHARGE - FEET	HEADWATER ELEVATION																			DISCHARGE - FEET		
	594.0	594.2	594.4	594.6	594.8	595.0	595.2	595.4	595.6	595.8	596.0	596.2	596.4	596.6	596.8	597.0	597.2	597.4	597.6		597.8	598.0
55	108,400	109,100	109,900	110,600	111,300	112,100	112,800	113,500	114,300	115,000	115,800	116,600	117,400	118,200	119,000	119,800	120,600	121,400	122,200	123,000	123,800	55
56	111,600	112,300	113,100	113,900	114,600	115,400	116,200	116,900	117,700	118,400	119,200	120,000	120,800	121,600	122,400	123,200	124,000	124,800	125,600	126,400	127,200	56
57	114,700	115,500	116,300	117,100	117,800	118,600	119,400	120,200	121,000	121,800	122,600	123,400	124,200	125,000	125,800	126,600	127,400	128,200	129,000	129,800	130,600	57
58	118,700	119,600	120,500	121,500	122,400	123,300	124,200	125,100	126,000	126,900	127,800	128,700	129,600	130,500	131,400	132,300	133,200	134,100	135,000	135,900	136,800	58
59	122,700	123,800	124,800	125,900	126,900	128,000	129,000	130,100	131,100	132,200	133,300	134,400	135,500	136,600	137,700	138,800	140,000	141,200	142,400	143,600	144,800	59
60	126,700	127,900	129,100	130,300	131,500	132,700	133,900	135,000	136,200	137,500	138,700	139,900	141,200	142,500	143,700	145,000	146,300	147,600	148,900	150,100	151,400	60
61	130,800	132,100	133,400	134,700	136,000	137,400	138,700	140,000	141,300	142,700	144,100	145,400	146,800	148,200	149,600	151,000	152,500	153,900	155,400	156,800	158,200	61
62	134,800	136,300	137,700	139,100	140,600	142,000	143,500	144,900	146,400	147,900	149,400	150,900	152,500	154,000	155,600	157,100	158,700	160,300	161,900	163,500	165,000	62
63	138,800	140,400	142,000	143,600	145,100	146,700	148,300	149,900	151,500	153,100	154,800	156,400	158,100	159,800	161,500	163,200	164,900	166,600	168,400	170,100	171,800	63
64	142,900	144,600	146,300	148,000	149,700	151,400	153,100	154,900	156,600	158,400	160,200	162,000	163,800	165,600	167,400	169,300	171,100	173,000	174,900	176,800	178,600	64
65	146,900	148,700	150,600	152,400	154,200	156,100	157,900	159,800	161,700	163,600	165,500	167,500	169,400	171,400	173,400	175,400	177,400	179,400	181,400	183,400	185,400	65
66	151,400	153,200	155,100	156,900	158,800	160,700	162,600	164,500	166,400	168,300	170,200	172,100	174,000	176,000	177,900	179,900	181,900	183,900	185,800	187,800	189,800	66
67	154,400	156,300	158,200	160,100	162,000	163,900	165,800	167,700	169,700	171,600	173,500	175,500	177,500	179,400	181,400	183,400	185,400	187,400	189,400	191,400	193,500	67
68	158,500	160,500	162,500	164,500	166,600	168,600	170,600	172,700	174,700	176,800	178,900	181,000	183,100	185,200	187,300	189,500	191,600	193,800	195,900	198,100	200,300	68
69	162,500	164,700	166,800	169,000	171,100	173,300	175,500	177,600	179,800	182,000	184,300	186,500	188,700	191,000	193,300	195,500	197,800	200,100	202,400	204,700	207,100	69
70	166,500	168,800	171,100	173,400	175,700	178,000	180,300	182,600	184,900	187,300	189,600	192,000	194,400	196,800	199,200	201,600	204,000	206,500	208,900	211,400	213,900	70
71	170,600	173,000	175,400	177,800	180,200	182,600	185,100	187,500	190,000	192,500	195,000	197,500	200,000	202,600	205,100	207,700	210,300	212,800	215,400	218,000	220,700	71
72	174,600	177,100	179,700	182,200	184,800	187,300	189,900	192,500	195,100	197,700	200,400	203,000	205,700	208,400	211,000	213,800	216,500	219,200	221,900	224,700	227,500	72
73	181,700	184,400	187,100	189,800	192,500	195,200	198,000	200,700	203,500	206,300	209,100	211,900	214,700	217,600	220,400	223,300	226,200	229,100	232,000	234,900	237,900	73
74	188,800	191,700	194,700	197,700	200,700	203,700	206,700	209,800	211,900	214,800	217,800	220,800	223,800	226,800	229,800	232,900	235,900	239,000	242,100	245,200	248,300	74
75	192,900	195,800	198,800	201,800	204,800	207,800	210,900	213,900	217,000	220,100	223,200	226,300	229,400	232,600	235,800	239,000	242,200	245,400	248,600	251,900	255,100	75
77	198,200	201,000	203,800	206,600	209,400	212,200	215,000	217,800	220,700	223,600	226,500	229,500	232,400	235,400	238,400	241,400	244,400	247,500	250,500	253,600	256,700	77
78	202,300	205,200	208,100	211,000	213,900	216,900	219,800	222,800	225,800	228,800	231,900	235,000	238,100	241,200	244,300	247,500	250,600	253,800	257,000	260,300	263,500	78
79	209,800	212,800	215,700	218,700	221,700	224,700	227,700	230,700	233,800	236,800	239,900	243,000	246,100	249,200	252,400	255,500	258,700	261,900	265,100	268,300	271,500	79
80	213,900	216,900	220,000	223,100	226,200	229,400	232,500	235,700	238,900	242,000	245,300	248,500	251,700	255,000	258,300	261,600	264,900	268,200	271,600	274,900	278,300	80
82	219,200	222,100	225,000	227,900	230,800	233,700	236,700	239,600	242,600	245,600	248,600	251,700	254,700	257,800	260,900	264,000	267,200	270,300	273,500	276,700	279,900	82
83	223,300	226,300	229,300	232,300	235,400	238,400	241,500	244,600	247,700	250,800	254,000	257,200	260,400	263,600	266,800	270,100	273,400	276,700	280,000	283,400	286,700	83
84	234,800	238,000	241,200	244,400	247,700	251,000	254,300	257,600	261,000	264,400	267,800	271,300	274,800	278,300	281,800	285,400	289,000	292,600	296,200	299,900	303,500	84
86	244,300	247,400	250,500	253,600	256,800	260,000	263,100	266,300	269,500	272,800	276,100	279,400	282,700	286,000	289,400	292,800	296,200	299,600	303,000	306,500	309,900	86
87	255,800	259,100	262,400	265,800	269,100	272,500	275,800	279,200	282,600	286,000	289,400	292,900	296,400	299,900	303,400	306,900	310,400	314,000	317,600	321,100	324,700	87
89	265,200	268,500	271,700	275,000	278,200	281,500	284,800	288,100	291,400	294,800	298,200	301,600	305,000	308,400	311,900	315,400	318,900	322,400	326,000	329,600	333,100	89
90	276,800	280,200	283,700	287,100	290,500	294,000	297,500	301,000	304,500	308,000	311,500	315,100	318,700	322,300	325,900	329,500	333,200	336,900	340,500	344,200	347,900	90
92	286,200	289,600	293,000	296,300	299,600	303,000	306,400	309,800	313,300	316,700	320,200	323,800	327,300	330,900	334,500	338,100	341,700	345,300	349,000	352,600	356,300	92
93	297,800	301,300	304,900	308,400	312,000	315,500	319,100	322,700	326,300	330,000	333,600	337,300	341,000	344,700	348,400	352,200	355,900	359,700	363,500	367,300	371,200	93
95	309,400	312,800	316,200	319,700	323,100	326,600	330,100	333,600	337,100	340,700	344,200	347,800	351,500	355,100	358,800	362,400	366,100	369,900	373,600	377,300	381,100	95
96	321,000	324,600	328,200	331,800	335,500	339,100	342,800	346,500	350,200	353,900	357,600	361,400	365,100	368,900	372,700	376,600	380,400	384,300	388,100	392,000	395,900	96
98	332,500	336,000	339,600	343,100	346,600	350,200	353,700	357,300	360,900	364,600	368,200	371,900	375,600	379,300	383,100	386,800	390,600	394,400	398,200			98
99	344,100	347,800	351,500	355,200	358,900	362,700	366,400	370,200	374,000	377,800	381,600	385,400	389,300									99
101	355,700	359,300	362,900	366,500	370,100	373,800	377,400	381,100	384,700	388,500	392,200											101
102	367,300	371,000	374,800	378,600	382,400	386,300	390,100	393,900	397,800													102
104	378,800	382,500	386,200	389,900	393,600	397,300																104
105	390,400	394,300	398,200																			105
106	393,400	397,100																				106

HEADWATER 594 to 598  
TAILWATER 573.51 to 574.50

MARCH 2004

# GUNTERSVILLE DAM SPILLWAY DISCHARGE IN CUBIC FEET PER SECOND

## HEADWATER ELEVATION

ARRANGEMENT	HEADWATER ELEVATION																			TAILWATER ELEVATION			
	598.0	598.2	598.4	598.6	598.8	599.0	599.2	599.4	599.6	599.8	600.0	600.2	600.4	600.6	600.8	601.0	601.2	601.4	601.6	601.8	602.0		
0*	10, 110	11, 320	12, 570	13, 860	15, 200	16, 580	18, 000	19, 450	20, 940	22, 470	24, 030												0*
1	11, 000	12, 200	13, 440	14, 730	16, 050	17, 420	18, 830	20, 280	21, 770	23, 290	24, 850												1
2	12, 690	13, 840	15, 040	16, 280	17, 580	18, 920	20, 310	21, 730	23, 190	24, 700	26, 240												2
4	15, 270	16, 370	17, 510	18, 700	19, 960	21, 260	22, 620	24, 010	25, 450	26, 920	28, 440												4
6	17, 850	18, 890	19, 980	21, 120	22, 340	23, 610	24, 930	26, 290	27, 700	29, 150	30, 640												6
8	20, 430	21, 420	22, 450	23, 540	24, 710	25, 950	27, 240	28, 570	29, 950	31, 370	32, 840												8
10	23, 010	23, 940	24, 910	25, 960	27, 090	28, 290	29, 550	30, 850	32, 200	33, 600	35, 040												10
12	25, 590	26, 470	27, 380	28, 380	29, 470	30, 630	31, 860	33, 130	34, 460	35, 830	37, 240												12
14	28, 170	29, 000	29, 850	30, 800	31, 850	32, 980	34, 170	35, 410	36, 710	38, 050	39, 440												14
16	30, 740	31, 520	32, 320	33, 220	34, 230	35, 320	36, 480	37, 690	38, 960	40, 280	41, 650												16
18	33, 320	34, 050	34, 790	35, 630	36, 610	37, 660	38, 790	39, 970	41, 210	42, 510	43, 850												18
20	35, 900	36, 570	37, 260	38, 050	38, 990	40, 000	41, 100	42, 250	43, 460	44, 730	46, 050												20
21	37, 710	38, 390	39, 080	39, 880	40, 800	41, 800	42, 870	43, 990	45, 170	46, 400	47, 680												21
22	39, 520	40, 200	40, 910	41, 700	42, 610	43, 600	44, 640	45, 740	46, 880	48, 080	49, 310												22
23	41, 320	42, 020	42, 730	43, 530	44, 430	45, 390	46, 410	47, 480	48, 590	49, 750	50, 940												23
24	43, 130	43, 830	44, 560	45, 360	46, 240	47, 190	48, 180	49, 220	50, 300	51, 420	52, 570												24
25	44, 940	45, 650	46, 390	47, 180	48, 060	48, 980	49, 950	50, 960	52, 010	53, 090	54, 200												25
26	46, 740	47, 470	48, 210	49, 010	49, 870	50, 780	51, 720	52, 700	53, 720	54, 760	55, 830												26
27	48, 550	49, 280	50, 040	50, 830	51, 680	52, 570	53, 490	54, 450	55, 430	56, 430	57, 470												27
28	50, 350	51, 100	51, 860	52, 660	53, 500	54, 370	55, 270	56, 190	57, 140	58, 110	59, 100												28
29	52, 160	52, 910	53, 690	54, 480	55, 310	56, 160	57, 040	57, 930	58, 840	59, 780	60, 730												29
31	54, 740	55, 440	56, 150	56, 900	57, 690	58, 510	59, 350	60, 210	61, 100	62, 000	62, 930												31
32	56, 550	57, 260	57, 980	58, 730	59, 500	60, 300	61, 120	61, 950	62, 810	63, 670	64, 560												32
34	59, 130	59, 780	60, 450	61, 150	61, 880	62, 640	63, 430	64, 230	65, 060	65, 900	66, 760												34
35	60, 930	61, 600	62, 270	62, 970	63, 700	64, 440	65, 200	65, 980	66, 770	67, 570	68, 390												35
37	63, 510	64, 120	64, 740	65, 390	66, 070	66, 780	67, 510	68, 260	69, 020	69, 800	70, 590												37
38	65, 320	65, 940	66, 570	67, 220	67, 890	68, 580	69, 280	70, 000	70, 730	71, 470	72, 230												38
39	67, 900	68, 460	69, 040	69, 640	70, 270	70, 920	71, 590	72, 280	72, 980	73, 700	74, 430												39
40	70, 480	70, 990	71, 510	72, 060	72, 650	73, 260	73, 900	74, 560	75, 230	75, 920	76, 630												40
41	72, 280	72, 800	73, 330	73, 880	74, 460	75, 060	75, 670	76, 300	76, 940	77, 590	78, 260												41
42	75, 910	76, 460	77, 010	77, 580	78, 190	78, 810	79, 450	80, 110	80, 770	81, 450	82, 140												42
43	79, 540	80, 110	80, 690	81, 290	81, 920	82, 570	83, 230	83, 910	84, 610	85, 310	86, 020												43
44	83, 160	83, 760	84, 370	84, 990	85, 650	86, 320	87, 020	87, 720	88, 440	89, 170	89, 910												44
45	86, 790	87, 410	88, 040	88, 700	89, 380	90, 080	90, 800	91, 530	92, 270	93, 020	93, 790												45
46	90, 410	91, 070	91, 720	92, 400	93, 110	93, 840	94, 580	95, 330	96, 100	96, 880	97, 670												46
47	94, 040	94, 720	95, 400	96, 110	96, 840	97, 590	98, 360	99, 140	99, 930	100, 700	101, 600												47
48	97, 670	98, 370	99, 080	99, 810	100, 600	101, 300	102, 100	102, 900	103, 800	104, 600	105, 400												48
49	101, 300	102, 000	102, 800	103, 500	104, 300	105, 100	105, 900	106, 800	107, 600	108, 500	109, 300												49
50	105, 700	106, 400	107, 100	107, 800	108, 500	109, 200	110, 000	110, 800	111, 600	112, 400	113, 200												50
51	109, 300	110, 000	110, 700	111, 500	112, 200	113, 000	113, 800	114, 600	115, 400	116, 200	117, 000												51
52	112, 900	113, 700	114, 400	115, 200	116, 000	116, 800	117, 600	118, 400	119, 200	120, 100	120, 900												52
53	116, 600	117, 300	118, 100	118, 900	119, 700	120, 500	121, 300	122, 200	123, 100	123, 900	124, 800												53
54	120, 200	121, 000	121, 800	122, 600	123, 400	124, 300	125, 100	126, 000	126, 900	127, 800	128, 700												54
55	123, 800	124, 600	125, 400	126, 300	127, 100	128, 000	128, 900	129, 800	130, 700	131, 600	132, 600												55
56	127, 400	128, 300	129, 100	129, 900	130, 800	131, 600	132, 500	133, 300	134, 100	135, 000	135, 800												56
57	131, 100	131, 900	132, 800	133, 600	134, 500	135, 400	136, 200	137, 100	138, 000	138, 800	139, 700												57
58	137, 800	138, 900	139, 900	140, 900	141, 900	142, 900	143, 900	145, 000	146, 000	147, 000	148, 100												58
59	144, 600	145, 800	147, 000	148, 100	149, 300	150, 500	151, 700	152, 800	154, 000	155, 200	156, 400												59
60	151, 400	152, 800	154, 100	155, 400	156, 700	158, 000	159, 400	160, 700	162, 100	163, 400	164, 800												60
61	158, 200	159, 700	161, 200	162, 600	164, 100	165, 600	167, 100	168, 600	170, 100	171, 600	173, 100												61
62	165, 000	166, 700	168, 300	169, 900	171, 500	173, 200	174, 800	176, 500	178, 100	179, 800	181, 500												62
63	171, 800	173, 600	175, 400	177, 100	178, 900	180, 700	182, 500	184, 300	186, 200	188, 000	189, 800												63
64	178, 600	180, 600	182, 500	184, 400	186, 300	188, 300	190, 200	192, 200	194, 200	196, 200	198, 200												64
65	185, 400	187, 500	189, 600	191, 600	193, 700	195, 800	198, 000	200, 100	202, 200	204, 400	206, 500												65
66	189, 800	191, 800	193, 900	195, 900	197, 900	200, 000	202, 000	204, 100	206, 200	208, 300	210, 400												66

MARCH 2004

\* Arrangement "0" indicates that all spillway gates are closed.  
Discharge is spillway gate and trash gate overflow.

HEADWATER 598 to 602  
TAILWATER 573.51 to 574.50

# GUNTERSVILLE DAM SPILLWAY DISCHARGE IN CUBIC FEET PER SECOND

GATE RANGE MENT	HEADWATER ELEVATION																			GATE RANGE MENT		
	598.0	598.2	598.4	598.6	598.8	599.0	599.2	599.4	599.6	599.8	600.0	600.2	600.4	600.6	600.8	601.0	601.2	601.4	601.6		601.8	602.0
67	193,500	195,500	197,500	199,600	201,600	203,700	205,800	207,900	210,000	212,100	214,300											67
68	200,300	202,400	204,600	206,800	209,000	211,300	213,500	215,800	218,100	220,300	222,600											68
69	207,100	209,400	211,700	214,100	216,400	218,800	221,200	223,700	226,100	228,500	231,000											69
70	213,900	216,300	218,800	221,300	223,800	226,400	229,000	231,500	234,100	236,700	239,300											70
71	220,700	223,300	225,900	228,600	231,200	234,000	236,700	239,400	242,200	244,900	247,700											71
72	227,500	230,200	233,000	235,800	238,700	241,500	244,400	247,300	250,200	253,100	256,000											72
73	237,900	240,800	243,800	246,800	249,800	252,800	255,900	259,000	262,000	265,100	268,300											73
74	248,300	251,400	254,600	257,700	260,900	264,100	267,400	270,600	273,900	277,200	280,500											74
75	255,100	258,400	261,700	265,000	268,300	271,700	275,100	278,500	281,900	285,400	288,800											75
77	256,700	259,800	262,900	266,100	269,300	272,500	275,700	278,900	282,200	285,500	288,800											77
78	263,500	266,800	270,000	273,300	276,700	280,000	283,400	286,800	290,200	293,700	297,100											78
79	271,500	274,800	278,000	281,300	284,600	287,900	291,300	294,600	298,000	301,400	304,800											79
80	278,300	281,700	285,100	288,500	292,000	295,500	299,000	302,500	306,100	309,600	313,200											80
82	279,900	283,100	286,400	289,600	292,900	296,200	299,600	302,900	306,300	309,700												82
83	286,700	290,100	293,500	296,900	300,300	303,800	307,300	310,800	314,300	317,900	321,500											83
84	301,500	305,000	308,500	312,100	315,600	319,200	322,900	326,500	330,200	333,800	337,500											84
86	309,900	313,400	316,900	320,400	324,000	327,600	331,200	334,800	338,400	342,100	345,800											86
87	324,700	328,400	332,000	335,600	339,300	343,000	346,800	350,500	354,300	358,100	361,900											87
89	333,100	336,700	340,300	344,000	347,600	351,300	355,100	358,800	362,600	366,300	370,100											89
90	347,900	351,700	355,400	359,200	363,000	366,800	370,600	374,500	378,400	382,300	386,200											90
92	356,300	360,000	363,800	367,500	371,300	375,100	378,900	382,800	386,700	390,600	394,500											92
93	371,200	375,000	378,800	382,700	386,600	390,600	394,500	398,500														93
95	381,100	384,900	388,700	392,500	396,400																	95
96	395,900																					96

HEADWATER 598 to 602  
TAILWATER 573.51 to 574.50

MARCH 2004

# GUNTERSVILLE DAM SPILLWAY DISCHARGE IN CUBIC FEET PER SECOND

DATE ARRANGE- MENT	HEADWATER ELEVATION																			DATE ARRANGE- MENT		
	590.0	590.2	590.4	590.6	590.8	591.0	591.2	591.4	591.6	591.8	592.0	592.2	592.4	592.6	592.8	593.0	593.2	593.4	593.6		593.8	594.0
1	950	960	970	970	980	980	990	1,000	1,000	1,010	1,010	1,020	1,020	1,030	1,040	1,040	1,050	1,050	1,060	1,060	1,070	1
2	2,500	2,520	2,530	2,550	2,570	2,590	2,600	2,620	2,640	2,650	2,670	2,680	2,700	2,720	2,730	2,750	2,780	2,780	2,790	2,810	2,830	2
3	3,450	3,480	3,500	3,520	3,550	3,570	3,590	3,610	3,640	3,660	3,680	3,700	3,720	3,750	3,770	3,790	3,810	3,830	3,850	3,870	3,890	3
4	5,000	5,030	5,070	5,100	5,140	5,170	5,200	5,240	5,270	5,300	5,340	5,370	5,400	5,430	5,460	5,500	5,530	5,560	5,590	5,620	5,650	4
5	5,950	5,990	6,030	6,070	6,110	6,150	6,190	6,230	6,270	6,310	6,350	6,390	6,430	6,460	6,500	6,540	6,570	6,610	6,650	6,680	6,720	5
6	7,500	7,550	7,600	7,650	7,710	7,760	7,810	7,860	7,910	7,960	8,010	8,050	8,100	8,150	8,200	8,240	8,290	8,340	8,380	8,430	8,480	6
7	8,450	8,510	8,570	8,630	8,680	8,740	8,800	8,850	8,910	8,960	9,020	9,070	9,130	9,180	9,230	9,290	9,340	9,390	9,440	9,490	9,540	7
8	10,000	10,070	10,140	10,210	10,270	10,340	10,410	10,480	10,540	10,610	10,670	10,740	10,800	10,870	10,930	10,990	11,060	11,120	11,180	11,240	11,300	8
9	10,950	11,030	11,100	11,180	11,250	11,330	11,400	11,470	11,540	11,620	11,690	11,760	11,830	11,900	11,970	12,030	12,100	12,170	12,240	12,300	12,370	9
10	12,500	12,580	12,670	12,760	12,840	12,930	13,010	13,090	13,180	13,260	13,340	13,420	13,500	13,580	13,660	13,740	13,820	13,900	13,970	14,050	14,130	10
11	13,450	13,540	13,640	13,730	13,820	13,910	14,000	14,090	14,180	14,270	14,350	14,440	14,530	14,610	14,700	14,780	14,870	14,950	15,030	15,110	15,190	11
12	14,990	15,100	15,200	15,310	15,410	15,510	15,610	15,710	15,810	15,910	16,010	16,110	16,200	16,300	16,390	16,490	16,580	16,680	16,770	16,860	16,950	12
13	15,950	16,060	16,170	16,280	16,390	16,500	16,600	16,710	16,810	16,920	17,020	17,130	17,230	17,330	17,430	17,530	17,630	17,730	17,830	17,920	18,020	13
14	17,490	17,620	17,740	17,860	17,980	18,100	18,220	18,330	18,450	18,560	18,680	18,790	18,900	19,020	19,130	19,240	19,350	19,460	19,560	19,670	19,780	14
15	18,450	18,580	18,700	18,830	18,960	19,080	19,210	19,330	19,450	19,570	19,690	19,810	19,930	20,050	20,160	20,280	20,390	20,510	20,620	20,730	20,850	15
16	19,990	20,130	20,270	20,410	20,550	20,680	20,820	20,950	21,080	21,220	21,350	21,480	21,610	21,730	21,860	21,990	22,110	22,240	22,360	22,480	22,600	16
17	20,950	21,090	21,240	21,380	21,520	21,670	21,810	21,950	22,090	22,220	22,360	22,500	22,630	22,760	22,900	23,030	23,160	23,290	23,420	23,540	23,670	17
18	22,490	22,650	22,810	22,960	23,120	23,270	23,420	23,570	23,720	23,870	24,020	24,160	24,310	24,450	24,590	24,730	24,870	25,010	25,150	25,290	25,430	18
19	23,440	23,610	23,770	23,930	24,090	24,250	24,410	24,570	24,720	24,880	25,030	25,180	25,330	25,480	25,630	25,780	25,920	26,070	26,210	26,350	26,500	19
20	24,990	25,170	25,340	25,510	25,680	25,850	26,020	26,190	26,360	26,520	26,680	26,850	27,010	27,170	27,320	27,480	27,620	27,790	27,950	28,100	28,250	20
21	26,370	26,550	26,740	26,920	27,110	27,290	27,470	27,650	27,830	28,000	28,180	28,350	28,520	28,690	28,860	29,030	29,200	29,370	29,530	29,690	29,860	21
22	27,740	27,940	28,140	28,340	28,530	28,730	28,920	29,110	29,300	29,490	29,670	29,860	30,040	30,220	30,400	30,580	30,760	30,940	31,110	31,290	31,460	22
23	29,120	29,330	29,540	29,750	29,950	30,160	30,360	30,570	30,770	30,970	31,170	31,360	31,560	31,750	31,940	32,130	32,320	32,510	32,700	32,880	33,070	23
24	30,500	30,720	30,940	31,160	31,380	31,600	31,810	32,030	32,240	32,450	32,660	32,870	33,070	33,280	33,480	33,680	33,880	34,080	34,280	34,470	34,670	24
25	31,870	32,110	32,340	32,570	32,800	33,030	33,260	33,490	33,710	33,930	34,150	34,370	34,590	34,810	35,020	35,230	35,440	35,650	35,860	36,070	36,270	25
26	33,250	33,490	33,740	33,980	34,230	34,470	34,710	34,940	35,180	35,410	35,650	35,880	36,110	36,330	36,560	36,780	37,000	37,230	37,440	37,660	37,880	26
27	34,620	34,880	35,140	35,390	35,650	35,900	36,150	36,400	36,650	36,900	37,140	37,380	37,620	37,860	38,100	38,330	38,570	38,800	39,030	39,250	39,480	27
28	36,000	36,270	36,540	36,810	37,070	37,340	37,600	37,860	38,120	38,380	38,630	38,890	39,140	39,390	39,640	39,880	40,130	40,370	40,610	40,850	41,090	28
29	37,380	37,660	37,940	38,220	38,500	38,770	39,050	39,320	39,590	39,860	40,130	40,390	40,660	40,920	41,180	41,430	41,690	41,940	42,190	42,440	42,690	29
30	38,330	38,620	38,900	39,190	39,470	39,760	40,040	40,320	40,590	40,870	41,140	41,410	41,680	41,950	42,210	42,470	42,740	42,990	43,250	43,500	43,760	30
31	39,880	40,170	40,470	40,770	41,070	41,360	41,650	41,940	42,230	42,510	42,800	43,080	43,360	43,630	43,910	44,180	44,450	44,720	44,990	45,250	45,510	31
32	41,250	41,560	41,870	42,180	42,490	42,800	43,100	43,400	43,700	44,000	44,290	44,580	44,870	45,160	45,450	45,730	46,010	46,290	46,570	46,850	47,120	32
33	42,210	42,520	42,840	43,150	43,470	43,780	44,090	44,400	44,700	45,000	45,300	45,600	45,900	46,190	46,480	46,770	47,060	47,340	47,630	47,910	48,190	33
34	43,750	44,080	44,400	44,730	45,060	45,380	45,700	46,020	46,340	46,650	46,960	47,270	47,570	47,880	48,180	48,480	48,780	49,070	49,360	49,660	49,940	34
35	45,130	45,470	45,800	46,140	46,480	46,820	47,150	47,480	47,810	48,130	48,450	48,770	49,090	49,410	49,720	50,030	50,340	50,640	50,950	51,250	51,550	35
36	46,080	46,430	46,770	47,120	47,460	47,800	48,140	48,470	48,810	49,140	49,470	49,790	50,110	50,440	50,750	51,070	51,380	51,700	52,000	52,310	52,620	36
37	47,630	47,980	48,340	48,690	49,050	49,400	49,750	50,100	50,440	50,780	51,120	51,460	51,790	52,120	52,450	52,780	53,100	53,420	53,740	54,060	54,370	37
38	49,000	49,370	49,740	50,110	50,470	50,840	51,200	51,560	51,910	52,270	52,620	52,960	53,310	53,650	53,990	54,330	54,660	54,990	55,320	55,650	55,980	38
39	51,500	51,890	52,270	52,660	53,040	53,420	53,800	54,180	54,550	54,920	55,280	55,650	56,010	56,370	56,720	57,080	57,430	57,770	58,120	58,460	58,800	39
40	54,000	54,400	54,810	55,210	55,610	56,010	56,400	56,800	57,180	57,570	57,950	58,330	58,710	59,080	59,450	59,820	60,190	60,550	60,910	61,270	61,630	40
41	55,380	55,790	56,210	56,620	57,030	57,440	57,850	58,250	58,650	59,050	59,450	59,840	60,230	60,610	60,990	61,370	61,750	62,120	62,500	62,870	63,230	41
42	57,860	58,300	58,740	59,180	59,620	60,050	60,480	60,910	61,340	61,770	62,190	62,610	63,030	63,450	63,860	64,270	64,670	65,080	65,480	65,880	66,270	42
43	60,340	60,810	61,270	61,740	62,200	62,660	63,110	63,570	64,030	64,490	64,940	65,390	65,840	66,280	66,730	67,160	67,600	68,030	68,460	68,890	69,310	43
44	62,830	63,320	63,810	64,300	64,780	65,260	65,740	66,220	66,710	67,200	67,680	68,170	68,650	69,120	69,590	70,060	70,520	70,980	71,440	71,900	72,350	44
45	65,310	65,830	66,340	66,860	67,360	67,870	68,370	68,880	69,400	69,920	70,430	70,950	71,450	71,960	72,460	72,950	73,450	73,940	74,420	74,910	75,390	45
46	67,790	68,340	68,880	69,410	69,950	70,480	71,000	71,540	72,090	72,640	73,180	73,720	74,260	74,790	75,320	75,850	76,370	76,890	77,410	77,920	78,430	46
47	70,280	70,850	71,410	71,970	72,530	73,080	73,630	74,190	74,770	75,350	75,930	76,500	77,070	77,630	78,190	78,740	79,300	79,840	80,390	80,930	81,470	47
48	72,760	73,360	73,950	74,530	75,110	75,690	76,260	76,850	77,460	78,070	78,680	79,280	79,870	80,470	81,050	81,640	82,220	82,800	83,370	83,940	84,500	48
49	75,250	75,870	76,480	77,090	77,700	78,290	78,890															

# GUNTERSVILLE DAM SPILLWAY DISCHARGE IN CUBIC FEET PER SECOND

GAGE- ELEVATION	HEADWATER ELEVATION																				GAGE- ELEVATION	
	590.0	590.2	590.4	590.6	590.8	591.0	591.2	591.4	591.6	591.8	592.0	592.2	592.4	592.6	592.8	593.0	593.2	593.4	593.6	593.8		594.0
56	94, 290	95, 090	95, 890	96, 670	97, 450	98, 220	98, 980	99, 780	100, 600	101, 500	102, 300	103, 100	104, 000	104, 800	105, 600	106, 400	107, 200	108, 000	108, 800	109, 600	110, 400	56
57	96, 770	97, 600	98, 420	99, 230	100, 000	100, 800	101, 600	102, 400	103, 300	104, 200	105, 100	106, 000	107, 600	108, 500	109, 300	110, 100	111, 000	111, 800	112, 600	113, 400	114, 200	57
58	98, 640	99, 580	100, 500	101, 400	102, 400	103, 300	104, 200	105, 100	106, 100	107, 100	108, 100	109, 100	110, 000	111, 000	112, 000	112, 900	113, 900	114, 800	115, 800	116, 700	117, 700	58
59	100, 500	101, 600	102, 600	103, 600	104, 700	105, 700	106, 700	107, 800	108, 900	110, 000	111, 100	112, 200	113, 300	114, 400	115, 500	116, 600	117, 700	118, 700	119, 800	120, 900	121, 900	59
60	102, 400	103, 500	104, 700	105, 900	107, 000	108, 200	109, 300	110, 500	111, 700	112, 900	114, 100	115, 400	116, 600	117, 800	119, 000	120, 200	121, 400	122, 600	123, 800	125, 000	126, 200	60
61	104, 300	105, 500	106, 800	108, 100	109, 300	110, 600	111, 900	113, 200	114, 500	115, 800	117, 200	118, 500	119, 900	121, 200	122, 500	123, 800	125, 200	126, 500	127, 800	129, 100	130, 400	61
62	106, 100	107, 500	108, 900	110, 300	111, 700	113, 000	114, 400	115, 800	117, 300	118, 800	120, 200	121, 700	123, 100	124, 600	126, 000	127, 500	128, 900	130, 400	131, 800	133, 300	134, 700	62
63	108, 000	109, 500	111, 000	112, 500	114, 000	115, 500	117, 000	118, 500	120, 100	121, 700	123, 200	124, 800	126, 400	128, 000	129, 600	131, 100	132, 700	134, 300	135, 800	137, 400	139, 000	63
64	109, 900	111, 500	113, 100	114, 700	116, 300	117, 900	119, 500	121, 200	122, 900	124, 600	126, 300	128, 000	129, 700	131, 400	133, 100	134, 800	136, 400	138, 100	139, 800	141, 500	143, 200	64
65	111, 700	113, 400	115, 200	116, 900	118, 600	120, 400	122, 100	123, 900	125, 700	127, 500	129, 300	131, 100	132, 900	134, 800	136, 600	138, 400	140, 200	142, 000	143, 800	145, 700	147, 500	65
66	115, 600	117, 300	119, 100	120, 900	122, 600	124, 400	126, 200	128, 000	129, 800	131, 600	133, 500	135, 300	137, 200	139, 000	140, 900	142, 700	144, 500	146, 400	148, 200	150, 100	151, 900	66
67	118, 100	119, 900	121, 600	123, 400	125, 200	127, 000	128, 800	130, 600	132, 500	134, 300	136, 200	138, 100	140, 000	141, 900	143, 700	145, 600	147, 500	149, 300	151, 200	153, 100	155, 000	67
68	120, 000	121, 800	123, 700	125, 600	127, 500	129, 400	131, 300	133, 300	135, 300	137, 300	139, 200	141, 200	143, 200	145, 300	147, 200	149, 200	151, 200	153, 200	155, 200	157, 200	159, 200	68
69	121, 800	123, 800	125, 800	127, 800	129, 900	131, 900	133, 900	136, 000	138, 100	140, 200	142, 300	144, 400	146, 500	148, 600	150, 800	152, 900	155, 000	157, 100	159, 200	161, 300	163, 500	69
70	123, 700	125, 800	127, 900	130, 000	132, 200	134, 300	136, 500	138, 700	140, 900	143, 100	145, 300	147, 500	149, 800	152, 000	154, 300	156, 500	158, 700	161, 000	163, 200	165, 500	167, 700	70
71	125, 600	127, 800	130, 000	132, 300	134, 500	136, 800	139, 000	141, 300	143, 700	146, 000	148, 300	150, 700	153, 100	155, 400	157, 800	160, 100	162, 500	164, 800	167, 200	169, 600	172, 000	71
72	127, 400	129, 800	132, 100	134, 500	136, 800	139, 200	141, 600	144, 000	146, 500	148, 900	151, 400	153, 800	156, 300	158, 800	161, 300	163, 800	166, 200	168, 700	171, 200	173, 700	176, 200	72
73	131, 800	134, 200	136, 700	139, 200	141, 700	144, 300	146, 800	149, 400	151, 900	154, 500	157, 100	159, 800	162, 400	165, 100	167, 700	170, 300	172, 900	175, 600	178, 200	180, 900	183, 500	73
74	136, 100	138, 700	141, 400	144, 000	146, 600	149, 300	152, 000	154, 700	157, 400	160, 200	162, 900	165, 700	168, 500	171, 300	174, 100	176, 800	179, 600	182, 400	185, 200	188, 000	190, 800	74
75	138, 000	140, 700	143, 500	146, 200	148, 900	151, 800	154, 600	157, 400	160, 200	163, 100	166, 000	168, 800	171, 800	174, 700	177, 600	180, 500	183, 400	186, 300	189, 200	192, 100	195, 100	75
76	140, 200	142, 700	145, 200	147, 700	150, 200	152, 800	155, 400	157, 900	160, 600	163, 200	166, 000	168, 800	171, 800	174, 700	177, 600	180, 500	183, 400	186, 300	189, 200	192, 100	195, 100	76
77	146, 500	149, 100	151, 600	154, 200	156, 800	159, 400	162, 000	164, 700	167, 300	170, 000	172, 700	175, 400	178, 100	180, 900	183, 600	186, 300	189, 000	191, 700	194, 500	197, 200	200, 000	77
78	148, 400	151, 100	153, 700	156, 400	159, 100	161, 900	164, 600	167, 400	170, 100	172, 900	175, 700	178, 600	181, 400	184, 300	187, 100	189, 900	192, 800	195, 600	198, 500	201, 300	204, 200	78
79	154, 700	157, 500	160, 200	162, 900	165, 700	168, 500	171, 300	174, 100	176, 900	179, 800	182, 700	185, 500	188, 400	191, 400	194, 200	197, 100	200, 000	202, 900	205, 800	208, 700	211, 700	79
80	156, 600	159, 400	162, 300	165, 200	168, 000	170, 900	173, 800	176, 800	179, 700	182, 700	185, 700	188, 700	191, 700	194, 700	197, 800	200, 800	203, 800	206, 800	209, 800	212, 900	215, 900	80
81	158, 800	161, 400	164, 000	166, 600	169, 300	172, 000	174, 600	177, 300	180, 100	182, 800	185, 600	188, 400	191, 300	194, 200	197, 100	200, 000	202, 900	205, 800	208, 700	211, 700	214, 700	81
82	165, 100	167, 800	170, 500	173, 200	175, 900	178, 600	181, 300	184, 100	186, 900	189, 600	192, 400	195, 300	198, 200	201, 100	204, 000	206, 900	209, 800	212, 700	215, 600	218, 500	221, 400	82
83	167, 000	169, 800	172, 600	175, 400	178, 200	181, 000	183, 900	186, 800	189, 700	192, 600	195, 500	198, 400	201, 300	204, 200	207, 100	210, 000	212, 900	215, 800	218, 700	221, 600	224, 500	83
84	175, 200	178, 200	181, 100	184, 100	187, 100	190, 100	193, 100	196, 200	199, 200	202, 300	205, 400	208, 500	211, 600	214, 700	217, 800	220, 900	224, 000	227, 100	230, 200	233, 300	236, 400	84
85	177, 400	180, 100	182, 900	185, 600	188, 400	191, 100	193, 900	196, 700	199, 600	202, 400	205, 400	208, 500	211, 600	214, 700	217, 800	220, 900	224, 000	227, 100	230, 200	233, 300	236, 400	85
86	185, 600	188, 500	191, 400	194, 300	197, 300	200, 200	203, 200	206, 200	209, 200	212, 200	215, 200	218, 300	221, 300	224, 400	227, 400	230, 500	233, 500	236, 600	239, 700	242, 800	245, 900	86
87	193, 800	196, 900	200, 000	203, 100	206, 200	209, 300	212, 400	215, 600	218, 800	221, 900	225, 200	228, 400	231, 600	234, 900	238, 100	241, 300	244, 600	247, 800	251, 100	254, 300	257, 600	87
88	196, 000	198, 800	201, 700	204, 600	207, 400	210, 300	213, 200	216, 100	219, 100	222, 000	225, 000	228, 000	231, 000	234, 000	237, 000	240, 000	243, 000	246, 000	249, 000	252, 000	255, 000	88
89	204, 200	207, 200	210, 300	213, 300	216, 300	219, 400	222, 500	225, 600	228, 700	231, 800	234, 900	238, 100	241, 300	244, 500	247, 600	250, 800	253, 900	257, 100	260, 300	263, 500	266, 700	89
90	212, 500	215, 600	218, 800	222, 000	225, 200	228, 500	231, 700	235, 000	238, 300	241, 600	244, 900	248, 200	251, 600	254, 900	258, 300	261, 600	265, 000	268, 300	271, 700	275, 100	278, 500	90
92	222, 800	226, 000	229, 100	232, 200	235, 400	238, 600	241, 800	245, 000	248, 200	251, 400	254, 700	257, 900	261, 200	264, 500	267, 800	271, 100	274, 300	277, 600	280, 900	284, 300	287, 600	92
93	231, 100	234, 400	237, 700	241, 000	244, 300	247, 600	251, 000	254, 400	257, 800	261, 200	264, 600	268, 100	271, 500	275, 000	278, 400	281, 900	285, 300	288, 800	292, 300	295, 800	299, 300	93
95	243, 800	247, 100	250, 300	253, 600	256, 800	260, 100	263, 400	266, 700	270, 000	273, 300	276, 700	280, 000	283, 400	286, 800	290, 100	293, 500	296, 900	300, 300	303, 700	307, 100	310, 500	95
96	252, 100	255, 500	258, 900	262, 300	265, 700	269, 200	272, 600	276, 100	279, 600	283, 100	286, 600	290, 100	293, 700	297, 300	300, 800	304, 300	307, 900	311, 400	315, 000	318, 600	322, 200	96
98	264, 800	268, 200	271, 500	274, 900	278, 200	281, 600	285, 000	288, 400	291, 800	295, 200	298, 700	302, 100	305, 600	309, 000	312, 500	315, 900	319, 400	322, 900	326, 400	329, 900	333, 400	98
99	273, 100	276, 600	280, 100	283, 600	287, 100	290, 700	294, 200	297, 800	301, 400	305, 000	308, 600	312, 200	315, 900	319, 500	323, 100	326, 800	330, 400	334, 100	337, 700	341, 400	345, 100	99
101																						

# GUNTERSVILLE DAM SPILLWAY DISCHARGE IN CUBIC FEET PER SECOND

GATE ARRANGEMENT		HEADWATER ELEVATION																		GATE ARRANGEMENT				
		594.0	594.2	594.4	594.6	594.8	595.0	595.2	595.4	595.6	595.8	596.0	596.2	596.4	596.6	596.8	597.0	597.2	597.4		597.6	597.8	598.0	
0*	0	0	0	0	0	0	0	0	0	0	0	0	0	0	0	0	0	0	0	0	0	0	0	1*
1	1, 070	1, 070	1, 080	1, 080	1, 090	1, 090	1, 100	1, 100	1, 160	1, 260	1, 620	1, 620	2, 100	2, 320	3, 080	3, 910	4, 810	5, 760	6, 770	7, 840	8, 950	10, 110	10, 110	0*
2	2, 830	2, 840	2, 860	2, 870	2, 890	2, 900	2, 910	2, 930	3, 090	3, 460	3, 950	4, 530	5, 190	5, 930	6, 720	7, 580	8, 500	9, 470	10, 480	11, 550	12, 660	12, 660	10, 980	1
3	3, 890	3, 910	3, 930	3, 950	3, 970	3, 990	4, 010	4, 030	4, 190	4, 550	5, 010	5, 560	6, 190	6, 900	7, 680	8, 520	9, 420	10, 370	11, 380	12, 430	12, 430	10, 660	2	
4	5, 650	5, 680	5, 710	5, 740	5, 770	5, 800	5, 830	5, 860	6, 030	6, 390	6, 860	7, 430	8, 060	8, 770	9, 540	10, 360	11, 230	12, 160	13, 130	14, 150	15, 210	15, 210	3	
5	6, 720	6, 750	6, 790	6, 820	6, 860	6, 890	6, 930	6, 960	7, 130	7, 470	7, 930	8, 460	9, 060	9, 740	10, 490	11, 290	12, 150	13, 070	14, 020	15, 030	16, 090	17, 200	17, 200	5
6	8, 480	8, 520	8, 570	8, 610	8, 660	8, 700	8, 740	8, 790	8, 960	9, 320	9, 780	10, 320	10, 930	11, 610	12, 350	13, 130	13, 970	14, 850	15, 780	16, 750	17, 750	18, 890	18, 890	6
7	9, 540	9, 590	9, 650	9, 690	9, 740	9, 790	9, 840	9, 890	10, 060	10, 400	10, 840	11, 350	11, 940	12, 580	13, 300	14, 070	14, 890	15, 760	16, 670	17, 630	18, 630	19, 670	19, 670	7
8	11, 300	11, 360	11, 420	11, 480	11, 540	11, 600	11, 660	11, 720	11, 900	12, 250	12, 690	13, 220	13, 810	14, 450	15, 160	15, 910	16, 700	17, 540	18, 420	19, 340	20, 300	21, 300	21, 300	8
9	12, 370	12, 440	12, 500	12, 570	12, 630	12, 690	12, 760	12, 820	13, 000	13, 330	13, 750	14, 250	14, 810	15, 430	16, 110	16, 840	17, 620	18, 450	19, 320	20, 230	21, 180	22, 170	22, 170	9
10	14, 130	14, 200	14, 280	14, 350	14, 430	14, 500	14, 570	14, 640	14, 830	15, 170	15, 610	16, 110	16, 680	17, 300	17, 970	18, 680	19, 440	20, 240	21, 070	21, 940	22, 850	23, 800	23, 800	10
11	15, 190	15, 280	15, 360	15, 440	15, 510	15, 590	15, 670	15, 750	15, 930	16, 260	16, 670	17, 150	17, 680	18, 270	18, 920	19, 620	20, 360	21, 140	21, 970	22, 830	23, 740	24, 690	24, 690	11
12	16, 950	17, 040	17, 130	17, 220	17, 310	17, 400	17, 490	17, 570	17, 770	18, 100	18, 520	19, 010	19, 550	20, 140	20, 780	21, 460	22, 170	22, 930	23, 720	24, 540	25, 400	26, 300	26, 300	12
13	18, 020	18, 120	18, 210	18, 310	18, 400	18, 490	18, 590	18, 680	18, 870	19, 190	19, 700	20, 200	20, 700	21, 200	21, 740	22, 310	22, 910	23, 510	24, 140	24, 800	25, 490	26, 200	26, 200	13
14	19, 780	19, 880	19, 990	20, 090	20, 200	20, 300	20, 400	20, 500	20, 700	21, 030	21, 440	21, 900	22, 420	22, 980	23, 590	24, 230	24, 910	25, 620	26, 370	27, 140	27, 940	28, 760	28, 760	14
15	20, 850	20, 960	21, 070	21, 180	21, 280	21, 390	21, 500	21, 610	21, 800	22, 110	22, 500	22, 950	23, 450	23, 990	24, 570	25, 190	25, 840	26, 520	27, 230	27, 970	28, 740	29, 540	29, 540	15
16	22, 620	22, 720	22, 840	22, 960	23, 080	23, 200	23, 320	23, 440	23, 630	23, 960	24, 350	24, 800	25, 290	25, 830	26, 400	27, 010	27, 650	28, 320	29, 010	29, 740	30, 490	31, 270	31, 270	16
17	23, 670	23, 800	23, 920	24, 050	24, 170	24, 290	24, 410	24, 540	24, 740	25, 040	25, 400	25, 830	26, 300	26, 810	27, 350	27, 920	28, 510	29, 120	29, 760	30, 430	31, 130	31, 860	31, 860	17
18	25, 430	25, 560	25, 700	25, 830	25, 970	26, 100	26, 230	26, 360	26, 570	26, 890	27, 260	27, 690	28, 160	28, 670	29, 210	29, 780	30, 380	31, 010	31, 660	32, 340	33, 040	33, 760	33, 760	18
19	26, 500	26, 640	26, 780	26, 920	27, 060	27, 190	27, 330	27, 460	27, 700	28, 070	28, 490	28, 950	29, 450	29, 980	30, 540	31, 130	31, 740	32, 370	33, 020	33, 690	34, 390	35, 110	35, 110	19
20	28, 250	28, 400	28, 550	28, 700	28, 850	29, 000	29, 140	29, 290	29, 500	29, 810	30, 180	30, 590	31, 030	31, 510	32, 020	32, 550	33, 120	33, 700	34, 310	34, 940	35, 590	36, 260	36, 260	20
21	29, 860	30, 020	30, 180	30, 340	30, 500	30, 650	30, 810	30, 970	31, 190	31, 510	31, 890	32, 300	32, 760	33, 250	33, 770	34, 310	34, 880	35, 480	36, 090	36, 730	37, 390	38, 070	38, 070	21
22	31, 460	31, 630	31, 800	31, 970	32, 140	32, 310	32, 480	32, 640	32, 880	33, 210	33, 590	34, 020	34, 490	34, 980	35, 510	36, 070	36, 650	37, 250	37, 880	38, 530	39, 200	39, 890	39, 890	22
23	33, 070	33, 250	33, 430	33, 610	33, 790	33, 970	34, 140	34, 320	34, 560	34, 900	35, 300	35, 740	36, 210	36, 720	37, 260	37, 820	38, 410	39, 030	39, 660	40, 320	41, 000	41, 690	41, 690	23
24	34, 670	34, 860	35, 050	35, 250	35, 430	35, 620	35, 810	36, 000	36, 250	36, 600	37, 010	37, 450	37, 940	38, 460	39, 000	39, 580	40, 180	40, 800	41, 450	42, 120	42, 800	43, 500	43, 500	24
25	36, 270	36, 480	36, 680	36, 880	37, 080	37, 280	37, 480	37, 670	37, 940	38, 300	38, 710	39, 170	39, 670	40, 190	40, 750	41, 330	41, 940	42, 580	43, 230	43, 910	44, 610	45, 320	45, 320	25
26	37, 880	38, 090	38, 310	38, 520	38, 730	38, 940	39, 140	39, 350	39, 620	39, 990	40, 420	40, 890	41, 390	41, 930	42, 500	43, 090	43, 710	44, 350	45, 020	45, 700	46, 410	47, 140	47, 140	26
27	39, 480	39, 710	39, 930	40, 150	40, 370	40, 590	40, 810	41, 030	41, 310	41, 690	42, 130	42, 610	43, 120	43, 670	44, 240	44, 850	45, 480	46, 130	46, 800	47, 500	48, 210	48, 940	48, 940	27
28	41, 090	41, 320	41, 560	41, 790	42, 020	42, 250	42, 480	42, 700	43, 000	43, 390	43, 830	44, 320	44, 850	45, 400	45, 990	46, 600	47, 240	47, 900	48, 590	49, 290	50, 020	50, 770	50, 770	28
29	42, 690	42, 940	43, 180	43, 420	43, 660	43, 900	44, 140	44, 380	44, 690	45, 090	45, 540	46, 040	46, 570	47, 140	47, 740	48, 360	49, 010	49, 680	50, 370	51, 090	51, 820	52, 570	52, 570	29
34	50, 690	50, 940	51, 180	51, 420	51, 660	51, 900	52, 140	52, 380	52, 740	53, 150	53, 610	54, 110	54, 640	55, 200	55, 790	56, 410	57, 060	57, 740	58, 450	59, 190	59, 960	60, 760	60, 760	34
35	52, 290	52, 540	52, 780	53, 020	53, 260	53, 500	53, 740	53, 980	54, 340	54, 750	55, 210	55, 710	56, 240	56, 800	57, 390	58, 010	58, 660	59, 340	60, 050	60, 790	61, 560	62, 360	62, 360	35
36	53, 890	54, 140	54, 380	54, 620	54, 860	55, 100	55, 340	55, 580	55, 940	56, 350	56, 810	57, 310	57, 840	58, 400	58, 990	59, 610	60, 260	60, 940	61, 650	62, 390	63, 160	63, 960	63, 960	36
37	55, 490	55, 740	55, 980	56, 220	56, 460	56, 700	56, 940	57, 180	57, 540	57, 950	58, 410	58, 910	59, 440	59, 990	60, 570	61, 180	61, 820	62, 490	63, 190	63, 920	64, 680	65, 470	65, 4	



# GUNTERSVILLE DAM SPILLWAY DISCHARGE IN CUBIC FEET PER SECOND

GATE NUMBER	HEADWATER ELEVATION																			GATE NUMBER		
	594.0	594.2	594.4	594.6	594.8	595.0	595.2	595.4	595.6	595.8	596.0	596.2	596.4	596.6	596.8	597.0	597.2	597.4	597.6		597.8	598.0
55	107,200	107,900	108,700	109,400	110,200	110,900	111,600	112,400	113,100	113,900	114,700	115,500	116,200	117,000	117,800	118,600	119,400	120,300	121,100	121,900	122,700	55
56	110,400	111,200	111,900	112,700	113,500	114,200	115,000	115,700	116,500	117,300	118,100	118,900	119,700	120,500	121,300	122,100	122,900	123,700	124,500	125,300	126,100	56
57	113,400	114,200	115,000	115,800	116,600	117,400	118,200	119,000	119,800	120,600	121,400	122,200	123,000	123,800	124,600	125,400	126,200	127,000	127,800	128,600	129,400	57
58	117,700	118,600	119,500	120,500	121,400	122,300	123,200	124,100	125,000	126,000	127,000	128,000	129,000	130,000	131,000	132,000	133,000	134,000	135,000	136,000	137,000	58
59	121,900	123,000	124,100	125,100	126,200	127,200	128,300	129,300	130,400	131,500	132,600	133,700	134,800	135,900	137,000	138,200	139,300	140,500	141,600	142,800	143,900	59
60	126,200	127,400	128,600	129,800	131,000	132,100	133,300	134,500	135,700	136,900	138,200	139,400	140,700	141,900	143,200	144,500	145,800	147,100	148,400	149,700	151,000	60
61	130,400	131,800	133,100	134,400	135,700	137,000	138,400	139,700	141,000	142,400	143,800	145,100	146,500	147,900	149,400	150,800	152,200	153,600	155,100	156,500	158,000	61
62	134,700	136,200	137,600	139,100	140,500	142,000	143,400	144,900	146,300	147,800	149,400	150,900	152,400	154,000	155,500	157,100	158,600	160,200	161,800	163,400	165,000	62
63	139,000	140,500	142,100	143,700	145,300	146,900	148,500	150,000	151,700	153,300	154,900	156,600	158,300	160,000	161,700	163,400	165,100	166,800	168,500	170,300	172,000	63
64	143,200	144,900	146,600	148,300	150,100	151,800	153,500	155,200	157,000	158,700	160,500	162,300	164,200	166,000	167,800	169,700	171,500	173,400	175,300	177,200	179,100	64
65	147,500	149,300	151,200	153,000	154,800	156,700	158,500	160,400	162,300	164,200	166,100	168,000	170,000	172,000	174,000	176,000	178,000	180,000	182,000	184,000	186,100	65
66	151,900	153,800	155,600	157,500	159,400	161,200	163,100	165,000	166,900	168,800	170,700	172,700	174,600	176,600	178,500	180,500	182,500	184,500	186,400	188,400	190,400	66
67	155,000	156,800	158,700	160,600	162,500	164,400	166,300	168,200	170,200	172,100	174,100	176,000	178,000	180,000	181,900	183,900	185,900	187,900	190,000	192,000	194,000	67
68	159,200	161,200	163,200	165,300	167,300	169,300	171,400	173,400	175,500	177,600	179,700	181,700	183,900	186,000	188,100	190,200	192,400	194,500	196,700	198,900	201,000	68
69	163,500	165,600	167,800	169,900	172,100	174,300	176,400	178,600	180,800	183,000	185,200	187,500	189,700	192,000	194,300	196,500	198,800	201,100	203,400	205,700	208,100	69
70	167,700	170,000	172,300	174,600	176,900	179,200	181,500	183,800	186,100	188,500	190,800	193,200	195,600	198,000	200,400	202,800	205,300	207,700	210,100	212,600	215,100	70
71	172,000	174,400	176,800	179,200	181,600	184,100	186,500	189,000	191,400	193,900	196,400	198,900	201,500	204,000	206,600	209,100	211,700	214,300	216,900	219,500	222,100	71
72	176,200	178,800	181,300	183,900	186,400	189,000	191,600	194,100	196,800	199,400	202,000	204,700	207,300	210,000	212,700	215,400	218,100	220,900	223,600	226,400	229,100	72
73	183,500	186,200	188,900	191,600	194,300	197,100	199,800	202,600	205,300	208,100	210,900	213,700	216,600	219,400	222,300	225,200	228,000	230,900	233,900	236,800	239,700	73
74	190,800	193,700	196,500	199,400	202,300	205,200	208,100	211,000	213,900	216,900	219,800	222,800	225,800	228,800	231,900	234,900	238,000	241,000	244,100	247,200	250,300	74
75	195,100	198,100	201,100	204,000	207,100	210,100	213,100	216,200	219,200	222,300	225,400	228,500	231,700	234,800	238,000	241,200	244,400	247,600	250,800	254,100	257,400	75
77	200,000	202,700	205,500	208,300	211,100	213,900	216,700	219,600	222,400	225,300	228,300	231,200	234,200	237,100	240,100	243,100	246,200	249,200	252,300	255,400	258,500	77
78	204,200	207,100	210,000	212,900	215,800	218,800	221,800	224,800	227,800	230,800	233,800	236,900	240,000	243,100	246,300	249,400	252,600	255,800	259,000	262,200	265,500	78
79	211,700	214,600	217,600	220,600	223,600	226,600	229,600	232,600	235,600	238,700	241,800	244,900	248,000	251,100	254,300	257,400	260,600	263,800	267,000	270,200	273,400	79
80	215,900	219,000	222,100	225,200	228,300	231,500	234,600	237,800	241,000	244,200	247,400	250,600	253,900	257,100	260,400	263,700	267,000	270,400	273,700	277,100	280,400	80
82	220,800	223,700	226,600	229,500	232,400	235,300	238,300	241,200	244,200	247,200	250,200	253,300	256,300	259,400	262,500	265,700	268,800	272,000	275,200	278,300	281,600	82
83	225,100	228,100	231,100	234,100	237,200	240,200	243,300	246,400	249,500	252,600	255,800	259,000	262,200	265,400	268,700	272,000	275,300	278,600	281,900	285,200	288,600	83
84	236,800	240,000	243,200	246,400	249,600	252,900	256,100	259,400	262,700	266,000	269,300	272,700	276,000	279,400	282,800	286,200	289,700	293,100	296,600	300,000	303,500	84
86	245,900	249,000	252,200	255,300	258,500	261,600	264,800	268,000	271,200	274,500	277,800	281,100	284,400	287,700	291,100	294,500	297,900	301,300	304,700	308,200	311,700	86
87	257,600	260,900	264,200	267,600	270,900	274,300	277,600	281,000	284,400	287,900	291,300	294,800	298,200	301,700	305,200	308,800	312,300	315,900	319,400	323,000	326,600	87
89	266,700	270,000	273,300	276,600	279,900	283,300	286,600	289,900	293,300	296,700	299,700	303,100	306,600	310,000	313,500	317,000	320,500	324,100	327,600	331,200	334,800	89
90	278,500	281,900	285,300	288,800	292,200	295,700	299,200	302,600	306,200	309,700	313,300	316,800	320,400	324,000	327,600	331,300	334,900	338,600	342,300	346,000	349,700	90
92	287,600	290,900	294,300	297,700	301,000	304,400	307,800	311,300	314,700	318,200	321,700	325,200	328,800	332,300	335,900	339,500	343,200	346,800	350,500	354,100	357,800	92
93	299,300	302,800	306,400	309,900	313,500	317,100	320,700	324,300	327,900	331,500	335,200	338,900	342,600	346,300	350,100	353,800	357,600	361,400	365,200	369,000	372,800	93
95	310,500	313,900	317,400	320,800	324,300	327,800	331,300	334,800	338,300	341,800	345,400	349,000	352,700	356,300	360,000	363,700	367,400	371,100	374,900	378,600	382,400	95
96	322,200	325,800	329,500	333,100	336,700	340,400	344,100	347,800	351,500	355,200	359,000	362,700	366,500	370,300	374,100	378,000	381,800	385,700	389,500	393,400	397,400	96
98	333,400	336,900	340,400	344,000	347,500	351,100	354,700	358,300	361,900	365,500	369,200	372,900	376,600	380,300	384,100	387,800	391,600	395,400	399,300	403,100	406,900	98
99	345,100	348,800	352,500	356,300	360,000	363,700	367,500	371,300	375,100	378,900	382,700	386,600	390,400	394,300	398,200	402,100	406,000	410,000	413,900			99
101	356,300	359,900	363,500	367,100	370,800	374,400	378,100	381,800	385,500	389,200	392,900	396,700	400,500	404,300	408,200	412,000						101
102	368,000	371,800	375,600	379,400	383,200	387,100	390,900	394,800	398,700	402,600	406,500											102
104	379,200	382,900	386,600	390,300	394,000	397,800	401,500	405,300	409,000	412,900												104
105	390,900	394,800	398,700	402,600	406,500	410,400																105
106	393,600	397,300	401,100	404,800	408,600	412,400																106

HEADWATER 594 to 598  
TAILWATER 574.51 to 575.50

MARCH 2004

# GUNTERVILLE DAM SPILLWAY DISCHARGE IN CUBIC FEET PER SECOND

GATE ARRANGEMENT	HEADWATER ELEVATION																				GATE ARRANGEMENT	
	598.0	598.2	598.4	598.6	598.8	599.0	599.2	599.4	599.6	599.8	600.0	600.2	600.4	600.6	600.8	601.0	601.2	601.4	601.6	601.8		602.0
0*	10, 110	11, 320	12, 570	13, 860	15, 200	16, 580	18, 000	19, 450	20, 940	22, 470	24, 030											0*
1	10, 980	12, 180	13, 430	14, 710	16, 040	17, 410	18, 820	20, 270	21, 750	23, 280	24, 830											1
2	12, 660	13, 810	15, 010	16, 250	17, 550	18, 890	20, 270	21, 700	23, 160	24, 670	26, 210											2
4	15, 210	16, 310	17, 440	18, 640	19, 900	21, 200	22, 550	23, 950	25, 390	26, 860	28, 380											4
6	17, 750	18, 800	19, 880	21, 030	22, 240	23, 510	24, 830	26, 200	27, 610	29, 060	30, 550											6
8	20, 300	21, 290	22, 320	23, 420	24, 590	25, 830	27, 110	28, 450	29, 830	31, 250	32, 720											8
10	22, 850	23, 790	24, 760	25, 800	26, 940	28, 140	29, 390	30, 700	32, 050	33, 450	34, 890											10
12	25, 400	26, 280	27, 200	28, 190	29, 290	30, 450	31, 670	32, 950	34, 270	35, 640	37, 060											12
14	27, 940	28, 780	29, 630	30, 580	31, 630	32, 760	33, 950	35, 200	36, 490	37, 840	39, 230											14
16	30, 490	31, 270	32, 070	32, 970	33, 980	35, 070	36, 230	37, 450	38, 720	40, 040	41, 400											16
18	33, 040	33, 760	34, 510	35, 350	36, 330	37, 380	38, 510	39, 700	40, 940	42, 230	43, 580											18
20	35, 590	36, 260	36, 950	37, 740	38, 680	39, 700	40, 790	41, 950	43, 160	44, 430	45, 750											20
21	37, 390	38, 070	38, 770	39, 570	40, 490	41, 490	42, 560	43, 690	44, 870	46, 100	47, 380											21
22	39, 200	39, 880	40, 590	41, 390	42, 300	43, 280	44, 330	45, 420	46, 570	47, 770	49, 000											22
23	41, 000	41, 700	42, 410	43, 210	44, 110	45, 070	46, 090	47, 160	48, 280	49, 440	50, 630											23
24	42, 800	43, 510	44, 240	45, 030	45, 920	46, 870	47, 860	48, 900	49, 990	51, 100	52, 260											24
25	44, 610	45, 320	46, 060	46, 860	47, 730	48, 660	49, 630	50, 640	51, 690	52, 770	53, 890											25
26	46, 410	47, 140	47, 880	48, 680	49, 540	50, 450	51, 400	52, 380	53, 400	54, 440	55, 520											26
27	48, 210	48, 950	49, 700	50, 500	51, 360	52, 250	53, 170	54, 120	55, 100	56, 110	57, 150											27
28	50, 020	50, 760	51, 530	52, 330	53, 170	54, 040	54, 940	55, 860	56, 810	57, 780	58, 770											28
29	51, 820	52, 580	53, 350	54, 150	54, 980	55, 830	56, 710	57, 600	58, 520	59, 450	60, 400											29
31	54, 370	55, 070	55, 790	56, 540	57, 330	58, 140	58, 990	59, 850	60, 740	61, 650	62, 570											31
32	56, 170	56, 880	57, 610	58, 360	59, 140	59, 940	60, 750	61, 590	62, 440	63, 320	64, 200											32
34	58, 720	59, 380	60, 050	60, 750	61, 490	62, 250	63, 030	63, 840	64, 670	65, 510	66, 370											34
35	60, 530	61, 190	61, 870	62, 570	63, 300	64, 040	64, 800	65, 580	66, 370	67, 180	68, 000											35
37	63, 070	63, 690	64, 310	64, 960	65, 640	66, 350	67, 080	67, 830	68, 590	69, 380	70, 170											37
38	64, 880	65, 500	66, 130	66, 780	67, 460	68, 150	68, 850	69, 570	70, 300	71, 050	71, 800											38
39	67, 430	67, 990	68, 570	69, 170	69, 800	70, 460	71, 130	71, 820	72, 520	73, 240	73, 970											39
40	69, 970	70, 490	71, 010	71, 560	72, 150	72, 770	73, 410	74, 070	74, 740	75, 440	76, 140											40
41	71, 780	72, 300	72, 830	73, 380	73, 960	74, 560	75, 180	75, 810	76, 450	77, 110	77, 770											41
42	75, 360	75, 910	76, 460	77, 040	77, 650	78, 270	78, 920	79, 570	80, 240	80, 920	81, 610											42
43	78, 940	79, 520	80, 100	80, 700	81, 330	81, 990	82, 650	83, 330	84, 030	84, 730	85, 450											43
44	82, 520	83, 130	83, 730	84, 360	85, 020	85, 700	86, 390	87, 100	87, 820	88, 550	89, 290											44
45	86, 110	86, 730	87, 370	88, 020	88, 710	89, 410	90, 130	90, 860	91, 610	92, 360	93, 130											45
46	89, 690	90, 340	91, 000	91, 680	92, 390	93, 120	93, 870	94, 620	95, 390	96, 180	96, 970											46
47	93, 270	93, 950	94, 640	95, 340	96, 080	96, 830	97, 600	98, 390	99, 180	99, 990	100, 800											47
48	96, 850	97, 560	98, 270	99, 000	99, 760	100, 500	101, 300	102, 200	103, 000	103, 800	104, 600											48
49	100, 400	101, 200	101, 900	102, 700	103, 500	104, 300	105, 100	105, 900	106, 800	107, 600	108, 500											49
50	104, 800	105, 500	106, 200	106, 900	107, 600	108, 400	109, 100	109, 900	110, 700	111, 500	112, 300											50
51	108, 400	109, 100	109, 800	110, 500	111, 300	112, 100	112, 900	113, 700	114, 500	115, 300	116, 100											51
52	112, 000	112, 700	113, 400	114, 200	115, 000	115, 800	116, 600	117, 400	118, 300	119, 100	120, 000											52
53	115, 500	116, 300	117, 100	117, 900	118, 700	119, 500	120, 300	121, 200	122, 100	122, 900	123, 800											53
54	119, 100	119, 900	120, 700	121, 500	122, 400	123, 200	124, 100	125, 000	125, 800	126, 700	127, 600											54
55	122, 700	123, 500	124, 300	125, 200	126, 000	126, 900	127, 800	128, 700	129, 600	130, 600	131, 500											55
56	126, 300	127, 100	128, 000	128, 800	129, 700	130, 500	131, 400	132, 200	133, 000	133, 900	134, 700											56
57	129, 900	130, 800	131, 600	132, 500	133, 300	134, 200	135, 100	136, 000	136, 800	137, 700	138, 600											57
58	136, 900	137, 900	138, 900	140, 000	141, 000	142, 000	143, 000	144, 100	145, 100	146, 100	147, 200											58
59	143, 900	145, 100	146, 300	147, 400	148, 600	149, 800	151, 000	152, 200	153, 300	154, 500	155, 700											59
60	151, 000	152, 300	153, 600	154, 900	156, 200	157, 600	158, 900	160, 200	161, 600	163, 000	164, 300											60
61	158, 000	159, 400	160, 900	162, 400	163, 800	165, 300	166, 800	168, 300	169, 900	171, 400	172, 900											61
62	165, 000	166, 600	168, 200	169, 800	171, 500	173, 100	174, 800	176, 400	178, 100	179, 800	181, 500											62
63	172, 000	173, 800	175, 500	177, 300	179, 100	180, 900	182, 700	184, 500	186, 400	188, 200	190, 000											63
64	179, 100	181, 000	182, 900	184, 800	186, 700	188, 700	190, 700	192, 600	194, 600	196, 600	198, 600											64
65	186, 100	188, 100	190, 200	192, 300	194, 300	196, 500	198, 600	200, 700	202, 900	205, 000	207, 200											65
66	190, 400	192, 400	194, 400	196, 500	198, 500	200, 600	202, 600	204, 700	206, 800	208, 900	211, 000											66

MARCH 2004

\* Arrangement "0" indicates that all spillway gates are closed.  
Discharge is spillway gate and trash gate overflow.

HEADWATER 598 to 602  
TAILWATER 574.51 to 575.50

# GUNTERSVILLE DAM SPILLWAY DISCHARGE IN CUBIC FEET PER SECOND

RAISE- MENT	HEADWATER ELEVATION																				RAISE- MENT	
	598.0	598.2	598.4	598.6	598.8	599.0	599.2	599.4	599.6	599.8	600.0	600.2	600.4	600.6	600.8	601.0	601.2	601.4	601.6	601.8		602.0
67	194,000	196,000	198,100	200,100	202,200	204,300	206,400	208,500	210,600	212,700	214,800											67
68	201,000	203,200	205,400	207,600	209,800	212,100	214,300	216,600	218,800	221,100	223,400											68
69	208,100	210,400	212,700	215,100	217,400	219,800	222,300	224,700	227,100	229,500	232,000											69
70	215,100	217,600	220,000	222,500	225,100	227,600	230,200	232,800	235,300	237,900	240,500											70
71	222,100	224,700	227,400	230,000	232,700	235,400	238,100	240,900	243,600	246,400	249,100											71
72	229,100	231,900	234,700	237,500	240,300	243,200	246,100	249,000	251,900	254,800	257,700											72
73	239,700	242,700	245,600	248,600	251,600	254,700	257,700	260,800	263,900	267,000	270,100											73
74	250,300	253,500	256,600	259,800	262,900	266,200	269,400	272,700	275,900	279,200	282,500											74
75	257,400	260,600	263,900	267,200	270,600	274,000	277,400	280,800	284,200	287,600	291,100											75
77	258,500	261,600	264,700	267,800	271,000	274,200	277,500															77
78	265,500	268,800	272,000	275,300	278,600	282,000	285,400	288,800	292,200	295,700	299,100											78
79	273,400	276,700	279,900	283,200	286,500	289,800	293,200	296,600	299,900	303,300	306,700											79
80	280,400	283,800	287,200	290,700	294,100	297,600	301,100	304,700	308,200	311,800	315,300											80
82	281,600	284,800	288,000	291,300	294,600	297,900	301,200															82
83	288,600	292,000	295,300	298,700	302,200	305,700	309,200	312,700	316,200	319,800	323,300											83
84	303,500	307,000	310,600	314,100	317,700	321,300	324,900	328,500	332,200	335,900	339,600											84
86	311,700	315,200	318,700	322,200	325,700	329,300	332,900	336,600	340,200	343,900	347,600											86
87	326,600	330,200	333,900	337,500	341,200	344,900	348,700	352,400	356,200	360,000	363,800											87
89	334,800	338,400	342,000	345,600	349,300	353,000	356,700	360,500	364,200	368,000	371,800											89
90	349,700	353,400	357,200	361,000	364,700	368,600	372,400	376,300	380,200	384,100	388,000											90
92	357,800	361,600	365,300	369,000	372,800	376,600	380,500	384,300	388,200	392,100	396,000											92
93	372,800	376,600	380,500	384,400	388,300	392,200	396,200	400,200	404,200	408,200	412,200											93
95	382,400	386,200	390,000	393,800	397,700	401,600	405,500	409,400	413,300													95
96	397,400	401,300	405,200	409,200	413,100																	96
98	406,900	410,800																				98

HEADWATER 598 to 602  
TAILWATER 574.51 to 575.50

MARCH 2004

**GUNTERSVILLE DAM  
SPILLWAY DISCHARGE  
IN CUBIC FEET PER SECOND**

GATE ARRANGE- MENT	HEADWATER ELEVATION																			GATE ARRANGE- MENT		
	590.0	590.2	590.4	590.6	590.8	591.0	591.2	591.4	591.6	591.8	592.0	592.2	592.4	592.6	592.8	593.0	593.2	593.4	593.6		593.8	594.0
6	7.330	7.380	7.430	7.490	7.540	7.590	7.640	7.690	7.740	7.790	7.840	7.890	7.940	7.990	8.040	8.090	8.140	8.180	8.230	8.280	8.320	6
7	8.260	8.320	8.380	8.430	8.490	8.550	8.610	8.670	8.720	8.780	8.830	8.890	8.940	9.000	9.050	9.110	9.160	9.210	9.270	9.320	9.370	7
8	9.770	9.840	9.910	9.980	10.050	10.120	10.190	10.260	10.320	10.390	10.460	10.520	10.590	10.660	10.720	10.780	10.850	10.910	10.970	11.040	11.100	8
9	10.700	10.780	10.850	10.930	11.010	11.080	11.160	11.230	11.300	11.380	11.450	11.520	11.590	11.660	11.730	11.800	11.870	11.940	12.010	12.080	12.140	9
10	12.210	12.300	12.390	12.480	12.560	12.650	12.740	12.820	12.910	13.000	13.070	13.160	13.240	13.320	13.400	13.480	13.560	13.640	13.720	13.790	13.870	10
11	13.140	13.240	13.330	13.420	13.520	13.610	13.700	13.790	13.880	13.970	14.060	14.150	14.240	14.330	14.410	14.500	14.580	14.670	14.750	14.840	14.920	11
12	14.650	14.760	14.870	14.970	15.080	15.180	15.280	15.390	15.490	15.590	15.690	15.790	15.890	15.980	16.080	16.180	16.270	16.370	16.460	16.550	16.650	12
13	15.580	15.700	15.810	15.920	16.030	16.140	16.250	16.360	16.470	16.570	16.680	16.780	16.890	16.990	17.090	17.200	17.300	17.400	17.500	17.600	17.690	13
14	17.090	17.220	17.340	17.470	17.590	17.710	17.830	17.950	18.070	18.190	18.300	18.420	18.530	18.650	18.760	18.870	18.980	19.090	19.200	19.310	19.420	14
15	18.020	18.160	18.290	18.420	18.540	18.670	18.800	18.920	19.050	19.170	19.290	19.410	19.530	19.650	19.770	19.890	20.010	20.120	20.240	20.350	20.470	15
16	19.540	19.680	19.820	19.960	20.100	20.240	20.380	20.510	20.650	20.780	20.920	21.050	21.180	21.310	21.440	21.570	21.700	21.820	21.950	22.070	22.200	16
17	20.470	20.620	20.760	20.910	21.060	21.200	21.340	21.490	21.630	21.770	21.910	22.050	22.180	22.320	22.450	22.590	22.720	22.850	22.980	23.110	23.240	17
18	21.980	22.140	22.300	22.460	22.620	22.770	22.930	23.080	23.230	23.380	23.530	23.680	23.830	23.970	24.120	24.260	24.410	24.550	24.690	24.830	24.970	18
19	22.910	23.080	23.240	23.410	23.570	23.730	23.890	24.050	24.210	24.370	24.520	24.680	24.830	24.980	25.130	25.280	25.430	25.580	25.730	25.870	26.020	19
20	24.420	24.600	24.780	24.950	25.130	25.300	25.470	25.640	25.810	25.980	26.150	26.310	26.480	26.640	26.800	26.960	27.120	27.280	27.430	27.590	27.740	20
21	25.770	25.960	26.150	26.340	26.530	26.710	26.890	27.080	27.260	27.440	27.620	27.790	27.970	28.140	28.310	28.490	28.660	28.820	28.990	29.160	29.320	21
22	27.120	27.320	27.520	27.720	27.920	28.120	28.320	28.510	28.700	28.890	29.080	29.270	29.460	29.640	29.830	30.010	30.190	30.370	30.550	30.730	30.900	22
23	28.470	28.690	28.900	29.110	29.320	29.530	29.740	29.940	30.150	30.350	30.550	30.750	30.950	31.150	31.340	31.540	31.730	31.920	32.110	32.300	32.480	23
24	29.820	30.050	30.270	30.500	30.720	30.940	31.160	31.380	31.590	31.810	32.020	32.230	32.440	32.650	32.860	33.060	33.260	33.470	33.670	33.870	34.060	24
25	31.170	31.410	31.650	31.880	32.120	32.350	32.580	32.810	33.040	33.270	33.490	33.710	33.930	34.150	34.370	34.590	34.800	35.010	35.230	35.440	35.640	25
26	32.520	32.770	33.020	33.270	33.520	33.760	34.000	34.250	34.490	34.720	34.960	35.190	35.430	35.660	35.890	36.110	36.340	36.560	36.780	37.000	37.220	26
27	33.870	34.130	34.390	34.650	34.910	35.170	35.430	35.680	35.930	36.180	36.430	36.670	36.920	37.160	37.400	37.640	37.870	38.110	38.340	38.570	38.800	27
28	35.220	35.500	35.770	36.040	36.310	36.580	36.850	37.110	37.380	37.640	37.900	38.150	38.410	38.660	38.910	39.160	39.410	39.660	39.900	40.140	40.380	28
29	36.570	36.860	37.140	37.430	37.710	37.990	38.270	38.550	38.820	39.100	39.370	39.630	39.900	40.170	40.430	40.690	40.950	41.200	41.460	41.710	41.960	29
30	37.500	37.790	38.080	38.370	38.660	38.950	39.240	39.520	39.800	40.080	40.360	40.630	40.900	41.170	41.440	41.710	41.970	42.230	42.490	42.750	43.010	30
31	39.010	39.320	39.620	39.920	40.220	40.520	40.820	41.110	41.400	41.690	41.980	42.270	42.550	42.830	43.110	43.380	43.660	43.930	44.200	44.470	44.740	31
32	40.360	40.680	40.990	41.310	41.620	41.930	42.240	42.550	42.850	43.150	43.450	43.750	44.040	44.330	44.620	44.910	45.200	45.480	45.760	46.040	46.320	32
33	41.290	41.610	41.930	42.250	42.570	42.890	43.210	43.520	43.830	44.140	44.440	44.740	45.040	45.340	45.640	45.930	46.220	46.510	46.800	47.080	47.360	33
34	42.810	43.140	43.470	43.800	44.130	44.460	44.790	45.110	45.430	45.750	46.060	46.380	46.690	47.000	47.310	47.610	47.910	48.210	48.500	48.800	49.090	34
35	44.160	44.500	44.840	45.190	45.530	45.870	46.210	46.540	46.880	47.210	47.530	47.860	48.180	48.500	48.820	49.130	49.440	49.750	50.060	50.370	50.670	35
36	45.080	45.440	45.790	46.140	46.490	46.830	47.180	47.520	47.850	48.190	48.520	48.850	49.180	49.510	49.830	50.150	50.470	50.780	51.100	51.410	51.720	36
37	46.600	46.960	47.320	47.680	48.040	48.400	48.760	49.110	49.460	49.800	50.150	50.490	50.830	51.160	51.500	51.830	52.160	52.480	52.810	53.130	53.450	37
38	47.950	48.320	48.690	49.070	49.440	49.810	50.180	50.540	50.900	51.260	51.620	51.970	52.320	52.670	53.010	53.350	53.690	54.030	54.360	54.700	55.030	38
39	50.390	50.780	51.170	51.560	51.950	52.340	52.730	53.110	53.480	53.860	54.230	54.600	54.970	55.330	55.690	56.050	56.400	56.760	57.110	57.460	57.800	39
40	52.830	53.240	53.650	54.060	54.470	54.870	55.270	55.670	56.070	56.460	56.850	57.230	57.610	57.990	58.370	58.740	59.120	59.480	59.850	60.210	60.580	40
41	54.180	54.600	55.020	55.450	55.870	56.280	56.690	57.100	57.510	57.910	58.310	58.710	59.110	59.500	59.880	60.270	60.650	61.030	61.410	61.780	62.160	41
42	56.630	57.080	57.530	57.970	58.420	58.860	59.290	59.730	60.170	60.600	61.030	61.460	61.880	62.300	62.720	63.130	63.540	63.950	64.360	64.760	65.160	42
43	59.080	59.560	60.030	60.500	60.970	61.430	61.890	62.350	62.820	63.280	63.740	64.200	64.650	65.100	65.550	66.000	66.430	66.870	67.310	67.740	68.170	43
44	61.530	62.030	62.530	63.020	63.520	64.000	64.490	64.980	65.470	65.970	66.460	66.940	67.430	67.910	68.380	68.860	69.330	69.790	70.260	70.720	71.170	44
45	63.980	64.510	65.030	65.550	66.070	66.580	67.080	67.580	68.080	68.570	69.060	69.550	70.040	70.520	71.000	71.470	71.940	72.410	72.870	73.330	73.790	45
46	66.430	66.990	67.530	68.080	68.620	69.150	69.680	70.220	70.780	71.340	71.890	72.430	72.980	73.510	74.050	74.580	75.110	75.630	76.150	76.670	77.190	46
47	68.880	69.460	70.030	70.600	71.170	71.720	72.280	72.850	73.440	74.020	74.600	75.180	75.750	76.320	76.880	77.440	78.000	78.550	79.100	79.650	80.200	47
48	71.330	71.940	72.530	73.130	73.710	74.300	74.870	75.470	76.090	76.700	77.320	77.920	78.520	79.120	79.720	80.310	80.890	81.470	82.050	82.630	83.200	48
49	73.790	74.410	75.040	75.650	76.260	76.870	77.470	78.090	78.740	79.390	80.030	80.670	81.300	81.930	82.550	83.170	83.780	84.390	85.000	85.600	86.200	49
50	77.580	78.240	78.890	79.530	80.180	80.810	81.440	82.090	82.740	83.440	84.110	84.780	85.440	86.090	86.740	87.390	88.030	88.670	89.300	89.930	90.560	50
51	80.030	80.710	81.390	82.060	82.730	83.380	84.030	84.710	85.420	86.130	86.830	87.520	88.210	88.900	89.580	90.250	90.920	91.590	92.250	92.910	93.560	51
52	82.480	83.190	83.890	84.590	85.280	85.960	86.630	87.340	88.080	88.810	89.540	90.270	90.990	91.700	92.410	93.110	93.810	94.510	95.200	95.890	96.570	52
53	84.930	85.660	86.390	87.110	87.830	88.530	89.230	89.960	90.730	91.500	92.260	93.010	93.760	94.500	95.240	95.980	96.710	97.430	98.150	98.860	99.580	53

GUNTERSVILLE DAM  
SPILLWAY DISCHARGE  
IN CUBIC FEET PER SECOND

88	194,700	197,600	200,500	203,400	206,300	209,200	212,100	215,000	217,900	220,800	223,700	226,600	229,500	232,400	235,300	238,200	241,100	244,000	246,900	249,800	252,700	255,600
89	202,900	206,000	209,000	212,100	215,100	218,200	221,200	224,300	227,300	230,400	233,400	236,500	239,500	242,600	245,600	248,700	251,700	254,800	257,800	260,900	263,900	266,900
90	211,100	214,300	217,500	220,700	223,900	227,100	230,300	233,500	236,700	239,900	243,100	246,300	249,500	252,700	255,900	259,100	262,300	265,500	268,700	271,900	275,100	278,300
92	221,400	224,600	227,700	230,900	234,100	237,300	240,500	243,700	246,900	250,100	253,300	256,500	259,700	262,900	266,100	269,300	272,500	275,700	278,900	282,100	285,300	288,500
93	229,600	232,900	236,100	239,300	242,500	245,700	248,900	252,100	255,300	258,500	261,700	264,900	268,100	271,300	274,500	277,700	280,900	284,100	287,300	290,500	293,700	296,900
95	242,200	245,500	248,800	252,100	255,400	258,700	262,000	265,300	268,600	271,900	275,200	278,500	281,800	285,100	288,400	291,700	295,000	298,300	301,600	304,900	308,200	311,500
96	250,400	253,800	257,300	260,800	264,200	267,700	271,100	274,500	277,900	281,300	284,700	288,100	291,500	294,900	298,300	301,700	305,100	308,500	311,900	315,300	318,700	322,100
98	263,000	266,400	269,800	273,200	276,600	280,000	283,400	286,800	290,200	293,600	297,000	300,400	303,800	307,200	310,600	314,000	317,400	320,800	324,200	327,600	331,000	334,400
99	271,200	274,800	278,300	281,900	285,500	289,100	292,700	296,300	299,900	303,500	307,100	310,700	314,300	317,900	321,500	325,100	328,700	332,300	335,900	339,500	343,100	346,700
101	283,900	287,400	290,900	294,400	297,900	301,400	304,900	308,400	311,900	315,400	318,900	322,400	325,900	329,400	332,900	336,400	339,900	343,400	346,900	350,400	353,900	357,400
102	292,100	295,700	299,300	302,900	306,500	310,100	313,700	317,300	320,900	324,500	328,100	331,700	335,300	338,900	342,500	346,100	349,700	353,300	356,900	360,500	364,100	367,700
104	304,700	308,300	311,900	315,500	319,100	322,700	326,300	329,900	333,500	337,100	340,700	344,300	347,900	351,500	355,100	358,700	362,300	365,900	369,500	373,100	376,700	380,300
105	312,900	316,600	320,200	323,800	327,400	331,000	334,600	338,200	341,800	345,400	349,000	352,600	356,200	359,800	363,400	367,000	370,600	374,200	377,800	381,400	385,000	388,600
106	318,100	321,700	325,300	328,900	332,500	336,100	339,700	343,300	346,900	350,500	354,100	357,700	361,300	364,900	368,500	372,100	375,700	379,300	382,900	386,500	390,100	393,700
107	334,500	338,100	341,700	345,300	348,900	352,500	356,100	359,700	363,300	366,900	370,500	374,100	377,700	381,300	384,900	388,500	392,100	395,700	399,300	402,900	406,500	410,100
108	345,900	349,500	353,100	356,700	360,300	363,900	367,500	371,100	374,700	378,300	381,900	385,500	389,100	392,700	396,300	399,900	403,500	407,100	410,700	414,300	417,900	421,500
109	354,100	358,000	361,900	365,800	369,700	373,600	377,500</															

# GUNTERSVILLE DAM SPILLWAY DISCHARGE IN CUBIC FEET PER SECOND

GATE ARRANGEMENT	HEADWATER ELEVATION																			GATE ARRANGEMENT			
	594.0	594.2	594.4	594.6	594.8	595.0	595.2	595.4	595.6	595.8	596.0	596.2	596.4	596.6	596.8	597.0	597.2	597.4	597.6		597.8	598.0	
0*																						0*	
1																							1
2																							2
3																							3
54																							54

MARCH 2004

\* Arrangement "0" indicates that all spillway gates are closed.  
Discharge is spillway gate and trash gate overflow.

HEADWATER 594 to 598  
TAILWATER 575.51 to 576.50

# GUNTERSVILLE DAM SPILLWAY DISCHARGE IN CUBIC FEET PER SECOND

GATE OPENING FEET	HEADWATER ELEVATION																			GATE OPENING FEET		
	594.0	594.2	594.4	594.6	594.8	595.0	595.2	595.4	595.6	595.8	596.0	596.2	596.4	596.6	596.8	597.0	597.2	597.4	597.6		597.8	598.0
55	105,600	106,400	107,100	107,900	108,600	109,400	110,100	110,800	111,600	112,400	113,100	113,900	114,700	115,500	116,300	117,100	118,000	118,800	119,600	120,400	121,200	55
56	108,700	109,500	110,300	111,100	111,900	112,600	113,400	114,100	114,900	115,700	116,500	117,300	118,100	119,000	119,800	120,600	121,400	122,300	123,100	123,900	124,800	56
57	111,800	112,600	113,400	114,200	115,000	115,800	116,600	117,300	118,100	119,000	119,800	120,600	121,500	122,300	123,200	124,000	124,900	125,700	126,600	127,500	128,300	57
58	116,100	117,000	118,000	119,000	119,800	120,800	121,700	122,600	123,500	124,500	125,500	126,400	127,400	128,400	129,400	130,400	131,400	132,400	133,400	134,400	135,400	58
59	120,400	121,500	122,600	123,600	124,700	125,800	126,800	127,900	128,900	130,000	131,100	132,300	133,400	134,500	135,600	136,800	137,900	139,100	140,200	141,400	142,500	59
60	124,800	126,000	127,200	128,400	129,600	130,800	131,900	133,100	134,300	135,600	136,800	138,100	139,300	140,600	141,900	143,200	144,400	145,700	147,000	148,300	149,700	60
61	129,100	130,400	131,800	133,100	134,400	135,700	137,100	138,400	139,700	141,100	142,500	143,900	145,300	146,700	148,100	149,500	151,000	152,400	153,900	155,300	156,800	61
62	133,500	134,900	136,400	137,800	139,300	140,700	142,200	143,700	145,100	146,600	148,200	149,700	151,200	152,800	154,300	155,900	157,500	159,100	160,700	162,300	163,900	62
63	137,800	139,400	141,000	142,600	144,100	145,700	147,300	148,900	150,500	152,200	153,800	155,500	157,200	158,900	160,600	162,300	164,000	165,700	167,500	169,200	171,000	63
64	142,100	143,800	145,600	147,300	149,000	150,700	152,500	154,200	155,900	157,700	159,500	161,300	163,100	165,000	166,800	168,700	170,500	172,400	174,300	176,200	178,100	64
65	146,500	148,300	150,200	152,000	153,900	155,700	157,600	159,500	161,300	163,300	165,200	167,100	169,100	171,100	173,000	175,000	177,100	179,100	181,100	183,200	185,200	65
66	150,800	152,700	154,600	156,400	158,300	160,200	162,100	164,000	165,900	167,800	169,700	171,700	173,600	175,600	177,500	179,500	181,500	183,500	185,500	187,500	189,500	66
67	153,800	155,700	157,600	159,500	161,400	163,300	165,300	167,200	169,100	171,100	173,000	175,000	177,000	179,000	180,900	182,900	184,900	187,000	189,000	191,000	193,000	67
68	158,200	160,200	162,200	164,300	166,300	168,300	170,400	172,400	174,500	176,600	178,700	180,800	182,900	185,000	187,200	189,300	191,500	193,600	195,800	198,000	200,100	68
69	162,500	164,700	166,800	169,000	171,200	173,300	175,500	177,700	179,900	182,100	184,400	186,600	188,900	191,100	193,400	195,700	198,000	200,300	202,600	204,900	207,300	69
70	166,900	169,100	171,400	173,700	176,000	178,300	180,600	183,000	185,300	187,700	190,000	192,400	194,800	197,200	199,600	202,100	204,500	207,000	209,400	211,900	214,400	70
71	171,200	173,600	176,000	178,400	180,900	183,300	185,800	188,200	190,700	193,200	195,700	198,200	200,800	203,300	205,900	208,400	211,000	213,600	216,200	218,800	221,500	71
72	175,500	178,100	180,600	183,200	185,700	188,300	190,900	193,500	196,100	198,700	201,400	204,000	206,700	209,400	212,100	214,800	217,600	220,300	223,000	225,800	228,600	72
73	182,900	185,600	188,300	191,000	193,700	196,500	199,200	202,000	204,700	207,500	210,300	213,200	216,000	218,900	221,700	224,600	227,500	230,400	233,400	236,300	239,200	73
74	190,200	193,100	196,000	198,900	201,700	204,600	207,500	210,400	213,400	216,300	219,300	222,300	225,300	228,300	231,400	234,400	237,500	240,600	243,700	246,800	249,900	74
75	194,600	197,500	200,500	203,500	206,600	209,600	212,600	215,700	218,800	221,900	225,000	228,100	231,300	234,400	237,600	240,800	244,000	247,200	250,500	253,700	257,000	75
77	199,300	202,100	204,900	207,700	210,500	213,300	216,200	219,000	221,900	224,800	227,700	230,700	233,600	236,600	239,600	242,700	245,700	248,800	251,800	254,900	258,000	77
78	203,700	206,600	209,500	212,400	215,400	218,300	221,300	224,300	227,300	230,300	233,400	236,500	239,600	242,700	245,900	249,000	252,200	255,400	258,600	261,900	265,100	78
79	211,000	214,000	217,000	219,900	222,900	226,000	229,000	232,000	235,100	238,100	241,200	244,300	247,500	250,600	253,700	256,900	260,100	263,300	266,500	269,700	273,000	79
80	215,400	218,400	221,600	224,700	227,800	230,900	234,100	237,300	240,500	243,700	246,900	250,100	253,400	256,700	260,000	263,300	266,600	270,000	273,300	276,700	280,100	80
82	220,100	223,000	225,900	228,800	231,700	234,700	237,600	240,600	243,600	246,600	249,600	252,700	255,800	258,900	262,000	265,100	268,300	271,500	274,700	277,900	281,100	82
83	224,400	227,500	230,500	233,500	236,600	239,700	242,800	245,900	249,000	252,100	255,300	258,500	261,700	265,000	268,200	271,500	274,800	278,100	281,500	284,800	288,200	83
84	236,100	239,300	242,600	245,800	249,000	252,300	255,600	258,900	262,200	265,500	268,800	272,200	275,600	279,000	282,400	285,800	289,200	292,700	296,200	299,600	303,100	84
86	245,200	248,400	251,500	254,700	257,900	261,000	264,200	267,400	270,700	273,900	277,200	280,600	283,900	287,300	290,600	294,000	297,400	300,900	304,300	307,800	311,300	86
87	256,900	260,200	263,600	266,900	270,300	273,700	277,000	280,400	283,900	287,300	290,700	294,200	297,700	301,200	304,700	308,300	311,800	315,400	319,000	322,600	326,200	87
89	266,000	269,300	272,500	275,800	279,100	282,400	285,700	289,000	292,400	295,800	299,200	302,600	306,000	309,500	313,000	316,500	320,000	323,600	327,100	330,700	334,300	89
90	277,700	281,200	284,600	288,100	291,500	295,000	298,500	302,000	305,600	309,100	312,700	316,300	319,900	323,500	327,100	330,800	334,400	338,100	341,800	345,500	349,300	90
92	286,800	290,200	293,500	296,900	300,300	303,800	307,200	310,600	314,100	317,600	321,100	324,600	328,200	331,800	335,400	339,000	342,600	346,300	350,000	353,700	357,400	92
93	298,500	302,100	305,600	309,200	312,800	316,400	320,000	323,600	327,300	330,900	334,600	338,300	342,000	345,700	349,500	353,300	357,000	360,800	364,700	368,500	372,300	93
95	309,600	313,100	316,600	320,000	323,500	327,000	330,500	334,100	337,600	341,200	344,800	348,400	352,100	355,700	359,400	363,100	366,900	370,600	374,400	378,100	381,900	95
96	321,300	325,000	328,600	332,300	336,000	339,700	343,400	347,100	350,800	354,500	358,300	362,100	365,900	369,700	373,500	377,400	381,300	385,100	389,000	392,900	396,900	96
98	332,500	336,000	339,600	343,200	346,700	350,300	353,900	357,500	361,200	364,800	368,500	372,200	376,000	379,700	383,500	387,300	391,100	394,900	398,700	402,600	406,400	98
99	344,200	347,900	351,700	355,400	359,200	363,000	366,700	370,500	374,300	378,200	382,000	385,900	389,800	393,700	397,600	401,500	405,500	409,400	413,400	417,400	421,400	99
101	355,300	359,000	362,600	366,300	369,900	373,600	377,300	381,000	384,700	388,500	392,200	396,000	399,800	403,700	407,500	411,400	415,300	419,200	423,100	427,000		101
102	367,000	370,800	374,700	378,500	382,400	386,200	390,100	394,000	397,900	401,800	405,700	409,700	413,700	417,600	421,600	425,600	429,700					102
104	378,100	381,900	385,600	389,400	393,100	396,900	400,700	404,500	408,300	412,100	416,000	419,800	423,700	427,600								104
105	389,800	393,800	397,700	401,600	405,600	409,500	413,500	417,500	421,400	425,400	429,500											105
106	392,600	396,400	400,200	404,000	407,800	411,600	415,400	419,200	423,100	427,000												106
107	416,000	420,200	424,300	428,500																		107
108	426,100																					108

HEADWATER 594 to 598  
TAILWATER 575.51 to 576.50

MARCH 2004

GUNTERSVILLE DAM  
**SPILLWAY DISCHARGE**  
 IN CUBIC FEET PER SECOND

SPILLWAY ARRANGEMENT	HEADWATER ELEVATION																				SPILLWAY ARRANGEMENT	
	598.0	598.2	598.4	598.6	598.8	599.0	599.2	599.4	599.6	599.8	600.0	600.2	600.4	600.6	600.8	601.0	601.2	601.4	601.6	601.8		602.0
0*	10,110	11,320	12,570	13,860	15,200	16,580	18,000	19,450	20,940	22,470	24,030											0*
1	10,960	12,160	13,410	14,690	16,020	17,390	18,800	20,250	21,740	23,260	24,820											1
2	12,610	13,770	14,960	16,210	17,500	18,850	20,230	21,650	23,120	24,620	26,160											2
4	15,110	16,210	17,350	18,550	19,810	21,110	22,460	23,860	25,300	26,770	28,290											4
6	17,610	18,660	19,750	20,890	22,110	23,380	24,700	26,060	27,470	28,920	30,410											6
8	20,120	21,110	22,140	23,230	24,410	25,640	26,930	28,270	29,650	31,080	32,540											8
10	22,620	23,560	24,530	25,580	26,710	27,910	29,170	30,470	31,830	33,230	34,670											10
12	25,120	26,010	26,920	27,920	29,010	30,180	31,400	32,680	34,000	35,380	36,800											12
14	27,620	28,450	29,310	30,260	31,320	32,440	33,640	34,880	36,180	37,530	38,920											14
16	30,120	30,900	31,700	32,600	33,620	34,710	35,870	37,090	38,360	39,680	41,050											16
18	32,620	33,350	34,100	34,940	35,920	36,980	38,100	39,290	40,540	41,830	43,180											18
20	35,130	35,800	36,490	37,290	38,220	39,240	40,340	41,500	42,710	43,980	45,300											20
21	36,910	37,590	38,290	39,090	40,010	41,010	42,080	43,210	44,400	45,630	46,910											21
22	38,690	39,380	40,090	40,890	41,800	42,790	43,830	44,930	46,080	47,280	48,520											22
23	40,470	41,170	41,890	42,690	43,590	44,560	45,580	46,650	47,770	48,930	50,120											23
24	42,250	42,960	43,690	44,490	45,380	46,330	47,320	48,370	49,450	50,570	51,730											24
25	44,030	44,750	45,490	46,290	47,170	48,100	49,070	50,080	51,140	52,220	53,340											25
26	45,810	46,540	47,290	48,090	48,960	49,870	50,820	51,800	52,820	53,870	54,940											26
27	47,590	48,330	49,090	49,890	50,750	51,640	52,560	53,520	54,500	55,510	56,550											27
28	49,380	50,120	50,890	51,690	52,540	53,410	54,310	55,240	56,190	57,160	58,160											28
29	51,160	51,910	52,690	53,490	54,320	55,180	56,060	56,960	57,870	58,810	59,760											29
31	53,660	54,360	55,080	55,830	56,630	57,450	58,290	59,160	60,050	60,960	61,890											31
32	55,440	56,150	56,880	57,640	58,420	59,220	60,040	60,880	61,730	62,610	63,500											32
34	57,940	58,600	59,270	59,980	60,720	61,480	62,270	63,080	63,910	64,760	65,620											34
35	59,720	60,390	61,070	61,780	62,510	63,250	64,020	64,800	65,600	66,410	67,230											35
37	62,220	62,840	63,470	64,120	64,810	65,520	66,250	67,000	67,770	68,560	69,360											37
38	64,010	64,630	65,270	65,920	66,600	67,290	68,000	68,720	69,460	70,200	70,960											38
39	66,510	67,080	67,660	68,260	68,900	69,560	70,230	70,930	71,630	72,360	73,090											39
40	69,010	69,530	70,050	70,610	71,200	71,820	72,470	73,130	73,810	74,510	75,220											40
41	70,790	71,320	71,850	72,410	72,990	73,600	74,210	74,850	75,500	76,150	76,820											41
42	74,340	74,890	75,450	76,030	76,640	77,270	77,920	78,580	79,250	79,940	80,630											42
43	77,890	78,470	79,050	79,660	80,300	80,950	81,630	82,310	83,010	83,720	84,440											43
44	81,440	82,050	82,660	83,290	83,950	84,630	85,330	86,040	86,760	87,500	88,250											44
45	84,990	85,620	86,260	86,920	87,610	88,310	89,040	89,770	90,520	91,280	92,050											45
46	88,540	89,200	89,860	90,550	91,260	91,990	92,740	93,500	94,280	95,060	95,860											46
47	92,090	92,770	93,460	94,170	94,910	95,670	96,450	97,230	98,030	98,850	99,670											47
48	95,640	96,350	97,060	97,800	98,570	99,350	100,200	101,000	101,800	102,600	103,500											48
49	99,190	99,920	100,700	101,400	102,200	103,000	103,900	104,700	105,500	106,400	107,300											49
50	103,500	104,200	104,900	105,600	106,300	107,100	107,800	108,600	109,400	110,200	111,000											50
51	107,000	107,700	108,500	109,200	110,000	110,700	111,500	112,300	113,200	114,000	114,800											51
52	110,600	111,300	112,100	112,800	113,600	114,400	115,200	116,100	116,900	117,800	118,600											52
53	114,100	114,900	115,700	116,500	117,300	118,100	119,000	119,800	120,700	121,600	122,400											53
54	117,700	118,500	119,300	120,100	120,900	121,800	122,700	123,500	124,400	125,300	126,200											54
55	121,200	122,000	122,900	123,700	124,600	125,500	126,400	127,300	128,200	129,100	130,100											55
56	124,800	125,600	126,500	127,300	128,200	129,100	130,000	130,900	131,800	132,700	133,600											56
57	128,300	129,200	130,100	130,900	131,800	132,700	133,600	134,400	135,300	136,200	137,100											57
58	135,400	136,500	137,500	138,500	139,500	140,600	141,600	142,600	143,700	144,700	145,700											58
59	142,500	143,700	144,900	146,100	147,200	148,400	149,600	150,800	152,000	153,200	154,400											59
60	149,700	151,000	152,300	153,600	154,900	156,300	157,600	159,000	160,300	161,700	163,100											60
61	156,800	158,200	159,700	161,200	162,700	164,200	165,700	167,200	168,700	170,200	171,700											61
62	163,900	165,500	167,100	168,700	170,400	172,000	173,700	175,300	177,000	178,700	180,400											62
63	171,000	172,700	174,500	176,300	178,100	179,900	181,700	183,500	185,400	187,200	189,000											63
64	178,100	180,000	181,900	183,800	185,800	187,800	189,700	191,700	193,700	195,700	197,700											64
65	185,200	187,300	189,300	191,400	193,500	195,600	197,800	199,900	202,000	204,200	206,400											65
66	189,500	191,500	193,500	195,600	197,600	199,700	201,700	203,800	205,900	208,000	210,100											66

MARCH 2004

\* Arrangement "0" indicates that all spillway gates are closed.  
 Discharge is spillway gate and trash gate overflow.

HEADWATER 598 to 602  
 TAILWATER 575.51 to 576.50



## GUNTERSVILLE DAM SPILLWAY DISCHARGE IN CUBIC FEET PER SECOND

GAGE HEIGHT	HEADWATER ELEVATION																			GAGE HEIGHT		
	598.0	598.2	598.4	598.6	598.8	599.0	599.2	599.4	599.6	599.8	600.0	600.2	600.4	600.6	600.8	601.0	601.2	601.4	601.6		601.8	602.0
67	193,000	195,100	197,100	199,200	201,200	203,300	205,400	207,500	209,700	211,800	213,900											67
68	200,100	202,300	204,500	206,700	209,000	211,200	213,500	215,700	218,000	220,300	222,600											68
69	207,300	209,600	211,900	214,300	216,700	219,100	221,500	223,900	226,300	228,800	231,200											69
70	214,400	216,800	219,300	221,900	224,400	226,900	229,500	232,100	234,700	237,300	239,900											70
71	221,500	224,100	226,800	229,400	232,100	234,800	237,500	240,300	243,000	245,800	248,600											71
72	228,600	231,400	234,200	237,000	239,800	242,700	245,600	248,500	251,400	254,300	257,200											72
73	239,200	242,200	245,200	248,200	251,200	254,200	257,300	260,400	263,500	266,600	269,700											73
74	249,900	253,000	256,200	259,300	262,500	265,800	269,000	272,300	275,600	278,900	282,200											74
75	257,000	260,300	263,600	266,900	270,200	273,600	277,000	280,500	283,900	287,400	290,800											75
77	258,000	261,100	264,300	267,400	270,600	273,800	277,100															77
78	265,100	268,400	271,700	275,000	278,300	281,700	285,100	288,500	291,900	295,400	298,800											78
79	273,000	276,200	279,500	282,800	286,100	289,400	292,800	296,200	299,500	303,000	306,400											79
80	280,100	283,500	286,900	290,300	293,800	297,300	300,800	304,300	307,900	311,500	315,000											80
82	281,100	284,300	287,600	290,800	294,100	297,500	300,800															82
83	288,200	291,600	295,000	298,400	301,800	305,300	308,800	312,400	315,900	319,500	323,000											83
84	303,100	306,700	310,200	313,700	317,300	320,900	324,600	328,200	331,900	335,600	339,200											84
86	311,300	314,800	318,300	321,800	325,400	329,000	332,600	336,200	339,900	343,600	347,300											86
87	326,200	329,800	333,500	337,100	340,800	344,600	348,300	352,100	355,900	359,600	363,500											87
89	334,300	337,900	341,600	345,200	348,900	352,600	356,300	360,100	363,900	367,700	371,500											89
90	349,300	353,000	356,800	360,500	364,300	368,200	372,100	375,900	379,800	383,700	387,700											90
92	357,400	361,100	364,900	368,600	372,400	376,200	380,100	384,000	387,900	391,800	395,700											92
93	372,300	376,200	380,100	384,000	387,900	391,800	395,800	399,800	403,800	407,800	411,900											93
95	381,900	385,700	389,500	393,400	397,200	401,100	405,100	409,000	413,000	416,900	420,900											95
96	396,900	400,800	404,700	408,700	412,700	416,700	420,800	424,800	428,900													96
98	406,400	410,300	414,200	418,100	422,100	426,100																98
99	421,400	425,400	429,400																			99

HEADWATER 598 to 602  
TAILWATER 575.51 to 576.50

MARCH 2004

**GUNTERSVILLE DAM  
SPILLWAY DISCHARGE  
IN CUBIC FEET PER SECOND**

GATE ARRANGE- MENT	HEADWATER ELEVATION																				GATE ARRANGE- MENT		
	590.0	590.2	590.4	590.6	590.8	591.0	591.2	591.4	591.6	591.8	592.0	592.2	592.4	592.6	592.8	593.0	593.2	593.4	593.6	593.8		594.0	
16																						16	
17													21,590	21,730	21,870	22,010	22,150	22,280	22,420	21,540	21,660	21,790	17
18												23,040	23,200	23,350	23,500	23,650	23,790	23,940	24,080	22,550	22,680	22,810	18
19	22,360	22,530	22,700	22,870	23,040	23,200	23,370	23,530	23,690	23,850	24,010	24,170	24,330	24,480	24,640	24,790	24,940	25,090	25,240	25,390	25,540	19	
20	23,840	24,020	24,210	24,390	24,560	24,740	24,920	25,090	25,260	25,440	25,610	25,770	25,940	26,110	26,280	26,440	26,600	26,760	26,920	27,080	27,240	20	
21	25,160	25,360	25,550	25,740	25,940	26,130	26,310	26,500	26,680	26,870	27,050	27,230	27,410	27,590	27,760	27,940	28,110	28,280	28,450	28,620	28,790	21	
22	26,490	26,690	26,900	27,100	27,310	27,510	27,710	27,910	28,100	28,300	28,490	28,680	28,870	29,060	29,250	29,440	29,620	29,810	29,990	30,170	30,350	22	
23	27,810	28,030	28,250	28,460	28,680	28,890	29,100	29,310	29,520	29,730	29,940	30,140	30,340	30,540	30,740	30,940	31,130	31,330	31,520	31,710	31,900	23	
24	29,130	29,360	29,590	29,820	30,050	30,280	30,500	30,720	30,940	31,160	31,380	31,590	31,810	32,020	32,230	32,440	32,650	32,850	33,060	33,260	33,460	24	
25	30,450	30,700	30,940	31,180	31,420	31,660	31,890	32,130	32,360	32,590	32,820	33,050	33,270	33,500	33,720	33,940	34,160	34,370	34,590	34,800	35,010	25	
26	31,770	32,030	32,280	32,540	32,790	33,040	33,290	33,540	33,780	34,020	34,260	34,500	34,740	34,980	35,210	35,440	35,670	35,900	36,120	36,350	36,570	26	
27	33,100	33,360	33,630	33,900	34,160	34,420	34,690	34,940	35,200	35,460	35,710	35,960	36,210	36,450	36,690	36,940	37,180	37,420	37,660	37,890	38,130	27	
28	34,420	34,700	34,980	35,260	35,530	35,810	36,080	36,350	36,620	36,890	37,150	37,410	37,670	37,930	38,190	38,440	38,690	38,940	39,190	39,440	39,680	28	
29	35,740	36,030	36,320	36,610	36,900	37,190	37,480	37,760	38,040	38,320	38,590	38,870	39,140	39,410	39,680	39,940	40,210	40,470	40,730	40,980	41,240	29	
30	36,650	36,940	37,240	37,540	37,830	38,130	38,420	38,710	39,000	39,280	39,560	39,840	40,120	40,390	40,670	40,940	41,210	41,480	41,740	42,000	42,260	30	
31	38,130	38,440	38,740	39,050	39,360	39,670	39,970	40,270	40,570	40,860	41,150	41,450	41,730	42,020	42,300	42,590	42,870	43,140	43,420	43,690	43,960	31	
32	39,450	39,770	40,090	40,410	40,730	41,050	41,360	41,680	41,990	42,290	42,600	42,900	43,200	43,500	43,790	44,090	44,380	44,670	44,950	45,240	45,520	32	
33	40,350	40,680	41,010	41,340	41,660	41,990	42,310	42,630	42,940	43,250	43,560	43,870	44,180	44,480	44,790	45,080	45,380	45,670	45,970	46,250	46,540	33	
34	41,830	42,170	42,510	42,850	43,190	43,520	43,860	44,190	44,510	44,840	45,160	45,480	45,790	46,110	46,420	46,730	47,040	47,340	47,640	47,940	48,240	34	
35	43,150	43,510	43,860	44,210	44,560	44,910	45,250	45,590	45,930	46,270	46,600	46,930	47,260	47,590	47,910	48,230	48,550	48,860	49,180	49,490	49,800	35	
36	44,060	44,420	44,770	45,130	45,490	45,840	46,190	46,540	46,890	47,230	47,570	47,910	48,240	48,570	48,900	49,230	49,550	49,870	50,190	50,510	50,820	36	
37	45,540	45,910	46,280	46,650	47,020	47,380	47,740	48,100	48,460	48,810	49,160	49,510	49,860	50,200	50,540	50,880	51,210	51,540	51,870	52,200	52,520	37	
38	46,860	47,240	47,620	48,010	48,390	48,760	49,140	49,510	49,880	50,240	50,610	50,960	51,320	51,680	52,030	52,380	52,720	53,060	53,400	53,740	54,080	38	
39	49,240	49,650	50,040	50,440	50,840	51,240	51,630	52,020	52,400	52,790	53,170	53,540	53,920	54,290	54,650	55,020	55,380	55,740	56,100	56,450	56,800	39	
40	51,630	52,050	52,470	52,880	53,300	53,710	54,120	54,530	54,930	55,330	55,730	56,120	56,510	56,900	57,280	57,660	58,040	58,420	58,790	59,160	59,520	40	
41	52,950	53,380	53,810	54,240	54,670	55,100	55,520	55,940	56,350	56,760	57,170	57,570	57,970	58,380	58,770	59,160	59,550	59,940	60,320	60,700	61,080	41	
42	55,370	55,830	56,280	56,740	57,190	57,640	58,080	58,530	58,970	59,410	59,850	60,290	60,720	61,150	61,570	61,990	62,410	62,830	63,240	63,650	64,050	42	
43	57,790	58,280	58,760	59,230	59,710	60,180	60,650	61,120	61,600	62,070	62,540	63,000	63,460	63,920	64,370	64,820	65,270	65,710	66,150	66,590	67,020	43	
44	60,220	60,720	61,230	61,730	62,230	62,720	63,210	63,710	64,200	64,720	65,220	65,710	66,200	66,690	67,170	67,650	68,130	68,600	69,070	69,540	70,000	44	
45	62,640	63,170	63,700	64,230	64,750	65,270	65,780	66,300	66,840	67,370	67,900	68,420	68,940	69,460	69,970	70,480	70,990	71,490	72,000	72,480	72,970	45	
46	65,060	65,620	66,170	66,720	67,270	67,810	68,350	68,900	69,460	70,030	70,580	71,140	71,690	72,230	72,770	73,310	73,850	74,380	74,900	75,430	75,940	46	
47	67,480	68,060	68,640	69,220	69,790	70,350	70,910	71,490	72,090	72,680	73,270	73,850	74,430	75,000	75,570	76,140	76,710	77,260	77,820	78,370	78,920	47	
48	69,900	70,510	71,110	71,710	72,310	72,890	73,480	74,080	74,710	75,330	75,950	76,560	77,170	77,780	78,380	78,970	79,560	80,150	80,730	81,310	81,890	48	
49	72,320	72,960	73,590	74,210	74,830	75,440	76,040	76,670	77,330	77,980	78,630	79,270	79,910	80,550	81,180	81,800	82,420	83,040	83,650	84,260	84,860	49	
50	76,030	76,700	77,350	78,010	78,650	79,290	79,930	80,590	81,280	81,960	82,640	83,310	83,970	84,640	85,290	85,950	86,590	87,240	87,880	88,510	89,140	50	
51	78,450	79,140	79,820	80,500	81,170	81,840	82,500	83,180	83,900	84,610	85,320	86,020	86,720	87,410	88,090	88,780	89,450	90,130	90,790	91,460	92,120	51	
52	80,870	81,590	82,300	83,000	83,690	84,380	85,060	85,780	86,520	87,260	88,000	88,730	89,460	90,180	90,890	91,600	92,310	93,010	93,710	94,400	95,090	52	
53	83,300	84,040	84,770	85,490	86,210	86,920	87,630	88,370	89,150	89,920	90,680	91,440	92,200	92,950	93,690	94,430	95,170	95,900	96,630	97,350	98,060	53	
54	85,720	86,480	87,240	87,990	88,730	89,460	90,190	90,960	91,770	92,570	93,370	94,160	94,940	95,720	96,500	97,260	98,030	98,790	99,540	100,300	101,000	54	
55	88,140	88,930	89,710	90,490	91,250	92,010	92,760	93,550	94,390	95,220	96,050	96,870	97,680	98,490	99,300	100,100	100,900	101,700	102,500	103,200	104,000	55	
56	90,780	91,600	92,410	93,200	93,990	94,770	95,550	96,370	97,230	98,090	98,930	99,780	100,600	101,400	102,300	103,100	103,900	104,700	105,500	106,300	107,100	56	
57	93,210	94,050	94,880	95,700	96,510	97,320	98,120	98,960	99,850	100,700	101,600	102,500	103,400	104,200	105,100	105,900	106,800	107,600	108,400	109,300	110,100	57	
58	95,150	96,100	97,040	97,980	98,910	99,830	100,700	101,700	102,700	103,700	104,700	105,700	106,700	107,700	108,700	109,600	110,600	111,600	112,500	113,500	114,400	58	
59	97,090	98,160	99,210	100,300	101,300	102,300	103,400	104,500	105,600	106,700	107,800	108,900	110,000	111,100	112,200	113,300	114,400	115,500	116,600	117,700	118,700	59	
60	99,040	100,200	101,400	102,500	103,700	104,900	106,000	107,200	108,500	109,700	110,900	112,100	113,400	114,600	115,800	117,000	118,200	119,500	120,700	121,900	123,100	60	
61	101,000	102,300	103,500	104,800	106,100	107,400	108,700	110,000	111,300	112,700	114,000	115,400	116,700	118,100	119,400	120,700	122,100	123,400	124,700	126,100	127,400	61	
62	102,900	104,300	105,700	107,100	108,500	109,900	111,300	112,700	114,200	115,600	117,100	118,600	120,100	121,500	123,000	124,400	125,900	127,300	128,800	130,300	131,700	62	
63	104,900	106,400	107,900	109,400	110,900	112,400	113,900	115,500	117,000	118,600	120,200	121,800	123,400	125,000	126,600	128,100	129,700	131,300	132,900	134,500	136,000	63	
64	106,800	108,400	110,000	111,700	113,300	114,900	116,6																

# GUNTERSVILLE DAM SPILLWAY DISCHARGE IN CUBIC FEET PER SECOND

GATE ARRANGE- MENT	HEADWATER ELEVATION																			GATE ARRANGE- MENT		
	590.0	590.2	590.4	590.6	590.8	591.0	591.2	591.4	591.6	591.8	592.0	592.2	592.4	592.6	592.8	593.0	593.2	593.4	593.6		593.8	594.0
71	122,700	124,900	127,100	129,400	131,600	133,900	136,200	138,500	140,800	143,200	145,500	147,900	150,200	152,600	155,000	157,300	159,700	162,100	164,500	166,800	169,200	71
72	124,600	126,900	129,300	131,700	134,000	136,400	138,800	141,200	143,700	146,100	148,600	151,100	153,600	156,100	158,600	161,000	163,500	166,000	168,500	171,000	173,600	72
73	129,000	131,400	133,900	136,400	138,900	141,500	144,000	146,600	149,200	151,800	154,400	157,000	159,700	162,300	165,000	167,600	170,200	172,900	175,500	178,200	180,900	73
74	133,300	135,900	138,600	141,200	143,900	146,500	149,200	151,900	154,700	157,400	160,200	163,000	165,700	168,600	171,300	174,100	176,900	179,700	182,500	185,300	188,200	74
75	135,300	138,000	140,700	143,500	146,300	149,000	151,900	154,700	157,500	160,400	163,300	166,200	169,100	172,000	174,900	177,800	180,700	183,600	186,600	189,500	192,500	75
76	137,500	140,000	142,500	145,000	147,600	150,200	152,700	155,300	158,000	160,600	163,300	166,000	168,700	171,400	174,100	176,800	179,500	182,200	185,000	187,800	190,600	76
77	143,600	146,100	148,700	151,300	153,900	156,600	159,200	161,800	164,500	167,200	169,900	172,700	175,400	178,100	180,900	183,600	186,300	189,100	191,800	194,600	197,300	77
78	145,500	148,200	150,900	153,600	156,300	159,100	161,800	164,600	167,400	170,200	173,000	175,900	178,700	181,600	184,500	187,300	190,100	193,000	195,900	198,800	201,700	78
79	151,700	154,400	157,100	159,900	162,700	165,500	168,300	171,100	174,000	176,800	179,700	182,600	185,500	188,500	191,400	194,300	197,200	200,100	203,000	206,000	208,900	79
80	153,600	156,400	159,300	162,200	165,100	168,000	170,900	173,900	176,800	179,800	182,800	185,800	188,900	191,900	195,000	198,000	201,000	204,000	207,100	210,200	213,200	80
81	155,800	158,400	161,100	163,700	166,400	169,100	171,800	174,500	177,300	180,000	182,800	185,600	188,500	191,400	194,300	197,200	200,100	203,000	206,000	209,000	212,000	81
82	161,900	164,600	167,300	170,000	172,700	175,500	178,200	181,000	183,800	186,700	189,500	192,300	195,200	198,100	201,000	203,900	206,800	209,700	212,600	215,500	218,400	82
83	163,800	166,600	169,500	172,300	175,100	178,000	180,900	183,800	186,700	189,600	192,600	195,500	198,500	201,500	204,500	207,400	210,400	213,400	216,400	219,400	222,400	83
84	171,900	174,900	177,900	180,900	183,900	186,900	189,900	193,000	196,100	199,200	202,400	205,500	208,700	211,800	215,000	218,100	221,300	224,400	227,600	230,800	234,000	84
85	174,100	176,800	179,600	182,400	185,200	188,000	190,900	193,700	196,600	199,500	202,400	205,300	208,200	211,100	214,000	216,900	219,800	222,700	225,600	228,500	231,400	85
86	182,200	185,100	188,000	191,000	194,000	196,900	199,900	203,000	206,000	209,100	212,100	215,200	218,300	221,400	224,500	227,600	230,700	233,800	236,900	240,000	243,200	86
87	190,200	193,300	196,400	199,600	202,700	205,900	209,000	212,200	215,400	218,700	221,900	225,200	228,500	231,700	235,000	238,300	241,500	244,800	248,100	251,400	254,800	87
88	192,400	195,300	198,200	201,100	204,000	207,000	209,900	212,900	215,900	218,900	221,900	224,900	227,900	230,900	233,900	236,900	239,900	242,900	245,900	248,900	251,900	88
89	200,500	203,500	206,600	209,700	212,800	215,900	219,000	222,100	225,300	228,500	231,700	234,900	238,100	241,300	244,500	247,700	251,000	254,200	257,400	260,700	263,900	89
90	208,500	211,800	215,000	218,200	221,500	224,800	228,100	231,400	234,700	238,100	241,500	244,800	248,200	251,700	255,000	258,400	261,800	265,200	268,600	272,100	275,500	90
92	218,800	222,000	225,200	228,400	231,600	234,800	238,100	241,300	244,600	247,900	251,200	254,600	257,900	261,200	264,600	267,900	271,200	274,600	277,900	281,300	284,700	92
93	226,900	230,200	233,600	236,900	240,300	243,700	247,200	250,600	254,100	257,500	261,000	264,500	268,000	271,600	275,100	278,600	282,100	285,600	289,200	292,700	296,300	93
95	239,500	242,800	246,100	249,400	252,700	256,100	259,400	262,800	266,200	269,600	273,000	276,500	279,900	283,400	286,800	290,200	293,700	297,100	300,600	304,100	307,500	95
96	247,500	251,000	254,500	258,000	261,500	265,000	268,500	272,100	275,600	279,200	282,800	286,400	290,100	293,700	297,300	300,900	304,500	308,200	311,800	315,400	319,100	96
98	260,100	263,500	267,000	270,400	273,900	277,300	280,800	284,300	287,800	291,300	294,800	298,400	301,900	305,500	309,000	312,600	316,100	319,700	323,200	326,800	330,400	98
99	268,200	271,800	275,400	279,000	282,600	286,200	289,900	293,600	297,200	300,900	304,600	308,300	312,100	315,800	319,500	323,200	327,000	330,700	334,400	338,200	342,000	99
101	280,800	284,300	287,900	291,400	295,000	298,600	302,200	305,800	309,400	313,000	316,600	320,300	323,900	327,600	331,300	334,900	338,500	342,200	345,900	349,500	353,200	101
102	288,900	292,600	296,300	300,000	303,700	307,500	311,300	315,000	318,800	322,600	326,400	330,300	334,100	337,900	341,800	345,600	349,400	353,200	357,100	360,900	364,800	102
104	301,500	305,100	308,800	312,500	316,100	319,800	323,500	327,200	331,000	334,700	338,500	342,200	346,000	349,700	353,500	357,200	361,000	364,700	368,500	372,300	376,100	104
105	309,500	313,400	317,200	321,000	324,900	328,700	332,600	336,500	340,400	344,300	348,200	352,200	356,100	360,000	364,000	367,900	371,800	375,800	379,700	383,700	387,600	105
106	314,800	318,600	322,300	326,000	329,800	333,500	337,300	341,100	344,900	348,600	352,400	356,200	360,100	363,900	367,700	371,500	375,300	379,100	382,900	386,800	390,600	106
107	331,000	335,000	339,100	343,200	347,300	351,400	355,500	359,600	363,700	367,900	372,000	376,200	380,300	384,500	388,700	392,800	397,000	401,200	405,400	409,600	413,800	107
108	342,400	346,400	350,400	354,500	358,500	362,500	366,600	370,700	374,700	378,800	382,900	387,000	391,100	395,200	399,300	403,400	407,500	411,600	415,700	419,900	424,000	108
109	350,500	354,600	358,800	363,000	367,200	371,500	375,700	379,900	384,200	388,400	392,700	397,000	401,200	405,500	409,800	414,100	418,400	422,700	427,000	431,300	435,600	109
110	361,900	366,000	370,200	374,300	378,500	382,600	386,800	391,000	395,200	399,400	403,600	407,800	412,000	416,200	420,400	424,700	428,900	433,100	437,300	441,600	445,900	110
111	370,000	374,300	378,600	382,900	387,200	391,500	395,900	400,300	404,600	409,000	413,400	417,800	422,200	426,600	430,900	435,300	439,700	444,100				111
112	380,300	384,500	388,700	393,000	397,200	401,500	405,700	410,000	414,300	418,600	422,900	427,100	431,400	435,700	440,000	444,300						112
113	397,500	402,100	406,700	411,300	415,900	420,600	425,200	429,800	434,500	439,200	443,800											113
114	409,000	413,500	418,000	422,600	427,200	431,700	436,300	440,900														114
115	417,000	421,700	426,400	431,200	435,900	440,700	445,400															115
116	427,400	432,000	436,600	441,300																		116
117	436,500	441,300																				117

HEADWATER 590 to 594  
TAILWATER 576.51 to 577.50

MARCH 2004

# GUNTERSVILLE DAM SPILLWAY DISCHARGE IN CUBIC FEET PER SECOND

GATE HEIGHT FEET	HEADWATER ELEVATION																				GATE HEIGHT FEET	
	594.0	594.2	594.4	594.6	594.8	595.0	595.2	595.4	595.6	595.8	596.0	596.2	596.4	596.6	596.8	597.0	597.2	597.4	597.6	597.8		598.0
10																						10
12																	21, 610	22, 370	23, 160	23, 980	22, 390	12
14																24, 250	24, 970	25, 710	26, 490	24, 840	14	
16	21, 790	21, 910	22, 040	22, 160	22, 280	22, 400	22, 530	22, 650	22, 850	23, 180	23, 570	24, 030	21, 750	22, 310	22, 920	23, 570	24, 250	24, 970	25, 710	26, 490	27, 300	16
17	22, 810	22, 940	23, 070	23, 200	23, 330	23, 460	23, 580	23, 710	23, 910	24, 220			24, 520	25, 060	25, 640	26, 250	26, 890	27, 570	28, 270	29, 000	29, 750	17
18	24, 510	24, 650	24, 790	24, 930	25, 070	25, 210	25, 340	25, 480	25, 690	26, 010	26, 390	26, 820	27, 300	27, 810	28, 350	28, 930	29, 530	30, 160	30, 820	31, 500	32, 210	18
19	25, 540	25, 680	25, 830	25, 970	26, 120	26, 260	26, 400	26, 540	26, 750	27, 050			27, 500	28, 000	28, 520	29, 060	29, 620	30, 200	30, 800	31, 410	32, 040	19
20	27, 240	27, 390	27, 550	27, 700	27, 850	28, 010	28, 160	28, 310	28, 530	28, 840	29, 210	29, 620	30, 070	30, 560	31, 070	31, 610	32, 170	32, 760	33, 380	34, 010	34, 660	20
21	28, 790	28, 960	29, 120	29, 290	29, 450	29, 610	29, 780	29, 940	30, 170	30, 490	30, 870	31, 290	31, 750	32, 250	32, 770	33, 320	33, 890	34, 490	35, 110	35, 760	36, 420	21
22	30, 350	30, 520	30, 700	30, 880	31, 050	31, 220	31, 400	31, 570	31, 810	32, 140	32, 530	32, 960	33, 430	33, 940	34, 470	35, 030	35, 610	36, 220	36, 850	37, 510	38, 180	22
23	31, 900	32, 090	32, 280	32, 460	32, 650	32, 830	33, 010	33, 200	33, 450	33, 790	34, 190	34, 630	35, 110	35, 630	36, 170	36, 740	37, 330	37, 950	38, 590	39, 260	39, 940	23
24	33, 460	33, 660	33, 860	34, 050	34, 250	34, 440	34, 630	34, 830	35, 090	35, 440	35, 850	36, 310	36, 800	37, 320	37, 870	38, 450	39, 050	39, 680	40, 330	41, 010	41, 700	24
25	35, 010	35, 220	35, 430	35, 640	35, 850	36, 050	36, 250	36, 450	36, 730	37, 090	37, 510	37, 980	38, 480	39, 010	39, 570	40, 160	40, 770	41, 410	42, 070	42, 760	43, 460	25
26	36, 570	36, 790	37, 010	37, 230	37, 440	37, 660	37, 870	38, 080	38, 370	38, 740	39, 170	39, 650	40, 160	40, 700	41, 270	41, 870	42, 490	43, 140	43, 810	44, 500	45, 220	26
27	38, 130	38, 360	38, 590	38, 820	39, 040	39, 270	39, 490	39, 710	40, 010	40, 390	40, 830	41, 320	41, 840	42, 390	42, 970	43, 580	44, 210	44, 870	45, 550	46, 250	46, 970	27
28	39, 680	39, 920	40, 160	40, 400	40, 640	40, 880	41, 110	41, 340	41, 650	42, 040	42, 490	42, 990	43, 520	44, 080	44, 670	45, 290	45, 930	46, 600	47, 290	48, 000	48, 730	28
29	41, 240	41, 490	41, 740	41, 990	42, 240	42, 490	42, 730	42, 970	43, 290	43, 690	44, 150	44, 660	45, 200	45, 770	46, 370	47, 000	47, 650	48, 330	49, 030	49, 750	50, 490	29
30	42, 260	42, 520	42, 780	43, 030	43, 290	43, 540	43, 790	44, 040	44, 350	44, 740												30
31	43, 960	44, 230	44, 500	44, 760	45, 020	45, 290	45, 550	45, 800	46, 120	46, 520	46, 970	47, 460	47, 970	48, 520	49, 090	49, 680	50, 300	50, 930	51, 590	52, 260	52, 950	31
32	45, 520	45, 800	46, 070	46, 350	46, 620	46, 900	47, 170	47, 430	47, 760	48, 170	48, 630	49, 130	49, 650	50, 210	50, 790	51, 390	52, 020	52, 660	53, 320	54, 010	54, 710	32
33	46, 540	46, 830	47, 110	47, 390	47, 670	47, 950	48, 220	48, 500	48, 820	49, 220												33
34	48, 240	48, 540	48, 830	49, 120	49, 410	49, 700	49, 980	50, 260	50, 600	51, 000	51, 450	51, 930	52, 430	52, 960	53, 500	54, 070	54, 660	55, 260	55, 880	56, 510	57, 160	34
35	49, 800	50, 100	50, 410	50, 710	51, 010	51, 300	51, 600	51, 890	52, 240	52, 650	53, 110	53, 600	54, 110	54, 650	55, 200	55, 780	56, 380	56, 990	57, 620	58, 260	58, 920	35
36	50, 820	51, 130	51, 440	51, 750	52, 050	52, 360	52, 660	52, 960	53, 300	53, 700												36
37	52, 520	52, 840	53, 160	53, 480	53, 790	54, 110	54, 420	54, 720	55, 080	55, 480	55, 930	56, 390	56, 880	57, 390	57, 920	58, 460	59, 020	59, 590	60, 170	60, 770	61, 380	37
38	54, 080	54, 410	54, 740	55, 070	55, 390	55, 710	56, 040	56, 360	56, 720	57, 130	57, 590	58, 070	58, 560	59, 080	59, 620	60, 170	60, 740	61, 320	61, 910	62, 520	63, 130	38

# GUNTERSVILLE DAM SPILLWAY DISCHARGE IN CUBIC FEET PER SECOND

DATE ELEMENT	HEADWATER ELEVATION																			DATE ELEMENT		
	594.0	594.2	594.4	594.6	594.8	595.0	595.2	595.4	595.6	595.8	596.0	596.2	596.4	596.6	596.8	597.0	597.2	597.4	597.6		597.8	598.0
68	156,300	158,300	160,300	162,400	164,400	166,500	168,500	170,600	172,600	174,700	176,800	178,900	181,000	183,200	185,300	187,500	189,600	191,800	193,900	196,100	198,300	68
69	160,600	162,700	164,900	167,100	169,200	171,400	173,600	175,800	178,000	180,200	182,500	184,700	187,000	189,200	191,500	193,800	196,100	198,400	200,700	203,100	205,400	69
70	164,900	167,200	169,500	171,800	174,100	176,400	178,700	181,100	183,400	185,800	188,100	190,500	192,900	195,300	197,700	200,200	202,600	205,100	207,500	210,000	212,500	70
71	169,200	171,700	174,100	176,500	178,900	181,400	183,800	186,300	188,800	191,300	193,800	196,300	198,800	201,400	204,000	206,500	209,100	211,700	214,300	217,000	219,600	71
72	173,600	176,100	178,700	181,200	183,800	186,400	189,000	191,500	194,200	196,800	199,400	202,100	204,800	207,500	210,200	212,900	215,600	218,400	221,100	223,900	226,700	72
73	180,900	183,600	186,300	189,000	191,700	194,400	197,200	200,000	202,700	205,500	208,300	211,200	214,000	216,900	219,800	222,600	225,500	228,500	231,400	234,300	237,300	73
74	188,200	191,000	193,900	196,800	199,600	202,500	205,400	208,400	211,300	214,300	217,300	220,200	223,300	226,300	229,300	232,400	235,500	238,500	241,600	244,800	247,900	74
75	192,500	195,500	198,500	201,500	204,500	207,500	210,600	213,600	216,700	219,800	222,900	226,000	229,200	232,400	235,500	238,700	242,000	245,200	248,400	251,700	255,000	75
77	197,300	200,100	202,900	205,700	208,600	211,400	214,200	217,100	220,000	222,900	225,800	228,800	231,700	234,700	237,700	240,800	243,800	246,900	250,000	253,000	256,000	77
78	201,700	204,600	207,500	210,400	213,400	216,400	219,300	222,300	225,300	228,400	231,500	234,600	237,700	240,800	244,000	247,100	250,300	253,500	256,700	260,000	263,200	78
79	208,900	211,900	214,900	217,900	220,900	223,900	226,900	230,000	233,000	236,100	239,200	242,300	245,400	248,600	251,700	254,900	258,100	261,300	264,500	267,700	271,000	79
80	213,200	216,300	219,500	222,600	225,700	228,900	232,000	235,200	238,400	241,600	244,800	248,100	251,400	254,600	257,900	261,300	264,600	267,900	271,300	274,700	278,100	80
82	218,100	221,000	223,900	226,800	229,800	232,700	235,700	238,700	241,700	244,700	247,700	250,800	253,900	257,000	260,100	263,300	266,400	269,600	272,800	276,000	279,300	82
83	222,400	225,500	228,500	231,600	234,600	237,700	240,800	243,900	247,000	250,200	253,400	256,600	259,800	263,100	266,400	269,600	272,900	276,300	279,600	283,000	286,300	83
84	234,000	237,200	240,400	243,700	246,900	250,200	253,500	256,800	260,100	263,400	266,800	270,100	273,500	276,900	280,300	283,800	287,200	290,700	294,200	297,700	301,200	84
86	243,200	246,300	249,500	252,700	255,900	259,100	262,300	265,500	268,700	272,000	275,300	278,700	282,000	285,400	288,800	292,200	295,600	299,000	302,500	306,000	309,400	86
87	254,800	258,100	261,400	264,800	268,200	271,600	275,000	278,400	281,800	285,200	288,700	292,200	295,700	299,200	302,700	306,300	309,900	313,400	317,000	320,600	324,300	87
89	263,900	267,200	270,500	273,800	277,100	280,400	283,700	287,100	290,400	293,800	297,300	300,700	304,200	307,700	311,200	314,700	318,200	321,800	325,300	328,900	332,500	89
90	275,500	279,000	282,400	285,900	289,400	292,900	296,400	299,900	303,500	307,100	310,600	314,200	317,900	321,500	325,100	328,800	332,500	336,200	339,900	343,600	347,400	90
92	284,700	288,100	291,500	294,900	298,300	301,800	305,200	308,700	312,100	315,500	319,200	322,800	326,300	329,900	333,600	337,200	340,800	344,500	348,200	351,900	355,600	92
93	296,300	299,800	303,400	307,000	310,600	314,300	317,900	321,500	325,200	328,900	332,600	336,300	340,000	343,800	347,500	351,300	355,100	358,900	362,800	366,600	370,500	93
95	307,500	311,000	314,500	318,000	321,600	325,100	328,600	332,200	335,700	339,300	343,000	346,600	350,300	354,000	357,700	361,400	365,100	368,900	372,700	376,400	380,300	95
96	319,100	322,800	326,500	330,200	333,900	337,600	341,300	345,000	348,800	352,600	356,400	360,200	364,000	367,800	371,700	375,500	379,400	383,300	387,200	391,100	395,100	96
98	330,400	334,000	337,600	341,200	344,800	348,400	352,000	355,700	359,300	363,000	366,800	370,500	374,200	378,000	381,800	385,600	389,400	393,300	397,100	401,000	404,900	98
99	342,000	345,700	349,500	353,300	357,100	360,900	364,700	368,600	372,400	376,300	380,100	384,000	387,900	391,900	395,800	399,700	403,700	407,700	411,700	415,700	419,700	99
101	353,200	356,900	360,600	364,300	368,000	371,700	375,500	379,200	382,900	386,700	390,500	394,400	398,200	402,100	405,900	409,800	413,700	417,600	421,600	425,500	429,500	101
102	364,800	368,700	372,500	376,400	380,300	384,200	388,100	392,100	396,000	399,900	403,900	407,900	411,900	415,900	419,900	424,000	428,000	432,100	436,100	440,200	444,300	102
104	376,100	379,900	383,600	387,400	391,200	395,100	398,900	402,700	406,500	410,400	414,300	418,200	422,100	426,100	430,100	434,000	438,000	442,000				104
105	387,600	391,600	395,600	399,600	403,600	407,600	411,600	415,600	419,600	423,600	427,700	431,800	435,800	439,900	444,000							105
106	390,600	394,500	398,300	402,200	406,000	409,900	413,700	417,600	421,500	425,500	429,400	433,400	437,400	441,500	445,500							106
107	413,800	418,000	422,200	426,400	430,600	434,900	439,100	443,400														107
108	424,000	428,100	432,300	436,400	440,600	444,700																108
109	435,600	439,900	444,200																			109

HEADWATER 594 to 598  
TAILWATER 576.51 to 577.50

MARCH 2004

GÜNTERSVILLE DAM  
**SPILLWAY DISCHARGE**  
 IN CUBIC FEET PER SECOND

GATE ARRANGEMENT	HEADWATER ELEVATION																				GATE ARRANGEMENT	
	598.0	598.2	598.4	598.6	598.8	599.0	599.2	599.4	599.6	599.8	600.0	600.2	600.4	600.6	600.8	601.0	601.2	601.4	601.6	601.8		602.0
0*																						0*
2									21,610	23,070	22,470	24,030										2
4									23,770	25,210	24,580	26,120										4
6									25,930	27,340	26,680	28,200										6
8			21,950	23,050	24,230	23,240	25,460	24,560	26,750	28,090	27,340	28,790	30,280									8
10	22,390	23,330	24,300	25,350	26,480	27,680	28,940	30,250	31,600	33,000	34,450											10
12	24,840	25,730	26,650	27,640	28,740	29,910	31,130	32,410	33,740	35,110	36,530											12
14	27,300	28,130	28,990	29,940	31,000	32,130	33,320	34,570	35,870	37,220	38,610											14
16	29,750	30,530	31,340	32,240	33,250	34,350	35,510	36,730	38,000	39,320	40,700											16
18	32,210	32,940	33,680	34,530	35,510	36,570	37,700	38,890	40,130	41,430	42,780											18
20	34,660	35,340	36,030	36,830	37,770	38,790	39,890	41,050	42,270	43,540	44,860											20
21	36,420	37,110	37,810	38,610	39,530	40,540	41,610	42,740	43,930	45,160	46,450											21
22	38,180	38,870	39,590	40,390	41,300	42,290	43,340	44,440	45,590	46,790	48,030											22
23	39,940	40,640	41,360	42,160	43,070	44,040	45,060	46,130	47,250	48,410	49,610											23
24	41,700	42,410	43,140	43,940	44,830	45,790	46,790	47,830	48,920	50,040	51,200											24
25	43,460	44,180	44,920	45,720	46,600	47,530	48,510	49,530	50,580	51,670	52,780											25
26	45,220	45,950	46,700	47,500	48,370	49,280	50,230	51,220	52,240	53,290	54,370											26
27	46,970	47,720	48,470	49,280	50,140	51,030	51,960	52,920	53,900	54,920	55,950											27
28	48,730	49,480	50,250	51,060	51,900	52,780	53,680	54,610	55,570	56,540	57,540											28
29	50,490	51,250	52,030	52,840	53,670	54,530	55,410	56,310	57,230	58,170	59,120											29
31	52,950	53,650	54,380	55,130	55,930	56,750	57,600	58,470	59,360	60,270	61,210											31
32	54,710	55,420	56,150	56,910	57,690	58,500	59,320	60,160	61,020	61,900	62,790											32
34	57,160	57,820	58,500	59,210	59,950	60,720	61,510	62,320	63,160	64,010	64,870											34
35	58,920	59,590	60,280	60,990	61,720	62,470	63,240	64,020	64,820	65,630	66,460											35
37	61,380	61,990	62,620	63,280	63,970	64,690	65,420	66,180	66,950	67,740	68,540											37
38	63,130	63,760	64,400	65,060	65,740	66,440	67,150	67,870	68,610	69,360	70,130											38
39	65,590	66,170	66,750	67,360	68,000	68,660	69,340	70,030	70,750	71,470	72,210											39
40	68,050	68,570	69,090	69,650	70,250	70,880	71,530	72,190	72,880	73,580	74,290											40
41	69,800	70,340	70,870	71,430	72,020	72,630	73,250	73,890	74,540	75,200	75,880											41
42	73,320	73,880	74,440	75,030	75,640	76,280	76,920	77,590	78,260	78,950	79,650											42
43	76,840	77,420	78,010	78,620	79,260	79,920	80,600	81,290	81,990	82,700	83,430											43
44	80,360	80,970	81,580	82,220	82,880	83,570	84,270	84,980	85,710	86,450	87,200											44
45	83,870	84,510	85,150	85,810	86,510	87,220	87,940	88,680	89,440	90,200	90,980											45
46	87,390	88,050	88,720	89,410	90,130	90,860	91,620	92,380	93,160	93,950	94,750											46
47	90,910	91,600	92,290	93,000	93,750	94,510	95,290	96,080	96,880	97,700	98,530											47
48	94,420	95,140	95,860	96,600	97,370	98,160	98,960	99,780	100,600	101,400	102,300											48
49	97,940	98,680	99,430	100,200	101,000	101,800	102,600	103,500	104,300	105,200	106,100											49
50	102,200	102,900	103,600	104,300	105,000	105,800	106,500	107,300	108,100	108,900	109,700											50
51	105,700	106,400	107,100	107,900	108,600	109,400	110,200	111,000	111,900	112,700	113,500											51
52	109,200	109,900	110,700	111,500	112,300	113,100	113,900	114,700	115,600	116,400	117,300											52
53	112,700	113,500	114,300	115,100	115,900	116,700	117,600	118,400	119,300	120,200	121,100											53
54	116,200	117,000	117,800	118,700	119,500	120,400	121,200	122,100	123,000	123,900	124,800											54
55	119,700	120,600	121,400	122,200	123,100	124,000	124,900	125,800	126,700	127,700	128,600											55
56	123,300	124,100	125,000	125,800	126,700	127,500	128,400	129,200	130,100	130,900	131,800											56
57	126,800	127,600	128,500	129,400	130,300	131,200	132,000	132,900	133,800	134,700	135,600											57
58	133,900	134,900	135,900	136,900	138,000	139,000	140,000	141,100	142,100	143,200	144,200											58
59	141,000	142,100	143,300	144,500	145,700	146,800	148,000	149,200	150,400	151,600	152,800											59
60	148,000	149,400	150,700	152,000	153,400	154,700	156,000	157,400	158,800	160,100	161,500											60
61	155,100	156,600	158,100	159,600	161,000	162,500	164,100	165,600	167,100	168,600	170,100											61
62	162,200	163,800	165,500	167,100	168,700	170,400	172,100	173,700	175,400	177,100	178,800											62
63	169,300	171,100	172,900	174,600	176,400	178,200	180,100	181,900	183,700	185,600	187,400											63
64	176,400	178,300	180,200	182,000	184,100	186,100	188,100	190,100	192,100	194,100	196,100											64
65	183,500	185,600	187,600	189,700	191,800	193,900	196,100	198,200	200,400	202,500	204,700											65
66	187,700	189,700	191,800	193,800	195,800	197,900	200,000	202,100	204,200	206,300	208,400											66
67	191,200	193,300	195,300	197,400	199,500	201,600	203,700	205,800	207,900	210,000	212,200											67

MARCH 2004

\* Arrangement "0" indicates that all spillway gates are closed.  
 Discharge is spillway gate and trash gate overflow.

HEADWATER 598 to 602  
 TAILWATER 576.51 to 577.50

## GUNTERSVILLE DAM SPILLWAY DISCHARGE IN CUBIC FEET PER SECOND

GUAGE-MENT	HEADWATER ELEVATION																				GUAGE-MENT	
	598.0	598.2	598.4	598.6	598.8	599.0	599.2	599.4	599.6	599.8	600.0	600.2	600.4	600.6	600.8	601.0	601.2	601.4	601.6	601.8		602.0
68	198,300	200,500	202,700	204,900	207,100	209,400	211,700	213,900	216,200	218,500	220,800											68
69	205,400	207,700	210,100	212,500	214,800	217,300	219,700	222,100	224,500	227,000	229,400											69
70	212,500	215,000	217,500	220,000	222,500	225,100	227,700	230,300	232,900	235,500	238,100											70
71	219,600	222,200	224,900	227,500	230,200	232,900	235,700	238,400	241,200	243,900	246,700											71
72	226,700	229,500	232,300	235,100	237,900	240,800	243,700	246,600	249,500	252,400	255,400											72
73	237,300	240,200	243,200	246,200	249,200	252,300	255,400	258,500	261,500	264,700	267,800											73
74	247,900	251,000	254,200	257,300	260,500	263,800	267,000	270,300	273,600	276,900	280,200											74
75	255,000	258,300	261,600	264,900	268,200	271,600	275,000	278,500	281,900	285,400	288,800											75
77	256,200	259,300	262,400	265,600	268,800	272,000	275,200	278,500														77
78	263,200	266,500	269,800	273,100	276,500	279,800	283,200	286,700	290,100	293,500	297,000											78
79	271,000	274,200	277,500	280,800	284,100	287,500	290,800	294,200	297,600	301,000	304,500											79
80	278,100	281,500	284,900	288,300	291,800	295,300	298,800	302,400	305,900	309,500	313,100											80
82	279,300	282,500	285,800	289,000	292,300	295,700	299,000	302,400														82
83	286,300	289,700	293,100	296,600	300,000	303,500	307,000	310,600	314,100	317,700	321,300											83
84	301,200	304,700	308,200	311,800	315,400	319,000	322,600	326,300	330,000	333,600	337,300											84
86	309,400	312,900	316,500	320,000	323,600	327,200	330,800	334,500	338,100	341,800	345,500											86
87	324,300	327,900	331,600	335,200	338,900	342,700	346,400	350,200	354,000	357,800	361,600											87
89	332,500	336,200	339,800	343,500	347,100	350,900	354,600	358,400	362,200	366,000	369,800											89
90	347,400	351,100	354,900	358,700	362,500	366,300	370,200	374,100	378,000	381,900	385,900											90
92	355,600	359,400	363,100	366,900	370,700	374,500	378,400	382,300	386,200	390,100	394,000											92
93	370,500	374,300	378,200	382,100	386,000	390,000	394,000	398,000	402,000	406,100	410,100											93
95	380,300	384,100	387,900	391,800	395,600	399,500	403,500	407,400	411,400	415,400	419,400											95
96	395,100	399,000	403,000	407,000	411,000	415,000	419,100	423,100	427,200	431,300	435,500											96
98	404,900	408,800	412,700	416,600	420,600	424,600	428,600	432,600	436,600	440,700	444,700											98
99	419,700	423,700	427,800	431,800	435,900	440,000	444,100															99
101	429,500	433,500	437,500	441,500	445,500																	101
102	444,300																					102

HEADWATER 598 to 602  
TAILWATER 576.51 to 577.50

MARCH 2004

## GUNTERSVILLE DAM SPILLWAY DISCHARGE IN CUBIC FEET PER SECOND

GAGE- HEIGHT	HEADWATER ELEVATION																		GAGE- HEIGHT			
	590.0	590.2	590.4	590.6	590.8	591.0	591.2	591.4	591.6	591.8	592.0	592.2	592.4	592.6	592.8	593.0	593.2	593.4		593.6	593.8	594.0
27															35,950	36,190	36,440	36,680	36,920	37,160	37,400	27
28					36,050	36,340	36,630	36,920	37,200	37,480	37,770	38,040	38,320	38,590	38,860	39,130	39,400	39,670	39,930	40,190	40,450	28
29			36,040	36,340	36,640	36,940	37,240	37,540	37,830	38,120	38,410	38,700	38,990	39,270	39,550	39,830	40,100	40,380	40,650	40,920	41,190	29
30	37,190	37,510	37,820	38,130	38,450	38,760	39,060	39,370	39,670	39,970	40,270	40,570	40,860	41,150	41,440	41,720	42,010	42,290	42,570	42,850	43,120	30
31																						31
32	38,480	38,810	39,140	39,460	39,790	40,110	40,430	40,750	41,060	41,370	41,680	41,990	42,290	42,600	42,900	43,200	43,490	43,780	44,080	44,360	44,650	32
33	39,350	39,680	40,020	40,350	40,680	41,010	41,340	41,660	41,980	42,300	42,620	42,930	43,240	43,550	43,860	44,160	44,470	44,770	45,060	45,360	45,650	33
34	40,810	41,150	41,500	41,840	42,190	42,530	42,860	43,200	43,530	43,860	44,190	44,510	44,830	45,150	45,470	45,780	46,100	46,410	46,710	47,020	47,320	34
35	42,100	42,460	42,810	43,170	43,530	43,880	44,230	44,580	44,920	45,260	45,600	45,940	46,270	46,600	46,930	47,260	47,580	47,900	48,220	48,540	48,850	35
36	42,960	43,330	43,690	44,060	44,420	44,780	45,140	45,490	45,840	46,190	46,540	46,880	47,220	47,560	47,890	48,220	48,550	48,880	49,210	49,530	49,850	36
37	44,420	44,800	45,170	45,550	45,920	46,300	46,660	47,030	47,390	47,750	48,110	48,460	48,810	49,160	49,500	49,850	50,190	50,520	50,860	51,190	51,520	37
38	45,710	46,100	46,490	46,880	47,270	47,650	48,030	48,410	48,780	49,150	49,520	49,880	50,250	50,610	50,960	51,320	51,670	52,020	52,360	52,710	53,050	38
39	48,040	48,450	48,850	49,260	49,660	50,070	50,460	50,860	51,250	51,640	52,020	52,410	52,790	53,160	53,540	53,910	54,270	54,640	55,000	55,360	55,720	39
40	50,360	50,790	51,210	51,640	52,060	52,480	52,900	53,310	53,720	54,130	54,530	54,930	55,320	55,720	56,110	56,500	56,880	57,260	57,640	58,020	58,390	40
41	51,650	52,090	52,530	52,970	53,400	53,830	54,260	54,690	55,110	55,530	55,940	56,350	56,760	57,170	57,570	57,970	58,360	58,760	59,150	59,530	59,920	41
42	54,060	54,530	54,990	55,450	55,910	56,370	56,820	57,270	57,720	58,170	58,610	59,050	59,490	59,920	60,350	60,780	61,200	61,630	62,040	62,460	62,870	42
43	56,470	56,960	57,450	57,940	58,420	58,900	59,370	59,850	60,330	60,810	61,280	61,750	62,220	62,680	63,140	63,590	64,050	64,500	64,940	65,390	65,830	43
44	58,880	59,400	59,910	60,420	60,930	61,430	61,920	62,430	62,940	63,440	63,950	64,450	64,940	65,430	65,920	66,410	66,890	67,370	67,840	68,310	68,780	44
45	61,290	61,830	62,370	62,900	63,430	63,960	64,480	65,010	65,550	66,080	66,620	67,150	67,670	68,190	68,710	69,220	69,730	70,240	70,740	71,240	71,740	45
46	63,700	64,270	64,830	65,390	65,940	66,490	67,030	67,590	68,160	68,720	69,290	69,840	70,400	70,950	71,500	72,030	72,570	73,110	73,640	74,170	74,690	46
47	66,110	66,710	67,290	67,870	68,450	69,020	69,580	70,170	70,770	71,360	71,950	72,540	73,120	73,700	74,280	74,850	75,420	75,980	76,540	77,090	77,650	47
48	68,520	69,140	69,750	70,360	70,960	71,550	72,140	72,750	73,380	74,000	74,620	75,240	75,850	76,460	77,060	77,660	78,260	78,850	79,440	80,020	80,600	48
49	70,930	71,580	72,210	72,840	73,460	74,080	74,690	75,330	75,990	76,640	77,290	77,940	78,580	79,220	79,850	80,480	81,100	81,720	82,340	82,950	83,550	49
50	74,550	75,220	75,890	76,550	77,200	77,850	78,490	79,160	79,850	80,530	81,210	81,880	82,550	83,220	83,880	84,540	85,190	85,840	86,480	87,120	87,750	50
51	76,960	77,660	78,350	79,030	79,710	80,380	81,040	81,740	82,460	83,170	83,880	84,580	85,280	85,980	86,670	87,350	88,030	88,710	89,380	90,040	90,710	51
52	79,370	80,090	80,810	81,520	82,220	82,910	83,600	84,320	85,070	85,810	86,550	87,280	88,010	88,730	89,450	90,160	90,870	91,580	92,280	92,970	93,660	52
53	81,780	82,530	83,270	84,000	84,730	85,440	86,160	86,900	87,670	88,450	89,220	89,980	90,740	91,490	92,240	92,980	93,720	94,450	95,180	95,900	96,620	53
54	84,190	84,960	85,730	86,480	87,230	87,970	88,710	89,480	90,280	91,090	91,890	92,680	93,460	94,250	95,020	95,790	96,560	97,320	98,070	98,830	99,570	54
55	86,600	87,400	88,190	88,970	89,740	90,500	91,260	92,060	92,890	93,730	94,550	95,380	96,190	97,000	97,810	98,610	99,400	100,200	101,000	101,800	102,500	55
56	89,180	90,010	90,820	91,620	92,420	93,210	93,990	94,810	95,670	96,530	97,380	98,230	99,060	99,900	100,740	101,500	102,400	103,200	104,000	104,800	105,600	56
57	91,590	92,440	93,280	94,110	94,930	95,740	96,540	97,390	98,280	99,170	100,000	100,900	101,800	102,700	103,500	104,400	105,200	106,000	106,900	107,700	108,500	57
58	93,520	94,470	95,420	96,370	97,300	98,230	99,150	100,100	101,100	102,100	103,100	104,100	105,100	106,100	107,100	108,000	109,000	110,000	111,000	112,000	113,000	58
59	95,440	96,510	97,570	98,620	99,670	100,700	101,800	102,800	104,000	105,100	106,200	107,300	108,400	109,500	110,600	111,700	112,800	113,900	115,000	116,000	117,100	59
60	97,360	98,540	99,710	100,900	102,000	103,200	104,400	105,600	106,800	108,000	109,300	110,500	111,700	112,900	114,200	115,400	116,600	117,800	119,000	120,200	121,400	60
61	99,280	100,600	101,900	103,100	104,400	105,700	107,000	108,300	109,600	111,000	112,300	113,700	115,000	116,400	117,700	119,000	120,400	121,700	123,000	124,400	125,700	61
62	101,200	102,600	104,000	105,400	106,800	108,200	109,600	111,000	112,500	113,900	115,400	116,900	118,300	119,800	121,300	122,700	124,200	125,600	127,100	128,500	130,000	62
63	103,100	104,600	106,100	107,700	109,200	110,700	112,200	113,700	115,300	116,900	118,500	120,100	121,600	123,200	124,800	126,400	128,000	129,500	131,100	132,700	134,300	63
64	105,100	106,700	108,300	109,900	111,500	113,200	114,800	116,500	118,100	119,800	121,500	123,300	125,000	126,700	128,400	130,100	131,800	133,500	135,200	136,900	138,600	64
65	107,000	108,700	110,400	112,200	113,900	115,700	117,400	119,200	121,000	122,800	124,600	126,400	128,300	130,100	131,900	133,700	135,500	137,400	139,200	141,000	142,900	65
66	110,600	112,300	114,100	115,900	117,600	119,400	121,200	123,000	124,800	126,700	128,500	130,400	132,200	134,100	136,000	137,800	139,600	141,500	143,300	145,200	147,100	66
67	113,000	114,800	116,600	118,400	120,200	122,000	123,800	125,600	127,500	129,300	131,200	133,100	135,000	136,900	138,700	140,600	142,500	144,400	146,200	148,100	150,000	67
68	114,900	116,800	118,700	120,600	122,500	124,400	126,400	128,300	130,300	132,300	134,300	136,300	138,300	140,300	142,300	144,300	146,300	148,300	150,300	152,300	154,300	68
69	116,800	118,800	120,900	122,900	124,900	126,900	129,000	131,000	133,100	135,200	137,300	139,500	141,600	143,700	145,800	147,900	150,100	152,200	154,300	156,400	158,600	69
70	118,800	120,900	123,000	125,100	127,300	129,400	131,600	133,800	136,000	138,200	140,400	142,700	144,900	147,200	149,400	151,600	153,900	156,100	158,300	160,600	162,900	70
71	120,700	122,900	125,100	127,400	129,600	131,900	134,200	136,500	138,800	141,100	143,500	145,800	148,200	150,600	152,900	155,300	157,600	160,000	162,400	164,800	167,200	71
72	122,600	124,900	127,300	129,600	132,000	134,400	136,800	139,200	141,600	144,100	146,600	149,000	151,500	154,000	156,500	159,000	161,400	163,900	166,400	168,900	171,500	72
73	127,000	129,400	131,900	134,400	136,900	139,400	142,000	144,500	147,100	149,700	152,300	154,900	157,500	160,100	162,700	165,300	168,000	170,700	173,400	176,100	178,900	73
74	131,300	133,900	136,500	139,100	141,800	144,400	147,100	149,800	152,500	155,300	158,000	160,800	163									



## GUNTERSVILLE DAM SPILLWAY DISCHARGE IN CUBIC FEET PER SECOND

DATE ARRANGE- MENT	HEADWATER ELEVATION																				DATE ARRANGE- MENT	
	590.0	590.2	590.4	590.6	590.8	591.0	591.2	591.4	591.6	591.8	592.0	592.2	592.4	592.6	592.8	593.0	593.2	593.4	593.6	593.8		594.0
82	159,600	162,300	165,000	167,700	170,500	173,200	176,000	178,700	181,600	184,400	187,200	190,000	192,900	195,800	198,600	201,500	204,300	207,200	210,100	213,000	215,900	82
83	161,600	164,300	167,200	170,000	172,800	175,700	178,600	181,500	184,400	187,300	190,300	193,200	196,200	199,200	202,200	205,200	208,100	211,100	214,100	217,100	220,200	83
84	169,500	172,500	175,400	178,400	181,500	184,500	187,500	190,600	193,700	196,800	199,900	203,100	206,200	209,400	212,600	215,700	218,800	222,000	225,200	228,400	231,600	84
85	171,700	174,500	177,300	180,100	182,900	185,700	188,500	191,400	194,200	197,100												85
86	179,700	182,600	185,600	188,500	191,500	194,500	197,500	200,500	203,500	206,600	209,700	212,800	215,900	219,000	222,100	225,200	228,300	231,400	234,500	237,700	240,800	86
87	187,600	190,700	193,800	197,000	200,100	203,300	206,400	209,600	212,900	216,100	219,300	222,600	225,900	229,200	232,500	235,700	239,000	242,300	245,600	248,900	252,300	87
88	189,900	192,800	195,700	198,600	201,500	204,500	207,400	210,400	213,400	216,400												88
89	197,800	200,900	204,000	207,000	210,100	213,200	216,400	219,500	222,700	225,900	229,100	232,300	235,500	238,800	242,000	245,200	248,500	251,700	255,000	258,200	261,500	89
90	205,800	209,000	212,200	215,500	218,800	222,000	225,300	228,700	232,000	235,400	238,800	242,100	245,600	249,000	252,400	255,800	259,200	262,600	266,100	269,500	273,000	90
92	216,000	219,200	222,400	225,600	228,800	232,000	235,300	238,600	241,900	245,200	248,500	251,900	255,200	258,600	261,900	265,300	268,600	272,000	275,400	278,800	282,200	92
93	223,900	227,300	230,600	234,000	237,400	240,800	244,200	247,700	251,200	254,700	258,200	261,700	265,200	268,800	272,300	275,800	279,400	282,900	286,500	290,100	293,600	93
95	236,500	239,800	243,100	246,400	249,800	253,100	256,500	259,900	263,300	266,700	270,200	273,600	277,100	280,600	284,100	287,500	291,000	294,500	298,000	301,500	305,000	95
96	244,400	247,900	251,400	254,900	258,400	261,900	265,500	269,000	272,600	276,200	279,800	283,500	287,100	290,800	294,400	298,100	301,700	305,400	309,100	312,700	316,400	96
98	257,000	260,400	263,800	267,300	270,700	274,200	277,700	281,200	284,800	288,300	291,900	295,400	299,000	302,600	306,200	309,800	313,400	317,000	320,600	324,200	327,800	98
99	264,900	268,500	272,100	275,700	279,400	283,000	286,700	290,400	294,100	297,800	301,500	305,300	309,000	312,800	316,600	320,300	324,100	327,900	331,600	335,400	339,200	99
101	277,500	281,000	284,600	288,100	291,700	295,300	298,900	302,500	306,200	309,900	313,500	317,200	320,900	324,600	328,300	332,000	335,700	339,400	343,100	346,900	350,600	101
102	285,400	289,100	292,800	296,600	300,300	304,100	307,900	311,700	315,500	319,300	323,200	327,100	330,900	334,800	338,700	342,600	346,400	350,300	354,200	358,100	362,000	102
104	298,000	301,600	305,300	309,000	312,700	316,400	320,100	323,900	327,600	331,400	335,200	339,000	342,800	346,600	350,400	354,300	358,100	361,900	365,700	369,500	373,400	104
105	305,900	309,800	313,600	317,400	321,300	325,200	329,100	333,000	336,900	340,900	344,900	348,800	352,800	356,800	360,800	364,800	368,800	372,800	376,800	380,800	384,800	105
106	311,300	315,000	318,700	322,500	326,300	330,000	333,800	337,600	341,500	345,300	349,200	353,000	356,900	360,800	364,700	368,500	372,400	376,300	380,200	384,100	388,000	106
107	327,200	331,200	335,300	339,400	343,500	347,600	351,800	355,900	360,100	364,300	368,500	372,700	376,900	381,200	385,400	389,600	393,800	398,100	402,300	406,600	410,900	107
108	338,600	342,600	346,600	350,600	354,700	358,800	362,900	367,000	371,100	375,200	379,400	383,500	387,700	391,900	396,000	400,200	404,400	408,600	412,800	417,000	421,100	108
109	346,500	350,700	354,900	359,100	363,300	367,500	371,800	376,100	380,400	384,700	389,000	393,400	397,700	402,100	406,400	410,800	415,100	419,500	423,800	428,200	432,600	109
110	357,900	362,000	366,200	370,300	374,500	378,700	382,900	387,100	391,400	395,600	399,900	404,200	408,500	412,800	417,100	421,400	425,700	430,000	434,300	438,600	442,900	110
111	365,800	370,100	374,400	378,800	383,100	387,500	391,900	396,300	400,700	405,100	409,600	414,000	418,500	423,000	427,400	431,900	436,400	440,900	445,300	449,800	454,300	111
112	376,100	380,300	384,600	388,800	393,100	397,400	401,700	406,000	410,400	414,700	419,100	423,400	427,800	432,200	436,600	440,900	445,300	449,700	454,100	458,500		112
113	393,100	397,700	402,300	406,900	411,500	416,200	420,900	425,600	430,300	435,000	439,800	444,500	449,300	454,100	458,800							113
114	404,500	409,000	413,600	418,100	422,700	427,400	432,000	436,600	441,300	446,000	450,700	455,300	460,100									114
115	412,400	417,100	421,900	426,600	431,400	436,100	440,900	445,800	450,600	455,400	460,300											115
116	422,700	427,400	432,000	436,700	441,400	446,100	450,800	455,500	460,300													116
117	431,800	436,600	441,400	446,300	451,200	456,100	461,000															117
118	450,000	454,900	459,800																			118

HEADWATER 590 to 594  
TAILWATER 577.51 to 578.50

MARCH 2004

# GUNTERSVILLE DAM SPILLWAY DISCHARGE IN CUBIC FEET PER SECOND

RANGE- ELEVATION	HEADWATER ELEVATION																				RANGE- ELEVATION	
	594.0	594.2	594.4	594.6	594.8	595.0	595.2	595.4	595.6	595.8	596.0	596.2	596.4	596.6	596.8	597.0	597.2	597.4	597.6	597.8		598.0
21																						21
22																						22
23																						23
75																						75

## GUNTERSVILLE DAM SPILLWAY DISCHARGE IN CUBIC FEET PER SECOND

GATE HEIGHT	HEADWATER ELEVATION																				GATE HEIGHT	
	594.0	594.2	594.4	594.6	594.8	595.0	595.2	595.4	595.6	595.8	596.0	596.2	596.4	596.6	596.8	597.0	597.2	597.4	597.6	597.8		598.0
77	195,200	198,000	200,800	203,600	206,400	209,200	212,000	214,900	217,800	220,700	223,600	226,600	229,500	232,500	235,500	238,600	241,600	244,700	247,700	250,800	253,900	77
78	199,500	202,400	205,300	208,200	211,200	214,100	217,100	220,100	223,100	226,200	229,200	232,300	235,400	238,600	241,700	244,900	248,100	251,300	254,500	257,700	261,000	78
79	206,600	209,600	212,600	215,600	218,600	221,600	224,600	227,600	230,700	233,800	236,900	240,000	243,100	246,200	249,400	252,500	255,700	258,900	262,100	265,400	268,600	79
80	210,900	214,000	217,100	220,200	223,400	226,500	229,700	232,800	236,000	239,200	242,500	245,700	249,000	252,300	255,600	258,900	262,200	265,500	268,900	272,300	275,600	80
82	215,900	218,800	221,700	224,600	227,600	230,500	233,500	236,400	239,400	242,500	245,500	248,600	251,700	254,800	257,900	261,100	264,200	267,400	270,600	273,800	277,000	82
83	220,200	223,200	226,200	229,300	232,400	235,500	238,500	241,700	244,800	248,000	251,100	254,400	257,600	260,800	264,100	267,400	270,700	274,000	277,400	280,700	284,100	83
84	231,600	234,800	238,000	241,300	244,500	247,800	251,100	254,400	257,700	261,000	264,400	267,800	271,100	274,500	278,000	281,400	284,800	288,300	291,800	295,300	298,800	84
86	240,800	244,000	247,200	250,400	253,500	256,800	260,000	263,200	266,500	269,700	273,100	276,400	279,700	283,100	286,500	289,900	293,300	296,800	300,200	303,700	307,200	86
87	252,300	255,600	259,000	262,300	265,700	269,100	272,500	275,900	279,400	282,800	286,300	289,800	293,300	296,800	300,400	303,900	307,500	311,100	314,600	318,300	321,900	87
89	261,500	264,800	268,100	271,400	274,700	278,100	281,400	284,700	288,100	291,500	295,000	298,400	301,900	305,400	308,900	312,400	316,000	319,500	323,100	326,700	330,300	89
90	273,000	276,400	279,900	283,400	286,900	290,400	293,900	297,500	301,000	304,600	308,200	311,800	315,500	319,100	322,800	326,400	330,100	333,800	337,500	341,300	345,000	90
92	282,200	285,600	289,000	292,500	295,900	299,400	302,800	306,300	309,800	313,300	316,900	320,500	324,100	327,700	331,300	335,000	338,600	342,300	346,000	349,700	353,500	92
93	293,600	297,200	300,800	304,500	308,100	311,700	315,400	319,000	322,700	326,400	330,100	333,900	337,600	341,400	345,200	348,900	352,800	356,600	360,400	364,300	368,100	93
95	305,000	308,500	312,000	315,600	319,100	322,700	326,200	329,800	333,400	337,000	340,700	344,400	348,100	351,800	355,500	359,200	363,000	366,800	370,500	374,300	378,200	95
96	316,400	320,100	323,800	327,600	331,300	335,000	338,800	342,600	346,300	350,100	353,900	357,800	361,600	365,500	369,300	373,200	377,100	381,000	385,000	388,900	392,800	96
98	327,800	331,400	335,000	338,700	342,300	346,000	349,700	353,300	357,000	360,800	364,500	368,300	372,100	375,900	379,700	383,500	387,400	391,200	395,100	399,000	402,900	98
99	339,200	343,000	346,900	350,700	354,500	358,400	362,200	366,100	370,000	373,800	377,800	381,700	385,600	389,600	393,500	397,500	401,500	405,500	409,500	413,500	417,600	99
101	350,600	354,300	358,100	361,800	365,600	369,300	373,100	376,900	380,700	384,500	388,300	392,200	396,100	400,000	403,900	407,800	411,700	415,700	419,600	423,600	427,600	101
102	362,000	365,900	369,900	373,800	377,700	381,700	385,600	389,600	393,600	397,600	401,600	405,600	409,600	413,700	417,700	421,800	425,900	429,900	434,000	438,100	442,300	102
104	373,400	377,200	381,100	384,900	388,800	392,600	396,500	400,400	404,300	408,200	412,100	416,100	420,100	424,100	428,100	432,100	436,100	440,100	444,200	448,200	452,300	104
105	384,800	388,800	392,900	396,900	401,000	405,000	409,100	413,100	417,200	421,300	425,400	429,500	433,600	437,800	441,900	446,100	450,200	454,400	458,600			105
106	388,000	391,900	395,800	399,700	403,600	407,500	411,500	415,400	419,300	423,300	427,400	431,400	435,500	439,600	443,700	447,800	451,900	456,100	460,200			106
107	410,900	415,100	419,400	423,700	428,000	432,300	436,500	440,900	445,200	449,500	453,900	458,200										107
108	421,100	425,300	429,600	433,800	438,000	442,200	446,400	450,700	454,900	459,200												108
109	432,600	437,000	441,400	445,800	450,200	454,600	459,000															109
110	442,900	447,200	451,500	455,900	460,200																	110
111	454,300	458,800																				111

HEADWATER 594 to 598  
TAILWATER 577.51 to 578.50

MARCH 2004

**GUNTERVILLE DAM  
SPILLWAY DISCHARGE  
IN CUBIC FEET PER SECOND**

GATE APERTURE FEET	HEADWATER ELEVATION																				GATE APERTURE FEET
	598.0	598.2	598.4	598.6	598.8	599.0	599.2	599.4	599.6	599.8	600.0	600.2	600.4	600.6	600.8	601.0	601.2	601.4	601.6	601.8	
12											36,260										12
14										36,900	38,300										14
16								36,360	37,640	38,960	40,340										16
18				36,360	37,300	38,480	39,730	41,150	42,730	44,380	46,110										18
20												41,030	42,370								20
21	35,930	36,610	37,320	38,120	39,050	40,060	41,130	42,260	43,450	44,690	45,970										21
22	37,660	38,360	39,070	39,870	40,790	41,780	42,830	43,940	45,090	46,290	47,540										22
23	39,390	40,100	40,820	41,630	42,530	43,510	44,530	45,610	46,730	47,890	49,100										23
24	41,130	41,840	42,580	43,380	44,280	45,230	46,230	47,280	48,370	49,500	50,660										24
25	42,860	43,590	44,330	45,140	46,020	46,960	47,940	48,950	50,010	51,100	52,220										25
26	44,600	45,330	46,090	46,890	47,760	48,680	49,640	50,630	51,650	52,700	53,780										26
27	46,330	47,080	47,840	48,650	49,510	50,410	51,340	52,300	53,290	54,300	55,350										27
28	48,070	48,820	49,590	50,400	51,250	52,130	53,040	53,970	54,930	55,910	56,910										28
29	49,800	50,560	51,350	52,160	52,990	53,860	54,740	55,640	56,570	57,510	58,470										29
31	52,210	52,920	53,650	54,410	55,200	56,030	56,880	57,760	58,650	59,570	60,510										31
32	53,940	54,660	55,400	56,160	56,950	57,760	58,580	59,430	60,290	61,170	62,070										32
34	56,350	57,020	57,700	58,410	59,160	59,930	60,730	61,540	62,380	63,240	64,110										34
35	58,090	58,760	59,450	60,160	60,900	61,660	62,430	63,220	64,020	64,840	65,670										35
37	60,490	61,120	61,750	62,410	63,110	63,830	64,570	65,330	66,110	66,900	67,710										37
38	62,230	62,860	63,510	64,170	64,850	65,560	66,270	67,000	67,750	68,500	69,270										38
39	64,640	65,220	65,800	66,420	67,060	67,730	68,420	69,120	69,830	70,560	71,310										39
40	67,040	67,570	68,100	68,670	69,270	69,910	70,560	71,230	71,920	72,630	73,350										40
41	68,780	69,320	69,860	70,420	71,020	71,630	72,260	72,900	73,560	74,230	74,910										41
42	72,270	72,830	73,400	73,990	74,610	75,250	75,900	76,570	77,250	77,950	78,650										42
43	75,760	76,340	76,940	77,560	78,200	78,870	79,550	80,240	80,950	81,670	82,400										43
44	79,250	79,860	80,480	81,120	81,790	82,480	83,190	83,910	84,640	85,380	86,140										44
45	82,730	83,370	84,020	84,690	85,380	86,100	86,830	87,580	88,330	89,100	89,880										45
46	86,220	86,890	87,560	88,250	88,970	89,720	90,470	91,240	92,030	92,820	93,630										46
47	89,710	90,400	91,100	91,820	92,570	93,330	94,110	94,910	95,720	96,540	97,370										47
48	93,200	93,920	94,640	95,380	96,160	96,950	97,760	98,580	99,410	100,250	101,100										48
49	96,690	97,430	98,180	98,950	99,750	100,600	101,400	102,200	103,100	104,000	104,900										49
50	100,800	101,500	102,200	103,000	103,700	104,500	105,200	106,000	106,800	107,600	108,500										50
51	104,300	105,000	105,800	106,500	107,300	108,100	108,900	109,700	110,500	111,400	112,200										51
52	107,800	108,600	109,300	110,100	110,900	111,700	112,500	113,400	114,200	115,100	115,900										52
53	111,300	112,100	112,900	113,700	114,500	115,300	116,200	117,000	117,900	118,800	119,700										53
54	114,800	115,600	116,400	117,200	118,100	118,900	119,800	120,700	121,600	122,500	123,400										54
55	118,300	119,100	119,900	120,800	121,700	122,500	123,500	124,400	125,300	126,200	127,200										55
56	121,700	122,600	123,400	124,300	125,100	126,000	126,900	127,700	128,600	129,400	130,300										56
57	125,200	126,100	127,000	127,900	128,700	129,600	130,500	131,400	132,300	133,200	134,000										57
58	132,300	133,300	134,300	135,300	136,400	137,400	138,500	139,500	140,500	141,600	142,600										58
59	139,300	140,500	141,700	142,800	144,000	145,200	146,400	147,600	148,800	150,000	151,200										59
60	146,400	147,700	149,000	150,300	151,700	153,000	154,400	155,700	157,100	158,400	159,800										60
61	153,400	154,900	156,300	157,800	159,300	160,800	162,300	163,800	165,400	166,900	168,400										61
62	160,400	162,100	163,700	165,300	167,000	168,600	170,300	171,900	173,600	175,300	177,000										62
63	167,500	169,300	171,000	172,800	174,600	176,400	178,200	180,100	181,900	183,700	185,600										63
64	174,500	176,400	178,400	180,300	182,200	184,200	186,200	188,200	190,200	192,200	194,200										64
65	181,600	183,600	185,700	187,800	189,900	192,000	194,100	196,300	198,400	200,600	202,800										65
66	188,700	191,000	193,300	195,800	198,300	200,800	203,300	205,800	208,400	211,000	213,600										66
67	195,800	198,500	201,200	204,100	207,000	210,000	213,000	216,000	219,100	222,200	225,300										67

# GUNTERSVILLE DAM SPILLWAY DISCHARGE IN CUBIC FEET PER SECOND

RAISE-MENT	HEADWATER ELEVATION																				RAISE-MENT	
	598.0	598.2	598.4	598.6	598.8	599.0	599.2	599.4	599.6	599.8	600.0	600.2	600.4	600.6	600.8	601.0	601.2	601.4	601.6	601.8		602.0
74	245,500	248,600	251,800	254,900	258,100	261,300	264,600	267,900	271,100	274,400	277,700											74
75	252,500	255,800	259,100	262,400	265,800	269,100	272,500	276,000	279,400	282,800	286,300											75
77	253,900	257,000	260,200	263,300	266,500	269,700	273,000	276,200	279,500	282,800												77
78	261,000	264,200	267,500	270,800	274,200	277,500	280,900	284,300	287,800	291,200	294,700											78
79	268,600	271,900	275,100	278,400	281,700	285,100	288,400	291,800	295,200	298,600	302,000											79
80	275,600	279,000	282,500	285,900	289,300	292,900	296,400	299,900	303,500	307,000	310,600											80
82	277,000	280,300	283,500	286,800	290,100	293,500	296,800	300,200	303,600	307,000												82
83	284,100	287,500	290,900	294,300	297,800	301,300	304,800	308,300	311,800	315,400	319,000											83
84	298,800	302,300	305,800	309,400	312,900	316,600	320,200	323,900	327,500	331,200	334,900											84
86	307,200	310,700	314,200	317,800	321,400	325,000	328,600	332,200	335,900	339,600	343,300											86
87	321,900	325,500	329,200	332,800	336,500	340,300	344,000	347,800	351,600	355,400	359,200											87
89	330,300	334,000	337,600	341,300	344,900	348,700	352,400	356,200	360,000	363,800	367,600											89
90	345,000	348,800	352,500	356,300	360,100	364,000	367,900	371,800	375,700	379,600	383,500											90
92	353,500	357,200	361,000	364,700	368,500	372,400	376,300	380,100	384,000	387,900	391,900											92
93	368,100	372,000	375,900	379,800	383,700	387,700	391,700	395,700	399,700	403,800	407,800											93
95	378,200	382,000	385,800	389,700	393,600	397,500	401,500	405,400	409,400	413,400	417,400											95
96	392,800	396,800	400,800	404,800	408,800	412,800	416,900	421,000	425,100	429,200	433,300											96
98	402,900	406,800	410,700	414,700	418,600	422,600	426,700	430,700	434,700	438,800	442,900											98
99	417,600	421,600	425,700	429,700	433,800	438,000	442,100	446,300	450,400	454,600	458,800											99
101	427,600	431,600	435,600	439,600	443,700	447,800	451,900	456,000	460,100													101
102	442,300	446,400	450,500	454,700	458,900																	102
104	452,300	456,400	460,500																			104

HEADWATER 598 to 602  
TAILWATER 577.51 to 578.50

MARCH 2004

GUNTERSVILLE DAM  
**SPILLWAY DISCHARGE**  
 IN CUBIC FEET PER SECOND

GATE ELEVATION FEET	HEADWATER ELEVATION																			GATE ELEVATION FEET		
	590.0	590.2	590.4	590.6	590.8	591.0	591.2	591.4	591.6	591.8	592.0	592.2	592.4	592.6	592.8	593.0	593.2	593.4	593.6		593.8	594.0

MARCH 2004

HEADWATER 590 to 594  
 TAILWATER 578.51 to 579.50

## GUNTERSVILLE DAM SPILLWAY DISCHARGE IN CUBIC FEET PER SECOND

GATE ELEVATION	HEADWATER ELEVATION																			GATE ELEVATION		
	590.0	590.2	590.4	590.6	590.8	591.0	591.2	591.4	591.6	591.8	592.0	592.2	592.4	592.6	592.8	593.0	593.2	593.4	593.6		593.8	594.0
93	220,700	224,100	227,400	230,800	234,200	237,600	241,100	244,500	248,000	251,500	255,000	258,500	262,100	265,600	269,200	272,700	276,300	279,800	283,400	287,000	290,600	93
95	233,200	236,500	239,900	243,200	246,600	249,900	253,300	256,700	260,100	263,500	267,000	270,500	273,900	277,400	280,900	284,400	287,900	291,400	294,900	298,500	302,000	95
96	241,000	244,500	248,000	251,500	255,000	258,600	262,100	265,700	269,300	272,900	276,500	280,200	283,800	287,500	291,200	294,800	298,500	302,200	305,900	309,600	313,300	96
98	253,600	257,000	260,400	263,900	267,400	270,900	274,400	277,900	281,400	284,900	288,500	292,100	295,700	299,300	302,900	306,500	310,100	313,800	317,400	321,000	324,700	98
99	261,400	265,000	268,600	272,200	275,900	279,500	283,200	286,900	290,600	294,300	298,000	301,800	305,600	309,400	313,100	316,900	320,700	324,500	328,300	332,200	336,000	99
101	273,900	277,400	281,000	284,600	288,200	291,800	295,400	299,000	302,700	306,400	310,000	313,700	317,400	321,200	324,900	328,600	332,300	336,100	339,900	343,600	347,400	101
102	281,700	285,400	289,200	292,900	296,700	300,400	304,200	308,000	311,900	315,700	319,500	323,400	327,300	331,200	335,100	339,000	342,900	346,900	350,800	354,700	358,700	102
104	294,200	297,900	301,600	305,300	309,000	312,700	316,500	320,200	324,000	327,800	331,500	335,400	339,200	343,000	346,900	350,700	354,600	358,400	362,300	366,200	370,100	104
105	302,000	305,900	309,700	313,600	317,500	321,400	325,300	329,200	333,100	337,100	341,100	345,100	349,100	353,100	357,100	361,100	365,200	369,200	373,200	377,300	381,400	105
106	307,400	311,200	315,000	318,700	322,500	326,300	330,100	333,900	337,800	341,600	345,500	349,300	353,200	357,100	361,000	364,900	368,900	372,800	376,700	380,700	384,600	106
107	323,100	327,200	331,300	335,400	339,500	343,600	347,800	351,900	356,100	360,300	364,500	368,700	373,000	377,200	381,500	385,800	390,000	394,300	398,600	402,900	407,200	107
108	334,400	338,500	342,500	346,600	350,700	354,700	358,800	362,900	367,100	371,200	375,400	379,500	383,700	387,900	392,100	396,300	400,600	404,800	409,100	413,300	417,600	108
109	342,200	346,400	350,700	354,900	359,100	363,400	367,700	371,900	376,200	380,500	384,900	389,200	393,600	398,000	402,400	406,800	411,200	415,600	420,000	424,400	428,900	109
110	353,600	357,700	361,900	366,100	370,300	374,500	378,700	383,000	387,200	391,500	395,700	400,000	404,300	408,700	413,000	417,300	421,700	426,100	430,400	434,800	439,200	110
111	361,400	365,700	370,100	374,400	378,800	383,200	387,500	392,000	396,400	400,800	405,300	409,700	414,200	418,700	423,200	427,700	432,300	436,800	441,400	445,900	450,500	111
112	371,600	375,900	380,200	384,500	388,800	393,100	397,400	401,700	406,000	410,400	414,800	419,100	423,500	428,000	432,400	436,800	441,200	445,700	450,200	454,600	459,100	112
113	388,300	393,000	397,600	402,300	406,900	411,600	416,300	421,000	425,700	430,400	435,200	439,900	444,700	449,500	454,300	459,200	464,000	468,800	473,700			113
114	399,700	404,300	408,900	413,500	418,100	422,700	427,300	432,000	436,600	441,300	446,000	450,700	455,500	460,200	465,000	469,700	474,500					114
115	407,500	412,200	417,000	421,800	426,600	431,400	436,200	441,000	445,800	450,700	455,500	460,400	465,300	470,300	475,200							115
116	417,700	422,400	427,100	431,800	436,600	441,300	446,000	450,700	455,500	460,300	465,000	469,800	474,700									116
117	426,600	431,500	436,400	441,300	446,200	451,100	456,100	461,000	466,000	470,900	475,900											117
118	444,700	449,700	454,700	459,700	464,700	469,700	474,700															118
119	463,900	469,000	474,100																			119

HEADWATER 590 to 594  
TAILWATER 578.51 to 579.50

MARCH 2004

**GUNTERSVILLE DAM  
SPILLWAY DISCHARGE  
IN CUBIC FEET PER SECOND**

GATE NUMBER	HEADWATER ELEVATION																				GATE NUMBER	
	594.0	594.2	594.4	594.6	594.8	595.0	595.2	595.4	595.6	595.8	596.0	596.2	596.4	596.6	596.8	597.0	597.2	597.4	597.6	597.8		598.0
31																						31
32																						32
33																						33
75																						75
77																						77
78																						78
79																						79
80																						80
82																						82
83																						83
84																						84
86																						86
87																						87
89																						89
90																						90

MARCH 2004

HEADWATER 594 to 598  
TAILWATER 578.51 to 579.50



# GUNTERSVILLE DAM SPILLWAY DISCHARGE IN CUBIC FEET PER SECOND

GATE HEIGHT	HEADWATER ELEVATION																				GATE HEIGHT	
	594.0	594.2	594.4	594.6	594.8	595.0	595.2	595.4	595.6	595.8	596.0	596.2	596.4	596.6	596.8	597.0	597.2	597.4	597.6	597.8		598.0
92	279,300	282,800	286,200	289,700	293,200	296,600	300,100	303,600	307,200	310,700	314,300	317,900	321,500	325,100	328,800	332,500	336,200	339,900	343,600	347,300	351,100	92
93	290,600	294,300	297,900	301,500	305,200	308,900	312,500	316,200	319,900	323,600	327,400	331,100	334,900	338,700	342,500	346,300	350,100	354,000	357,800	361,700	365,600	93
95	302,000	305,600	309,100	312,700	316,300	319,900	323,500	327,100	330,700	334,400	338,100	341,800	345,500	349,200	353,000	356,800	360,500	364,300	368,200	372,000	375,800	95
96	313,300	317,100	320,800	324,600	328,300	332,100	335,900	339,700	343,500	347,300	351,200	355,000	358,900	362,800	366,700	370,600	374,500	378,500	382,400	386,400	390,300	96
98	324,700	328,400	332,100	335,700	339,400	343,100	346,800	350,600	354,300	358,100	361,900	365,700	369,500	373,300	377,200	381,000	384,900	388,800	392,700	396,600	400,600	98
99	336,000	339,900	343,700	347,600	351,500	355,400	359,200	363,200	367,100	371,000	375,000	378,900	382,900	386,900	390,900	394,900	398,900	402,900	407,000	411,000	415,100	99
101	347,400	351,200	355,000	358,800	362,600	366,400	370,200	374,000	377,900	381,700	385,600	389,500	393,500	397,400	401,400	405,300	409,300	413,300	417,300	421,300	425,300	101
102	358,700	362,700	366,600	370,600	374,600	378,600	382,600	386,600	390,600	394,700	398,700	402,800	406,900	411,000	415,100	419,200	423,300	427,400	431,600	435,700	439,900	102
104	370,100	374,000	377,900	381,800	385,700	389,600	393,600	397,500	401,400	405,400	409,400	413,400	417,500	421,500	425,600	429,600	433,700	437,800	441,900	446,000	450,100	104
105	381,400	385,500	389,600	393,600	397,700	401,900	406,000	410,100	414,200	418,400	422,500	426,700	430,900	435,100	439,300	443,500	447,700	451,900	456,100	460,400	464,600	105
106	384,600	388,600	392,600	396,600	400,600	404,500	408,500	412,500	416,600	420,600	424,700	428,800	432,900	437,100	441,200	445,400	449,600	453,800	458,000	462,300	466,500	106
107	407,200	411,600	415,900	420,300	424,600	429,000	433,300	437,700	442,100	446,500	450,900	455,300	459,800	464,200	468,600	473,100						107
108	417,600	421,800	426,100	430,400	434,700	439,000	443,300	447,600	451,900	456,300	460,600	465,000	469,400	473,800								108
109	428,900	433,300	437,800	442,300	446,700	451,200	455,700	460,200	464,700	469,200	473,700											109
110	439,200	443,600	448,000	452,400	456,800	461,200	465,600	470,100	474,500													110
111	450,500	455,100	459,700	464,200	468,800	473,400																111
112	459,100	463,600	468,100	472,600																		112

HEADWATER 594 to 598  
TAILWATER 578.51 to 579.50

MARCH 2004

GUNTERSVILLE DAM  
**SPILLWAY DISCHARGE**  
IN CUBIC FEET PER SECOND

GATE HEIGHT FEET	HEADWATER ELEVATION																				GATE HEIGHT FEET	
	598.0	598.2	598.4	598.6	598.8	599.0	599.2	599.4	599.6	599.8	600.0	600.2	600.4	600.6	600.8	601.0	601.2	601.4	601.6	601.8		602.0
25																						25
26									51,030	50,510	51,630											26
27								50,680	51,650	52,080	53,170											27
28								52,360	53,290	53,660	54,700											28
29			50,630	51,440	50,570	51,450	50,680	51,650	52,360	53,290	54,250	55,240	56,240									29
					52,280	53,150	54,030	54,940	55,870	56,810	57,780											
31	51,440	52,150	52,880	53,640	54,450	55,280	56,130	57,010	57,910	58,830	59,770											31
32	53,140	53,870	54,610	55,370	56,160	56,970	57,810	58,650	59,520	60,400	61,300											32
34	55,510	56,180	56,860	57,570	58,330	59,100	59,900	60,720	61,560	62,420	63,300											34
35	57,210	57,890	58,590	59,300	60,040	60,800	61,580	62,370	63,180	64,000	64,830											35
37	59,570	60,200	60,840	61,500	62,210	62,930	63,670	64,440	65,220	66,010	66,820											37
38	61,280	61,920	62,570	63,230	63,920	64,630	65,350	66,080	66,830	67,590	68,360											38
39	63,640	64,220	64,820	65,440	66,080	66,760	67,440	68,150	68,870	69,600	70,350											39
40	66,000	66,530	67,070	67,640	68,250	68,880	69,540	70,220	70,910	71,620	72,340											40
41	67,710	68,250	68,800	69,370	69,960	70,580	71,220	71,860	72,520	73,200	73,880											41
42	71,180	71,750	72,320	72,920	73,540	74,180	74,840	75,520	76,200	76,900	77,610											42
43	74,660	75,250	75,850	76,470	77,120	77,790	78,470	79,170	79,880	80,600	81,330											43
44	78,130	78,750	79,370	80,020	80,700	81,390	82,100	82,820	83,560	84,300	85,060											44
45	81,610	82,250	82,900	83,570	84,270	84,990	85,730	86,470	87,240	88,010	88,790											45
46	85,080	85,750	86,430	87,120	87,850	88,590	89,350	90,130	90,910	91,710	92,520											46
47	88,560	89,250	89,950	90,680	91,430	92,200	92,980	93,780	94,590	95,410	96,250											47
48	92,030	92,750	93,480	94,230	95,000	95,800	96,610	97,430	98,270	99,120	99,970											48
49	95,510	96,250	97,000	97,780	98,580	99,400	100,200	101,100	101,900	102,800	103,700											49
50	99,570	100,300	101,000	101,700	102,500	103,200	104,000	104,800	105,600	106,400	107,200											50
51	103,000	103,800	104,500	105,300	106,000	106,800	107,600	108,500	109,300	110,100	111,000											51
52	106,500	107,300	108,000	108,800	109,600	110,400	111,300	112,100	113,000	113,800	114,700											52
53	110,000	110,800	111,600	112,400	113,200	114,000	114,900	115,800	116,600	117,500	118,400											53
54	113,500	114,300	115,100	115,900	116,800	117,600	118,500	119,400	120,300	121,200	122,100											54
55	116,900	117,800	118,600	119,500	120,300	121,200	122,100	123,100	124,000	124,900	125,900											55
56	120,400	121,200	122,100	122,900	123,800	124,600	125,500	126,400	127,200	128,100	128,900											56
57	123,800	124,700	125,600	126,500	127,400	128,200	129,100	130,000	130,900	131,800	132,700											57
58	130,800	131,800	132,900	133,900	134,900	136,000	137,000	138,100	139,100	140,100	141,200											58
59	137,800	139,000	140,200	141,300	142,500	143,700	144,900	146,100	147,300	148,500	149,700											59
60	144,800	146,100	147,400	148,800	150,100	151,400	152,800	154,200	155,500	156,900	158,200											60
61	151,800	153,200	154,700	156,200	157,700	159,200	160,700	162,200	163,700	165,200	166,800											61
62	158,700	160,400	162,000	163,600	165,300	166,900	168,600	170,200	171,900	173,600	175,300											62
63	165,700	167,500	169,300	171,000	172,800	174,600	176,500	178,300	180,100	182,000	183,800											63
64	172,700	174,600	176,500	178,500	180,400	182,400	184,400	186,300	188,300	190,300	192,300											64
65	179,700	181,800	183,800	185,900	188,000	190,100	192,200	194,400	196,500	198,700	200,900											65
66	183,800	185,800	187,800	189,800	191,900	193,900	196,000	198,100	200,200	202,300	204,400											66
67	187,200	189,300	191,300	193,400	195,500	197,500	199,600	201,800	203,900	206,000	208,100											67
68	194,200	196,400	198,600	200,800	203,000	205,300	207,500	209,800	212,100	214,400	216,600											68
69	201,200	203,500	205,900	208,200	210,600	213,000	215,400	217,900	220,300	222,700	225,200											69
70	208,200	210,700	213,200	215,700	218,200	220,800	223,300	225,900	228,500	231,100	233,700											70
71	215,200	217,800	220,400	223,100	225,800	228,500	231,200	233,900	236,700	239,400	242,200											71
72	222,200	224,900	227,700	230,500	233,400	236,200	239,100	242,000	244,900	247,800	250,700											72
73	232,600	235,600	238,500	241,500	244,500	247,600	250,600	253,700	256,800	259,900	263,000											73
74	243,100	246,200	249,300	252,500	255,700	258,900	262,100	265,400	268,700	271,900	275,200											74
75	250,000	253,300	256,600	259,900	263,200	266,600	270,000	273,400	276,900	280,300	283,800											75
77	251,600	254,800	257,900	261,100	264,200	267,500	270,700	273,900	277,200	280,500	283,800											77
78	258,600	261,900	265,200	268,500	271,800	275,200	278,600	282,000	285,400	288,900	292,300											78
79	266,200	269,400	272,700	276,000	279,300	282,600	286,000	289,400	292,700	296,200	299,600											79
80	273,200	276,600	280,000	283,400	286,900	290,400	293,900	297,400	301,000	304,500	308,100											80
82	274,800	278,000	281,300	284,500	287,800	291,200	294,500	297,900	301,300	304,700	308,100											82
83	281,700	285,100	288,500	292,000	295,400	298,900	302,400	306,000	309,500	313,100	316,600											83
84	296,300	299,800	303,300	306,900	310,500	314,100	317,700	321,400	325,000	328,700	332,400											84

MARCH 2004

HEADWATER 598 to 602  
TAILWATER 578.51 to 579.50

# GUNTERSVILLE DAM SPILLWAY DISCHARGE IN CUBIC FEET PER SECOND

GAGE ELEVATION	HEADWATER ELEVATION																				GAGE ELEVATION	
	598.0	598.2	598.4	598.6	598.8	599.0	599.2	599.4	599.6	599.8	600.0	600.2	600.4	600.6	600.8	601.0	601.2	601.4	601.6	601.8		602.0
86	304,800	308,400	311,900	315,400	319,000	322,600	326,300	329,900	333,600	337,300	341,000											86
87	319,400	323,000	326,700	330,300	334,100	337,800	341,600	345,300	349,100	352,900	356,700											87
89	328,000	331,600	335,200	338,900	342,600	346,400	350,100	353,900	357,700	361,500	365,300											89
90	342,500	346,200	350,000	353,800	357,700	361,500	365,400	369,300	373,200	377,100	381,100											90
92	351,100	354,800	358,600	362,400	366,200	370,100	374,000	377,800	381,800	385,700	389,600											92
93	365,600	369,500	373,400	377,300	381,300	385,200	389,200	393,300	397,300	401,300	405,400											93
95	375,800	379,700	383,500	387,400	391,300	395,300	399,200	403,200	407,200	411,200	415,200											95
96	390,300	394,300	398,300	402,300	406,400	410,400	414,500	418,600	422,700	426,900	431,000											96
98	400,600	404,500	408,500	412,500	416,500	420,500	424,500	428,600	432,600	436,700	440,800											98
99	415,100	419,200	423,300	427,400	431,500	435,600	439,800	444,000	448,200	452,400	456,600											99
101	425,300	429,400	433,400	437,500	441,600	445,700	449,800	453,900	458,100	462,200	466,400											101
102	439,900	444,000	448,200	452,400	456,600	460,800	465,100	469,400	473,600													102
104	450,100	454,200	458,400	462,500	466,700	470,900	475,100															104
105	464,600	468,900	473,200																			105
106	466,500	470,700	475,000																			106

HEADWATER 598 to 602  
TAILWATER 578.51 to 579.50

MARCH 2004

**GUNTERSVILLE DAM  
SPILLWAY DISCHARGE  
IN CUBIC FEET PER SECOND**

GAGE- HEIGHT	HEADWATER ELEVATION																				GAGE- HEIGHT	
	590.0	590.2	590.4	590.6	590.8	591.0	591.2	591.4	591.6	591.8	592.0	592.2	592.4	592.6	592.8	593.0	593.2	593.4	593.6	593.8		594.0	


## GUNTERSVILLE DAM SPILLWAY DISCHARGE IN CUBIC FEET PER SECOND

RAILWAY ELEVATION	HEADWATER ELEVATION																				RAILWAY ELEVATION	
	590.0	590.2	590.4	590.6	590.8	591.0	591.2	591.4	591.6	591.8	592.0	592.2	592.4	592.6	592.8	593.0	593.2	593.4	593.6	593.8		594.0
104	289,600	293,400	297,200	301,000	304,800	308,600	312,400	316,200	320,000	323,900	327,700	331,500	335,300	339,200	343,000	346,900	350,700	354,600	358,500	362,400	366,300	104
105	297,300	301,200	305,200	309,200	313,100	317,100	321,100	325,100	329,000	333,000	337,000	341,000	345,100	349,100	353,100	357,100	361,100	365,200	369,300	373,300	377,400	105
106	302,700	306,600	310,500	314,400	318,300	322,200	326,000	329,900	333,800	337,700	341,500	345,400	349,300	353,200	357,100	361,100	365,000	368,900	372,900	376,800	380,800	106
107	318,100	322,300	326,500	330,700	334,900	339,100	343,400	347,600	351,800	356,000	360,300	364,500	368,800	373,000	377,300	381,600	385,800	390,100	394,400	398,800	403,100	107
108	329,300	333,500	337,700	341,900	346,100	350,200	354,400	358,600	362,800	366,900	371,100	375,300	379,500	383,700	387,900	392,200	396,400	400,600	404,900	409,100	413,400	108
109	337,000	341,300	345,700	350,000	354,400	358,700	363,100	367,400	371,800	376,100	380,500	384,900	389,200	393,600	398,000	402,400	406,800	411,200	415,700	420,100	424,600	109
110	348,200	352,600	356,900	361,200	365,500	369,800	374,100	378,400	382,700	387,000	391,400	395,700	400,000	404,300	408,700	413,000	417,300	421,700	426,100	430,500	434,900	110
111	355,900	360,400	364,900	369,400	373,800	378,300	382,800	387,300	391,800	396,200	400,700	405,200	409,700	414,200	418,700	423,200	427,800	432,300	436,900	441,500	446,000	111
112	366,100	370,500	375,000	379,400	383,800	388,200	392,600	397,000	401,400	405,800	410,200	414,600	419,100	423,500	427,900	432,300	436,800	441,200	445,700	450,200	454,700	112
113	382,400	387,200	392,000	396,800	401,600	406,400	411,200	416,000	420,700	425,500	430,300	435,100	439,900	444,700	449,500	454,300	459,200	464,000	468,900	473,800	478,700	113
114	393,700	398,500	403,200	408,000	412,800	417,500	422,200	427,000	431,700	436,400	441,200	445,900	450,700	455,400	460,200	464,900	469,700	474,500	479,300	484,200	489,000	114
115	401,400	406,300	411,200	416,200	421,100	426,000	430,900	435,800	440,700	445,600	450,500	455,500	460,400	465,300	470,200	475,200	480,100	485,100	490,100			115
116	411,600	416,500	421,300	426,200	431,100	435,900	440,700	445,600	450,400	455,200	460,100	464,900	469,700	474,600	479,400	484,300	489,100					116
117	420,300	425,300	430,400	435,500	440,500	445,600	450,600	455,700	460,700	465,700	470,800	475,800	480,900	485,900	491,000							117
118	438,100	443,300	448,500	453,700	458,800	464,000	469,100	474,300	479,400	484,500	489,600											118
119	457,000	462,400	467,700	473,000	478,300	483,600	488,900															119
120	474,900	480,400	485,800	491,200																		120

HEADWATER 590 to 594  
TAILWATER 579.51 to 580.50

MARCH 2004

GUNTERVILLE DAM  
 SPILLWAY DISCHARGE  
 IN CUBIC FEET PER SECOND

HEADWATER ELEVATION

GATE NUMBER	HEADWATER ELEVATION																				GATE NUMBER		
	594.0	594.2	594.4	594.6	594.8	595.0	595.2	595.4	595.6	595.8	596.0	596.2	596.4	596.6	596.8	597.0	597.2	597.4	597.6	597.8		598.0	
40																						40	
41																			64, 970	65, 510	66, 050	64, 910	41
42																			68, 350	68, 910	69, 480	66, 590	42
43																			71, 150	71, 730	72, 320	70, 500	43
44	66, 180	66, 660	67, 140	67, 610	65, 060	65, 500	65, 940	66, 380	66, 840	67, 330	64, 650	65, 150	65, 660	66, 180	66, 710	67, 250	67, 800	74, 500	75, 110	72, 320	73, 500	44	
45	69, 090	69, 600	70, 110	70, 620	71, 120	71, 610	72, 110	72, 600	73, 120	73, 660	74, 230	74, 810	75, 400	76, 000	76, 610	77, 230	77, 850	78, 490	79, 120	79, 770	80, 420	45	
46	72, 010	72, 550	73, 080	73, 620	74, 140	74, 670	75, 190	75, 710	76, 250	76, 830	77, 420	78, 030	78, 650	79, 270	79, 910	80, 560	81, 210	81, 860	82, 530	83, 200	83, 870	46	
47	74, 930	75, 490	76, 060	76, 620	77, 170	77, 730	78, 280	78, 820	79, 390	79, 990	80, 610	81, 250	81, 890	82, 550	83, 210	83, 880	84, 560	85, 240	85, 930	86, 630	87, 330	47	
48	77, 840	78, 440	79, 030	79, 620	80, 200	80, 780	81, 360	81, 930	82, 530	83, 160	83, 810	84, 470	85, 140	85, 820	86, 510	87, 210	87, 910	88, 620	89, 340	90, 060	90, 790	48	
49	80, 760	81, 380	82, 000	82, 620	83, 230	83, 840	84, 440	85, 040	85, 670	86, 320	87, 000	87, 680	88, 380	89, 090	89, 810	90, 530	91, 260	92, 000	92, 740	93, 490	94, 250	49	
50	84, 780	85, 440	86, 080	86, 730	87, 370	88, 000	88, 630	89, 260	89, 900	90, 560	91, 240	91, 920	92, 600	93, 300	93, 990	94, 690	95, 390	96, 100	96, 810	97, 520	98, 240	50	
51	87, 700	88, 380	89, 060	89, 730	90, 390	91, 060	91, 720	92, 370	93, 040	93, 730	94, 430	95, 140	95, 850	96, 570	97, 290	98, 020	98, 750	99, 480	100, 200	101, 000	101, 700	51	
52	90, 620	91, 330	92, 030	92, 730	93, 420	94, 110	94, 800	95, 480	96, 180	96, 890	97, 620	98, 350	99, 090	99, 840	100, 600	101, 300	102, 100	102, 900	103, 600	104, 400	105, 100	52	
53	93, 530	94, 270	95, 000	95, 730	96, 450	97, 170	97, 880	98, 590	99, 320	100, 100	100, 800	101, 600	102, 300	103, 100	103, 900	104, 700	105, 500	106, 200	107, 000	107, 800	108, 600	53	
54	96, 450	97, 210	97, 970	98, 730	99, 480	100, 200	101, 000	101, 700	102, 500	103, 200	104, 000	104, 800	105, 600	106, 400	107, 200	108, 000	108, 800	109, 600	110, 400	111, 200	112, 100	54	
55	99, 370	100, 200	100, 900	101, 700	102, 500	103, 300	104, 000	104, 800	105, 600	106, 400	107, 200	108, 000	108, 800	109, 700	110, 500	111, 300	112, 200	113, 000	113, 800	114, 700	115, 500	55	
56	102, 300	103, 100	103, 900	104, 800	105, 500	106, 300	107, 100	107, 900	108, 700	109, 500	110, 400	111, 200	112, 000	112, 900	113, 700	114, 600	115, 400	116, 300	117, 200	118, 000	118, 900	56	
57	105, 200	106, 100	106, 900	107, 800	108, 600	109, 400	110, 200	111, 000	111, 900	112, 700	113, 600	114, 400	115, 300	116, 200	117, 000	117, 900	118, 800	119, 700	120, 600	121, 500	122, 300	57	
58	109, 400	110, 400	111, 400	112, 300	113, 300	114, 200	115, 200	116, 100	117, 100	118, 100	119, 100	120, 100	121, 100	122, 100	123, 100	124, 100	125, 100	126, 200	127, 200	128, 200	129, 300	58	
59	113, 600	114, 700	115, 800	116, 900	118, 000	119, 100	120, 200	121, 200	122, 300	123, 400	124, 600	125, 700	126, 800	128, 000	129, 200	130, 300	131, 500	132, 600	133, 800	135, 000	136, 200	59	
60	117, 800	119, 100	120, 300	121, 500	122, 700	123, 900	125, 100	126, 300	127, 600	128, 800	130, 100	131, 400	132, 600	133, 900	135, 200	136, 500	137, 800	139, 100	140, 400	141, 800	143, 100	60	
61	122, 000	123, 400	124, 700	126, 100	127, 400	128, 800	130, 100	131, 400	132, 800	134, 200	135, 600	137, 000	138, 400	139, 800	141, 300	142, 700	144, 200	145, 600	147, 100	148, 500	150, 000	61	
62	126, 200	127, 700	129, 200	130, 700	132, 100	133, 600	135, 100	136, 500	138, 000	139, 600	141, 100	142, 600	144, 200	145, 800	147, 300	148, 900	150, 500	152, 100	153, 700	155, 300	156, 900	62	
63	130, 400	132, 000	133, 600	135, 200	136, 800	138, 400	140, 000	141, 700	143, 300	144, 900	146, 600	148, 300	150, 000	151, 700	153, 400	155, 100	156, 800	158, 600	160, 300	162, 100	163, 900	63	
64	134, 600	136, 400	138, 100	139, 800	141, 500	143, 300	145, 000	146, 800	148, 500	150, 300	152, 100	153, 900	155, 800	157, 600	159, 500	161, 300	163, 200	165, 100	167, 000	168, 900	170, 800	64	
65	138, 800	140, 700	142, 500	144, 400	146, 300	148, 100	150, 000	151, 900	153, 800	155, 700	157, 600	159, 600	161, 500	163, 500	165, 500	167, 500	169, 500	171, 600	173, 600	175, 600	177, 700	65	
66	142, 900	144, 700	146, 600	148, 500	150, 400	152, 300	154, 200	156, 100	158, 000	159, 900	161, 900	163, 800	165, 800	167, 800	169, 700	171, 700	173, 700	175, 700	177, 700	180, 000	181, 700	66	
67	145, 800	147, 700	149, 600	151, 500	153, 400	155, 300	157, 300	159, 200	161, 100	163, 100	165, 000	167, 000	169, 000	171, 000	173, 000	175, 000	177, 000	179, 000	181, 100	183, 100	185, 100	67	
68	150, 000	152, 000	154, 000	156, 100	158, 100	160, 200	162, 200	164, 300	166, 400	168, 500	170, 600	172, 700	174, 800	176, 900	179, 100	181, 200	183, 400	185, 500	187, 700	189, 900	192, 100	68	
69	154, 200	156, 300	158, 500	160, 700	162, 800	165, 000	167, 200	169, 400	171, 600	173, 800	176, 100	178, 300	180, 600	182, 800	185, 100	187, 400	189, 700	192, 000	194, 300	196, 600	199, 000	69	
70	158, 400	160, 700	162, 900	165, 200	167, 500	169, 900	172, 200	174, 500	176, 800	179, 200	181, 600	184, 000	186, 300	188, 800	191, 200	193, 600	196, 000	198, 500	200, 900	203, 400	205, 900	70	
71	162, 600	165, 000	167, 400	169, 800	172, 300	174, 700	177, 100	179, 600	182, 100	184, 600	187, 100	189, 600	192, 100	194, 700	197, 200	199, 800	202, 400	205, 000	207, 600	210, 200	212, 800	71	
72	166, 800	169, 300	171, 800	174, 400	177, 000	179, 500	182, 100	184, 700	187, 300	189, 900	192, 600	195, 200	197, 900	200, 600	203, 300	206, 000	208, 700	211, 500	214, 200	217, 000	219, 700	72	
73	173, 900	176, 600	179, 300	182, 000	184, 700	187, 400	190, 200	192, 900	195, 700	198, 500	201, 300	204, 100	206, 900	209, 800	212, 600	215, 500	218, 400	221, 300	224, 200	227, 200	230, 100	73	
74	181, 000	183, 800	186, 700	189, 600	192, 400	195, 300	198, 200	201, 100	204, 100	207, 000	210, 000	213, 000	216, 000	219, 000	222, 000	225, 100	228, 100	231, 200	234, 300	237, 400	240, 500	74	
75	185, 200	188, 200	191, 200	194, 100	197, 100	200, 200	203, 200	206, 200	209, 300	212, 400	215, 500	218, 600	221, 700	224, 900	228, 100	231, 300	234, 500	237, 700	240, 900	244, 100	247, 400	75	
77	190, 300	193, 100	195, 900	198, 700	201, 500	204, 300	207, 200	210, 000	212, 900	215, 800	218, 800	221, 700	224, 700	227, 700	230, 700	233, 800	236, 800	239, 900	243, 000	246, 100	249, 200	77	
78	194, 500	197, 400	200, 300	203, 300	206, 200	209, 200	212, 200	215, 100	218, 200	221, 200	224, 300	227, 400	230, 500	233, 600	236, 800	240, 000	243, 200	246, 400	249, 600	252, 800	256, 100	78	
79	201, 400	204, 400	207, 400	210, 400	213, 400	216, 400	219, 400	222, 500	225, 500	228, 600	231, 700	234, 800	238, 000	241, 100	244, 300	247, 500	250, 600	253, 800	257, 100	260, 300	263, 500	79	
80	205, 600	208, 700	211, 800	214, 900	218, 100	221, 200	224, 400	227, 600	230, 800	234, 000	237, 200	240, 500	243, 800	247, 000	250, 300	253, 700	257, 000	260, 300	263, 700	267, 100	270, 500	80	
82	210, 700	213, 600	216, 500	219, 500	222, 400	225, 400	228, 400	231, 400	234, 400	237, 500	240, 500	243, 600	246, 700	249, 900	253, 000	256, 200	259, 300	262, 500	265, 800	269, 000	272, 200	82	
83	214, 900	217, 900	221, 000	224, 100	227, 100	230, 200	233, 400	236, 500	239, 600	242, 800	246, 000	249, 300	252, 500	255, 800	259, 100	262, 400	265, 700	269, 000	272, 400	275, 800	279, 100	83	
84	226, 000	229, 200	232, 500	235, 800	239, 000	242, 300	245, 600	248, 900	252, 200	255, 600	259, 000	262, 400	265, 800	269, 200	272, 600	276, 100	279, 500	283, 000	286, 500	290, 000	293, 500	84	
86	235, 300	238, 500	241, 700	244, 900	248, 100	251, 300	254, 600	257, 800	261, 100	264, 400	267, 800	271, 100	274, 500	277, 90									

# GUNTERSVILLE DAM SPILLWAY DISCHARGE IN CUBIC FEET PER SECOND

GATE NUMBER	HEADWATER ELEVATION																				GATE NUMBER	
	594.0	594.2	594.4	594.6	594.8	595.0	595.2	595.4	595.6	595.8	596.0	596.2	596.4	596.6	596.8	597.0	597.2	597.4	597.6	597.8		598.0
104	366,300	370,200	374,100	378,100	382,000	386,000	390,000	394,000	398,000	402,000	406,100	410,100	414,200	418,300	422,400	426,600	430,700	434,800	439,000	443,200	447,300	104
105	377,400	381,500	385,600	389,800	393,900	398,100	402,200	406,400	410,600	414,800	419,000	423,200	427,500	431,700	436,000	440,200	444,500	448,800	453,100	457,400	461,700	105
106	380,800	384,800	388,800	392,800	396,900	400,900	404,900	409,000	413,100	417,200	421,300	425,500	429,700	433,900	438,200	442,400	446,600	450,900	455,200	459,500	463,800	106
107	403,100	407,500	411,800	416,200	420,600	425,000	429,400	433,800	438,300	442,700	447,200	451,700	456,200	460,700	465,200	469,800	474,300	478,800	483,400	487,900	492,500	107
108	413,400	417,700	422,000	426,400	430,700	435,000	439,400	443,800	448,200	452,600	457,000	461,500	465,900	470,400	474,900	479,400	483,900	488,400				108
109	424,600	429,100	433,500	438,100	442,600	447,100	451,600	456,200	460,800	465,300	469,900	474,600	479,200	483,800	488,400							109
110	434,900	439,300	443,800	448,200	452,700	457,200	461,600	466,100	470,600	475,200	479,700	484,300	488,900									110
111	446,000	450,700	455,300	459,900	464,600	469,200	473,900	478,500	483,200	487,900												111
112	454,700	459,200	463,700	468,300	472,800	477,400	481,900	486,500	491,100													112
113	478,700	483,600	488,500																			113
114	489,000																					114

HEADWATER 594 to 598  
TAILWATER 579.51 to 580.50

MARCH 2004

**GUNTERSVILLE DAM  
SPILLWAY DISCHARGE  
IN CUBIC FEET PER SECOND**

GATE NUMBER	HEADWATER ELEVATION																				GATE NUMBER		
	598.0	598.2	598.4	598.6	598.8	599.0	599.2	599.4	599.6	599.8	600.0	600.2	600.4	600.6	600.8	601.0	601.2	601.4	601.6	601.8		602.0	
37																						37	
38																							38
39																							39
40	64,910	65,450	65,990	66,570	67,190	67,840	68,500	69,190	69,900	70,610	71,340											40	
41	66,590	67,140	67,700	68,280	68,880	69,510	70,150	70,810	71,480	72,160	72,850											41	
42	70,050	70,620	71,210	71,810	72,440	73,100	73,760	74,450	75,140	75,850	76,560											42	
43	73,500	74,110	74,710	75,350	76,000	76,680	77,380	78,080	78,800	79,530	80,280											43	
44	76,960	77,590	78,220	78,880	79,570	80,270	80,990	81,720	82,470	83,220	83,990											44	
45	80,420	81,070	81,730	82,410	83,130	83,850	84,600	85,360	86,130	86,910	87,700											45	
46	83,870	84,560	85,240	85,950	86,690	87,440	88,210	89,000	89,790	90,600	91,420											46	
47	87,330	88,040	88,750	89,480	90,250	91,030	91,820	92,630	93,450	94,290	95,130											47	
48	90,790	91,520	92,260	93,020	93,810	94,610	95,430	96,270	97,120	97,980	98,840											48	
49	94,250	95,000	95,770	96,550	97,370	98,200	99,050	99,910	100,800	101,700	102,600											49	
50	98,240	98,950	99,670	100,400	101,200	102,000	102,700	103,500	104,400	105,200	106,000											50	
51	101,700	102,400	103,200	103,900	104,700	105,500	106,400	107,200	108,000	108,900	109,700											51	
52	105,100	105,900	106,700	107,500	108,300	109,100	110,000	110,800	111,700	112,600	113,400											52	
53	108,600	109,400	110,200	111,000	111,900	112,700	113,600	114,500	115,300	116,200	117,000											53	
54	112,100	112,900	113,700	114,500	115,400	116,300	117,200	118,100	119,000	119,900	120,900											54	
55	115,500	116,400	117,200	118,100	119,000	119,900	120,800	121,700	122,700	123,600	124,600											55	
56	118,900	119,800	120,600	121,500	122,400	123,200	124,100	125,000	125,800	126,700	127,600											56	
57	122,300	123,200	124,100	125,000	125,900	126,800	127,700	128,600	129,500	130,400	131,300											57	
58	129,300	130,300	131,300	132,400	133,400	134,500	135,500	136,600	137,600	138,700	139,800											58	
59	136,200	137,400	138,600	139,700	140,900	142,100	143,400	144,600	145,800	147,000	148,200											59	
60	143,100	144,400	145,800	147,100	148,500	149,800	151,200	152,500	153,900	155,300	156,700											60	
61	150,000	151,500	153,000	154,500	156,000	157,500	159,000	160,500	162,000	163,600	165,100											61	
62	156,900	158,600	160,200	161,800	163,500	165,100	166,800	168,500	170,200	171,900	173,600											62	
63	163,900	165,600	167,400	169,200	171,000	172,800	174,600	176,500	178,300	180,200	182,000											63	
64	170,800	172,700	174,600	176,600	178,500	180,500	182,500	184,400	186,400	188,400	190,500											64	
65	177,700	179,800	181,800	183,900	186,000	188,100	190,300	192,400	194,600	196,700	198,900											65	
66	181,700	183,700	185,700	187,800	189,800	191,900	194,000	196,100	198,200	200,300	202,400											66	
67	185,100	187,200	189,200	191,300	193,400	195,500	197,600	199,700	201,800	203,900	206,100											67	
68	192,100	194,300	196,500	198,700	200,900	203,100	205,400	207,700	210,000	212,200	214,500											68	
69	199,000	201,300	203,700	206,000	208,400	210,800	213,200	215,700	218,100	220,500	223,000											69	
70	205,900	208,400	210,900	213,400	215,900	218,500	221,000	223,600	226,200	228,800	231,400											70	
71	212,800	215,400	218,100	220,800	223,400	226,100	228,900	231,600	234,400	237,100	239,900											71	
72	219,700	222,500	225,300	228,100	230,900	233,800	236,700	239,600	242,500	245,400	248,300											72	
73	230,100	233,100	236,000	239,000	242,000	245,100	248,100	251,200	254,300	257,400	260,500											73	
74	240,500	243,600	246,800	249,900	253,100	256,300	259,600	262,800	266,100	269,400	272,700											74	
75	247,400	250,700	254,000	257,300	260,600	264,000	267,400	270,800	274,200	277,700	281,100											75	
77	249,200	252,300	255,400	258,600	261,800	265,000	268,200	271,500	274,800	278,100	281,400											77	
78	256,100	259,400	262,700	266,000	269,300	272,700	276,100	279,500	282,900	286,300	289,800											78	
79	263,500	266,800	270,100	273,300	276,700	280,000	283,400	286,800	290,100	293,600	297,000											79	
80	270,500	273,900	277,300	280,700	284,200	287,700	291,200	294,700	298,300	301,800	305,400											80	
82	272,200	275,500	278,700	282,000	285,300	288,700	292,100	295,400	298,800	302,300	305,700											82	
83	279,100	282,500	286,000	289,400	292,900	296,400	299,900	303,400	307,000	310,500	314,100											83	
84	293,500	297,000	300,600	304,100	307,700	311,400	315,000	318,700	322,400	326,000	329,700											84	
86	302,200	305,700	309,300	312,800	316,400	320,100	323,700	327,400	331,000	334,700	338,400											86	
87	316,600	320,200	323,900	327,600	331,300	335,100	338,800	342,600	346,400	350,200	354,100											87	
89	325,200	328,900	332,600	336,300	340,000	343,700	347,500	351,300	355,100	358,900	362,800											89	
90	339,600	343,400	347,200	351,000	354,900	358,800	362,700	366,600	370,500	374,400	378,400											90	
92	348,300	352,100	355,900	359,700	363,600	367,400	371,300	375,300	379,200	383,100	387,100											92	
93	362,700	366,600	370,500	374,400	378,400	382,400	386,500	390,500	394,600	398,600	402,700											93	
95	373,100	376,900	380,800	384,800	388,700	392,700	396,700	400,700	404,700	408,700	412,800											95	
96	387,400	391,400	395,500	399,500	403,600	407,700	411,800	415,900	420,100	424,200	428,400											96	
98	397,800	401,800	405,800	409,800	413,800	417,900	422,000	426,100	430,200	434,300	438,400											98	

MARCH 2004

HEADWATER 598 to 602  
TAILWATER 579.51 to 580.50



# GUNTERSVILLE DAM SPILLWAY DISCHARGE IN CUBIC FEET PER SECOND

DATE ELEMENT	HEADWATER ELEVATION																				DATE ELEMENT	
	598.0	598.2	598.4	598.6	598.8	599.0	599.2	599.4	599.6	599.8	600.0	600.2	600.4	600.6	600.8	601.0	601.2	601.4	601.6	601.8		602.0
99	412,200	416,300	420,400	424,600	428,700	432,900	437,100	441,300	445,600	449,800	454,000											99
101	422,600	426,700	430,800	434,900	439,000	443,100	447,300	451,500	455,700	459,900	464,100											101
102	436,900	441,200	445,400	449,600	453,900	458,100	462,400	466,700	471,100	475,400	479,700											102
104	447,300	451,500	455,700	459,900	464,100	468,400	472,600	476,900	481,200	485,500	489,700											104
105	461,700	466,000	470,300	474,700	479,000	483,400	487,800	492,100														105
106	463,800	468,100	472,400	476,800	481,100	485,500	489,900															106
107	492,500																					107

HEADWATER 598 to 602  
TAILWATER 579.51 to 580.50

MARCH 2004

**GUNTERSVILLE DAM  
SPILLWAY DISCHARGE  
IN CUBIC FEET PER SECOND**

		590.0	590.2	590.4	590.6	590.8	591.0	591.2	591.4	591.6	591.8	592.0	592.2	592.4	592.6	592.8	593.0	593.2	593.4	593.6			593.8	594.0		
49																							79,240	49		
50															79,090	79,780	80,470	81,150	81,830	82,510	83,180		83,180	50		
51															81,790	82,520	83,240	83,950	84,660	85,360	86,060		86,060	51		
52															84,500	85,250	86,000	86,740	87,480	88,220	88,950		88,950	52		
54		79,200	80,020	80,830	81,640	82,430	83,220	84,040	84,890	85,740	86,590	87,420	88,260	89,080	89,900	90,720	91,530	92,330	93,130	93,930	94,710		94,710	54		
55	80,670	81,530	82,370	83,210	84,040	84,860	85,670	86,520	87,410	88,290	89,160	90,030	90,900	91,750	92,600	93,450	94,290	95,130	95,960	96,780	97,600		97,600	55		
56	83,230	84,110	84,970	85,830	86,680	87,520	88,350	89,210	90,120	91,020	91,920	92,800	93,690	94,560	95,430	96,300	97,160	98,010	98,860	99,700	100,500		100,500	56		
57	85,530	86,430	87,320	88,210	89,080	89,940	90,800	91,700	92,640	93,570	94,490	95,410	96,330	97,230	98,130	99,030	99,920	100,800	101,700	102,600	103,400		103,400	57		
58	87,360	88,370	89,380	90,370	91,360	92,340	93,310	94,320	95,370	96,410	97,450	98,490	99,520	100,500	101,600	102,600	103,600	104,600	105,600	106,600	107,600		107,600	58		
59	89,200	90,320	91,430	92,540	93,640	94,730	95,810	96,940	98,100	99,260	100,400	101,600	102,700	103,900	105,000	106,100	107,200	108,400	109,500	110,600	111,700		111,700	59		
60	91,040	92,270	93,490	94,700	95,910	97,120	98,320	99,560	100,800	102,100	103,400	104,600	105,900	107,200	108,400	109,700	110,900	112,100	113,400	114,600	115,900		115,900	60		
61	92,880	94,210	95,540	96,870	98,190	99,510	100,800	102,200	103,600	104,900	106,300	107,700	109,100	110,500	111,800	113,200	114,600	115,900	117,300	118,600	120,000		120,000	61		
62	94,720	96,160	97,600	99,030	100,500	101,900	103,300	104,800	106,300	107,800	109,300	110,800	112,300	113,800	115,300	116,700	118,200	119,700	121,200	122,700	124,100		124,100	62		
63	96,560	98,100	99,650	101,200	102,700	104,300	105,800	107,400	109,000	110,600	112,200	113,900	115,500	117,100	118,700	120,300	121,900	123,500	125,100	126,700	128,300		128,300	63		
64	98,390	100,000	101,700	103,400	105,000	106,700	108,300	110,000	111,800	113,500	115,200	116,900	118,700	120,400	122,100	123,800	125,500	127,300	129,000	130,700	132,400		132,400	64		
65	100,200	102,000	103,800	105,500	107,300	109,100	110,900	112,700	114,500	116,300	118,200	120,000	121,900	123,700	125,500	127,400	129,200	131,000	132,900	134,700	136,600		136,600	65		
66	103,600	105,400	107,200	109,000	110,800	112,600	114,400	116,200	118,100	119,900	121,800	123,700	125,600	127,400	129,300	131,200	133,000	134,900	136,800	138,600	140,500		140,500	66		
67	105,900	107,700	109,500	111,300	113,200	115,000	116,800	118,700	120,600	122,500	124,400	126,300	128,200	130,100	132,000	133,900	135,800	137,700	139,600	141,500	143,400		143,400	67		
68	107,700	109,600	111,600	113,500	115,400	117,400	119,300	121,300	123,300	125,300	127,300	129,400	131,400	133,400	135,400	137,400	139,500	141,500	143,500	145,500	147,600		147,600	68		
69	109,500	111,600	113,600	115,700	117,700	119,800	121,900	123,900	126,100	128,200	130,300	132,400	134,600	136,700	138,900	141,000	143,100	145,300	147,400	149,500	151,700		151,700	69		
70	111,400	113,500	115,700	117,800	120,000	122,200	124,400	126,600	128,800	131,000	133,300	135,500	137,800	140,000	142,300	144,500	146,800	149,000	151,300	153,600	155,800		155,800	70		
71	113,200	115,500	117,700	120,000	122,300	124,600	126,900	129,200	131,500	133,900	136,200	138,600	141,000	143,400	145,700	148,100	150,400	152,800	155,200	157,600	160,000		160,000	71		
72	115,100	117,400	119,800	122,200	124,600	127,000	129,400	131,800	134,300	136,700	139,200	141,700	144,200	146,700	149,100	151,600	154,100	156,600	159,100	161,600	164,100		164,100	72		
73	119,200	121,700	124,200	126,700	129,200	131,800	134,300	136,900	139,500	142,100	144,700	147,300	150,000	152,600	155,300	157,900	160,500	163,200	165,800	168,500	171,200		171,200	73		
74	123,300	126,000	128,600	131,300	133,900	136,600	139,300	142,000	144,700	147,500	150,300	153,000	155,800	158,600	161,400	164,200	167,000	169,700	172,600	175,400	178,200		178,200	74		
75	125,200	127,900	130,600	133,400	136,200	139,000	141,800	144,600	147,500	150,300	153,200	156,100	159,000	161,900	164,800	167,700	170,600	173,500	176,500	179,400	182,300		182,300	75		
76	127,700	130,200	132,800	135,400	137,900	140,500	143,200	145,800	148,400	151,100	153,800	156,500	159,200	161,900	164,600	167,300	170,000	172,700	175,500	178,200	181,000		181,000	76		
77	133,300	135,900	138,500	141,200	143,800	146,500	149,100	151,800	154,500	157,200	160,000	162,700	165,500	168,200	171,000	173,700	176,400	179,200	181,900	184,700	187,500		187,500	77		
78	135,200	137,900	140,600	143,300	146,100	148,900	151,700	154,500	157,300	160,100	162,900	165,800	168,600	171,500	174,400	177,200	180,100	182,900	185,800	188,700	191,600		191,600	78		
79	140,800	143,600	146,300	149,100	152,000	154,800	157,600	160,500	163,400	166,200	169,100	172,100	175,000	177,900	180,800	183,800	186,700	189,600	192,500	195,500	198,400		198,400	79		
80	142,600	145,500	148,400	151,300	154,200	157,200	160,100	163,100	166,100	169,100	172,100	175,100	178,200	181,200	184,300	187,300	190,300	193,400	196,400	199,500	202,600		202,600	80		
81	145,100	147,800	150,500	153,300	156,000	158,700	161,500	164,200	167,000	169,800	172,600	175,400	178,200	181,100	184,000	187,000	190,000	193,000	196,000	199,000	202,100		202,100	81		
82	150,800	153,500	156,300	159,100	161,900	164,700	167,500	170,300	173,100	176,000	178,900	181,700	184,600	187,500	190,400	193,300	196,200	199,100	202,000	204,900	207,800		207,800	82		
83	152,600	155,500	158,300	161,200	164,100	167,000	170,000	172,900	175,900	178,800	181,800	184,800	187,800	190,800	193,800	196,800	199,800	202,800	205,800	208,800	211,900		211,900	83		
84	160,100	163,100	166,200	169,200	172,300	175,400	178,500	181,600	184,700	187,800	191,000	194,200	197,400	200,500	203,700	206,900	210,000	213,200	216,400	219,600	222,800		222,800	84		
85	162,600	165,400	168,300	171,200	174,000	176,900	179,800	182,700	185,600	188,600	191,600	194,600	197,600	200,700	203,800	206,800	209,900	212,900	216,000	219,100	222,200		222,200	85		
86	170,100	173,100	176,100	179,100	182,200	185,200	188,300	191,400	194,500	197,600	200,700	203,800	206,900	210,000	213,100	216,200	219,300	222,400	225,500	228,600	231,700		231,700	86		
87	177,500	180,700	183,900	187,100	190,300	193,500	196,800	200,000	203,300	206,600	209,900	213,200	216,500	219,800	223,100	226,400	229,700	233,000	236,400	239,700	243,100		243,100	87		
88	180,100	183,000	186,000	189,000	192,100	195,100	198,100	201,200	204,300	207,300	210,400	213,500	216,600	219,700	222,800	225,900	229,000	232,100	235,200	238,300	241,400		241,400	88		
89	187,500	190,700	193,800	197,000	200,200	203,400	206,600	209,800	213,100	216,300	219,600	222,900	226,100	229,400	232,700	235,900	239,200	242,500	245,800	249,100	252,400		252,400	89		
90	195,000	198,300	201,700	205,000	208,400	211,700	215,100	218,500	221,900	225,300	228,800	232,200	235,700	239,200	242,600	246,000	249,500	252,900	256,400	259,900	263,300		263,300	90		
92	205,000	208,300	211,600	214,900	218,200	221,600	224,900	228,300	231,700	235,100	238,500	241,900	245,300	248,700	252,100	255,500	258,900	262,300	265,700	269,200	272,600		272,600	92		
93	212,500	215,900	219,400	222,900	226,400	229,900	233,400	237,000	240,500	244,100	247,700	251,300	254,900	258,500	262,000	265,600	269,200	272,800	276,400	280,000	283,600		283,600	93		
9																										

## GUNTERSVILLE DAM SPILLWAY DISCHARGE IN CUBIC FEET PER SECOND

GATE NUMBER	HEADWATER ELEVATION																				GATE NUMBER	
	590.0	590.2	590.4	590.6	590.8	591.0	591.2	591.4	591.6	591.8	592.0	592.2	592.4	592.6	592.8	593.0	593.2	593.4	593.6	593.8		594.0
109	330,700	335,100	339,600	344,000	348,500	353,000	357,400	361,900	366,400	370,900	375,400	379,900	384,400	388,800	393,300	397,700	402,200	406,600	411,100	415,600	420,000	109
110	341,900	346,300	350,700	355,100	359,500	364,000	368,400	372,900	377,300	381,800	386,200	390,700	395,100	399,500	404,000	408,400	412,800	417,200	421,600	426,000	430,400	110
111	349,300	353,900	358,500	363,100	367,700	372,300	376,900	381,600	386,200	390,800	395,400	400,000	404,700	409,300	413,900	418,400	423,000	427,600	432,200	436,800	441,400	111
112	359,500	364,000	368,500	373,100	377,600	382,200	386,700	391,300	395,800	400,400	405,000	409,500	414,000	418,500	423,100	427,600	432,100	436,600	441,100	445,600	450,100	112
113	375,400	380,300	385,200	390,100	395,000	400,000	404,900	409,800	414,800	419,700	424,600	429,600	434,500	439,400	444,300	449,200	454,100	459,000	463,900	468,800	473,700	113
114	386,600	391,400	396,300	401,200	406,100	411,000	415,900	420,800	425,700	430,600	435,500	440,400	445,300	450,100	455,000	459,800	464,700	469,500	474,300	479,200	484,000	114
115	394,100	399,100	404,100	409,200	414,200	419,300	424,400	429,500	434,500	439,600	444,700	449,700	454,800	459,800	464,900	469,900	474,900	479,900	484,900	489,000	495,000	115
116	404,200	409,200	414,100	419,100	424,100	429,200	434,200	439,200	444,200	449,200	454,200	459,200	464,200	469,100	474,100	479,000	484,000	488,900	493,800	498,800	503,700	116
117	412,700	417,800	423,000	428,200	433,400	438,600	443,900	449,100	454,300	459,500	464,700	469,900	475,100	480,300	485,400	490,600	495,700	500,900				117
118	430,300	435,600	440,900	446,200	451,500	456,800	462,100	467,500	472,800	478,100	483,400	488,700	494,000	499,300	504,500							118
119	448,900	454,300	459,800	465,200	470,700	476,200	481,600	487,100	492,600	498,000	503,500											119
120	466,500	472,100	477,600	483,200	488,800	494,300	499,900	505,500														120

HEADWATER 590 to 594  
TAILWATER 580.51 to 581.50

MARCH 2004

# GUNTERSVILLE DAM SPILLWAY DISCHARGE IN CUBIC FEET PER SECOND

GATE #	HEADWATER ELEVATION																				GATE #
	594.0	594.2	594.4	594.6	594.8	595.0	595.2	595.4	595.6	595.8	596.0	596.2	596.4	596.6	596.8	597.0	597.2	597.4	597.6	597.8	
45																79,230	79,880	80,540	81,210	81,890	79,140
46																82,530	83,210	83,900	84,590	85,300	82,400
47																86,540	87,250	87,980	88,700	89,440	86,000
48	79,240	79,870	80,510	81,140	81,760	82,380	82,990	83,600	84,230	84,890	85,570	86,260	86,970	87,680	88,400	89,130	89,870	90,610	91,360	88,700	
49																					92,110
50	83,180	83,840	84,500	85,160	85,810	86,460	87,100	87,730	88,380	89,050	89,730	90,410	91,100	91,800	92,500	93,210	93,910	94,630	95,340	96,060	96,780
51	86,060	86,760	87,450	88,130	88,820	89,490	90,160	90,820	91,490	92,190	92,890	93,610	94,330	95,050	95,780	96,510	97,240	97,980	98,720	99,460	100,200
52	88,950	89,670	90,390	91,110	91,820	92,530	93,220	93,910	94,610	95,330	96,060	96,800	97,550	98,300	99,050	99,810	100,600	101,300	102,100	102,900	103,600
53	91,830	92,580	93,330	94,080	94,820	95,560	96,280	96,990	97,720	98,470	99,230	100,000	100,800	101,500	102,300	103,100	103,900	104,700	105,500	106,300	107,100
54	94,710	95,500	96,280	97,050	97,820	98,590	99,340	100,100	100,800	101,600	102,400	103,200	104,000	104,800	105,600	106,400	107,200	108,000	108,900	109,700	110,500
55	97,600	98,410	99,220	100,000	100,800	101,600	102,400	103,200	104,000	104,800	105,600	106,400	107,200	108,000	108,900	109,700	110,600	111,400	112,200	113,100	113,900
56	100,500	101,400	102,200	103,000	103,800	104,600	105,400	106,200	107,000	107,900	108,700	109,500	110,400	111,200	112,100	112,900	113,800	114,700	115,500	116,400	117,300
57	103,400	104,300	105,100	106,000	106,800	107,700	108,500	109,300	110,200	111,000	111,900	112,700	113,600	114,500	115,400	116,200	117,100	118,000	118,900	119,800	120,700
58	107,600	108,600	109,500	110,500	111,500	112,500	113,400	114,400	115,300	116,300	117,300	118,300	119,300	120,300	121,400	122,400	123,400	124,400	125,500	126,500	127,600
59	111,700	112,800	113,900	115,000	116,100	117,200	118,300	119,400	120,500	121,600	122,700	123,900	125,000	126,200	127,300	128,500	129,700	130,900	132,000	133,200	134,400
60	115,900	117,100	118,300	119,600	120,800	122,000	123,200	124,400	125,700	126,900	128,200	129,500	130,800	132,000	133,300	134,600	136,000	137,300	138,600	139,900	141,300
61	120,100	121,400	122,700	124,100	125,400	126,800	128,100	129,500	130,800	132,200	133,600	135,000	136,500	137,900	139,300	140,800	142,200	143,700	145,200	146,600	148,100
62	124,300	125,600	127,100	128,600	130,100	131,600	133,000	134,500	136,000	137,500	139,000	140,600	142,200	143,800	145,300	146,900	148,500	150,100	151,700	153,300	155,000
63	128,300	129,900	131,500	133,100	134,700	136,300	138,000	139,600	141,200	142,900	144,500	146,200	147,900	149,600	151,300	153,100	154,900	156,700	158,500	160,300	162,100
64	132,400	134,200	136,000	137,800	139,400	141,100	142,900	144,600	146,400	148,200	150,000	151,800	153,600	155,500	157,300	159,200	161,100	162,900	164,800	166,700	168,700
65	136,600	138,400	140,300	142,200	144,000	145,900	147,800	149,600	151,500	153,500	155,400	157,400	159,300	161,300	163,300	165,300	167,300	169,400	171,400	173,400	175,500
66	140,500	142,400	144,300	146,200	148,100	150,000	151,900	153,800	155,700	157,600	159,600	161,500	163,500	165,400	167,400	169,400	171,400	173,400	175,400	177,400	179,400
67	143,400	145,300	147,200	149,200	151,100	153,000	154,900	156,900	158,800	160,800	162,700	164,700	166,700	168,700	170,700	172,700	174,700	176,700	178,800	180,800	182,800
68	147,600	149,600	151,500	153,500	155,500	157,500	159,500	161,500	163,500	165,500	167,500	169,500	171,500	173,500	175,500	177,500	179,500	181,500	183,500	185,500	187,500
69	151,700	153,900	156,000	158,200	160,400	162,600	164,800	166,900	169,200	171,400	173,600	175,900	178,100	180,400	182,700	185,000	187,300	189,600	191,900	194,200	196,500
70	155,800	158,100	160,400	162,700	165,000	167,300	169,700	172,000	174,300	176,700	179,000	181,400	183,800	186,200	188,600	191,000	193,500	196,000	198,400	200,900	203,400
71	160,000	162,400	164,800	167,200	169,700	172,100	174,600	177,000	179,500	182,000	184,500	187,000	189,500	192,000	194,500	197,000	199,500	202,000	204,500	207,000	210,000
72	164,100	166,700	169,200	171,800	174,300	176,900	179,500	182,100	184,700	187,300	189,900	192,600	195,300	198,000	200,700	203,400	206,100	208,800	211,600	214,300	217,100
73	171,200	173,900	176,500	179,300	182,000	184,700	187,400	190,200	193,000	195,800	198,600	201,400	204,200	207,100	209,900	212,800	215,700	218,600	221,500	224,400	227,400
74	178,200	181,000	183,900	186,800	189,600	192,500	195,400	198,300	201,300	204,200	207,200	210,200	213,200	216,200	219,200	222,200	225,300	228,400	231,500	234,600	237,700
75	182,300	185,300	188,300	191,300	194,300	197,300	200,300	203,400	206,400	209,500	212,600	215,700	218,900	222,000	225,200	228,400	231,600	234,800	238,000	241,300	244,500
77	187,500	190,300	193,100	195,900	198,700	201,500	204,300	207,300	210,100	213,100	216,000	219,000	222,000	225,000	228,000	231,000	234,100	237,100	240,200	243,300	246,400
78	191,600	194,500	197,500	200,400	203,400	206,300	209,300	212,300	215,300	218,400	221,400	224,500	227,700	230,800	234,000	237,100	240,300	243,500	246,800	250,000	253,300
79	198,400	201,400	204,400	207,400	210,400	213,400	216,500	219,500	222,600	225,700	228,800	231,900	235,000	238,200	241,300	244,500	247,700	250,900	254,100	257,400	260,600
80	202,600	205,700	208,800	211,900	215,100	218,200	221,400	224,600	227,800	231,000	234,200	237,500	240,700	244,000	247,300	250,600	254,000	257,300	260,700	264,100	267,500
82	207,700	210,700	213,600	216,500	219,500	222,500	225,400	228,400	231,500	234,500	237,600	240,700	243,800	247,000	250,100	253,300	256,500	259,700	262,900	266,100	269,400
83	211,900	214,900	218,000	221,100	224,100	227,200	230,300	233,500	236,600	239,800	243,000	246,300	249,500	252,800	256,100	259,400	262,700	266,100	269,500	272,800	276,200
84	222,800	226,100	229,300	232,600	235,800	239,100	242,400	245,700	249,100	252,400	255,800	259,200	262,600	266,000	269,500	273,000	276,400	279,900	283,400	286,900	290,400
86	232,100	235,300	238,500	241,700	244,900	248,200	251,400	254,700	258,000	261,300	264,600	268,000	271,400	274,800	278,200	281,700	285,200	288,600	292,100	295,700	299,200
87	243,100	246,500	249,800	253,200	256,600	260,100	263,500	266,900	270,400	273,900	277,400	280,900	284,500	288,000	291,600	295,200	298,800	302,400	306,100	309,700	313,400
89	252,400	255,700	259,000	262,400	265,700	269,100	272,500	275,900	279,300	282,700	286,200	289,700	293,300	296,800	300,400	304,000	307,600	311,200	314,800	318,500	322,200
90	263,300	266,600	270,000	273,400	277,000	280,500	284,000	288,100	291,700	295,400	299,000	302,700	306,300	310,000	313,800	317,500	321,200	325,000	328,800	332,500	336,300
92	272,600	276,100	279,500	283,000	286,500	290,000	293,500	297,100	300,600	304,200	307,800	311,500	315,100	318,800	322,500	326,200	330,000	333,700	337,500	341,300	345,100
93	283,600	287,200	290,900	294,500	298,200	301,900	305,600	309,300	313,100	316,800	320,600	324,400	328,200	332,000	335,900	339,800	343,600	347,500	351,400	355,400	359,300
95	295,000	298,600	302,200	305,800	309,400	313,000	316,600	320,300	324,000	327,700	331,400	335,200	339,000	342,700	346,600	350,400	354,200	358,100	362,000	365,900	369,800
96	306,000	309,800	313,500	317,300	321,100	324,900	328,700	332,500	336,400	340,300	344,200	348,100	352,000	356,000	359,900	363,900	367,900	371,900	375,900	380,000	384,000
98	317,400	321,100	324,800	328,500	332,300	336,000	339,800	343,500	347,300	351,100	355,000	358,900	362,800	366,700	370,600	374,500	378,500	382,500	386,500	390,500	394,500
99	328,400	332,300	336,200	340,100	344,000	347,900	351,800	355,800	359,700	363,700	367,800	371,800	375,800	379,900	384,000</						

# GUNTERSVILLE DAM SPILLWAY DISCHARGE IN CUBIC FEET PER SECOND

GATE NUMBER	HEADWATER ELEVATION																			GATE NUMBER			
	594.0	594.2	594.4	594.6	594.8	595.0	595.2	595.4	595.6	595.8	596.0	596.2	596.4	596.6	596.8	597.0	597.2	597.4	597.6		597.8	598.0	
110	430,400	434,800	439,300	443,700	448,200	452,700	457,200	461,700	466,200	470,800	475,400	480,000	484,600	489,300	493,900	498,600	503,300	508,000					110
111	441,400	446,000	450,600	455,200	459,900	464,500	469,200	473,900	478,600	483,400	488,100	492,900	497,700	502,500	507,300								111
112	450,100	454,600	459,100	463,700	468,200	472,800	477,300	481,900	486,600	491,200	495,900	500,600	505,300										112
113	473,700	478,600	483,500	488,500	493,400	498,400	503,400																113
114	484,000	488,900	493,800	498,700	503,600																		114
115	495,000	500,100	505,100																				115
116	503,700																						116

HEADWATER 594 to 598  
TAILWATER 580.51 to 581.50

MARCH 2004

# GUNTERSVILLE DAM SPILLWAY DISCHARGE IN CUBIC FEET PER SECOND

GAINSE- MENT	HEADWATER ELEVATION																			GAINSE- MENT			
	598.0	598.2	598.4	598.6	598.8	599.0	599.2	599.4	599.6	599.8	600.0	600.2	600.4	600.6	600.8	601.0	601.2	601.4	601.6		601.8	602.0	
43																						43	
44																							44
45	79,140	79,800	80,460	81,150	81,860	82,600	83,350	84,110	84,880	85,670	86,470												45
46	82,570	83,250	83,950	84,660	85,400	86,160	86,930	87,720	88,520	89,330	90,160												46
47	86,000	86,710	87,430	88,170	88,940	89,720	90,520	91,330	92,160	93,000	93,850												47
48	89,440	90,170	90,910	91,680	92,470	93,280	94,110	94,950	95,800	96,660	97,540												48
49	92,870	93,630	94,400	95,190	96,010	96,850	97,700	98,560	99,440	100,300	101,200												49
50	96,780	97,500	98,220	98,960	99,730	100,500	101,300	102,100	102,900	103,800	104,600												50
51	100,200	101,000	101,700	102,500	103,300	104,100	104,900	105,700	106,600	107,400	108,300												51
52	103,600	104,400	105,200	106,000	106,800	107,600	108,500	109,300	110,200	111,100	112,000												52
53	107,100	107,900	108,700	109,500	110,300	111,200	112,100	113,000	113,900	114,800	115,700												53
54	110,500	111,300	112,200	113,000	113,900	114,800	115,700	116,600	117,500	118,400	119,400												54
55	113,900	114,800	115,600	116,500	117,400	118,300	119,300	120,200	121,100	122,100	123,100												55
56	117,300	118,100	119,000	119,900	120,800	121,600	122,500	123,400	124,300	125,200	126,000												56
57	120,700	121,600	122,500	123,400	124,300	125,200	126,100	127,000	127,900	128,800	129,700												57
58	127,600	128,600	129,600	130,700	131,700	132,800	133,900	134,900	136,000	137,000	138,100												58
59	134,400	135,600	136,800	138,000	139,200	140,400	141,600	142,800	144,000	145,300	146,500												59
60	141,300	142,600	143,900	145,300	146,600	148,000	149,400	150,700	152,100	153,500	154,900												60
61	148,100	149,600	151,100	152,600	154,100	155,600	157,100	158,600	160,200	161,700	163,200												61
62	155,000	156,600	158,200	159,900	161,500	163,200	164,900	166,500	168,200	169,900	171,600												62
63	161,800	163,600	165,400	167,200	169,000	170,800	172,600	174,400	176,300	178,100	180,000												63
64	168,700	170,600	172,500	174,400	176,400	178,400	180,400	182,300	184,300	186,400	188,400												64
65	175,500	177,600	179,700	181,700	183,800	186,000	188,100	190,300	192,400	194,600	196,700												65
66	179,400	181,400	183,500	185,500	187,600	189,600	191,700	193,800	195,900	198,000	200,100												66
67	182,800	184,900	187,000	189,000	191,100	193,200	195,300	197,400	199,500	201,700	203,800												67
68	189,700	191,900	194,100	196,300	198,500	200,800	203,100	205,300	207,600	209,900	212,200												68
69	196,500	198,900	201,200	203,600	206,000	208,400	210,800	213,200	215,700	218,100	220,600												69
70	203,400	205,900	208,400	210,900	213,400	216,000	218,600	221,100	223,700	226,300	228,900												70
71	210,300	212,900	215,500	218,200	220,900	223,600	226,300	229,000	231,800	234,600	237,300												71
72	217,100	219,900	222,700	225,500	228,300	231,200	234,100	237,000	239,900	242,800	245,700												72
73	227,400	230,300	233,300	236,300	239,300	242,300	245,400	248,500	251,600	254,700	257,800												73
74	237,700	240,800	243,900	247,100	250,300	253,500	256,700	260,000	263,300	266,500	269,800												74
75	244,500	247,800	251,100	254,400	257,700	261,100	264,500	267,900	271,300	274,800	278,200												75
76	253,300	256,600	259,900	263,200	266,500	269,900	273,300	276,700	280,100	283,600	287,000												76
77	260,600	263,900	267,200	270,400	273,800	277,100	280,500	283,900	287,300	290,700	294,100												77
78	267,500	270,900	274,300	277,700	281,200	284,700	288,200	291,800	295,300	298,900	302,500												78
79	276,200	279,700	283,100	286,500	290,000	293,500	297,000	300,600	304,200	307,700	311,300												79
80	290,400	294,000	297,500	301,100	304,700	308,300	312,000	315,700	319,400	323,100	326,800												80
81	299,200	302,700	306,300	309,900	313,500	317,100	320,800	324,500	328,200	331,900	335,600												81
82	313,400	317,100	320,800	324,500	328,200	332,000	335,800	339,600	343,400	347,200	351,000												82
83	322,200	325,800	329,500	333,200	337,000	340,800	344,600	348,400	352,200	356,000	359,900												83
84	336,300	340,200	344,000	347,800	351,700	355,600	359,500	363,400	367,400	371,300	375,300												84
85	345,100	349,000	352,800	356,600	360,500	364,400	368,300	372,200	376,200	380,200	384,200												85
86	359,300	363,200	367,200	371,200	375,200	379,200	383,300	387,300	391,400	395,500	399,600												86
87	369,800	373,700	377,700	381,600	385,600	389,600	393,600	397,700	401,700	405,800	409,800												87
88	384,000	388,100	392,100	396,200	400,300	404,400	408,600	412,700	416,900	421,100	425,300												88
89	394,500	398,500	402,600	406,600	410,700	414,800	418,900	423,100	427,200	431,400	435,500												89
90	408,700	412,900	417,000	421,200	425,400	429,600	433,900	438,100	442,400	446,700	451,000												90
91	419,200	423,300	427,500	431,700	435,800	440,000	444,200	448,500	452,700	457,000	461,200												91
92	433,400	437,700	441,900	446,200	450,500	454,900	459,200	463,600	467,900	472,300	476,700												92
93	443,900	448,200	452,400	456,700	460,900	465,200	469,600	473,900	478,200	482,500	486,900												93
94	458,100	462,500	466,900	471,200	475,700	480,100	484,500	489,000	493,400	497,900	502,300												94
95	488,800	493,400	498,100	502,700	507,400																		95
96	498,400	503,000	507,700																				96
97																							97
98																							98
99																							99
100																							100
101																							101
102																							102
103																							103
104																							104
105																							105
106																							106
107																							107
108																							108

MARCH 2004

HEADWATER 598 to 602  
TAILWATER 580.51 to 581.50

# GUNTERSVILLE DAM SPILLWAY DISCHARGE IN CUBIC FEET PER SECOND

GAUGE-MENT	HEADWATER ELEVATION																			GAUGE-MENT			
	590.0	590.2	590.4	590.6	590.8	591.0	591.2	591.4	591.6	591.8	592.0	592.2	592.4	592.6	592.8	593.0	593.2	593.4	593.6		593.8	594.0	
55																93,450	94,320	95,190	96,050	93,960	94,800	95,620	55
56																94,320	95,190	96,050	96,900	94,800	95,620	96,480	56
57																95,190	96,050	96,900	97,750	95,620	96,480	97,300	57
58																96,050	96,900	97,750	98,600	96,480	97,300	98,100	58
59								94,500	95,710	96,910	98,120	99,310	100,500	101,700	102,800	104,000	105,100	106,200	103,500	104,500	105,500	106,500	59
60						94,530	95,770	97,060	98,380	99,690	101,000	102,300	103,600	104,900	106,200	107,400	108,700	109,900	111,200	112,400	113,700	113,700	60
61						96,860	98,220	99,620	101,000	102,500	103,900	105,300	106,800	108,200	109,500	110,900	112,300	113,700	115,000	116,400	117,800	117,800	61
62						99,190	100,700	102,200	103,700	105,200	106,700	108,200	109,700	111,200	112,700	114,200	115,700	117,200	118,700	120,200	121,700	121,700	62
63				94,760	95,490	96,240	97,220	98,350	99,500	100,700	101,900	103,100	104,400	105,600	106,900	108,200	109,500	110,900	112,300	113,700	115,000	116,400	63
64	93,610	95,190	96,770	98,350	99,940	101,500	103,100	104,700	106,400	108,000	109,700	111,300	113,000	114,700	116,300	117,900	119,500	121,100	122,700	124,300	125,900	64	
65	97,200	98,980	100,800	102,600	104,400	106,200	108,000	109,900	111,700	113,600	115,500	117,400	119,300	121,100	123,000	124,800	126,700	128,500	130,400	132,300	134,100	134,100	65
66	100,400	102,200	104,100	105,900	107,700	109,600	111,400	113,300	115,200	117,100	119,000	121,000	122,900	124,800	126,700	128,600	130,400	132,300	134,200	136,100	138,000	138,000	66
67	102,700	104,500	106,400	108,200	110,100	112,000	113,800	115,700	117,600	119,500	121,400	123,300	125,200	127,100	129,000	130,900	132,700	134,600	136,500	138,400	140,300	140,300	67
68	104,500	106,400	108,400	110,300	112,300	114,300	116,300	118,300	120,300	122,400	124,500	126,500	128,600	130,700	132,700	134,700	136,700	138,800	140,800	142,800	144,800	144,800	68
69	106,200	108,300	110,400	112,400	114,500	116,600	118,700	120,900	123,000	125,200	127,400	129,500	131,700	133,900	136,100	138,200	140,300	142,500	144,700	146,800	148,900	148,900	69
70	108,000	110,200	112,400	114,500	116,700	119,000	121,200	123,400	125,700	128,000	130,200	132,500	134,800	137,100	139,400	141,700	143,900	146,200	148,500	150,800	153,100	153,100	70
71	109,800	112,100	114,400	116,700	119,000	121,300	123,600	126,000	128,400	130,700	133,100	135,500	138,000	140,400	142,800	145,200	147,500	149,900	152,300	154,700	157,200	157,200	71
72	111,600	114,000	116,400	118,800	121,200	123,600	126,100	128,500	131,000	133,500	136,000	138,500	141,000	143,600	146,100	148,600	151,100	153,600	156,100	158,600	161,200	161,200	72
73	113,700	118,200	122,700	123,200	125,800	128,300	130,900	133,500	136,200	138,800	141,500	144,200	146,800	149,500	152,200	154,800	157,400	160,100	162,700	165,400	168,100	168,100	73
74	115,700	122,300	125,000	127,600	130,300	133,000	135,800	138,500	141,300	144,100	146,900	149,700	152,500	155,400	158,200	161,000	163,800	166,600	169,400	172,200	175,100	175,100	74
75	121,500	124,200	127,000	129,800	132,600	135,400	138,200	141,100	144,000	146,900	149,800	152,700	155,600	158,600	161,500	164,400	167,400	170,300	173,200	176,200	179,200	179,200	75
76	124,200	126,700	129,300	131,900	134,500	137,100	139,700	142,400	145,100	147,700	150,400	153,100	155,800	158,500	161,300	164,000	166,800	169,600	172,400	175,200	178,100	178,100	76
77	129,600	132,200	134,900	137,500	140,200	142,900	145,600	148,300	151,000	153,700	156,400	159,100	161,800	164,500	167,300	170,000	172,700	175,500	178,200	181,000	183,800	183,800	77
78	131,400	134,100	136,900	139,600	142,400	145,200	148,000	150,800	153,700	156,500	159,400	162,300	165,200	168,100	171,000	173,900	176,800	179,700	182,600	185,500	188,500	188,500	78
79	136,900	139,700	142,500	145,300	148,100	151,000	153,800	156,700	159,600	162,600	165,500	168,500	171,400	174,400	177,400	180,300	183,300	186,200	189,200	192,200	195,100	195,100	79
80	138,700	141,600	144,500	147,400	150,300	153,300	156,300	159,300	162,300	165,400	168,400	171,500	174,600	177,700	180,800	183,900	186,900	189,900	193,000	196,100	199,200	199,200	80
81	141,400	144,100	146,800	149,500	152,200	155,000	157,800	160,600	163,400	166,200	169,100	172,000	174,900	177,800	180,700	183,600	186,500	189,400	192,300	195,200	198,100	198,100	81
82	146,800	149,600	152,300	155,100	157,900	160,800	163,700	166,500	169,400	172,300	175,200	178,100	181,000	184,000	186,900	189,800	192,700	195,600	198,500	201,500	204,400	204,400	82
83	148,600	151,500	154,400	157,300	160,200	163,100	166,100	169,000	172,000	175,000	178,100	181,100	184,200	187,200	190,300	193,300	196,400	199,400	202,500	205,500	208,500	208,500	83
84	155,900	158,900	161,900	165,000	168,100	171,200	174,300	177,500	180,700	183,800	187,100	190,300	193,500	196,700	200,000	203,200	206,400	209,600	212,800	216,100	219,300	219,300	84
85	158,500	161,400	164,200	167,100	170,000	172,900	175,800	178,800	181,800	184,700	187,700	190,700	193,700	196,700	199,700	202,700	205,700	208,700	211,700	214,700	217,700	217,700	85
86	165,800	168,800	171,800	174,900	178,000	181,000	184,100	187,200	190,300	193,400	196,500	199,600	202,700	205,800	208,900	211,900	215,000	218,100	221,100	224,200	227,200	227,200	86
87	173,000	176,200	179,400	182,600	185,900	189,100	192,400	195,700	199,000	202,300	205,700	209,100	212,400	215,800	219,200	222,500	225,900	229,300	232,600	236,000	239,400	239,400	87
88	175,700	178,700	181,700	184,700	187,800	190,800	193,900	197,000	200,100	203,200	206,300	209,400	212,500	215,600	218,700	221,800	224,900	228,000	231,100	234,200	237,300	237,300	88
89	183,000	186,100	189,300	192,500	195,700	198,900	202,200	205,400	208,700	212,000	215,300	218,700	222,000	225,400	228,700	232,000	235,300	238,700	242,000	245,300	248,700	248,700	89
90	190,200	193,600	196,900	200,300	203,600	207,000	210,500	213,900	217,400	220,800	224,300	227,800	231,400	234,900	238,400	241,900	245,400	248,900	252,400	255,900	259,500	259,500	90
92	200,200	203,500	206,800	210,100	213,500	216,800	220,200	223,600	227,100	230,500	234,000	237,500	241,000	244,400	247,900	251,400	254,900	258,300	261,800	265,300	268,800	268,800	92
93	207,400	210,900	214,400	217,900	221,400	224,900	228,500	232,100	235,700	239,300	243,000	246,600	250,300	254,000	257,600	261,300	264,900	268,600	272,200	275,900	279,500	279,500	93
95	219,700	223,100	226,600	230,100	233,600	237,100	240,600	244,200	247,700	251,300	254,900	258,500	262,100	265,800	269,400	273,000	276,600	280,200	283,800	287,400	291,000	291,000	95
96	226,900	230,500	234,200	237,800	241,500	245,200	248,900	252,600	256,300	260,100	263,900	267,700	271,500	275,300	279,100	282,900	286,700	290,500	294,300	298,100	301,900	301,900	96
98	239,200	242,800	246,400	250,000	253,600	257,300	261,000	264,700	268,400	272,100	275,800	279,600	283,300	287,100	290,900	294,600	298,400	302,100	305,900	309,600	313,300	313,300	98
99	246,400	250,200	254,000	257,800	261,600	265,400	269,200	273,100	277,000	280,900	284,800	288,700	292,700	296,600	300,500	304,500	308,400	312,300	316,300	320,200	324,100	324,100	99
101	258,700	262,400	266,200	270,000	273,700	277,500	281,300	285,200	289,000	292,900	296,800	300,700	304,600	308,500	312,400	316,300	320,200	324,100	328,000	331,900	335,800	335,800	101
102	265,900	269,900	273,800	277,700	281,700	285,600	289,600	293,600	297,600	301,700	305,700	309,800	313,900	318,000	322,000	326,100	330,100	334,200	338,200	342,300	346,300	346,300	102
104	278,200	282,100	286,000	289,900	293,800	297,700	301,700	305,700	309,700	313,700	317,700	321,700	325,700	329,800	333,800	337,900	341,900	345,900	349,900	353,900	35		

GUNTERSVILLE DAM  
**SPILLWAY DISCHARGE**  
 IN CUBIC FEET PER SECOND

GAINGE- RMENT	HEADWATER ELEVATION																				GAINGE- RMENT	
	590.0	590.2	590.4	590.6	590.8	591.0	591.2	591.4	591.6	591.8	592.0	592.2	592.4	592.6	592.8	593.0	593.2	593.4	593.6	593.8		594.0
115	386,200	391,300	396,400	401,500	406,500	411,600	416,700	421,900	427,100	432,200	437,400	442,600	447,800	453,100	458,300	463,500	468,600	473,800	479,000	484,200	489,300	115
116	396,300	401,400	406,400	411,400	416,400	421,500	426,500	431,600	436,700	441,800	446,900	452,100	457,200	462,300	467,500	472,600	477,700	482,800	487,900	493,000	498,100	116
117	404,500	409,800	415,000	420,200	425,500	430,700	436,000	441,200	446,500	451,900	457,200	462,500	467,900	473,300	478,600	483,900	489,300	494,600	499,900	505,200	510,500	117
118	421,900	427,300	432,600	438,000	443,300	448,600	454,000	459,400	464,800	470,200	475,700	481,100	486,600	492,100	497,500	503,000	508,400	513,800	519,200			118
119	440,200	445,800	451,300	456,700	462,200	467,700	473,200	478,800	484,300	489,900	495,500	501,100	506,700	512,300	517,900	523,400						119
120	457,600	463,200	468,900	474,400	480,000	485,600	491,300	496,900	502,600	508,300	514,000	519,700										120

MARCH 2004

HEADWATER 590 to 594  
 TAILWATER 581.51 to 582.50



**GUNTERSVILLE DAM**  
**SPILLWAY DISCHARGE**  
IN CUBIC FEET PER SECOND

DISCHARGE RANGE - FEET	HEADWATER ELEVATION																			DISCHARGE RANGE - FEET			
	594.0	594.2	594.4	594.6	594.8	595.0	595.2	595.4	595.6	595.8	596.0	596.2	596.4	596.6	596.8	597.0	597.2	597.4	597.6		597.8	598.0	
50																						50	
51																							51
52																							52
53																							53
54		93,580	94,370	95,150	95,930	96,720	97,470	98,240	99,010	99,720	100,600	101,400	102,300	103,100	103,900	104,700	105,600	106,400	107,200	108,100	108,900	109,700	54
55	95,620	96,450	97,260	98,070	98,880	99,680	100,500	101,300	102,100	102,900	103,700	104,600	105,400	106,300	107,100	108,000	108,900	109,700	110,600	111,500	112,300	113,100	55
56	98,600	99,440	100,300	101,100	101,900	102,700	103,600	104,400	105,200	106,000	106,900	107,700	108,600	109,500	110,300	111,200	112,100	113,000	113,900	114,700	115,600	116,500	56
57	101,400	102,300	103,200	104,000	104,900	105,700	106,600	107,400	108,300	109,100	110,000	110,900	111,800	112,700	113,600	114,500	115,400	116,300	117,200	118,100	119,000	120,000	57
58	105,500	106,500	107,500	108,500	109,500	110,400	111,400	112,400	113,400	114,400	115,400	116,400	117,400	118,500	119,500	120,600	121,600	122,600	123,700	124,800	125,800	126,900	58
59	109,600	110,700	111,800	112,900	114,100	115,200	116,300	117,400	118,500	119,600	120,800	121,900	123,100	124,300	125,400	126,600	127,800	129,000	130,200	131,400	132,600	133,900	59
60	113,700	114,900	116,200	117,400	118,600	119,900	121,100	122,300	123,600	124,900	126,100	127,400	128,700	130,100	131,500	132,900	134,400	135,800	137,300	138,700	140,200	141,700	60
61	117,800	119,100	120,500	121,900	123,200	124,600	126,000	127,300	128,700	130,100	131,500	132,900	134,400	135,800	137,300	138,700	140,200	141,700	143,200	144,700	146,200	147,700	61
62	121,900	123,300	124,800	126,300	127,800	129,300	130,800	132,300	133,800	135,300	136,900	138,500	140,100	141,600	143,200	144,800	146,400	148,000	149,600	151,200	152,900	154,500	62
63	125,900	127,600	129,200	130,800	132,400	134,000	135,700	137,300	139,000	140,600	142,300	144,000	145,700	147,400	149,100	150,900	152,600	154,400	156,100	157,900	159,700	161,500	63
64	130,000	131,800	133,500	135,300	137,000	138,800	140,500	142,300	144,000	145,800	147,700	149,500	151,300	153,200	155,100	156,900	158,800	160,700	162,600	164,500	166,400	168,300	64
65	134,100	136,000	137,800	139,700	141,600	143,500	145,400	147,200	149,200	151,100	153,000	155,000	157,000	159,000	161,000	163,000	165,000	167,000	169,100	171,100	173,200	175,300	65
66	138,000	139,900	141,800	143,700	145,600	147,500	149,400	151,300	153,200	155,100	157,100	159,100	161,000	163,000	165,000	167,000	169,000	171,000	173,000	175,000	177,000	179,000	66
67	140,800	142,700	144,700	146,600	148,500	150,500	152,400	154,300	156,300	158,200	160,200	162,200	164,200	166,200	168,200	170,300	172,300	174,300	176,300	178,400	180,400	182,500	67
68	144,900	146,900	148,900	151,000	153,100	155,200	157,200	159,300	161,400	163,500	165,600	167,700	169,800	172,000	174,100	176,300	178,500	180,700	182,800	185,000	187,200	189,400	68
69	149,000	151,200	153,300	155,500	157,700	159,900	162,100	164,300	166,500	168,800	171,000	173,300	175,500	177,800	180,100	182,400	184,700	187,000	189,300	191,700	194,000	196,300	69
70	153,100	155,400	157,700	160,000	162,300	164,600	166,900	169,300	171,600	174,000	176,400	178,800	181,200	183,600	186,000	188,400	190,900	193,300	195,800	198,300	200,800	203,300	70
71	157,200	159,600	162,000	164,400	166,800	169,300	171,800	174,300	176,700	179,200	181,700	184,200	186,700	189,200	191,700	194,200	196,700	199,200	201,700	204,200	206,700	209,200	71
72	161,200	163,800	166,300	168,800	171,300	173,800	176,300	178,800	181,300	183,800	186,300	188,800	191,300	193,800	196,300	198,800	201,300	203,800	206,300	208,800	211,300	213,800	72
73	165,200	167,900	170,600	173,300	176,000	178,700	181,400	184,100	186,800	189,500	192,200	194,900	197,600	200,300	203,000	205,700	208,400	211,100	213,800	216,500	219,200	221,900	73
74	175,100	177,900	180,800	183,700	186,600	189,400	192,300	195,200	198,100	201,000	204,000	207,100	210,100	213,100	216,200	219,200	222,300	225,400	228,400	231,500	234,600	237,700	74
75	179,200	182,100	185,100	188,100	191,100	194,200	197,200	200,300	203,300	206,400	209,500	212,600	215,700	218,800	222,000	225,100	228,200	231,300	234,400	237,500	240,600	243,700	75
77	184,400	187,200	190,100	193,000	196,000	199,000	202,000	205,000	208,000	211,100	214,100	217,200	220,300	223,400	226,500	229,600	232,700	235,800	238,900	242,000	245,100	248,200	77
78	188,500	191,400	194,300	197,300	200,300	203,300	206,300	209,300	212,300	215,300	218,400	221,500	224,600	227,700	230,800	233,900	237,000	240,100	243,200	246,300	249,400	252,500	78
79	195,100	198,100	201,100	204,200	207,200	210,300	213,300	216,400	219,400	222,500	225,600	228,700	231,800	234,900	238,000	241,100	244,200	247,300	250,400	253,500	256,600	259,700	79
80	199,200	202,400	205,500	208,600	211,800	215,000	218,100	221,300	224,500	227,700	231,000	234,200	237,500	240,800	244,100	247,400	250,700	254,000	257,300	260,600	263,900	267,200	80
82	204,400	207,400	210,400	213,300	216,300	219,300	222,300	225,300	228,300	231,300	234,300	237,300	240,300	243,300	246,300	249,300	252,300	255,300	258,300	261,300	264,300	267,300	82
83	208,500	211,600	214,700	217,800	220,900	224,000	227,100	230,200	233,300	236,400	239,500	242,600	245,700	248,800	251,900	255,000	258,100	261,200	264,300	267,400	270,500	273,600	83
84	212,600	222,600	222,600	229,100	232,400	235,700	239,000	242,300	245,600	249,000	252,300	255,600	259,000	262,300	265,600	269,000	272,300	275,600	279,000	282,300	285,600	289,000	84
86	228,600	231,800	235,000	238,300	241,500	244,800	248,000	251,300	254,600	257,900	261,200	264,500	267,800	271,100	274,400	277,700	281,000	284,300	287,600	290,900	294,200	297,500	86
87	239,400	242,800	246,200	249,600	253,000	256,500	259,900	263,400	266,800	270,300	273,800	277,300	280,800	284,300	287,800	291,300	294,800	298,300	301,800	305,300	308,800	312,300	87
89	248,700	252,000	255,400	258,800	262,200	265,500	268,900	272,300	275,700	279,100	282,500	285,900	289,300	292,700	296,100	299,500	302,900	306,300	309,700	313,100	316,500	320,000	89
90	259,500	263,000	266,600	270,100	273,700	277,200	280,800	284,400	288,000	291,600	295,200	298,800	302,400	306,000	309,600	313,200	316,800	320,400	324,000	327,600	331,200	334,800	90
92	268,800	272,300	275,800	279,300	282,800	286,300	289,800	293,300	296,900	300,500	304,100	307,700	311,300	314,900	318,500	322,100	325,700	329,300	332,900	336,500	340,100	343,700	92
93	279,500	283,200	286,900	290,600	294,300	298,000	301,700	305,400	309,200	313,000	316,700	320,500	324,300	328,100	331,900	335,700	339,500	343,300	347,100	350,900	354,700	358,500	93
95	291,000	294,700	298,300	301,900	305,500	309,200	312,800	316,500	320,200	323,900	327,600	331,300	335,000	338,700	342,400	346,100	349,800	353,500	357,200	360,900	364,600	368,300	95
96	301,800	305,600	309,400	313,200	317,000	320,900	324,700	328,600	332,400	336,300	340,200	344,100	348,000	351,900	355,800	359,700	363,600	367,500	371,400	375,300	379,200	383,100	96
98	313,300	317,000	320,800	324,500	328,300	332,100	335,900	339,700	343,500	347,300	351,100	354,900	358,700	362,500	366,300	370,100	373,900	377,700	381,500	385,300	389,100	392,900	98
99	324,100	328,000	331,900	335,800	339,700	343,600	347,500	351,400	355,300	359,200	363,100	367,000	370,900	374,800	378,700	382,600	386,500	390,400	394,300	398,200	402,100	406,000	99
101	335,600	339,400	343,300	347,200	351,100	355,000	358,900	362,800	366,700	370,600	374,500	378,400	382,300	386,200	390,100	394,000	397,900	401,800	405,700	409,600	413,500	417,400	101
102	346,300	350,400	354,400	358,500	362,600	366,600	370,700	374,800	378,900	383,000	387,100	391,200	395,300	399,400	403,500	407,600	411,700	415,800	419,900</				

GUNTERSVILLE DAM  
**SPILLWAY DISCHARGE**  
 IN CUBIC FEET PER SECOND

GAGE ELEVATION FEET	HEADWATER ELEVATION																			GAGE ELEVATION FEET		
	594.0	594.2	594.4	594.6	594.8	595.0	595.2	595.4	595.6	595.8	596.0	596.2	596.4	596.6	596.8	597.0	597.2	597.4	597.6		597.8	598.0
114	478,500	483,500	488,500	493,400	498,400	503,300	508,300	513,200	518,200	523,200												114
115	489,300	494,500	499,600	504,700	509,900	515,000	520,100															115
116	498,100	503,100	508,200	513,200	518,300	523,300																116
117	510,500	515,800	521,000																			117

MARCH 2004

HEADWATER 594 to 598  
 TAILWATER 581.51 to 582.50

## GUNTERSVILLE DAM SPILLWAY DISCHARGE IN CUBIC FEET PER SECOND

GATE ELEVATION	HEADWATER ELEVATION																		GATE ELEVATION			
	598.0	598.2	598.4	598.6	598.8	599.0	599.2	599.4	599.6	599.8	600.0	600.2	600.4	600.6	600.8	601.0	601.2	601.4		601.6	601.8	602.0
48																						48
49				93,830	94,650	95,490	96,350	97,220	98,100	98,990	99,890											49
50	95,310	96,040	96,770	97,520	98,290	99,080	99,880	100,700	101,500	102,400	103,200											50
51	98,710	99,470	100,200	101,000	101,800	102,600	103,400	104,300	105,100	106,000	106,900											51
52	102,100	102,900	103,700	104,500	105,300	106,200	107,000	107,900	108,700	109,600	110,500											52
53	105,500	106,300	107,200	108,000	108,800	109,700	110,600	111,500	112,400	113,300	114,200											53
54	108,900	109,800	110,600	111,500	112,300	113,200	114,100	115,100	116,000	116,900	117,900											54
55	112,300	113,200	114,100	115,000	115,900	116,800	117,700	118,600	119,600	120,600	121,500											55
56	115,600	116,500	117,400	118,300	119,200	120,000	120,900	121,800	122,700	123,600	124,500											56
57	119,000	120,000	120,900	121,800	122,700	123,600	124,500	125,400	126,300	127,200	128,100											57
58	125,800	126,900	127,900	129,000	130,000	131,100	132,200	133,200	134,300	135,400	136,400											58
59	132,600	133,800	135,000	136,200	137,400	138,600	139,800	141,000	142,300	143,500	144,700											59
60	139,400	140,700	142,100	143,400	144,800	146,100	147,500	148,900	150,200	151,600	153,000											60
61	146,100	147,600	149,100	150,600	152,100	153,600	155,200	156,700	158,200	159,800	161,300											61
62	152,900	154,500	156,200	157,800	159,500	161,100	162,800	164,500	166,200	167,900	169,600											62
63	159,700	161,500	163,200	165,000	166,800	168,700	170,500	172,300	174,200	176,000	177,900											63
64	166,400	168,400	170,300	172,200	174,200	176,200	178,200	180,200	182,200	184,200	186,200											64
65	173,200	175,300	177,400	179,500	181,600	183,700	185,800	188,000	190,100	192,300	194,500											65
66	177,000	179,100	181,100	183,100	185,200	187,300	189,400	191,500	193,600	195,700	197,800											66
67	180,400	182,500	184,600	186,600	188,700	190,800	192,900	195,000	197,200	199,300	201,400											67
68	187,200	189,400	191,600	193,800	196,100	198,300	200,600	202,900	205,100	207,400	209,700											68
69	194,000	196,300	198,700	201,100	203,400	205,800	208,300	210,700	213,100	215,600	218,000											69
70	200,800	203,300	205,800	208,300	210,800	213,400	215,900	218,500	221,100	223,700	226,300											70
71	207,500	210,200	212,800	215,500	218,200	220,900	223,600	226,300	229,100	231,800	234,600											71
72	214,300	217,100	219,900	222,700	225,500	228,400	231,300	234,200	237,100	240,000	242,900											72
73	224,500	227,400	230,400	233,400	236,400	239,400	242,500	245,600	248,700	251,800	254,900											73
74	234,700	237,800	240,900	244,100	247,300	250,500	253,700	257,000	260,300	263,500	266,800											74
75	241,400	244,700	248,000	251,300	254,600	258,000	261,400	264,800	268,200	271,700	275,100											75
78	250,300	253,500	256,800	260,100	263,500	266,900	270,300	273,700	277,100	280,600	284,100											78
79	257,500	260,800	264,000	267,300	270,600	274,000	277,400	280,800	284,200	287,600	291,000											79
80	264,300	267,700	271,100	274,500	278,000	281,500	285,000	288,600	292,100	295,700	299,300											80
83	273,100	276,500	279,900	283,400	286,900	290,400	293,900	297,500	301,100	304,600	308,200											83
84	287,100	290,600	294,200	297,800	301,400	305,000	308,700	312,400	316,100	319,800	323,500											84
86	295,900	299,500	303,000	306,600	310,200	313,900	317,600	321,300	325,000	328,700	332,400											86
87	309,900	313,600	317,300	321,000	324,800	328,500	332,300	336,200	340,000	343,800	347,700											87
89	318,700	322,400	326,100	329,900	333,600	337,400	341,200	345,100	348,900	352,800	356,600											89
90	332,700	336,500	340,400	344,200	348,100	352,100	356,000	359,900	363,900	367,900	371,900											90
92	341,500	345,400	349,200	353,100	357,000	360,900	364,900	368,800	372,800	376,800	380,800											92
93	355,500	359,500	363,500	367,500	371,500	375,600	379,600	383,700	387,800	391,900	396,100											93
95	366,100	370,100	374,000	378,000	382,000	386,100	390,100	394,200	398,300	402,400	406,500											95
96	380,100	384,200	388,300	392,400	396,500	400,700	404,900	409,100	413,300	417,500	421,700											96
98	390,700	394,800	398,900	403,000	407,100	411,200	415,400	419,500	423,700	427,900	432,100											98
99	404,700	408,900	413,100	417,300	421,600	425,900	430,100	434,400	438,700	443,100	447,400											99
101	415,300	419,500	423,700	427,900	432,100	436,400	440,600	444,900	449,200	453,500	457,800											101
102	429,300	433,600	437,900	442,300	446,600	451,000	455,400	459,800	464,200	468,600	473,000											102
104	439,900	444,200	448,500	452,800	457,100	461,500	465,900	470,200	474,600	479,000	483,400											104
105	453,900	458,300	462,800	467,200	471,700	476,100	480,600	485,100	489,600	494,200	498,700											105
107	484,400	489,100	493,800	498,500	503,200	508,000	512,800	517,500	522,300													107
108	494,100	498,800	503,500	508,200	512,900	517,700	522,400															108
109	508,100	512,900	517,800	522,600																		109
110	517,800	522,600																				110

HEADWATER 598 to 602  
TAILWATER 581.51 to 582.50

MARCH 2004

**GUNTERSVILLE DAM  
SPILLWAY DISCHARGE  
IN CUBIC FEET PER SECOND**

**HEADWATER ELEVATION**

GATE ARRANGE- MENT	HEADWATER ELEVATION																				GATE ARRANGE- MENT		
	590.0	590.2	590.4	590.6	590.8	591.0	591.2	591.4	591.6	591.8	592.0	592.2	592.4	592.6	592.8	593.0	593.2	593.4	593.6	593.8		594.0	
61															108,500	110,000	108,200	109,600	111,000	112,400	113,800	115,200	61
62															111,700	113,300	111,600	113,100	114,600	116,200	117,700	119,200	62
63															114,800	116,600	115,000	116,600	118,300	120,100	121,900	123,700	63
64															118,000	119,900	118,400	120,400	122,400	124,500	126,600	128,700	64
65								108,600		107,700	109,500		108,300	110,000	111,300	111,300	114,200	116,100	118,000	120,000	122,000	124,000	65
66															121,500	123,400	125,400	127,300	129,200	131,100	133,100	135,000	66
67										108,700	110,600	112,400	114,400	116,300	118,200	120,200	124,100	126,100	128,000	129,900	131,900	133,900	67
68						109,000	111,000	112,900	114,900	117,000	119,000	121,000	123,100	125,200	127,300	129,300	131,400	133,500	135,500	137,600	139,700	141,800	68
69						111,200	113,300	115,300	117,400	119,500	121,600	123,700	125,800	127,900	130,000	132,100	134,200	136,300	138,400	140,500	142,600	144,700	69
70			109,000	111,200	113,400	115,600	117,700	119,900	122,200	124,400	126,700	129,000	131,300	133,600	135,900	138,200	140,500	142,800	145,100	147,500	149,800	152,100	70
71															136,800	139,200	141,600	144,000	146,400	148,900	151,300	153,800	71
72	108,400	110,700	111,000	113,300	115,500	117,800	120,100	122,400	124,800	127,200	129,500	132,000	134,400	136,800	139,200	141,600	144,000	146,400	148,900	151,300	153,800	157,800	72
73	112,400	114,900	117,300	119,800	122,300	124,800	127,300	129,900	132,500	135,100	137,700	140,400	143,000	145,700	148,400	151,100	153,700	156,400	159,100	161,900	164,600	167,400	73
74	116,500	119,000	121,600	124,200	126,800	129,500	132,100	134,800	137,500	140,300	143,000	145,800	148,600	151,500	154,300	157,100	159,900	162,800	165,600	168,500	171,400	174,400	74
75	118,300	121,000	123,600	126,300	129,000	131,700	134,500	137,300	140,100	143,000	145,900	148,800	151,700	154,600	157,600	160,500	163,400	166,400	169,400	172,400	175,400	178,500	75
76	120,900	123,400	125,900	128,500	131,000	133,600	136,200	138,800	141,400	144,100	146,800	149,500	152,200	155,000	157,800	160,600	163,400	166,200	169,100	172,000	174,900	177,800	76
77	126,100	128,700	131,300	133,900	136,500	139,200	141,800	144,500	147,200	149,900	152,600	155,400	158,200	161,000	163,800	166,600	169,400	172,200	175,000	177,800	180,700	183,600	77
78	128,000	130,600	133,300	136,000	138,700	141,500	144,200	147,000	149,800	152,600	155,500	158,400	161,300	164,200	167,100	170,000	172,900	175,800	178,700	181,600	184,500	187,400	78
79	133,200	136,000	138,700	141,500	144,300	147,100	149,900	152,700	155,600	158,500	161,400	164,300	167,300	170,300	173,300	176,200	179,200	182,200	185,200	188,200	191,200	194,200	79
80	135,000	137,900	140,700	143,600	146,400	149,300	152,300	155,200	158,200	161,200	164,200	167,300	170,400	173,500	176,500	179,600	182,700	185,800	188,900	192,000	195,100	198,200	80
81	137,600	140,300	143,000	145,700	148,500	151,200	153,900	156,700	159,500	162,300	165,200	168,100	171,000	173,900	176,900	179,800	182,700	185,700	188,600	191,600	194,600	197,500	81
82	142,900	145,600	148,400	151,200	154,000	156,800	159,600	162,400	165,300	168,100	171,000	173,900	176,900	179,800	182,700	185,700	188,600	191,600	194,600	197,500	200,500	203,500	82
83	144,700	147,600	150,400	153,300	156,200	159,100	162,000	164,900	167,900	170,900	173,900	176,900	179,900	183,000	186,000	189,100	192,100	195,200	198,300	201,400	204,500	207,600	83
84	151,800	154,800	157,800	160,800	163,900	167,000	170,000	173,100	176,200	179,300	182,400	185,500	188,600	191,700	194,800	197,900	201,000	204,100	207,200	210,300	213,400	216,500	84
85	154,300	157,200	160,100	163,000	165,900	168,800	171,700	174,600	177,600	180,500	183,500	186,500	189,500	192,500	195,500	198,500	202,000	205,200	208,500	211,800	215,100	218,400	85
86	161,400	164,500	167,500	170,600	173,600	176,700	179,800	182,800	186,000	189,100	192,200	195,400	198,600	201,800	205,000	208,200	211,400	214,600	217,900	221,100	224,400	227,600	86
87	168,500	171,700	174,900	178,100	181,300	184,600	187,800	191,100	194,300	197,600	201,000	204,300	207,700	211,100	214,500	217,900	221,300	224,700	228,100	231,500	234,900	238,300	87
88	171,100	174,200	177,300	180,400	183,500	186,600	189,700	192,800	195,900	199,000	202,100	205,200	208,300	211,400	214,500	217,600	220,700	223,800	226,900	230,000	233,100	236,200	88
89	178,100	181,400	184,600	187,800	191,100	194,300	197,500	200,800	204,000	207,300	210,600	213,900	217,300	220,600	224,000	227,300	230,700	234,000	237,400	240,800	244,300	247,700	89
90	185,200	188,600	192,000	195,400	198,800	202,200	205,600	209,000	212,400	215,900	219,300	222,800	226,300	229,800	233,300	236,800	240,300	243,800	247,300	250,800	254,300	257,800	90
92	194,900	198,300	201,700	205,100	208,500	211,900	215,300	218,700	222,100	225,500	229,000	232,400	235,900	239,400	242,900	246,400	249,900	253,500	257,000	260,600	264,100	267,700	92
93	201,900	205,500	209,100	212,700	216,200	219,800	223,300	226,900	230,500	234,100	237,700	241,400	245,000	248,700	252,400	256,100	259,800	263,500	267,200	270,900	274,600	278,300	93
95	213,800	217,500	221,100	224,700	228,300	231,800	235,400	239,000	242,500	246,000	249,600	253,200	256,900	260,500	264,100	267,800	271,400	275,100	278,800	282,500	286,200	290,000	95
96	220,900	224,700	228,500	232,200	236,000	239,700	243,400	247,100	250,900	254,600	258,400	262,200	266,000	269,800	273,600	277,400	281,300	285,100	289,000	292,800	296,700	300,600	96
98	232,800	236,700	240,500	244,200	248,000	251,700	255,400	259,100	262,800	266,600	270,300	274,000	277,800	281,600	285,400	289,100	292,900	296,700	300,500	304,300	308,200	312,100	98
99	239,900	243,900	247,900	251,800	255,700	259,600	263,500	267,400	271,200	275,100	279,000	283,000	286,900	290,900	294,800	298,800	302,800	306,700	310,700	314,600	318,600	322,600	99
101	251,800	255,800	259,900	263,800	267,700	271,600	275,500	279,400	283,300	287,200	291,100	295,000	298,900	302,800	306,700	310,600	314,500	318,400	322,300	326,200	330,100	334,000	101
102	258,900	263,000	267,100	271,200	275,300	279,400	283,500	287,600	291,700	295,800	299,900	304,000	308,100	312,200	316,300	320,400	324,500	328,600	332,700	336,800	340,900	345,000	102
104	270,800	275,000	279,200	283,400	287,500	291,600	295,700	299,800	303,900	307,900	311,900	315,900	319,900	323,900	327,900	331,900	335,900	340,000	344,000	348,000	352,000	356,000	104
105	277,800	282,300	286,600	290,900	295,200	299,400	303,600	307,800	312,000	316,200	320,300	324,500	328,600	332,700	336,800	340,900	345,000	349,100	353,200	357,300	361,400	365,500	105
106	283,400	287,800	292,100	296,300	300,500	304,700	308,800	312,900	317,000	321,100	325,200	329,300	333,400	337,500	341,600	345,700	349,800	353,900	358,000	362,100	366,200	370,300	106
107	297,500	302,200	306,900	311,400	316,000	320,500	324,900	329,400	333,800	338,200	342,700	347,100	351,600	356,000	360,500	365,000	369,500	374,000	378,500	383,000	387,500	392,000	107
108	308,300	313,000	317,700	322,300	326,800	331,300	335,800	340,200	344,600	349,000	353,400	357,900	362,300	366,800	371,200	375,700	380,200	384,700	389,200	393,700	398,200	402,700	108
109	315,400	320,300	325,100	329,900	334,600	339,200	343,800	348,400	353,000	357,500	362,000	366,500	371,000	375,500	380,000	384,500	389,000	393,500	398,000	402,500	407,000	411,500	109
110	326,100	331,100	336,000	340,700	345,400	350,100	354,700	359,300	363,900	368,400	373,000	377,500	382,000	386,500	391,000	395,500	400,000	404,500	409,000	413,500	418,000	422,500	110
111	333,200	338,300	343,300	348,																			

# GUNTERSVILLE DAM SPILLWAY DISCHARGE IN CUBIC FEET PER SECOND

HEADWATER ELEVATION	HEADWATER ELEVATION																				TAILWATER ELEVATION										
	594.0	594.2	594.4	594.6	594.8	595.0	595.2	595.4	595.6	595.8	596.0	596.2	596.4	596.6	596.8	597.0	597.2	597.4	597.6	597.8		598.0									
92	264,100	267,700	271,300	274,900																											

GUNTERSVILLE DAM  
**SPILLWAY DISCHARGE**  
 IN CUBIC FEET PER SECOND

GAGE ELEVATION FEET	HEADWATER ELEVATION																				GAGE ELEVATION FEET	
	598.0	598.2	598.4	598.6	598.8	599.0	599.2	599.4	599.6	599.8	600.0	600.2	600.4	600.6	600.8	601.0	601.2	601.4	601.6	601.8		602.0
52										108, 100	109, 000										52	
53						108, 000	108, 900	109, 800	110, 700	111, 700	112, 600											53
54		108, 000	108, 800	109, 700	110, 600	111, 500	112, 400	113, 400	114, 300	115, 300	116, 200											54
55	110, 500	111, 400	112, 300	113, 100	114, 100	115, 000	116, 000	116, 900	117, 900	118, 900	119, 900											55
56	113, 800	114, 700	115, 600	116, 500	117, 400	118, 300	119, 200	120, 100	121, 000	121, 900	122, 800											56
57	117, 200	118, 100	119, 000	119, 900	120, 900	121, 800	122, 700	123, 600	124, 600	125, 500	126, 400											57
58	123, 900	124, 900	126, 000	127, 100	128, 100	129, 200	130, 300	131, 400	132, 500	133, 500	134, 600											58
59	130, 600	131, 800	133, 000	134, 200	135, 400	136, 700	137, 900	139, 100	140, 400	141, 600	142, 800											59
60	137, 300	138, 600	140, 000	141, 300	142, 700	144, 100	145, 500	146, 900	148, 200	149, 600	151, 000											60
61	144, 000	145, 500	147, 000	148, 500	150, 000	151, 500	153, 100	154, 600	156, 100	157, 700	159, 200											61
62	150, 600	152, 300	153, 900	155, 600	157, 300	159, 000	160, 600	162, 300	164, 000	165, 700	167, 500											62
63	157, 300	159, 100	160, 900	162, 700	164, 500	166, 400	168, 200	170, 100	171, 900	173, 800	175, 700											63
64	164, 000	166, 000	167, 900	169, 900	171, 800	173, 800	175, 800	177, 800	179, 800	181, 800	183, 900											64
65	170, 700	172, 800	174, 900	177, 000	179, 100	181, 200	183, 400	185, 600	187, 700	189, 900	192, 100											65
66	174, 500	176, 500	178, 600	180, 600	182, 700	184, 800	186, 900	189, 000	191, 100	193, 200	195, 300											66
67	177, 800	179, 900	182, 000	184, 100	186, 100	188, 300	190, 400	192, 500	194, 600	196, 800	198, 900											67
68	184, 500	186, 700	189, 000	191, 200	193, 400	195, 700	198, 000	200, 200	202, 500	204, 800	207, 100											68
69	191, 200	193, 600	195, 900	198, 300	200, 700	203, 100	205, 600	208, 000	210, 400	212, 900	215, 300											69
70	197, 900	200, 400	202, 900	205, 500	208, 000	210, 600	213, 100	215, 700	218, 300	220, 900	223, 500											70
71	204, 600	207, 300	209, 900	212, 600	215, 300	218, 000	220, 700	223, 500	226, 200	229, 000	231, 800											71
72	211, 300	214, 100	216, 900	219, 700	222, 600	225, 400	228, 300	231, 200	234, 100	237, 000	240, 000											72
73	221, 400	224, 300	227, 300	230, 300	233, 300	236, 400	239, 400	242, 500	245, 600	248, 700	251, 800											73
74	231, 400	234, 600	237, 700	240, 900	244, 000	247, 300	250, 500	253, 800	257, 000	260, 300	263, 600											74
75	238, 100	241, 400	244, 700	248, 000	251, 300	254, 700	258, 100	261, 500	264, 900	268, 400	271, 800											75
78	247, 000	250, 300	253, 600	256, 900	260, 200	263, 600	267, 000	270, 500	273, 900	277, 400	280, 800											78
79	254, 100	257, 400	260, 600	263, 900	267, 300	270, 600	274, 000	277, 400	280, 800	284, 300	287, 700											79
80	260, 800	264, 200	267, 600	271, 100	274, 600	278, 100	281, 600	285, 200	288, 700	292, 300	295, 900											80
83	269, 600	273, 100	276, 500	280, 000	283, 500	287, 000	290, 600	294, 100	297, 700	301, 300	304, 900											83
84	283, 500	287, 000	290, 600	294, 200	297, 800	301, 400	305, 100	308, 800	312, 500	316, 200	320, 000											84
86	292, 300	295, 900	299, 500	303, 100	306, 700	310, 400	314, 100	317, 800	321, 500	325, 200	329, 000											86
87	306, 100	309, 800	313, 500	317, 300	321, 000	324, 800	328, 600	332, 500	336, 300	340, 200	344, 000											87
89	315, 000	318, 700	322, 400	326, 200	329, 900	333, 700	337, 600	341, 400	345, 300	349, 100	353, 000											89
90	328, 800	332, 600	336, 500	340, 400	344, 200	348, 200	352, 100	356, 100	360, 100	364, 100	368, 100											90
92	337, 700	341, 500	345, 400	349, 300	353, 200	357, 100	361, 100	365, 100	369, 100	373, 100	377, 100											92
93	351, 500	355, 400	359, 400	363, 400	367, 500	371, 600	375, 600	379, 800	383, 900	388, 000	392, 200											93
95	362, 200	366, 100	370, 100	374, 100	378, 100	382, 200	386, 200	390, 300	394, 400	398, 500	402, 700											95
96	376, 000	380, 000	384, 100	388, 300	392, 400	396, 600	400, 800	405, 000	409, 200	413, 500	417, 700											96
98	386, 600	390, 700	394, 800	398, 900	403, 000	407, 200	411, 400	415, 600	419, 800	424, 000	428, 200											98
99	400, 400	404, 600	408, 900	413, 100	417, 300	421, 600	425, 900	430, 300	434, 600	438, 900	443, 300											99
101	411, 100	415, 300	419, 500	423, 700	428, 000	432, 200	436, 500	440, 800	445, 100	449, 500	453, 800											101
102	424, 900	429, 200	433, 600	437, 900	442, 300	446, 700	451, 100	455, 500	460, 000	464, 400	468, 900											102
104	435, 600	439, 900	444, 200	448, 500	452, 900	457, 300	461, 700	466, 100	470, 500	474, 900	479, 400											104
105	449, 400	453, 800	458, 300	462, 700	467, 200	471, 700	476, 200	480, 800	485, 300	489, 900	494, 400											105
107	479, 700	484, 400	489, 100	493, 800	498, 600	503, 400	508, 100	513, 000	517, 800	522, 600	527, 500											107
108	489, 500	494, 100	498, 900	503, 600	508, 300	513, 100	517, 900	522, 700	527, 500	532, 400	537, 200											108
109	503, 300	508, 100	512, 900	517, 800	522, 700	527, 600	532, 500	537, 400														109
110	513, 000	517, 800	522, 700	527, 500	532, 400	537, 300																110
111	526, 800	531, 800	536, 700																			111
112	534, 300	539, 200																				112

MARCH 2004

HEADWATER 598 to 602  
 TAILWATER 582.51 to 583.50

# GUNTERSVILLE DAM SPILLWAY DISCHARGE IN CUBIC FEET PER SECOND

GATE ELEVATION FEET	HEADWATER ELEVATION																				GATE ELEVATION FEET	
	590.0	590.2	590.4	590.6	590.8	591.0	591.2	591.4	591.6	591.8	592.0	592.2	592.4	592.6	592.8	593.0	593.2	593.4	593.6	593.8		594.0
64																						64
65																						65
66																						66
120																						120

HEADWATER 590 to 594  
TAILWATER 583.51 to 584.50

MARCH 2004





# GUNTERSVILLE DAM SPILLWAY DISCHARGE IN CUBIC FEET PER SECOND

RAISE- MENT	HEADWATER ELEVATION																				RAISE- MENT	
	598.0	598.2	598.4	598.6	598.8	599.0	599.2	599.4	599.6	599.8	600.0	600.2	600.4	600.6	600.8	601.0	601.2	601.4	601.6	601.8		602.0
57									122,700	123,700	124,600											57
58			123,000	124,000	125,100	126,200	127,300	128,400	129,500	130,500	131,600	132,700										58
59	128,500	129,700	130,900	132,200	133,400	134,600	135,900	137,100	138,300	139,600	140,800											59
60	135,100	136,400	137,800	139,200	140,600	141,900	143,300	144,700	146,100	147,500	148,900											60
61	141,700	143,200	144,700	146,200	147,700	149,300	150,800	152,400	153,900	155,500	157,100											61
62	148,300	149,900	151,600	153,200	154,900	156,600	158,300	160,000	161,700	163,400	165,200											62
63	154,900	156,700	158,500	160,300	162,100	164,000	165,800	167,700	169,500	171,400	173,300											63
64	161,400	163,400	165,400	167,300	169,300	171,300	173,300	175,300	177,300	179,400	181,400											64
65	168,000	170,100	172,200	174,300	176,500	178,600	180,800	182,900	185,100	187,300	189,500											65
66	174,700	173,800	175,800	177,900	180,000	182,100	184,200	186,300	188,400	190,500	192,700											66
67	175,000	177,100	179,200	181,300	183,400	185,500	187,600	189,800	191,900	194,100	196,200											67
68	181,600	183,800	186,100	188,300	190,600	192,800	195,100	197,400	199,700	202,000	204,300											68
69	188,200	190,600	193,000	195,300	197,700	200,200	202,600	205,100	207,500	210,000	212,400											69
70	194,800	197,300	199,800	202,400	204,900	207,500	210,100	212,700	215,300	217,900	220,600											70
71	201,400	204,000	206,700	209,400	212,100	214,800	217,600	220,300	223,100	225,900	228,700											71
72	208,000	210,800	213,600	216,400	219,300	222,200	225,100	228,000	230,900	233,800	236,800											72
73	217,900	220,900	223,900	226,900	229,900	233,000	236,000	239,100	242,200	245,300	248,500											73
74	227,800	230,900	234,100	237,300	240,500	243,700	247,000	250,300	253,600	256,800	260,200											74
75	234,400	237,700	241,000	244,300	247,700	251,100	254,500	257,900	261,300	264,800	268,300											75
78	243,300	246,600	250,000	253,300	256,700	260,100	263,500	266,900	270,400	273,900	277,300											78
79	250,300	253,600	256,900	260,200	263,600	267,000	270,400	273,800	277,200	280,600	284,100											79
80	256,900	260,300	263,800	267,300	270,800	274,300	277,800	281,400	285,000	288,600	292,200											80
83	265,800	269,300	272,800	276,200	279,700	283,300	286,900	290,400	294,000	297,600	301,300											83
84	279,400	283,000	286,600	290,200	293,800	297,500	301,200	304,900	308,600	312,400	316,100											84
86	288,400	292,000	295,600	299,200	302,800	306,500	310,200	313,900	317,700	321,400	325,200											86
87	302,000	305,700	309,400	313,200	316,900	320,800	324,600	328,400	332,300	336,100	340,000											87
89	310,900	314,600	318,400	322,100	325,900	329,800	333,600	337,400	341,300	345,200	349,100											89
90	324,500	328,400	332,200	336,100	340,000	344,000	347,900	351,900	355,900	359,900	364,000											90
92	333,400	337,300	341,200	345,100	349,000	353,000	357,000	361,000	365,000	369,000	373,000											92
93	347,000	351,000	355,000	359,100	363,100	367,200	371,300	375,400	379,600	383,700	387,900											93
95	357,800	361,800	365,800	369,800	373,900	377,900	382,000	386,100	390,200	394,400	398,500											95
96	371,400	375,500	379,700	383,800	388,000	392,200	396,400	400,600	404,800	409,100	413,400											96
98	382,200	386,300	390,400	394,600	398,700	402,900	407,100	411,300	415,500	419,700	424,000											98
99	395,800	400,000	404,300	408,500	412,800	417,100	421,400	425,700	430,100	434,400	438,800											99
101	406,600	410,800	415,100	419,300	423,500	427,800	432,100	436,400	440,700	445,100	449,500											101
102	420,200	424,500	428,900	433,300	437,600	442,000	446,500	450,900	455,300	459,800	464,300											102
104	431,000	435,300	439,700	444,000	448,400	452,800	457,200	461,600	466,000	470,500	474,900											104
105	444,600	449,100	453,500	458,000	462,500	467,000	471,500	476,100	480,600	485,200	489,800											105
107	474,700	479,400	484,100	488,900	493,600	498,400	503,200	508,000	512,900	517,700	522,600											107
108	484,500	489,300	494,000	498,700	503,500	508,300	513,100	517,900	522,700	527,600	532,400											108
109	498,100	503,000	507,800	512,700	517,600	522,500	527,400	532,400	537,300	542,300	547,300											109
110	508,000	512,800	517,700	522,600	527,500	532,400	537,300	542,200	547,200	552,100												110
111	521,600	526,600	531,500	536,500	541,500	546,600	551,600															111
112	529,200	534,100	539,100	544,000	549,000	554,000																112

HEADWATER 598 to 602  
TAILWATER 583.51 to 584.50

MARCH 2004

**GUNTERSVILLE DAM  
SPILLWAY DISCHARGE  
IN CUBIC FEET PER SECOND**

GAGE RANGE - FEET	HEADWATER ELEVATION																			GAGE RANGE - FEET	
	590.0	590.2	590.4	590.6	590.8	591.0	591.2	591.4	591.6	591.8	592.0	592.2	592.4	592.6	592.8	593.0	593.2	593.4	593.6		593.8	594.0	
69	
70	
71	
72	


# GUNTERSVILLE DAM SPILLWAY DISCHARGE IN CUBIC FEET PER SECOND

GATE RANGE - FEET	HEADWATER ELEVATION																				GATE RANGE - FEET	
	594.0	594.2	594.4	594.6	594.8	595.0	595.2	595.4	595.6	595.8	596.0	596.2	596.4	596.6	596.8	597.0	597.2	597.4	597.6	597.8		598.0	


GUNTERSVILLE DAM  
**SPILLWAY DISCHARGE**  
 IN CUBIC FEET PER SECOND

GATE NUMBER	HEADWATER ELEVATION																				GATE NUMBER		
	598.0	598.2	598.4	598.6	598.8	599.0	599.2	599.4	599.6	599.8	600.0	600.2	600.4	600.6	600.8	601.0	601.2	601.4	601.6	601.8		602.0	
59																						59	
60				136,700	138,100	139,500	141,000	142,400	143,800	145,300	146,800											60	
61	138,900	140,400	142,000	143,600	145,100	146,700	148,300	149,900	151,500	153,100	154,700											61	
62	145,400	147,100	148,800	150,500	152,200	153,900	155,700	157,400	159,200	161,000	162,700											62	
63	151,800	153,700	155,500	157,400	159,300	161,200	163,100	165,000	166,900	168,800	170,700											63	
64	158,300	160,300	162,300	164,300	166,300	168,400	170,400	172,500	174,500	176,600	178,700											64	
65	164,800	166,900	169,100	171,200	173,400	175,600	177,800	180,000	182,200	184,400	186,700											65	
66	168,300	170,400	172,500	174,600	176,800	178,900	181,100	183,200	185,400	187,600	189,800											66	
67	171,600	173,700	175,900	178,000	180,200	182,300	184,500	186,700	188,900	191,100	193,300											67	
68	178,100	180,400	182,600	184,900	187,200	189,500	191,900	194,200	196,600	198,900	201,300											68	
69	184,600	187,000	189,400	191,800	194,300	196,800	199,200	201,700	204,200	206,700	209,300											69	
70	191,000	193,600	196,200	198,700	201,300	204,000	206,600	209,300	211,900	214,600	217,200											70	
71	197,500	200,200	202,900	205,700	208,400	211,200	214,000	216,800	219,600	222,400	225,200											71	
72	204,000	206,800	209,700	212,600	215,500	218,400	221,300	224,300	227,300	230,200	233,200											72	
73	213,800	216,800	219,800	222,800	225,900	229,000	232,100	235,300	238,400	241,600	244,700											73	
74	223,500	226,700	229,900	233,100	236,400	239,600	242,900	246,200	249,600	252,900	256,200											74	
75	230,000	233,300	236,700	240,000	243,400	246,900	250,300	253,800	257,200	260,700	264,200											75	
77	232,600	235,800	239,000	242,200	245,500	248,800	252,100	255,400	258,700	262,100	265,400											77	
78	239,100	242,400	245,800	249,100	252,500	256,000	259,400	262,900	266,400	269,900	273,400											78	
79	245,900	249,200	252,600	255,900	259,300	262,700	266,200	269,600	273,100	276,500	280,000											79	
80	252,400	255,800	259,300	262,800	266,400	270,000	273,500	277,100	280,800	284,400	288,000											80	
82	255,000	258,300	261,700	265,000	268,400	271,900	275,300	278,800	282,200	285,700	289,200											82	
83	261,400	264,900	268,400	271,900	275,500	279,100	282,700	286,300	289,900	293,600	297,200											83	
84	274,700	278,400	282,000	285,700	289,300	293,000	296,800	300,500	304,300	308,000	311,800											84	
86	283,800	287,400	291,100	294,800	298,400	302,200	305,900	309,700	313,400	317,200	321,000											86	
87	297,100	300,900	304,700	308,500	312,300	316,100	320,000	323,900	327,800	331,700	335,600											87	
89	306,200	310,000	313,800	317,600	321,400	325,300	329,100	333,000	336,900	340,900	344,800											89	
90	319,500	323,400	327,300	331,300	335,200	339,200	343,200	347,300	351,300	355,300	359,400											90	
92	328,600	332,500	336,400	340,400	344,300	348,400	352,400	356,400	360,500	364,500	368,600											92	
93	341,900	345,900	350,000	354,100	358,200	362,300	366,500	370,600	374,800	379,000	383,200											93	
95	352,900	356,900	361,000	365,000	369,100	373,200	377,400	381,500	385,600	389,800	394,000											95	
96	366,200	370,400	374,500	378,700	383,000	387,200	391,500	395,700	400,000	404,300	408,600											96	
98	377,200	381,300	385,500	389,700	393,900	398,100	402,300	406,600	410,800	415,100	419,400											98	
99	390,500	394,800	399,100	403,400	407,700	412,100	416,400	420,800	425,200	429,600	434,000											99	
101	401,400	405,700	410,000	414,300	418,600	423,000	427,300	431,700	436,000	440,400	444,800											101	
102	414,800	419,200	423,600	428,000	432,500	437,000	441,400	445,900	450,400	454,900	459,400											102	
104	425,700	430,200	434,600	439,000	443,400	447,900	452,300	456,800	461,200	465,700	470,200											104	
105	439,100	443,600	448,100	452,700	457,300	461,800	466,400	471,000	475,600	480,200	484,800											105	
107	468,900	473,700	478,500	483,300	488,200	493,000	497,900	502,700	507,600	512,500	517,400											107	
108	478,900	483,700	488,500	493,400	498,200	503,000	507,900	512,800	517,600	522,500	527,400											108	
109	492,200	497,200	502,100	507,100	512,000	517,000	522,000	527,000	532,000	537,000	542,000											109	
110	502,200	507,200	512,100	517,100	522,000	527,000	532,000	537,000	542,000	547,000	552,000											110	
111	515,500	520,600	525,700	530,800	535,900	541,000	546,100	551,200	556,300	561,400	566,500											111	
112	523,300	528,400	533,400	538,500	543,600	548,600	553,700	558,800	563,800	568,900												112	
113	552,200	557,300	562,300	567,400																			113
114	562,200	567,600																				114	

# GUNTERSVILLE DAM SPILLWAY DISCHARGE IN CUBIC FEET PER SECOND

GAINGE- MENT	HEADWATER ELEVATION																			GAINGE- MENT	
	590.0	590.2	590.4	590.6	590.8	591.0	591.2	591.4	591.6	591.8	592.0	592.2	592.4	592.6	592.8	593.0	593.2	593.4	593.6		593.8	594.0	
73	
74																					150,800	153,600	73	
75																					157,300	160,200	74	
76																					155,100	158,100	75	
77																					157,400	160,400	76	
78														151,400	151,300	154,400	152,000	155,100	158,100	161,200	163,300	166,300	169,200	77	
79																					160,900	164,000	170,100	173,100	78	


**GUNTERSVILLE DAM  
SPILLWAY DISCHARGE  
IN CUBIC FEET PER SECOND**

GATE NUMBER	HEADWATER ELEVATION																			GATE NUMBER			
	594.0	594.2	594.4	594.6	594.8	595.0	595.2	595.4	595.6	595.8	596.0	596.2	596.4	596.6	596.8	597.0	597.2	597.4	597.6		597.8	598.0	
64																							64
65																151,000	153,100	155,100	151,100	153,100	155,000	153,000	65
66															154,500	156,600	158,600	157,200	159,300	161,400	163,500	161,400	66
67															155,600	157,700	159,800	160,600	162,700	164,800	166,900	168,100	67
68											152,400	154,600	156,800	159,000	161,200	163,400	165,600	167,800	170,000	172,200	174,400	176,600	68
69																							69
70											150,800	153,000	155,200	157,500	159,800	162,100	164,400	166,700	169,100	171,400	173,700	176,100	70
71											155,500	157,800	160,200	162,600	165,000	167,400	169,800	172,300	174,700	177,200	179,700	182,100	71
72											157,700	160,200	162,700	165,200	167,700	170,200	172,700	175,200	177,700	180,200	182,700	185,200	72
73	153,600	156,300	159,000	161,700	164,500	167,200	169,900	172,600	175,300	178,100	180,800	183,600	186,400	189,200	192,100	195,000	197,800	200,700	203,600	206,600	209,500	212,500	73
74	160,200	163,100	166,000	168,800	171,700	174,500	177,400	180,300	183,100	186,000	188,900	191,800	194,700	197,600	200,500	203,400	206,300	209,200	212,100	215,000	217,900	220,800	74
75	164,200	167,200	170,100	173,100	176,100	179,000	182,000	185,000	188,000	191,000	194,000	197,100	200,100	203,200	206,300	209,400	212,500	215,600	218,700	221,800	224,900	228,000	75
77	169,200	172,100	174,900	177,800	180,600	183,500	186,300	189,200	192,000	194,900	197,800	200,700	203,600	206,500	209,400	212,300	215,200	218,100	221,000	223,900	226,800	229,700	77
78	173,100	176,100	179,100	182,100	185,000	188,000	190,900	193,900	196,800	199,800	202,800	205,700	208,700	211,600	214,600	217,500	220,500	223,400	226,400	229,300	232,300	235,200	78
79	179,100	182,100	185,200	188,200	191,300	194,300	197,300	200,300	203,400	206,400	209,500	212,600	215,700	218,800	221,900	225,000	228,100	231,200	234,300	237,400	240,500	243,600	79
80	183,000	186,200	189,300	192,500	195,600	198,800	201,900	205,000	208,200	211,400	214,600	217,800	221,000	224,200	227,500	230,800	234,100	237,400	240,700	244,000	247,300	250,600	80
82	188,000	191,100	194,100	197,200	200,200	203,200	206,200	209,200	212,300	215,300	218,400	221,500	224,600	227,700	230,800	233,900	237,000	240,100	243,200	246,300	249,400	252,500	82
83	192,000	195,100	198,100	201,200	204,200	207,200	210,300	213,300	216,400	219,400	222,500	225,600	228,700	231,800	234,900	238,000	241,100	244,200	247,300	250,400	253,500	256,600	83
84	201,800	205,200	208,600	211,900	215,200	218,500	221,800	225,100	228,400	231,700	235,000	238,300	241,600	244,900	248,200	251,500	254,800	258,100	261,400	264,700	268,000	271,300	84
86	210,800	214,200	217,500	220,800	224,100	227,400	230,700	234,000	237,300	240,700	244,000	247,400	250,800	254,200	257,600	261,000	264,400	267,800	271,200	274,600	278,000	281,400	86
87	220,700	224,200	227,800	231,300	234,800	238,200	241,700	245,200	248,700	252,100	255,700	259,200	262,700	266,300	269,900	273,500	277,100	280,800	284,500	288,300	292,000	295,800	87
89	229,600	233,200	236,700	240,200	243,700	247,200	250,700	254,200	257,700	261,200	264,700	268,200	271,700	275,200	278,700	282,200	285,700	289,200	292,700	296,200	299,700	303,200	89
90	239,500	243,300	247,000	250,700	254,400	258,100	261,800	265,500	269,200	272,900	276,600	280,300	284,000	287,700	291,400	295,100	298,800	302,500	306,200	310,000	313,700	317,400	90
92	248,500	252,200	255,900	259,600	263,300	266,900	270,500	274,200	277,900	281,600	285,300	289,000	292,700	296,400	300,100	303,800	307,500	311,200	314,900	318,600	322,300	326,000	92
93	258,400	262,300	266,200	270,100	273,900	277,700	281,500	285,300	289,100	292,900	296,800	300,600	304,500	308,400	312,300	316,200	320,100	324,000	327,900	331,800	335,700	339,600	93
95	269,400	273,400	277,300	281,100	285,000	288,800	292,600	296,300	300,100	303,900	307,700	311,600	315,500	319,400	323,300	327,200	331,100	335,000	338,900	342,800	346,700	350,600	95
96	279,300	283,500	287,500	291,600	295,600	299,600	303,500	307,500	311,500	315,400	319,400	323,400	327,400	331,500	335,500	339,600	343,700	347,700	351,800	355,800	359,900	364,000	96
98	290,400	294,600	298,600	302,700	306,700	310,600	314,600	318,500	322,500	326,400	330,400	334,400	338,400	342,500	346,500	350,600	354,700	358,800	362,900	367,000	371,100	375,200	98
99	300,300	304,600	308,900	313,100	317,300	321,400	325,600	329,700	333,800	337,900	342,000	346,200	350,400	354,500	358,700	362,900	367,100	371,300	375,500	379,700	384,000	388,300	99
101	311,400	315,700	320,000	324,200	328,400	332,500	336,600	340,700	344,800	348,900	353,000	357,200	361,300	365,500	369,700	373,900	378,100	382,300	386,500	390,700	395,000	399,300	101
102	321,300	325,800	330,200	334,600	339,000	343,300	347,600	351,900	356,100	360,400	364,700	369,000	373,300	377,600	382,000	386,400	390,800	395,200	399,600	404,000	408,400	412,800	102
104	332,400	336,900	341,300	345,700	350,100	354,400	358,800	363,100	367,500	371,800	376,100	380,500	384,900	389,300	393,700	398,100	402,500	406,900	411,300	415,700	420,100	424,500	104
105	342,300	346,900	351,300	355,700	360,100	364,500	368,900	373,200	377,600	381,900	386,300	390,700	395,100	399,500	403,900	408,300	412,700	417,100	421,500	425,900	430,300	434,700	105
106	346,300	351,000	355,500	360,000	364,500	368,900	373,200	377,600	381,900	386,300	390,700	395,100	399,500	403,900	408,300	412,700	417,100	421,500	425,900	430,300	434,700	439,100	106
107	366,100	371,100	376,000	380,900	385,700	390,500	395,200	399,900	404,600	409,300	414,000	418,700	423,400	428,100	432,800	437,500	442,200	446,900	451,600	456,300	461,000	465,700	107
108	376,100	381,100	386,000	390,900	395,700	400,500	405,200	409,900	414,500	419,200	423,900	428,600	433,300	438,000	442,700	447,400	452,100	456,800	461,500	466,200	470,900	475,600	108
109	386,000	391,200	396,300	401,300	406,300	411,300	416,300	421,300	426,300	431,300	436,300	441,300	446,300	451,300	456,300	461,300	466,300	471,300	476,300	481,300	486,300	491,300	109
110	396,000	401,200	406,300	411,400	416,500	421,600	426,700	431,800	436,900	442,000	447,100	452,200	457,300	462,400	467,500	472,600	477,700	482,800	487,900	493,000	498,100	503,200	110
111	405,900	411,300	416,600	421,900	427,200	432,500	437,800	443,100	448,400	453,700	459,000	464,300	469,600	474,900	480,200	485,500	490,800	496,100	501,400	506,700	512,000	517,300	111
112	414,400	419,800	425,000	430,200	435,400	440,600	445,800	451,000	456,200	461,400	466,600	471,800	477,000	482,200	487,400	492,600	497,800	503,000	508,200	513,400	518,600	523,800	112
113	435,700	441,500	447,100	452,700	458,200	463,600	469,100	474,400	479,800	485,100	490,500	495,800	501,100	506,500	511,900	517,300	522,700	528,100	533,500	539,000	544,400	549,900	113
114	445,700	451,500	457,100	462,700	468,200	473,600	479,100	484,400	489,800	495,100	500,500	505,800	511,100	516,500	521,900	527,300	532,700	538,100	543,500	549,000	554,400	559,900	114
115	455,600	461,600	467,400	473,100	478,800	484,400	490,000	495,500	501,000	506,500	512,000	517,500	523,000	528,500	534,000	539,500	545,000	550,500	556,000	561,500	567,000	572,500	115
116	464,100	470,000	475,800	481,600	487,200	492,800	498,300	503,800	509,200	514,700	520,100	525,600	531,000	536,500	542,000	547,500	553,000	558,500	564,000	569,500	575,000	580,500	116
117	475,500	481,600	487,700	493,800	499,900	505,900	511,900	517,900	523,900	529,900	535,900	541,900	547,900	553,900	559,900	565,900	571,900	577,900	583,900	589,900	595,900	601,900	117
118	493,900	500,200	506,400	512,500	518,400	524,400	530,200	536,000	541,800	547,600	553,300	559,100	564,900	570,700	576,500								

# GUNTERSVILLE DAM SPILLWAY DISCHARGE IN CUBIC FEET PER SECOND

GATE # - ELEVATION	HEADWATER ELEVATION																				GATE # - ELEVATION		
	598.0	598.2	598.4	598.6	598.8	599.0	599.2	599.4	599.6	599.8	600.0	600.2	600.4	600.6	600.8	601.0	601.2	601.4	601.6	601.8		602.0	
61																						61	
62																							62
63																							63
64	155,000	157,000	152,400	154,200	156,100	158,000	159,900	161,800	163,700	165,600	167,500											64	
65	161,400	163,500	159,000	161,000	163,000	165,100	167,100	169,200	171,200	173,300	175,400											65	
66	164,800	166,900	169,000	171,100	173,200	175,300	177,500	179,700	181,800	184,000	186,200											66	
67	168,100	170,200	172,300	174,500	176,600	178,800	180,900	183,100	185,300	187,500	189,700											67	
68	174,400	176,700	179,000	181,200	183,500	185,800	188,200	190,500	192,900	195,200	197,600											68	
69	180,800	183,200	185,600	188,000	190,500	192,900	195,400	197,900	200,400	202,900	205,400											69	
70	187,200	189,700	192,200	194,800	197,400	200,000	202,600	205,300	207,900	210,600	213,300											70	
71	193,500	196,200	198,900	201,600	204,300	207,100	209,900	212,700	215,500	218,300	221,100											71	
72	199,900	202,700	205,500	208,400	211,300	214,200	217,100	220,100	223,000	226,000	229,000											72	
73	209,500	212,500	215,500	218,500	221,600	224,700	227,800	230,900	234,100	237,200	240,400											73	
74	219,200	222,300	225,500	228,700	231,900	235,200	238,500	241,800	245,100	248,400	251,800											74	
75	225,600	228,800	232,200	235,500	238,800	242,300	245,700	249,200	252,600	256,100	259,600											75	
77	228,300	231,500	234,700	237,900	241,100	244,400	247,700	251,000	254,400	257,700	261,100											77	
78	234,700	238,000	241,300	244,700	248,100	251,500	254,900	258,400	261,900	265,400	269,000											78	
79	241,300	244,600	248,000	251,300	254,700	258,100	261,500	265,000	268,400	271,900	275,400											79	
80	247,700	251,100	254,600	258,100	261,600	265,200	268,800	272,400	276,000	279,600	283,300											80	
82	250,400	253,800	257,100	260,500	263,900	267,300	270,800	274,300	277,700	281,200	284,800											82	
83	256,800	260,300	263,800	267,300	270,800	274,400	278,000	281,600	285,300	288,900	292,600											83	
84	269,900	273,500	277,100	280,700	284,400	288,100	291,800	295,600	299,400	303,100	306,900											84	
86	278,900	282,600	286,200	289,900	293,600	297,300	301,100	304,900	308,600	312,400	316,300											86	
87	292,000	295,800	299,500	303,300	307,200	311,000	314,900	318,800	322,700	326,600	330,600											87	
89	301,100	304,900	308,700	312,500	316,400	320,200	324,200	328,100	332,000	336,000	339,900											89	
90	314,100	318,100	322,000	325,900	329,900	333,900	338,000	342,000	346,100	350,200	354,200											90	
92	323,200	327,200	331,100	335,100	339,100	343,200	347,200	351,300	355,400	359,500	363,600											92	
93	336,300	340,400	344,500	348,600	352,700	356,900	361,000	365,200	369,400	373,700	377,900											93	
95	347,300	351,400	355,500	359,600	363,800	367,900	372,100	376,300	380,500	384,700	388,900											95	
96	360,400	364,600	368,800	373,100	377,300	381,600	385,900	390,200	394,600	398,900	403,200											96	
98	371,400	375,700	379,900	384,100	388,400	392,700	397,000	401,300	405,600	409,900	414,300											98	
99	384,500	388,800	393,200	397,600	402,000	406,400	410,800	415,200	419,700	424,100	428,600											99	
101	395,500	399,900	404,300	408,800	413,000	417,400	421,900	426,300	430,700	435,200	439,600											101	
102	408,600	413,100	417,600	422,100	426,600	431,100	435,700	440,200	444,800	449,400	453,900											102	
104	419,600	424,100	428,600	433,100	437,700	442,200	446,800	451,300	455,800	460,400	464,900											104	
105	432,700	437,300	441,900	446,600	451,200	455,900	460,600	465,200	469,900	474,600	479,300											105	
107	462,200	467,100	472,000	476,900	481,900	486,800	491,800	496,700	501,700	506,700	511,600											107	
108	472,200	477,200	482,100	487,100	492,000	497,000	501,900	506,900	511,900	516,800	521,800											108	
109	485,300	490,400	495,400	500,500	505,600	510,700	515,800	520,800	525,900	531,000	536,100											109	
110	495,400	500,400	505,500	510,600	515,700	520,800	525,900	531,000	536,100	541,200	546,300											110	
111	508,400	513,500	518,600	524,100	529,300	534,500	539,700	545,000	550,200	555,400	560,600											111	
112	516,300	521,500	526,700	531,900	537,100	542,300	547,500	552,700	557,900	563,100	568,300											112	
113	544,600	550,100	555,600	561,000	566,500	572,000	577,500	583,000														113	
114	554,700	560,200	565,700	571,200	576,700	582,200																114	
115	567,700	573,300	579,000	584,600																		115	
116	575,600	581,200																				116	

HEADWATER 598 to 602  
TAILWATER 585.51 to 586.50

MARCH 2004

GUNTERSVILLE DAM  
**SPILLWAY DISCHARGE**  
 IN CUBIC FEET PER SECOND

GATE RANGE MENT	HEADWATER ELEVATION																				GATE RANGE MENT	
	590.0	590.2	590.4	590.6	590.8	591.0	591.2	591.4	591.6	591.8	592.0	592.2	592.4	592.6	592.8	593.0	593.2	593.4	593.6	593.8		594.0
78																					167,000	78
79																					172,700	79
80																					176,600	80
82																					178,000	82
83																167,500	167,700	166,000	165,900	169,300	181,400	83
84																					185,300	84
86																					194,800	86
87																					203,500	87
89																					213,000	89
90						168,000	172,600	177,100	181,500	185,800	189,900	194,000	198,100	202,200	206,300	210,400	214,500	218,700	222,900	227,000	231,200	90
92				166,600	171,400	176,200	181,000	185,600	190,100	194,400	198,600	202,700	206,800	210,800	214,900	219,000	223,100	227,300	231,500	235,700	239,900	92
93				172,800	177,800	182,800	187,700	192,500	197,200	201,700	206,100	210,400	214,700	218,900	223,200	227,500	231,900	236,200	240,600	245,000	249,400	93
95	167,300	172,400	177,500	182,700	187,900	193,000	198,100	203,100	207,900	212,500	216,900	221,200	225,400	229,600	233,900	238,200	242,500	246,900	251,300	255,800	260,200	95
96	172,800	178,100	183,500	188,800	194,200	199,600	204,900	210,000	215,000	219,800	224,400	228,900	233,300	237,800	242,200	246,700	251,300	255,900	260,500	265,100	269,700	96
98	182,300	187,800	193,200	198,700	204,300	209,800	215,300	220,600	225,700	230,500	235,200	239,700	244,100	248,500	252,900	257,400	262,000	266,600	271,200	275,800	280,500	98
99	187,800	193,500	199,200	204,800	210,600	216,300	222,000	227,500	232,800	237,900	242,700	247,400	252,000	256,600	261,200	265,900	270,700	275,500	280,300	285,200	290,000	99
101	197,300	203,100	208,900	214,800	220,700	226,600	232,400	238,100	243,500	248,600	253,500	258,100	262,700	267,300	271,900	276,600	281,400	286,200	291,000	295,900	300,700	101
102	202,800	208,900	214,800	220,900	227,000	233,100	239,200	245,000	250,600	255,900	261,000	265,900	270,600	275,400	280,200	285,100	290,100	295,100	300,200	305,200	310,300	102
104	212,400	218,500	224,600	230,800	237,100	243,400	249,600	255,600	261,300	266,700	271,700	276,600	281,400	286,100	290,900	295,800	300,800	305,800	310,900	315,900	321,000	104
105	217,900	224,200	230,500	236,900	243,400	249,900	256,300	262,500	268,400	274,000	279,300	284,300	289,300	294,200	299,300	304,400	309,500	314,700	320,000	325,300	330,600	105
106	222,900	229,200	235,500	241,900	248,400	254,900	261,300	267,500	273,400	278,900	284,000	289,000	293,900	298,700	303,700	308,700	313,800	318,900	324,100	329,400	334,600	106
107	233,900	240,600	247,300	254,100	261,000	267,900	274,800	281,400	287,600	293,500	299,100	304,400	309,700	315,000	320,300	325,700	331,300	336,800	342,400	348,000	353,700	107
108	242,500	249,400	256,200	263,100	270,100	277,200	284,200	290,900	297,300	303,200	308,800	314,100	319,400	324,600	330,000	335,400	340,900	346,500	352,100	357,700	363,400	108
109	248,000	255,100	262,100	269,200	276,500	283,700	290,900	297,800	304,400	310,500	316,300	321,900	327,300	332,800	338,300	343,900	349,600	355,400	361,200	367,100	372,900	109
110	256,700	263,800	270,900	278,200	285,600	293,000	300,300	307,400	314,000	320,200	326,000	331,600	337,000	342,400	347,900	353,600	359,300	365,100	370,900	376,800	382,600	110
111	262,200	269,500	276,900	284,300	291,900	299,500	307,100	314,300	321,200	327,500	333,500	339,300	344,900	350,500	356,300	362,100	368,000	374,000	380,000	386,100	392,200	111
112	270,000	277,500	284,900	292,400	300,100	307,900	315,500	322,900	329,800	336,200	342,200	347,900	353,500	359,000	364,700	370,500	376,400	382,300	388,300	394,400	400,400	112
113	281,800	289,700	297,500	305,500	313,700	321,900	329,900	337,700	345,000	351,900	358,300	364,400	370,400	376,500	382,600	388,800	395,100	401,500	408,000	414,500	420,900	113
114	290,400	298,400	306,400	314,500	322,800	331,100	339,400	347,300	354,700	361,600	368,000	374,100	380,100	386,100	392,200	398,500	404,800	411,200	417,700	424,200	430,600	114
115	295,900	304,100	312,300	320,600	329,100	337,700	346,100	354,200	361,800	368,900	375,500	381,900	388,100	394,300	400,600	407,000	413,500	420,100	426,800	433,500	440,200	115
116	303,800	312,100	320,300	328,700	337,400	346,000	354,600	362,800	370,400	377,500	384,200	390,500	396,600	402,700	409,000	415,400	421,900	428,500	435,100	441,800	448,400	116
117	310,000	318,600	327,100	335,700	344,600	353,500	362,200	370,700	378,600	385,900	392,700	399,300	405,700	412,000	418,500	425,200	431,900	438,700	445,600	452,500	459,400	117
118	323,400	332,200	341,000	350,000	359,100	368,400	377,400	386,200	394,300	401,900	408,900	415,600	422,100	428,700	435,300	442,100	449,000	456,000	463,100	470,100	477,200	118
119	337,500	346,700	355,800	365,000	374,600	384,200	393,600	402,600	411,100	418,900	426,100	433,000	439,700	446,400	453,300	460,300	467,400	474,600	481,900	489,200	496,500	119
120	350,900	360,300	369,700	379,300	389,100	399,000	408,800	418,100	426,900	434,900	442,300	449,300	456,200	463,000	470,000	477,200	484,500	491,800	499,300	506,800	514,300	120



# GUNTERSVILLE DAM SPILLWAY DISCHARGE IN CUBIC FEET PER SECOND

GAGE ELEVATION FEET	HEADWATER ELEVATION																				GAGE ELEVATION FEET	
	594.0	594.2	594.4	594.6	594.8	595.0	595.2	595.4	595.6	595.8	596.0	596.2	596.4	596.6	596.8	597.0	597.2	597.4	597.6	597.8		598.0
68																						68
69																						69
70																						70
71																						71
72										166,500	169,100	166,600	169,200	171,800	174,300	176,900	179,500	182,100	184,700	187,300	189,900	72
73																						73
74																						74
75																						75
76																						76
77																						77
78	167,000	166,400	169,500	172,700	175,800	178,900	182,000	185,000	188,000	191,000	194,100	197,100	200,100	203,100	206,100	209,100	212,200	215,200	218,300	221,400	224,500	78
79	172,700	176,100	179,500	182,800	186,200	189,500	192,700	195,900	199,100	202,300	205,500	208,700	211,800	215,000	218,200	221,300	224,500	227,700	230,900	234,100	237,300	79
80	176,600	180,100	183,600	187,100	190,500	193,900	197,300	200,700	204,000	207,300	210,600	213,900	217,200	220,400	223,700	227,000	230,300	233,600	236,900	240,200	243,600	80
82	181,400	184,800	188,200	191,500	194,900	198,200	201,400	204,700	207,900	211,100	214,300	217,400	220,600	223,800	227,000	230,200	233,400	236,600	239,800	243,000	246,300	82
83	185,300	188,800	192,300	195,800	199,200	202,700	206,000	209,400	212,700	216,000	219,300	222,600	225,900	229,300	232,600	235,900	239,200	242,500	245,900	249,200	252,600	83
84	194,800	198,500	202,200	205,900	209,600	213,200	216,800	220,300	223,800	227,300	230,800	234,200	237,700	241,100	244,600	248,000	251,500	255,000	258,400	261,900	265,400	84
86	203,500	207,200	210,900	214,600	218,300	221,900	225,500	229,000	232,500	236,000	239,500	243,000	246,500	249,900	253,400	256,900	260,400	263,900	267,400	270,900	274,500	86
87	213,000	217,000	220,900	224,800	228,600	232,500	236,200	240,000	243,800	247,500	251,200	254,900	258,600	262,300	265,900	269,600	273,200	276,800	280,400	283,600	287,300	87
89	221,700	225,600	229,400	233,300	237,100	240,900	244,700	248,500	252,300	256,100	259,900	263,700	267,500	271,300	275,100	278,900	282,700	286,500	290,300	294,100	297,900	89
90	231,200	235,400	239,500	243,600	247,700	251,700	255,700	259,600	263,500	267,400	271,300	275,200	279,100	283,000	286,900	290,800	294,700	298,600	302,500	306,400	310,300	90
92	239,900	244,100	248,200	252,300	256,400	260,500	264,400	268,300	272,200	276,100	279,900	283,700	287,500	291,300	295,100	298,900	302,700	306,500	310,300	314,100	317,900	92
93	249,400	253,800	258,200	262,500	266,800	271,000	275,100	279,300	283,300	287,300	291,300	295,300	299,300	303,200	307,200	311,100	315,100	319,000	323,000	327,000	331,000	93
95	260,200	264,600	268,900	273,300	277,600	281,800	286,000	290,000	294,100	298,100	302,200	306,100	310,100	314,100	318,000	322,000	325,900	329,900	333,900	337,900	341,900	95
96	269,700	274,300	278,900	283,400	287,900	292,300	296,700	301,000	305,200	309,400	313,600	317,700	321,900	326,000	330,100	334,200	338,200	342,300	346,500	350,600	354,700	96
98	280,500	285,100	289,700	294,200	298,700	303,100	307,500	311,800	316,000	320,200	324,400	328,500	332,700	336,800	340,900	345,000	349,100	353,200	357,400	361,500	365,700	98
99	290,000	294,800	299,600	304,400	309,000	313,700	318,200	322,700	327,100	331,500	335,800	340,100	344,400	348,700	352,900	357,200	361,400	365,700	369,900	374,200	378,500	99
101	300,700	305,600	310,400	315,100	319,800	324,500	329,000	333,500	337,900	342,300	346,600	351,000	355,300	359,500	363,800	368,100	372,300	376,600	380,900	385,200	389,500	101
102	310,300	315,300	320,300	325,300	330,200	335,000	339,800	344,400	349,000	353,600	358,100	362,600	367,000	371,400	375,800	380,200	384,600	389,000	393,400	397,900	402,300	102
104	321,000	326,100	331,100	336,100	341,000	345,800	350,600	355,200	359,800	364,400	368,900	373,400	377,800	382,300	386,700	391,100	395,500	399,900	404,300	408,800	413,300	104
105	330,600	335,800	341,000	346,200	351,300	356,400	361,300	366,100	370,900	375,600	380,300	385,000	389,600	394,100	398,700	403,300	407,800	412,400	416,900	421,500	426,100	105
106	334,600	339,800	344,900	350,100	355,100	360,100	364,900	369,700	374,400	379,100	383,800	388,400	393,000	397,500	402,100	406,600	411,200	415,800	420,300	424,900	429,600	106
107	353,700	359,300	364,800	370,300	375,800	381,100	386,400	391,500	396,600	401,700	406,600	411,600	416,400	421,300	426,200	431,000	435,800	440,600	445,500	450,300	455,200	107
108	363,400	369,000	374,600	380,100	385,500	390,900	396,100	401,300	406,400	411,400	416,400	421,400	426,300	431,100	436,000	440,800	445,700	450,500	455,400	460,300	465,200	108
109	372,900	378,700	384,500	390,200	395,900	401,400	406,900	412,200	417,500	422,700	427,800	432,900	438,000	443,000	448,000	453,000	458,000	463,000	468,000	473,000	478,000	109
110	382,600	388,400	394,200	400,000	405,600	411,200	416,600	422,000	427,300	432,500	437,600	442,700	447,800	452,800	457,900	462,900	467,900	472,900	477,900	483,000	488,000	110
111	392,200	398,200	404,200	410,100	416,000	421,700	427,400	432,900	438,400	443,700	449,100	454,300	459,600	464,700	469,900	475,000	480,200	485,300	490,500	495,700	500,800	111
112	400,400	406,400	412,400	418,300	424,100	429,900	435,500	441,000	446,400	451,700	457,000	462,300	467,500	472,600	477,800	482,900	488,000	493,200	498,300	503,500	508,700	112
113	420,900	427,400	433,800	440,200	446,400	452,600	458,600	464,500	470,300	476,100	481,700	487,300	492,800	498,300	503,800	509,200	514,700	520,100	525,500	531,000	536,500	113
114	430,600	437,100	443,500	449,900	456,200	462,300	468,400	474,300	480,100	485,800	491,500	497,100	502,700	508,200	513,600	519,100	524,600	530,000	535,500	541,000	546,500	114
115	440,200	446,900	453,500	460,100	466,500	472,900	479,100	485,200	491,200	497,100	502,900	508,700	514,400	520,100	525,700	531,300	536,900	542,400	548,000	553,700	559,300	115
116	448,400	455,100	461,700	468,200	474,700	481,000	487,200	493,300	499,200	505,100	510,900	516,600	522,300	528,000	533,600	539,100	544,700	550,300	555,900	561,500	567,100	116
117	459,400	466,300	473,200	479,900	486,600	493,200	499,600	505,900	512,100	518,200	524,200	530,100	535,900	541,800	547,500	553,300	559,000	564,800	570,500	576,300	582,100	117
118	477,200	484,300	491,300	498,300	505,100	511,800	518,400	524,900	531,200	537,400	543,500	549,600	555,600	561,500	567,400	573,300	579,200	585,100	591,000	596,900	602,800	118
119	496,500	503,800	511,000	518,200	525,200	532,100	538,900	545,500	552,100	558,500	564,800	571,000	577,100	583,200	589,300	595,300	601,300					119
120	514,300	521,700	529,200	536,500	543,700	550,800	557,700	564,500	571,200	577,700	584,100	590,500	596,800									120

HEADWATER 594 to 598  
TAILWATER 586.51 to 587.50

GUNTERSVILLE DAM  
**SPILLWAY DISCHARGE**  
 IN CUBIC FEET PER SECOND

RANGE- FEET	HEADWATER ELEVATION																				RANGE- FEET	
	598.0	598.2	598.4	598.6	598.8	599.0	599.2	599.4	599.6	599.8	600.0	600.2	600.4	600.6	600.8	601.0	601.2	601.4	601.6	601.8		602.0
64																						64
65					166,700	168,900	171,000	165,900	168,000	170,000	172,100											65
66			165,500	167,600	169,800	171,900	174,000	176,100	178,300	180,400	182,600											66
67		166,700	168,900	171,000	173,200	175,300	177,500	179,600	181,800	184,000	186,200											67
68	170,900	173,200	175,400	177,700	180,000	182,300	184,600	186,900	189,200	191,500	193,900											68
69	177,300	179,600	182,000	184,400	186,800	189,300	191,700	194,200	196,600	199,100	201,600											69
70	183,600	186,100	188,600	191,100	193,700	196,300	198,800	201,400	204,100	206,700	209,300											70
71	189,900	192,500	195,200	197,800	200,500	203,200	206,000	208,700	211,500	214,200	217,000											71
72	196,200	199,000	201,700	204,500	207,400	210,200	213,100	216,000	218,900	221,800	224,800											72
73	205,800	208,700	211,700	214,600	217,600	220,600	223,700	226,700	229,800	232,900	236,000											73
74	215,400	218,500	221,600	224,700	227,800	231,000	234,300	237,500	240,700	244,000	247,300											74
75	221,800	225,000	228,200	231,400	234,700	238,000	241,400	244,800	248,200	251,600	255,000											75
77	224,500	227,600	230,700	233,800	237,000	240,300	243,500	246,800	250,100	253,400	256,700											77
78	230,800	234,000	237,300	240,600	243,900	247,200	250,600	254,000	257,500	261,000	264,400											78
79	237,300	240,500	243,800	247,000	250,300	253,700	257,100	260,500	263,900	267,300	270,800											79
80	243,600	247,000	250,300	253,700	257,200	260,700	264,200	267,700	271,300	274,900	278,500											80
82	246,300	249,600	252,900	256,200	259,500	262,900	266,300	269,800	273,200	276,700	280,200											82
83	252,600	256,000	259,400	262,900	266,400	269,900	273,500	277,000	280,600	284,300	287,900											83
84	265,400	269,000	272,500	276,100	279,700	283,300	287,000	290,700	294,400	298,200	301,900											84
86	274,500	278,000	281,500	285,200	288,900	292,600	296,300	300,000	303,800	307,500	311,300											86
87	287,300	291,000	294,700	298,400	302,200	306,000	309,800	313,700	317,600	321,500	325,400											87
89	296,300	300,000	303,800	307,500	311,400	315,200	319,100	323,000	326,900	330,800	334,800											89
90	309,100	313,000	316,800	320,700	324,700	328,600	332,600	336,700	340,700	344,800	348,800											90
92	318,100	322,000	325,900	329,900	333,900	337,900	341,900	346,000	350,000	354,100	358,200											92
93	331,000	335,000	339,000	343,100	347,200	351,300	355,500	359,600	363,800	368,100	372,300											93
95	341,900	346,000	350,000	354,100	358,200	362,400	366,600	370,800	375,000	379,200	383,400											95
96	354,700	358,900	363,100	367,300	371,500	375,800	380,100	384,400	388,800	393,100	397,500											96
98	365,700	369,900	374,100	378,300	382,600	386,900	391,200	395,500	399,900	404,300	408,600											98
99	378,500	382,800	387,200	391,500	395,900	400,300	404,800	409,200	413,700	418,200	422,700											99
101	389,500	393,800	398,200	402,600	407,000	411,400	415,900	420,300	424,800	429,300	433,800											101
102	402,300	406,800	411,300	415,800	420,300	424,900	429,400	434,000	438,600	443,200	447,900											102
104	413,300	417,800	422,300	426,800	431,400	435,900	440,500	445,100	449,700	454,400	459,000											104
105	426,100	430,700	435,300	440,000	444,700	449,400	454,100	458,800	463,500	468,300	473,100											105
107	455,200	460,100	465,000	470,000	474,900	479,900	484,900	490,000	495,000	500,000	505,100											107
108	465,200	470,100	475,100	480,100	485,100	490,100	495,100	500,200	505,200	510,300	515,400											108
109	478,000	483,100	488,200	493,300	498,400	503,500	508,700	513,900	519,000	524,200	529,400											109
110	488,000	493,100	498,200	503,400	508,500	513,700	518,900	524,100	529,300	534,500	539,700											110
111	500,800	506,100	511,300	516,500	521,800	527,100	532,400	537,700	543,100	548,400	553,700											111
112	508,700	513,900	519,100	524,400	529,700	535,000	540,300	545,600	550,900	556,200	561,600											112
113	536,500	542,000	547,500	553,000	558,600	564,100	569,700	575,300	580,900	586,500	592,100											113
114	546,500	552,000	557,500	563,100	568,700	574,300	579,900	585,500	591,100	596,800												114
115	559,300	564,900	570,600	576,300	582,000	587,700	593,500	599,200														115
116	567,100	572,800	578,500	584,200	589,900	595,600	601,300															116
117	582,100	587,900	593,700	599,600																		117

# GUNTERSVILLE DAM SPILLWAY DISCHARGE IN CUBIC FEET PER SECOND

GATE NUMBER	HEADWATER ELEVATION																			GATE NUMBER		
	590.0	590.2	590.4	590.6	590.8	591.0	591.2	591.4	591.6	591.8	592.0	592.2	592.4	592.6	592.8	593.0	593.2	593.4	593.6		593.8	594.0
84																						84
86																						86
87																						87
89																						89
90																						90
92																						92
93																						93
95																						95
96																						96
98																						98
99																						99
101																						101
102																						102
104																						104
105																						105
106																						106
107																						107
108																						108
109																						109
110																						110
111																						111
112																						112
113																						113
114																						114
115																						115
116																						116
117																						117
118																						118
119																						119
120																						120

HEADWATER 590 to 594  
TAILWATER 587.51 to 588.50

MARCH 2004

GUNTERSVILLE DAM  
**SPILLWAY DISCHARGE**  
 IN CUBIC FEET PER SECOND

GATE ELEVATION	HEADWATER ELEVATION																			GATE ELEVATION		
	594.0	594.2	594.4	594.6	594.8	595.0	595.2	595.4	595.6	595.8	596.0	596.2	596.4	596.6	596.8	597.0	597.2	597.4	597.6		597.8	598.0
70																						70
71																						71
72																						72
73																						73
74											179,900	183,100	186,400	181,200	184,300	187,300	181,400	184,200	187,000	189,800	192,600	74
75																						75
77																						77
78																						78
79																						79
80					182,700	181,900	179,700	183,100	181,800	185,100	188,400	191,800	195,100	198,300	201,600	204,800	208,000	211,200	214,300	217,500	220,700	80
82																						82
83																						83
84	185,600	180,200	179,900	183,400	186,900	190,400	194,000	197,500	201,100	204,600	208,100	211,700	215,200	218,600	222,100	225,500	228,800	232,200	235,500	238,900	242,200	84
86	194,200	198,000	201,800	205,700	209,600	213,500	217,400	221,200	225,100	229,000	232,900	236,700	240,500	244,300	248,100	251,800	255,500	259,100	262,800	266,400	270,100	86
87	203,200	207,200	211,300	215,400	219,500	223,600	227,700	231,800	235,900	239,900	244,000	248,000	252,000	255,900	259,800	263,700	267,500	271,300	275,100	278,900	282,600	87
89	211,700	215,700	219,800	223,900	228,000	232,100	236,200	240,300	244,400	248,500	252,600	256,600	260,600	264,600	268,500	272,400	276,300	280,100	283,900	287,700	291,500	89
90	220,800	225,000	229,300	233,600	237,900	242,200	246,500	250,800	255,100	259,400	263,700	267,900	272,100	276,200	280,300	284,400	288,400	292,300	296,300	300,200	304,100	90
92	229,300	233,500	237,800	242,100	246,400	250,700	255,000	259,300	263,600	267,900	272,200	276,500	280,700	284,900	289,000	293,100	297,100	301,100	305,100	309,100	313,000	92
93	238,400	242,800	247,300	251,800	256,300	260,800	265,300	269,800	274,300	278,800	283,300	287,800	292,200	296,500	300,800	305,000	309,200	313,300	317,500	321,600	325,600	93
95	248,900	253,300	257,800	262,300	266,800	271,400	275,900	280,500	285,000	289,500	294,000	298,400	302,800	307,200	311,500	315,700	319,900	324,100	328,200	332,400	336,500	95
96	258,000	262,600	267,300	272,000	276,800	281,500	286,300	291,000	295,700	300,400	305,100	309,700	314,300	318,800	323,300	327,600	332,000	336,300	340,600	344,800	349,100	96
98	268,500	273,200	277,800	282,500	287,300	292,000	296,800	301,600	306,300	311,000	315,700	320,400	325,000	329,500	334,000	338,400	342,700	347,100	351,400	355,600	359,900	98
99	277,600	282,400	287,300	292,200	297,200	302,200	307,100	312,100	317,000	322,000	326,800	331,600	336,400	341,100	345,700	350,300	354,800	359,300	363,700	368,100	372,500	99
101	288,200	293,000	297,900	302,800	307,700	312,700	317,700	322,600	327,600	332,500	337,400	342,300	347,100	351,800	356,400	361,000	365,500	370,000	374,500	378,900	383,300	101
102	297,200	302,300	307,300	312,500	317,600	322,800	328,000	333,200	338,300	343,500	348,600	353,600	358,500	363,400	368,200	372,900	377,600	382,200	386,800	391,400	395,900	102
104	307,800	312,800	317,900	323,000	328,200	333,400	338,600	343,700	348,900	354,100	359,200	364,200	369,200	374,100	378,900	383,600	388,300	393,000	397,600	402,200	406,700	104
105	316,900	322,100	327,400	332,700	338,100	343,500	348,900	354,300	359,700	365,000	370,300	375,500	380,600	385,700	390,700	395,600	400,400	405,200	409,900	414,700	419,400	105
106	321,000	326,200	331,400	336,600	342,000	347,300	352,600	357,900	363,200	368,500	373,800	379,000	384,100	389,200	394,100	399,000	403,900	408,700	413,500	418,200	422,900	106
107	339,200	344,700	350,300	356,000	361,800	367,500	373,300	379,000	384,700	390,400	396,000	401,600	407,200	412,700	418,200	423,600	428,900	433,100	438,200	443,200	448,200	107
108	348,700	354,200	359,900	365,600	371,300	377,000	382,800	388,600	394,300	400,000	405,600	411,200	416,700	422,200	427,600	432,900	438,100	443,200	448,000	453,000	458,000	108
109	357,800	363,500	369,400	375,300	381,200	387,200	393,100	399,100	405,000	410,900	416,700	422,500	428,300	434,100	439,800	445,500	451,100	456,600	462,000	467,300	472,600	109
110	367,300	373,000	378,900	384,800	390,700	396,700	402,700	408,600	414,500	420,400	426,300	432,100	437,800	443,600	449,300	455,000	460,600	466,200	471,700	477,100	482,500	110
111	376,400	382,300	388,400	394,500	400,600	406,800	413,000	419,200	425,300	431,400	437,400	443,400	449,200	455,000	460,800	466,600	472,300	477,900	483,500	489,000	494,400	111
112	384,500	390,400	396,400	402,500	408,600	414,800	420,900	427,100	433,200	439,300	445,300	451,200	457,000	462,800	468,600	474,300	479,900	485,500	491,000	496,400	501,800	112
113	404,000	410,400	416,900	423,400	430,000	436,600	443,200	449,800	456,400	462,900	469,300	475,600	481,800	487,900	493,800	499,700	505,500	511,300	517,000	522,600	528,200	113
114	413,600	419,900	426,400	432,900	439,500	446,100	452,700	459,300	465,900	472,400	478,900	485,200	491,400	497,500	503,600	509,500	515,300	521,100	526,800	532,400	538,000	114
115	422,600	429,200	435,900	442,600	449,400	456,200	463,100	469,900	476,700	483,400	490,000	496,500	502,900	509,200	515,300	521,400	527,400	533,300	539,100	544,900	550,600	115
116	430,800	437,300	443,900	450,600	457,400	464,200	471,000	477,800	484,500	491,200	497,800	504,300	510,700	517,000	523,100	529,200	535,100	541,000	546,900	552,600	558,400	116
117	441,200	448,000	454,900	461,800	468,800	475,900	482,900	490,000	496,900	503,900	510,700	517,400	524,000	530,400	536,800	543,000	549,200	555,200	561,200	567,200	573,100	117
118	458,400	465,400	472,400	479,500	486,700	493,900	501,200	508,400	515,500	522,600	529,600	536,500	543,200	549,800	556,300	562,700	569,000	575,200	581,300	587,300	593,400	118
119	477,000	484,200	491,400	498,800	506,200	513,600	521,000	528,500	535,800	543,100	550,300	557,400	564,300	571,100	577,800	584,300	590,800	597,100	603,400	609,700		119
120	494,300	501,600	509,000	516,500	524,100	531,700	539,300	546,900	554,400	561,900	569,300	576,500	583,600	590,500	597,300	604,000						120

MARCH 2004

HEADWATER 594 to 598  
 TAILWATER 587.51 to 588.50

# GUNTERSVILLE DAM SPILLWAY DISCHARGE IN CUBIC FEET PER SECOND

GAINSE- SEGMENT	HEADWATER ELEVATION																			GAINSE- SEGMENT			
	598.0	598.2	598.4	598.6	598.8	599.0	599.2	599.4	599.6	599.8	600.0	600.2	600.4	600.6	600.8	601.0	601.2	601.4	601.6		601.8	602.0	
67																						67	
68																							68
69																							69
70	180,000	182,500	185,000	180,900	183,300	185,700	188,200	183,400	185,700	188,000	182,700												70
71	186,300	189,000	191,600	194,300	190,100	192,700	195,300	197,900	199,700	200,500	203,100												71
72	192,600	195,400	198,200	201,000	203,800	206,700	209,500	212,400	215,300	218,100	221,000												72
73	202,200	205,200	208,100	211,100	214,000	217,000	220,100	223,100	226,100	229,200	232,200												73
74	211,800	214,900	218,000	221,100	224,200	227,400	230,600	233,800	237,000	240,200	243,400												74
75	218,100	221,300	224,600	227,800	231,100	234,400	237,700	241,000	244,400	247,700	251,100												75
77	220,700	223,800	227,000	230,100	233,300	236,500	239,700	243,000	246,200	249,500	252,800												77
78	227,000	230,300	233,600	236,900	240,200	243,500	246,900	250,200	253,600	257,000	260,400												78
79	233,300	236,600	239,900	243,100	246,400	249,700	253,100	256,400	259,800	263,200	266,600												79
80	239,600	243,000	246,400	249,800	253,300	256,700	260,200	263,700	267,200	270,700	274,200												80
82	242,200	245,500	248,800	252,100	255,500	258,900	262,200	265,600	269,100	272,500	275,900												82
83	248,500	252,000	255,400	258,900	262,300	265,800	269,400	272,900	276,400	280,000	283,600												83
84	261,100	264,700	268,300	271,800	275,400	279,100	282,700	286,400	290,000	293,700	297,400												84
86	270,000	273,600	277,200	280,900	284,500	288,200	291,900	295,600	299,300	303,000	306,800												86
87	282,600	286,400	290,100	293,800	297,600	301,400	305,200	309,000	312,800	316,700	320,600												87
89	291,500	295,300	299,100	302,900	306,700	310,500	314,300	318,200	322,100	326,000	329,900												89
90	304,100	308,000	311,900	315,800	319,800	323,700	327,700	331,700	335,700	339,700	343,700												90
92	313,000	317,000	320,900	324,900	328,800	332,800	336,800	340,900	344,900	349,000	353,100												92
93	325,600	329,700	333,800	337,900	341,900	346,100	350,200	354,300	358,500	362,700	366,900												93
95	336,500	340,600	344,700	348,700	352,900	357,000	361,200	365,300	369,500	373,700	378,000												95
96	349,100	353,300	357,500	361,700	366,000	370,200	374,500	378,800	383,100	387,400	391,800												96
98	359,900	364,100	368,400	372,600	376,900	381,200	385,500	389,800	394,100	398,500	402,800												98
99	372,500	376,900	381,200	385,600	390,000	394,400	398,800	403,200	407,700	412,200	416,600												99
101	383,300	387,700	392,100	396,500	400,900	405,300	409,800	414,200	418,700	423,200	427,700												101
102	395,900	400,500	405,000	409,500	414,000	418,600	423,100	427,700	432,300	436,900	441,500												102
104	406,700	411,300	415,800	420,400	424,900	429,500	434,100	438,700	443,300	448,000	452,600												104
105	419,400	424,000	428,700	433,400	438,000	442,700	447,400	452,200	456,900	461,700	466,400												105
107	448,200	453,100	458,100	463,000	468,000	473,000	478,000	483,000	488,000	493,100	498,100												107
108	458,000	463,000	468,000	473,000	478,000	483,000	488,000	493,100	498,100	503,200	508,300												108
109	470,600	475,700	480,900	486,000	491,100	496,200	501,400	506,500	511,700	516,900	522,100												109
110	480,500	485,600	490,800	495,900	501,100	506,200	511,400	516,600	521,900	527,100	532,400												110
111	493,100	498,400	503,600	508,900	514,200	519,500	524,800	530,100	535,400	540,800	546,200												111
112	500,800	506,100	511,400	516,600	521,900	527,200	532,500	537,900	543,200	548,600	554,000												112
113	528,200	533,700	539,300	544,800	550,400	555,900	561,500	567,100	572,700	578,400	584,000												113
114	538,000	543,600	549,200	554,800	560,300	565,900	571,600	577,200	582,900	588,500	594,200												114
115	550,600	556,400	562,100	567,800	573,500	579,200	584,900	590,700	596,400	602,200	608,000												115
116	558,400	564,100	569,800	575,500	581,200	586,900	592,700	598,400	604,200	610,000													116
117	573,100	579,000	584,800	590,700	596,500	602,400	608,300																117
118	593,400	599,400	605,300																				118

HEADWATER 598 to 602  
TAILWATER 587.51 to 588.50

MARCH 2004

GUNTERSVILLE DAM  
**SPILLWAY DISCHARGE**  
 IN CUBIC FEET PER SECOND

GAUGE- NUMBER	HEADWATER ELEVATION																			GAUGE- NUMBER					
	590.0	590.2	590.4	590.6	590.8	591.0	591.2	591.4	591.6	591.8	592.0	592.2	592.4	592.6	592.8	593.0	593.2	593.4	593.6		593.8	594.0			
89																						197,000	201,300	89	
90																						205,400	209,900	90	
92																193,900	199,000	195,900	200,700			213,700	218,300	92	
93																201,400	206,700	204,000	209,000			212,000	217,100	93	
95													194,800	200,300	196,100	205,800	206,700	212,000	217,100			222,100	226,900	95	
96																						232,500	237,400	96	
98												195,900	201,600	207,400	213,100	218,800	224,400	230,000	235,500			240,800	245,900	98	
99											199,400	205,300	211,100	216,900	222,700	228,600	234,400	240,200	245,800			251,200	256,400	99	
101											205,800	211,900	217,900	224,000	230,000	236,100	242,100	248,100	254,000			259,600	265,000	101	
102									195,200	202,100	208,700	215,100	221,300	227,400	233,600	239,700	245,900	252,100	258,300	264,300			270,000	275,400	102
104									200,900	207,900	214,800	221,400	227,900	234,200	240,600	247,000	253,400	259,800	266,200	272,400			278,400	284,000	104
105						194,000	202,100	209,700	217,000	224,000	230,700	237,300	243,700	250,200	256,700	263,200	269,800	276,300	282,700	288,800			294,500	300,000	105
106						199,300	207,500	215,300	222,800	230,100	237,100	243,900	250,500	257,200	263,900	270,700	277,500	284,300	290,800	297,100			303,000	309,000	106
107					194,800	203,700	212,100	220,100	227,700	234,900	241,900	248,600	255,300	261,900	268,600	275,400	282,200	288,900	295,500	301,700			307,600	313,700	107
108				194,700	204,800	214,200	223,000	231,400	239,400	247,200	254,600	261,800	268,900	276,000	283,100	290,400	297,600	304,800	311,800	318,500			324,800	331,400	108
109				201,500	211,900	221,600	230,700	239,300	247,600	255,400	263,000	270,300	277,500	284,600	291,900	299,200	306,700	314,400	321,900	329,200			336,200	342,800	109
110			194,200	206,200	216,900	226,800	236,100	245,000	253,400	261,600	269,300	276,900	284,300	291,700	299,200	306,700	314,400	321,900	329,200	336,200			342,800	349,600	110
111			200,700	213,000	224,000	234,200	243,800	252,900	261,600	269,900	277,700	285,400	292,900	300,300	307,900	315,600	323,400	331,000	338,500	346,000			352,200	359,000	111
112			205,100	217,700	229,000	239,400	249,300	258,600	267,500	276,000	284,100	292,000	299,700	307,400	315,200	323,100	331,100	339,000	346,600	353,900			360,800	368,000	112
113		196,100	211,000	223,900	235,400	246,100	256,200	265,700	274,800	283,400	291,600	299,500	307,200	315,000	322,800	330,900	338,900	346,900	354,700	362,100			368,900	376,400	113
114			220,400	234,000	246,000	257,300	267,800	277,800	287,400	296,500	305,200	313,600	322,100	330,400	338,800	347,200	355,800	364,500	373,100	381,500			389,400	396,800	114
115	195,700	210,900	227,000	240,800	253,100	264,600	275,500	285,800	295,500	304,800	313,600	322,100	330,400	338,800	347,200	355,800	364,500	373,100	381,500	389,400			397,800	405,400	115
116	200,800	214,900	231,400	245,500	258,100	269,900	280,900	291,400	301,400	310,900	319,900	328,700	337,300	345,800	354,500	363,400	372,300	381,100	389,600	397,800			405,400	413,500	116
117	205,000	220,500	237,300	251,700	264,500	276,500	287,900	298,600	308,700	318,300	327,400	336,200	344,800	353,400	362,200	371,100	380,100	389,000	397,700	405,900			413,500	422,000	117
118	213,800	234,800	252,600	268,000	281,600	294,400	306,400	317,800	328,600	338,800	348,500	357,900	367,000	376,200	385,500	395,000	404,600	414,100	423,300	432,000			440,100	448,000	118
119	223,000	245,000	263,600	279,500	293,700	307,000	319,600	331,400	342,700	353,300	363,300	373,000	382,400	391,900	401,500	411,400	421,300	431,200	440,700	449,700			458,100	466,000	119
120	231,800	254,700	273,900	290,400	305,100	318,900	331,900	344,200	355,800	366,800	377,100	387,100	396,800	406,500	416,400	426,600	436,900	447,100	456,900	466,200			474,800	483,000	120

# GUNTERSVILLE DAM SPILLWAY DISCHARGE IN CUBIC FEET PER SECOND

GATE ARRANGE- MENT	HEADWATER ELEVATION																			GATE ARRANGE- MENT			
	594.0	594.2	594.4	594.6	594.8	595.0	595.2	595.4	595.6	595.8	596.0	596.2	596.4	596.6	596.8	597.0	597.2	597.4	597.6		597.8	598.0	
73																						73	
74																						74	
75																						75	
77																						77	
78															196, 300	194, 500	195, 000	198, 600	196, 300	199, 700	193, 900	197, 100	78
															200, 000	203, 600	201, 500	207, 300	210, 900	205, 800	209, 300	206, 600	
79																						79	
80																						80	
82																						82	
83																						83	
84																						84	
86																						86	
87																						87	
89																						89	
90																						90	
92																						92	
93																						93	
95																						95	
96																						96	
98																						98	
99																						99	
101																						101	
102																						102	
104																						104	
105																						105	
106																						106	
107																						107	
108																						108	
109																						109	
110																						110	
111																						111	
112																						112	
113																						113	
114																						114	
115																						115	
116																						116	
117																						117	
118																						118	
119																						119	
120																						120	

HEADWATER 594 to 598  
TAILWATER 588.51 to 589.50

MARCH 2004

GUNTERSVILLE DAM  
**SPILLWAY DISCHARGE**  
 IN CUBIC FEET PER SECOND

GAGE- ELEVATION	HEADWATER ELEVATION																			GAGE- ELEVATION			
	598.0	598.2	598.4	598.6	598.8	599.0	599.2	599.4	599.6	599.8	600.0	600.2	600.4	600.6	600.8	601.0	601.2	601.4	601.6		601.8	602.0	
69																						69	
70											194,100	196,700	199,400	199,400	202,100							70	
71											201,300	204,100	206,900	209,700	209,700							71	
72											208,600	211,500	214,500	217,400	217,400							72	
119	603,800																					119	



## GUNTERSVILLE DAM SPILLWAY DISCHARGE IN CUBIC FEET PER SECOND

GATE ELEVATION	HEADWATER ELEVATION																			GATE ELEVATION		
	590.0	590.2	590.4	590.6	590.8	591.0	591.2	591.4	591.6	591.8	592.0	592.2	592.4	592.6	592.8	593.0	593.2	593.4	593.6		593.8	594.0
93																					210,700	93
95																					220,300	95
96																					228,300	96
98																					237,900	98
99															208,400	214,900	214,100	210,700	226,000	232,000	245,900	99
101														210,700	217,500	224,000	230,400	236,700	242,900	249,200	255,600	101
102													209,700	217,000	224,000	230,800	237,500	244,000	250,400	257,000	263,500	102
104												210,400	218,300	225,800	233,100	240,000	246,700	253,300	259,900	266,500	273,200	104
105												216,200	224,400	232,100	239,600	246,800	253,800	260,600	267,400	274,300	281,200	105
106										211,900		220,700	228,900	236,800	244,300	251,500	258,400	265,200	272,000	278,700	285,600	106
107																						107
108													209,300	213,300	223,200	232,400	241,100	249,400	257,400	265,100	272,500	108
109													214,400	220,300	230,400	239,900	248,900	257,400	265,500	273,300	280,900	109
110													221,100	232,600	243,200	253,200	262,700	271,700	280,200	288,400	296,300	110
111												212,800	226,100	238,000	248,900	259,100	268,800	278,000	286,800	295,200	303,300	111
112																						112
113																						113
114																						114
115																						115
116																						116
117																						117
118																						118
119																						119
120					211,100	232,900	250,900	266,500	280,200	293,000	305,000	316,400	327,200	337,400	347,200	356,500	365,600	374,600	383,700	393,000	400,600	120
						220,700	242,700	261,400	277,500	291,800	305,000	317,500	329,400	340,600	351,200	361,200	370,900	380,200	389,500	398,900	408,500	
						230,100	253,100	272,600	289,300	304,100	317,900	330,900	343,200	354,800	365,900	376,300	386,300	396,000	405,600	415,200	425,100	
						239,000	262,900	283,100	300,300	315,600	329,900	343,400	356,100	368,200	379,600	390,400	400,600	410,600	420,500	430,400	440,600	

HEADWATER 590 to 594  
TAILWATER 589.51 to 590.50

MARCH 2004

GUNTERSVILLE DAM  
**SPILLWAY DISCHARGE**  
 IN CUBIC FEET PER SECOND

GATE ELEVATION	HEADWATER ELEVATION																			GATE ELEVATION			
	594.0	594.2	594.4	594.6	594.8	595.0	595.2	595.4	595.6	595.8	596.0	596.2	596.4	596.6	596.8	597.0	597.2	597.4	597.6		597.8	598.0	
78																						78	
79																							79
80																	209,900	213,800	217,800	221,700	225,700	229,700	80
82																	212,800	216,600	220,500	224,300	228,200	232,100	82
83															210,500	214,400	218,400	222,400	226,400	230,400	234,400	238,400	83
84																							84
86																							86
87																							87
89																							89
90																							90
92																							92
93																							93
95																							95
96																							96
98																							98
99																							99
101																							101
102																							102
104																							104
105																							105
106																							106
107																							107
108																							108
109																							109
110																							110
111																							111
112																							112
113																							113
114																							114
115																							115
116																							116
117																							117
118																							118
119																							119
120																							120

## GUNTERSVILLE DAM SPILLWAY DISCHARGE IN CUBIC FEET PER SECOND

DRAINAGE AREA - ACREFT	HEADWATER ELEVATION																				DRAINAGE AREA - ACREFT		
	598.0	598.2	598.4	598.6	598.8	599.0	599.2	599.4	599.6	599.8	600.0	600.2	600.4	600.6	600.8	601.0	601.2	601.4	601.6	601.8		602.0	
72										209,500	212,700											72	
73										220,400	223,700												73
74										231,200	234,800												74
75		208,800	212,600	216,300	218,600	220,000	222,200	223,800	227,500	231,300	235,000	238,700	242,400										75
77		211,300	214,900	218,600	222,200	225,900				233,200	236,800	240,400	244,000										77
78	213,800	217,600	221,400	225,200	229,000	232,800	236,600	240,400	244,100	247,900	251,600												78
79	219,400	223,300	227,100	230,900	234,700	238,500	242,300	246,000	249,800	253,600	257,300												79
80	225,700	229,600	233,600	237,500	241,400	245,400	249,300	253,200	257,100	261,000	264,900												80
82	228,200	232,100	235,900	239,800	243,600	247,500	251,300	255,100	258,900	262,700	266,500												82
83	234,400	238,400	242,400	246,400	250,400	254,400	258,400	262,300	266,300	270,200	274,100												83
84	246,300	250,400	254,600	258,700	262,900	267,000	271,100	275,200	279,300	283,300	287,400												84
86	255,000	259,200	263,500	267,700	271,800	276,000	280,200	284,300	288,400	292,500	296,600												86
87	266,800	271,200	275,600	280,000	284,300	288,600	292,900	297,200	301,500	305,700	309,900												87
89	275,600	280,000	284,500	288,900	293,300	297,600	302,000	306,300	310,600	314,900	319,100												89
90	287,400	292,000	296,600	301,200	305,700	310,200	314,700	319,200	323,600	328,000	332,400												90
92	296,200	300,900	305,500	310,100	314,700	319,300	323,800	328,300	332,800	337,200	341,600												92
93	308,000	312,800	317,600	322,400	327,100	331,900	336,500	341,200	345,800	350,300	354,900												93
95	318,700	323,600	328,400	333,200	338,000	342,700	347,400	352,100	356,700	361,300	365,800												95
96	330,500	335,600	340,600	345,500	350,400	355,300	360,200	365,000	369,700	374,400	379,100												96
98	341,200	346,300	351,300	356,300	361,300	366,200	371,100	375,900	380,600	385,400	390,100												98
99	353,100	358,300	363,500	368,600	373,700	378,800	383,800	388,800	393,700	398,500	403,300												99
101	363,700	369,000	374,300	379,400	384,600	389,700	394,700	399,700	404,600	409,500	414,300												101
102	375,600	381,000	386,400	391,700	397,000	402,300	407,400	412,500	417,600	422,600	427,600												102
104	386,300	391,700	397,200	402,600	407,900	413,100	418,300	423,500	428,500	433,500	438,500												104
105	398,100	403,700	409,300	414,900	420,300	425,700	431,100	436,300	441,600	446,700	451,800												105
106	402,200	407,900	413,500	419,100	424,600	430,000	435,400	440,700	445,900	451,100	456,200												106
107	425,900	431,900	437,800	443,700	449,500	455,200	460,900	466,400	471,900	477,400	482,800												107
108	435,600	441,600	447,600	453,500	459,400	465,200	470,800	476,400	482,000	487,400	492,900												108
109	447,400	453,600	459,800	465,800	471,800	477,700	483,600	489,300	495,000	500,600	506,100												109
110	457,200	463,400	469,600	475,700	481,800	487,700	493,500	499,300	505,000	510,600	516,200												110
111	469,000	475,400	481,700	488,000	494,200	500,300	506,300	512,200	518,000	523,800	529,500												111
112	476,700	483,200	489,500	495,800	502,000	508,100	514,100	520,000	525,800	531,600	537,300												112
113	502,400	509,200	515,900	522,500	529,000	535,400	541,700	548,000	554,100	560,200	566,200												113
114	512,100	518,900	525,700	532,400	538,900	545,400	551,700	558,000	564,100	570,200	576,200												114
115	523,900	530,900	537,800	544,700	551,400	558,000	564,500	570,900	577,200	583,400	589,500												115
116	531,700	538,700	545,600	552,400	559,200	565,800	572,300	578,600	584,900	591,100	597,300												116
117	545,500	552,700	559,800	566,800	573,700	580,500	587,200	593,700	600,200	606,600													117
118	565,000	572,300	579,600	586,800	593,800	600,700	607,500																118
119	586,500	594,100	601,600	608,900																			119
120	606,000																						120

HEADWATER 598 to 602  
TAILWATER 589.51 to 590.50

MARCH, 2004

GUNTERSVILLE DAM  
**SPILLWAY DISCHARGE**  
 IN CUBIC FEET PER SECOND

GATE ARRANGE- MENT	HEADWATER ELEVATION																			GATE ARRANGE- MENT			
	592.0	592.2	592.4	592.6	592.8	593.0	593.2	593.4	593.6	593.8	594.0	594.2	594.4	594.6	594.8	595.0	595.2	595.4	595.6		595.8	596.0	
90																						90	
91																							91
92																							92
93																							93
94																							94
95																							95
96																							96
97																							97
98																							98
99																							99
100																							100
101																							101
102																							102
103																							103
104																							104
105																							105
106																							106
107																							107
108																							108
109																							109
110																							110
111																							111
112																							112
113																							113
114																							114
115																							115
116																							116
117																							117
118																							118
119																							119
120																							120

# GUNTERSVILLE DAM SPILLWAY DISCHARGE IN CUBIC FEET PER SECOND

GAGE ELEVATION	HEADWATER ELEVATION																				GAGE ELEVATION		
	596.0	596.2	596.4	596.6	596.8	597.0	597.2	597.4	597.6	597.8	598.0	598.2	598.4	598.6	598.8	599.0	599.2	599.4	599.6	599.8		600.0	
74																						74	

HEADWATER 596 to 600  
TAILWATER 590.51 to 591.50

MARCH 2004

GUNTERSVILLE DAM  
**SPILLWAY DISCHARGE**  
 IN CUBIC FEET PER SECOND

CFS RANGE FEET	HEADWATER ELEVATION																			CFS RANGE FEET		
	592.0	592.2	592.4	592.6	592.8	593.0	593.2	593.4	593.6	593.8	594.0	594.2	594.4	594.6	594.8	595.0	595.2	595.4	595.6		595.8	596.0
95																					238,500	95
96																					247,400	96
98																		238,200	244,400	250,600	256,800	98
99																	239,800	246,300	252,800	259,200	265,700	99
101																242,200	248,900	255,500	262,000	268,500	275,100	101
102																						102
104																						104
105																						105
106																						106
107																						107
108																						108
109																						109
110																						110
111																						111
112																						112
113																						113
114																						114
115																						115
116																						116
117																						117
118																						118
119																						119
120																						120

# GUNTERSVILLE DAM SPILLWAY DISCHARGE IN CUBIC FEET PER SECOND

STAGE ELEVATION FEET	HEADWATER ELEVATION																			STAGE ELEVATION FEET				
	596.0	596.2	596.4	596.6	596.8	597.0	597.2	597.4	597.6	597.8	598.0	598.2	598.4	598.6	598.8	599.0	599.2	599.4	599.6		599.8	600.0		
79																					239,600	79		
80																					247,100	80		
83																					252,000	83		
84																					256,300	84		
86												238,400	242,600	238,100	242,400	246,700	251,000	255,400	259,700	264,300	268,800	273,300	277,800	86
87																							87	
89																							89	
90																							90	
92																							92	
93																							93	
95	238,500	244,500	250,600	256,600	262,500	268,200	273,800	279,200	284,300	289,300	294,200	299,000	303,800	308,700	313,600	318,500	323,600	328,600	333,800	338,900	344,100	349,300	95	
96	247,400	253,600	259,900	266,100	272,200	278,100	283,900	289,400	294,800	299,900	305,000	309,900	314,900	319,900	324,900	330,100	335,300	340,500	345,800	351,000	356,400	361,800	96	
98	256,800	263,100	269,600	275,900	282,200	288,300	294,200	299,900	305,300	310,500	315,500	320,500	325,500	330,500	335,600	340,800	346,000	351,300	356,600	362,000	367,400	372,800	98	
99	265,700	272,200	278,900	285,400	291,900	298,200	304,300	310,100	315,700	321,000	326,300	331,400	336,600	341,800	347,000	352,300	357,700	363,200	368,600	374,100	379,700	385,300	99	
101	275,100	281,700	288,500	295,300	301,900	308,400	314,600	320,500	326,200	331,600	336,900	342,000	347,200	352,400	357,700	363,100	368,500	374,000	379,500	385,100	390,700	396,300	101	
102	283,900	290,800	297,800	304,800	311,600	318,200	324,700	330,800	336,600	342,200	347,600	352,900	358,300	363,600	369,100	374,600	380,200	385,800	391,500	397,200	403,000	408,800	102	
104	293,300	300,300	307,500	314,600	321,600	328,400	335,000	341,200	347,100	352,700	358,200	363,500	368,900	374,300	379,800	385,300	391,000	396,700	402,400	408,200	414,000	420,000	104	
105	302,200	309,400	316,800	324,100	331,300	338,300	345,100	351,500	357,500	363,300	368,900	374,500	380,000	385,500	391,100	396,900	402,700	408,500	414,400	420,300	426,300	432,300	105	
106	306,600	313,900	321,200	328,600	335,900	343,000	349,800	356,300	362,400	368,200	373,800	379,300	384,800	390,400	396,100	401,800	407,700	413,600	419,600	425,600	431,600	437,700	106	
107	324,300	332,000	339,800	347,600	355,300	362,800	370,000	376,800	383,200	389,400	395,300	401,200	407,000	412,900	418,800	424,900	431,100	437,300	443,600	449,900	456,200	462,600	107	
108	332,800	340,600	348,600	356,500	364,300	372,000	379,300	386,200	392,700	398,900	404,900	410,800	416,600	422,500	428,600	434,700	440,900	447,200	453,500	459,900	466,300	472,800	108	
109	341,700	349,700	357,900	366,000	374,000	381,900	389,400	396,400	403,100	409,500	415,700	421,700	427,700	433,800	439,900	446,200	452,600	459,000	465,500	472,000	478,600	485,300	109	
110	350,200	358,300	366,600	374,900	383,100	391,100	398,700	405,900	412,600	419,100	425,300	431,300	437,400	443,500	449,700	456,000	462,400	468,800	475,500	482,100	488,700	495,500	110	
111	359,000	367,400	375,900	384,400	392,800	400,900	408,800	416,100	423,100	429,600	436,000	442,200	448,400	454,700	461,100	467,600	474,100	480,800	487,500	494,200	501,000	507,900	111	
112	366,100	374,500	383,100	391,700	400,300	408,500	416,400	423,900	430,800	437,400	443,800	450,000	456,200	462,500	468,900	475,400	482,000	488,600	495,400	502,100	508,900	515,800	112	
113	385,200	394,200	403,200	412,300	421,200	429,900	438,200	446,100	453,400	460,400	467,100	473,700	480,200	486,800	493,600	500,400	507,400	514,400	521,400	528,500	535,700	543,000	113	
114	393,700	402,800	412,000	421,000	430,300	439,100	447,600	455,500	462,900	469,900	476,700	483,300	489,900	496,500	503,300	510,200	517,200	524,300	531,400	538,600	545,800	553,200	114	
115	402,600	411,800	421,300	430,700	440,000	449,000	457,600	465,700	473,300	480,500	487,400	494,200	500,900	507,700	514,700	521,700	528,900	536,100	543,400	550,700	558,100	565,600	115	
116	409,700	419,000	428,500	438,000	447,400	456,600	465,300	473,500	481,100	488,300	495,200	502,000	508,700	515,500	522,500	529,500	536,700	544,000	551,300	558,600	566,000	573,500	116	
117	419,900	429,500	439,300	449,100	458,700	468,100	477,000	485,400	493,300	500,700	507,800	514,700	521,700	528,700	535,800	543,100	550,400	557,900	565,400	572,900	580,500	588,200	117	
118	435,900	445,700	455,800	465,900	475,900	485,500	494,700	503,300	511,400	519,000	526,200	533,300	540,400	547,500	554,800	562,200	569,800	577,400	585,000	592,800	600,500	608,300	118	
119	453,200	463,400	473,800	484,300	494,600	504,600	514,100	523,000	531,300	539,100	546,600	553,900	561,100	568,400	575,900	583,600	591,300	599,100	607,000				119	
120	469,100	479,600	490,400	501,100	511,700	522,000	531,800	541,000	549,400	557,400	565,000	572,500	579,900	587,300	595,000	602,800							120	

HEADWATER 596 to 600  
TAILWATER 591.51 to 592.50

MARCH 2004

GUNTERSVILLE DAM  
**SPILLWAY DISCHARGE**  
 IN CUBIC FEET PER SECOND

SPILLWAY DISCHARGE FEET PER SECOND	HEADWATER ELEVATION																		SPILLWAY DISCHARGE FEET PER SECOND					
	592.0	592.2	592.4	592.6	592.8	593.0	593.2	593.4	593.6	593.8	594.0	594.2	594.4	594.6	594.8	595.0	595.2	595.4		595.6	595.8	596.0		
101																						251,500	101	
102																						259,500	102	
104																						268,300	104	
105																						276,400	105	
106																		251,500	252,600	260,200	268,500	276,400	280,800	106
107																								107
108																								108
109																								109
110																								110
111																								111
112																								112
113																								113
114																								114
115																								115
116																								116
117																								117
118																								118
119																								119
120																								120

MARCH 2004

HEADWATER 592 to 596  
 TAILWATER 592.51 to 593.50



**GUNTERSVILLE DAM  
SPILLWAY DISCHARGE  
IN CUBIC FEET PER SECOND**

TAILWATER ELEVATION	HEADWATER ELEVATION																				TAILWATER ELEVATION			
	596.0	596.2	596.4	596.6	596.8	597.0	597.2	597.4	597.6	597.8	598.0	598.2	598.4	598.6	598.8	599.0	599.2	599.4	599.6	599.8		600.0		
84																					253,400	257,700	84	
86																					262,400	266,800	86	
87																					274,000	278,600	87	
89																					283,000	287,700	89	
90											255,500	260,700		255,100	259,900	264,600	269,300	273,800	278,400	283,000	289,900	294,600	299,400	90
92																					303,700	308,500	92	
93										252,800	258,400	264,000	269,300	274,500	279,500	284,400	289,300	294,100	298,900	303,700	310,300	315,200	320,200	93
95										262,700	268,500	274,300	279,800	285,100	290,300	295,400	300,400	305,300	310,300	315,200	320,200	325,200	330,200	95
96										272,800	278,800	284,700	290,400	295,800	301,100	306,200	311,200	316,200	321,100	326,100	331,200	336,100	341,100	96
98				254,000	260,300	266,700	273,100	279,600	286,300	292,800	299,200	305,400	311,400	317,100	322,600	327,900	333,100	338,300	343,400	348,600	353,800	359,000	364,200	98
99			256,100	262,700	269,300	275,800	282,500	289,200	296,100	302,800	309,300	315,700	321,900	327,800	333,400	338,900	344,300	349,600	354,800	360,200	365,500	370,800	376,100	99
101	251,500	258,400	265,200	272,000	278,600	285,300	292,100	298,900	306,000	312,800	319,600	326,200	332,500	338,400	344,200	349,700	355,100	360,400	365,700	371,000	376,500	381,800	387,100	101
102	259,500	266,700	273,700	280,700	287,500	294,400	301,400	308,500	315,700	322,800	329,700	336,400	342,900	349,100	355,000	360,700	366,200	371,700	377,100	382,600	388,200	393,800	399,400	102
104	268,300	275,700	282,900	289,900	296,900	303,900	311,000	318,200	325,600	332,900	340,000	346,900	353,500	359,800	365,700	371,400	377,000	382,500	388,000	393,500	399,100	404,700	410,300	104
105	276,400	284,000	291,400	298,600	305,800	313,100	320,400	327,800	335,400	342,800	350,100	357,200	364,000	370,400	376,500	382,400	388,100	393,800	399,400	405,100	410,800	416,500	422,200	105
106	280,800	288,500	295,900	303,200	310,500	317,800	325,100	332,600	340,200	347,800	355,200	362,400	369,300	375,800	382,000	387,900	393,700	399,300	405,000	410,700	416,500	422,200	427,900	106
107	296,900	305,000	312,900	320,600	328,300	336,000	343,800	351,700	359,700	367,600	375,400	383,000	390,200	397,100	403,600	409,800	415,900	421,900	427,800	433,900	440,000	446,100	452,200	107
108	304,800	313,100	321,100	329,000	336,800	344,600	352,500	360,500	368,700	376,800	384,700	392,500	399,800	406,800	413,300	419,600	425,800	431,800	437,800	443,800	449,800	455,800	461,800	108
109	312,900	321,400	329,600	337,700	345,700	353,700	361,800	370,100	378,400	386,700	394,900	402,800	410,300	417,400	424,200	430,600	436,900	443,000	449,200	455,400	461,700	468,000	474,300	109
110	320,800	329,500	337,900	346,100	354,200	362,300	370,500	378,900	387,400	395,900	404,200	412,200	419,900	427,100	433,900	440,400	446,700	452,900	459,100	465,400	471,700	478,000	484,300	110
111	328,800	337,700	346,300	354,800	363,100	371,400	379,900	388,500	397,100	405,800	414,300	422,500	430,400	437,800	444,700	451,400	457,900	464,200	470,500	476,900	483,300	489,700	496,100	111
112	335,500	344,500	353,200	361,700	370,100	378,500	387,000	395,700	404,500	413,300	421,900	430,300	438,200	445,600	452,700	459,300	465,800	472,100	478,500	484,900	491,400	497,800	504,300	112
113	352,900	362,400	371,600	380,500	389,400	398,200	407,200	416,400	425,600	434,800	443,800	452,600	460,900	468,700	476,100	483,100	490,000	496,600	503,300	510,100	516,900	523,700	530,500	113
114	360,800	370,500	379,800	388,900	397,900	406,800	415,900	425,200	434,600	444,000	453,200	462,000	470,500	478,400	485,900	493,000	499,800	506,500	513,200	520,000	526,900	533,700	540,500	114
115	368,800	378,800	388,300	397,600	406,800	415,900	425,200	434,700	444,300	453,900	463,300	472,300	481,000	489,100	496,700	503,900	510,900	517,800	524,700	531,600	538,500	545,400	552,300	115
116	375,500	385,500	395,200	404,500	413,800	423,000	432,400	442,000	451,700	461,400	470,900	480,100	488,800	497,000	504,600	511,900	518,900	525,800	532,600	539,600	546,500	553,400	560,300	116
117	384,800	395,100	405,000	414,700	424,100	433,600	443,300	453,100	463,100	473,000	482,700	492,100	501,000	509,400	517,200	524,700	531,900	539,000	546,000	553,200	560,400	567,500	574,600	117
118	399,500	410,200	420,400	430,300	440,000	449,800	459,700	469,800	480,100	490,300	500,300	510,000	519,200	527,800	535,800	543,500	550,800	558,000	565,200	572,500	579,900	587,200	594,500	118
119	415,500	426,500	437,100	447,300	457,400	467,500	477,700	488,200	498,800	509,400	519,800	529,800	539,300	548,100	556,400	564,200	571,800	579,200	586,500	594,000	601,600	609,200	616,800	119
120	430,200	441,600	452,400	463,000	473,300	483,700	494,200	504,900	515,800	526,700	537,400	547,700	557,500	566,500	575,000	583,000	590,700	598,200	605,700	613,400	621,100	628,800	636,500	120

HEADWATER 596 to 600  
TAILWATER 592.51 to 593.50

MARCH 2004

GUNTERSVILLE DAM  
**SPILLWAY DISCHARGE**  
 IN CUBIC FEET PER SECOND

GATE ARRANGEMENT	HEADWATER ELEVATION																		GATE ARRANGEMENT							
	592.0	592.2	592.4	592.6	592.8	593.0	593.2	593.4	593.6	593.8	594.0	594.2	594.4	594.6	594.8	595.0	595.2	595.4		595.6	595.8	596.0				
109																						272,500	109			
110																					266,800	279,400	110			
111																					273,500	286,400	111			
112																					279,100	292,100	112			
113																			278,400	293,500	307,300	113				
114																					267,300	284,800	300,200	314,100	114	
115																					273,200	291,100	306,900	321,200	115	
116																					278,400	296,500	312,500	326,900	116	
117																					285,200	303,800	320,200	335,000	117	
118																	274,100	296,300	315,600	332,500	347,800	118				
119																					285,100	308,300	328,300	345,800	361,600	119
120																267,500	295,300	319,300	340,100	358,100	374,400	120				

MARCH 2004

HEADWATER 592 to 596  
 TAILWATER 593.51 to 594.50

# GUNTERSVILLE DAM SPILLWAY DISCHARGE IN CUBIC FEET PER SECOND

GATE ARRANGE- MENT	HEADWATER ELEVATION																			GATE ARRANGE- MENT		
	596.0	596.2	596.4	596.6	596.8	597.0	597.2	597.4	597.6	597.8	598.0	598.2	598.4	598.6	598.8	599.0	599.2	599.4	599.6		599.8	600.0
87																					266,800	87
89																					276,000	89
92																	265,900	271,500	266,000	271,100	287,100	90
93														266,700	273,000	268,800	274,600	280,300	285,800	291,100	296,300	92
95																279,100	285,100	290,900	296,600	302,100	307,400	93
96																						95
98																						96
99																						98
101																						99
102																						101
104																						102
105																						104
106																						105
107																						106
108																						107
109																						108
110																						109
111																						110
112																						111
113																						112
114																						113
115																						114
116																						115
117																						116
118																						117
119																						118
120																						119
																						120

HEADWATER 596 to 600  
TAILWATER 593.51 to 594.50

MARCH 2004

GUNTERSVILLE DAM  
**SPILLWAY DISCHARGE**  
 IN CUBIC FEET PER SECOND

GATE ARRANGE- MENT	HEADWATER ELEVATION																			GATE ARRANGE- MENT			
	596.0	596.2	596.4	596.6	596.8	597.0	597.2	597.4	597.6	597.8	598.0	598.2	598.4	598.6	598.8	599.0	599.2	599.4	599.6		599.8	600.0	
93																							93
95																							95
96																							96
98																							98
99																							99
101																							101
102																							102
104																							104
105																							105
106																							106
107																							107
108																							108
109																							109
110																							110
111																							111
112																							112
113																							113
114																							114
115																							115
116																							116
117																							117
118																							118
119																							119
120																							120

MARCH 2004

HEADWATER 596 to 600  
 TAILWATER 594.51 to 595.50

## GUNTERSVILLE DAM GATE 18 TRASH DISCHARGE IN CUBIC FEET PER SECOND

ONE SECTION REMOVED


HEADWATER ELEVATION	0.0	0.2	0.4	0.6	0.8
590	220	270	330	380	440
591	500	570	640	710	780
592	850	930	1,010	1,090	1,170
593	1,260	1,340	1,430	1,520	1,620
594	1,710	1,810	1,910	2,010	2,110
595*	2,210	2,310	2,420	2,520	2,610
596*	2,690	2,770	2,850	2,920	2,990
597*	3,060	3,130	3,190	3,250	3,320
598*	3,380	3,440	3,500	3,550	3,610
599*	3,660	3,720	3,770	3,830	3,880
600*	3,930				

THREE SECTIONS REMOVED

HEADWATER ELEVATION	0.0	0.2	0.4	0.6	0.8
590	7,970	8,130	8,300	8,460	8,620
591	8,790	8,960	9,120	9,290	9,460
592	9,630	9,800	9,980	10,150	10,320
593	10,490	10,670	10,840	11,010	11,190
594	11,360	11,540	11,720	11,900	12,070
595*	12,250	12,430	12,620	12,790	12,950
596*	13,110	13,260	13,400	13,550	13,690
597*	13,830	13,960	14,090	14,220	14,350
598*	14,480	14,600	14,730	14,850	14,970
599*	15,090	15,210	15,330	15,450	15,570
600*	15,680				

TWO SECTIONS REMOVED

HEADWATER ELEVATION	0.0	0.2	0.4	0.6	0.8
590	3,210	3,330	3,450	3,570	3,700
591	3,820	3,950	4,070	4,200	4,330
592	4,460	4,590	4,730	4,860	5,000
593	5,130	5,270	5,410	5,550	5,690
594	5,840	5,980	6,130	6,270	6,420
595*	6,570	6,720	6,870	7,010	7,150
596*	7,270	7,390	7,510	7,630	7,740
597*	7,850	7,960	8,060	8,170	8,270
598*	8,370	8,470	8,570	8,660	8,760
599*	8,850	8,940	9,040	9,130	9,210
600*	9,300				

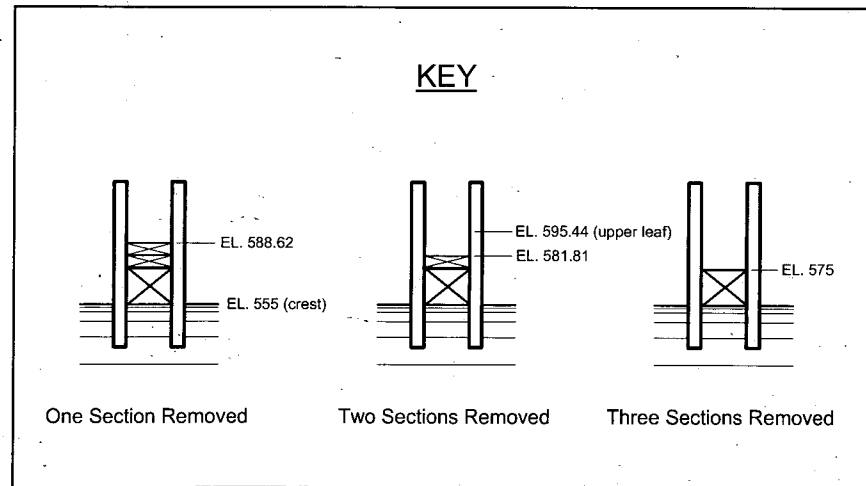

MARCH 2004

*\*Trash gate discharge does not include portion that would overflow closed gate (top elevation 595.44) because this discharge is already included in the spillway tables.*

AMERICAN SOCIETY OF CIVIL ENGINEERS

Founded November 5, 1852

TRANSACTIONS

Paper No. 2855

DISCHARGE COEFFICIENTS FOR SPILLWAYS  
AT TVA DAMS

BY KENNETH W. KIRKPATRICK,<sup>1</sup> A. M. ASCE

SYNOPSIS

Spillway ratings derived from model studies have been used in the preparation of spillway rating tables for the Tennessee Valley Authority dams. As a result of these studies, discharge coefficients for eleven of the Tennessee Valley Authority dams are given in this paper. Coefficients for both submerged and free discharge conditions are presented for discharges over standard spillway crests, irregular spillway crests, and a vertical-lift spillway gate. Discharge coefficients for Tainter gates placed on curved spillway crests are also given for various gate openings under free discharge conditions. In addition, data on the effect of model scale on the discharge coefficient and the effect of closing adjacent spillway bays and gates are presented. The coefficient relationships are shown in a form that may be used by designers as a guide in making determinations of the discharges for future spillways.

NOTATION

The letter symbols adopted for use in this paper are defined where they first appear, in the illustrations or in the text, and are arranged alphabetically, for convenience of reference, in the Appendix.

INTRODUCTION

The Tennessee Valley Authority (TVA) operates a system of nine dams on the Tennessee River and twenty-three on the tributary rivers. The successful operation of such a system requires accurate discharge ratings for each structure. Although enough water is seldom available to make complete ratings for most spillways from measurements conducted on the prototype structure, ratings can be determined from scale model tests. Therefore, the necessary ratings for the TVA spillways have been determined by this means. Model studies have been made at the TVA Hydraulic Laboratory at Norris, Tenn.,

<sup>1</sup>NOTE.—Published, essentially as printed here, in February, 1955, as *Proceedings-Separate No. 626*. Positions and titles given are those in effect when the paper was approved for publication in *Transactions*.  
<sup>1</sup> Hydr. Engr., Hydr. Lab., Tennessee Valley Authority, Norris, Tenn.

on nine different spillway crest shapes equipped with three types of control gates...

Seven of the nine crests were curved sections which approximated the shape of the lower nappe of a sharp-crested weir. The other two crests were flat. The two flat-crested weirs and one of the curved crests were equipped with double-leaf vertical lift gates. Five of the curved crests were equipped with Tainter gates and the other with vertical lift gates.

*Data Presented.*—Data are presented for the following conditions: (1) Free, ungated flow through a series of spillway bays; (2) submerged, ungated flow through a series of spillway bays; (3) free, ungated flow through a series of spillway bays, with adjacent bays fully open or closed; (4) free flow over a vertical lift gate; (5) submerged flow over a vertical lift gate; (6) flow under a series of Tainter gates set with equal openings; and (7) flow under a series of Tainter gates with adjacent gates closed.

Data are also presented to show the effect of model scale for the condition of free, ungated flow through a series of spillway bays.

*General Model Arrangement.*—The models were tested in flumes either 3.5 ft wide or 8 ft wide. Models installed in the smaller flume usually consisted of a reproduction of three of the prototype spillway bays. In the larger flume five or six spillway bays were reproduced. Each of these flumes was provided with glass panels for observation purposes. The models placed in the larger flume were constructed at scale ratios of from 1:28.72 to 1:50 with a ratio of approximately 1:35 generally used. Those tested in the smaller flume were built at scale ratios of 1:50, 1:100, and 1:200.

The models were usually provided with concrete crests and concrete piers to insure dimensional stability. Half piers were constructed on the ends of each model. If the model did not completely fill the flume one side was placed against the glass side of the flume and the other against a false wall. The river bed upstream and downstream from the model was reproduced at the elevation of the prototype river bed. Suitable baffling was provided to obtain a uniform distribution of flow in the spillway approach channel. The tailwater level was controlled at the end of the flumes by means of slat gates. Model discharges were determined from readings of a carefully calibrated diaphragm orifice located in the water supply line.

Headwater heights were measured at two piezometers at distances equal to approximately 5 and 8 times the design head upstream from the spillway crest. Tailwater heights were obtained at 2 piezometers at distances equal to approximately 9 and 12 times the design head downstream from the spillway crest—in all cases, sufficiently far enough downstream to eliminate the effect of the spillway apron.

In most studies the headwater and tailwater levels were determined by means of hook gages reading to 0.001 ft. For the 1/200-scale model the heads were measured with a micrometer point gage reading to 0.0001 ft.

*Discharge Equations.*—The model data have been reduced by the use of two commonly accepted discharge equations. For both free and submerged flow over a spillway crest the equation,

$$Q = C L H^{3/2} \dots \dots \dots (1)$$

was used, in which  $Q$  is the discharge in cubic feet per second,  $C$  is the coefficient of discharge determined from the model tests,  $L$  is the length of the crest, and  $H$  is the total head as shown in Fig. 1(a). Use was made of the same equation in the reduction of the data for free and submerged flows over a vertical gate with  $D$ ,  $H$ ,  $d$ , and  $P$  (Fig. 1(a)) being measured from the top of the gate.

For flow under a gate the equation for a rectangular orifice under low head,

$$Q = C L [H^{3/2} - (D_1 + h)^{3/2}] \dots (2)$$

was used, in which  $D_1$  is the depth of water to the bottom of the gate as defined in Fig. 1(b) and  $h$  is the approach velocity head.

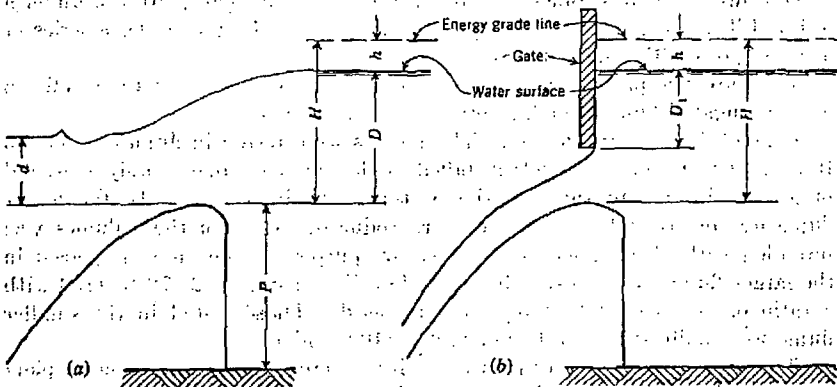


FIG. 1.—SPILLWAY-CREST DIAGRAM

FREE-DISCHARGE COEFFICIENTS, FLOW OVER SPILLWAY CRESTS

It is common practice for engineers to design spillway crests to approximate closely the shape of the lower portion of a jet issuing from a sharp-crested weir, and this type of crest is designated a standard crest.<sup>2</sup> Because the shape of the jet changes with the head on the weir, some particular head must be used for each design. This head for which a particular crest is designed is termed the design head. At this head, pressures approximating atmospheric pressure are developed at the spillway surface. At smaller heads, pressures are greater than atmospheric. Seven of the nine TVA crests for which data are available approximate standard crests in shape whereas the other two crests, which are flat, do not. Fig. 2 shows the basic details and dimensions of each of these crests. Fig. 3 presents the coefficient data obtained on the crests of Fig. 2. Pertinent design data concerning each crest, together with the scale to which each was modeled, appear in Table 1. Eleven spillways are also listed in Table 1. Two pairs of these, the Ocoee No. 3-Apalachia set, and the Douglas-Watts Bar set, both in Tennessee, have crest shapes that are identical within the pair but which were tested for different values of the approach depth,  $P$ .

<sup>2</sup>"Hydroelectric Handbook," by W. P. Creager and J. D. Justin, John Wiley & Sons, Inc., New York, N. Y., 2d Ed., 1950.

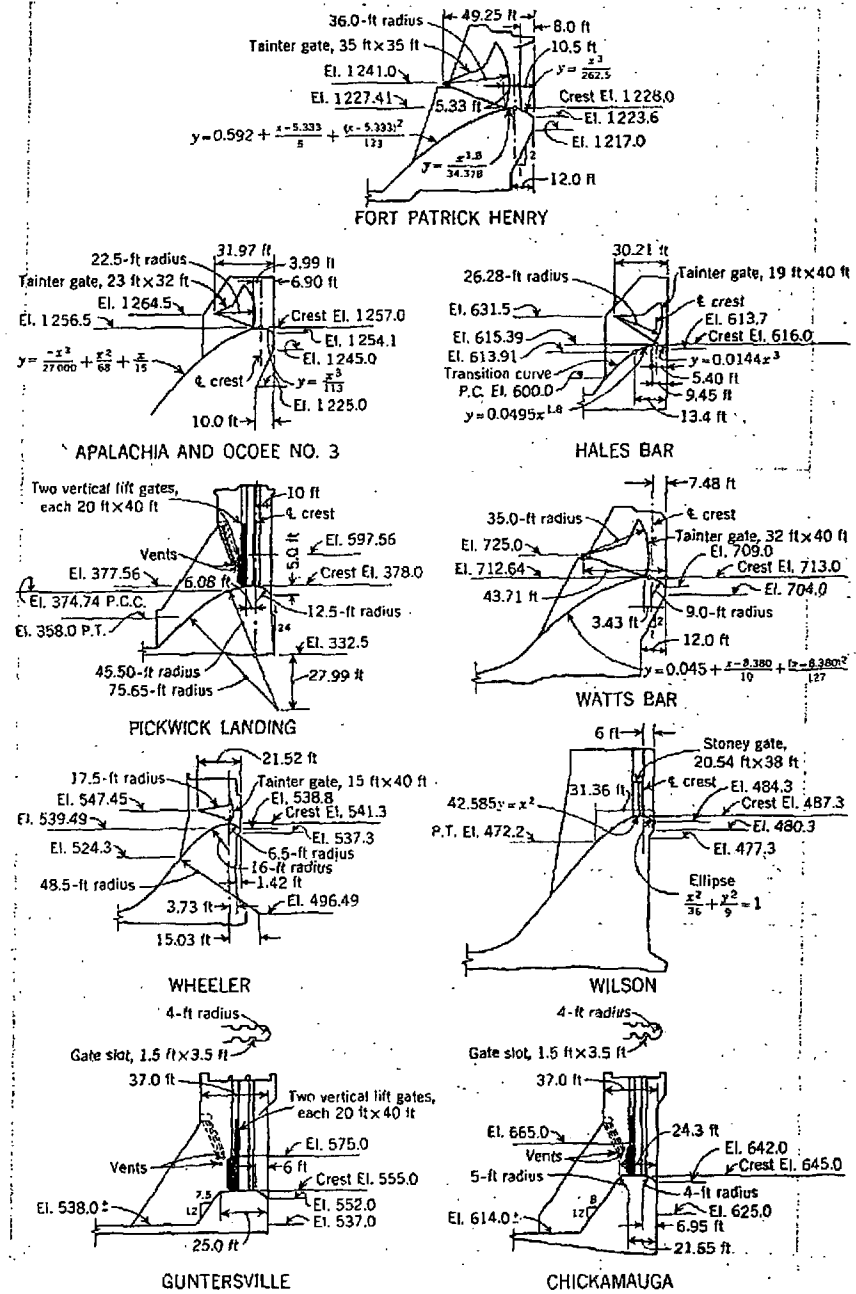


FIG. 2.—TVA SPILLWAY CRESTS (DATA IN FIG. 3)

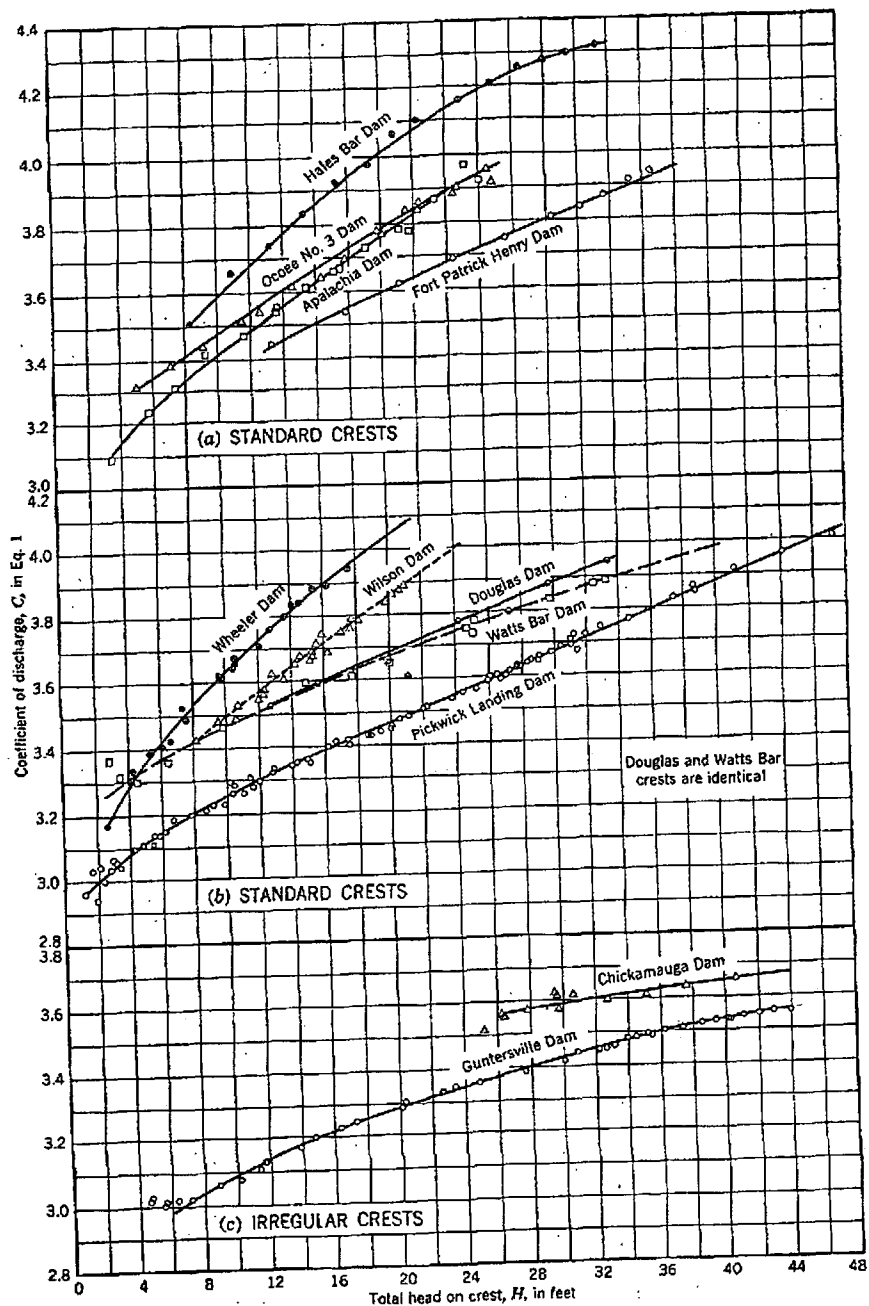


FIG. 3.—DISCHARGE COEFFICIENTS FOR FREE FLOW OVER THE SPILLWAY CRESTS OF FIG. 2

The accuracy of the data is evidenced by the plotting of the data points in Fig. 3. Except in some cases at low heads, the deviation of any plotted point from the coefficient curve does not exceed 0.5%.

**Standard Crests.**—It has been shown by various authors that the discharge coefficients for all standard crests can be related to each other and that, conversely, the coefficients to be used for a new design can be taken from previous test data.<sup>2,3,4,5</sup> Unfortunately, in most crest designs, due to other design considerations, it is necessary that the shape be varied from the standard form. Nevertheless, satisfactory coefficients can be obtained as sufficient data are now available on a range of crest shapes. By comparison of crest shapes designers may select a coefficient for any particular crest.

Dimensionless plotting provides a means for comparison of crest shapes. This method is used in Fig. 4 on which seven TVA crests which closely approximate standard crests are shown by the solid lines, with the dashed line representing a standard crest shape.<sup>2</sup> The horizontal coordinate,  $x$ , and the vertical coordinate,  $y$ , of the crest curve have been divided by the design head,  $H$ .

TABLE 1.—DESIGN DATA FOR ELEVEN MODELS OF TVA SPILLWAYS

Project	Model scale	Design head, $H_d$ , in feet	Upstream depth, $P$ , in feet	$H_d/P$	Pier nose radius, in feet
Hales Bar	1:34.76	18	32	0.56	3.00
Ocoee No. 3	1:28.72	23	67	0.35	3.00
Appalachia	1:28.72	23	97	0.24	3.00
Fort Patrick Henry	1:50	35	43	0.81	3.25
Wheeler	1:34.35	16.5	43	0.38	2.50
Wilson	1:39.4	19	75	0.25	4.00
Douglas	1:35	23.5	133	0.18	3.25
Watts Bar	1:35	23.5	52	0.45	3.25
Pickwick Landing	1:50	31.5	32	0.98	3.75
Chickamauga	1:50	20	20	1.00	4.00
Guntersville	1:50	18	18	1.00	4.00

The design head was determined by fitting the real and standard curves at the crest point ( $x = 0$ ) and at the intersection of the curve with the upstream vertical face. These design-head values are presented in Table 1. The design-head discharge coefficients ( $C_d$ ) determined from Fig. 3 are shown in Fig. 4.

The TVA crests all fairly closely approximate the standard curve from the upstream spillway face to a point somewhere downstream from the crest which was determined by the position of the gate seal. Below this latter point, the crest shape was modified to fit the trajectory of a jet issuing from under the gate when set at a small opening. The upstream face for a standard crest is vertical. The upstream face of the TVA crests, as shown in Fig. 4, deviates from the vertical. Other experimenters have established the fact that the shape of the upstream face generally has little influence on the discharge coefficient.<sup>3</sup>

<sup>2</sup> "Final Reports of Boulder Canyon Project," *Bulletin No. 8, Part VI, Hydraulic Investigations*, Bureau of Reclamation, U. S. Dept. of the Interior, Washington, D. C., 1947.

<sup>3</sup> "Engineering Hydraulics," edited by Hunter Rouse, John Wiley & Sons, Inc., New York, N. Y., 1950.

<sup>4</sup> "Discharge Coefficients for Irregular Overfall Spillways," by J. N. Bradley, *Engineering Monograph No. 9*, Bureau of Reclamation, U. S. Dept. of the Interior, Washington, D. C., 1952.



Fig. 4 indicates that the shape of the curve from the crest to a point somewhere in the neighborhood of  $x/H_0 = 0.5$  materially affects the coefficient. As the curve is raised above the standard curve, the coefficient is decreased. This can be seen by comparing the  $(y/H_0)$ -values at  $x/H_0 = 0.5$  with  $C_0$ . The comparative crests in Fig. 4 have been placed in the order of decreasing  $(Y/H_0)$ -values. No reasonable correlation of  $C_0$  with either upstream shape of  $H_0/P$  can be determined.

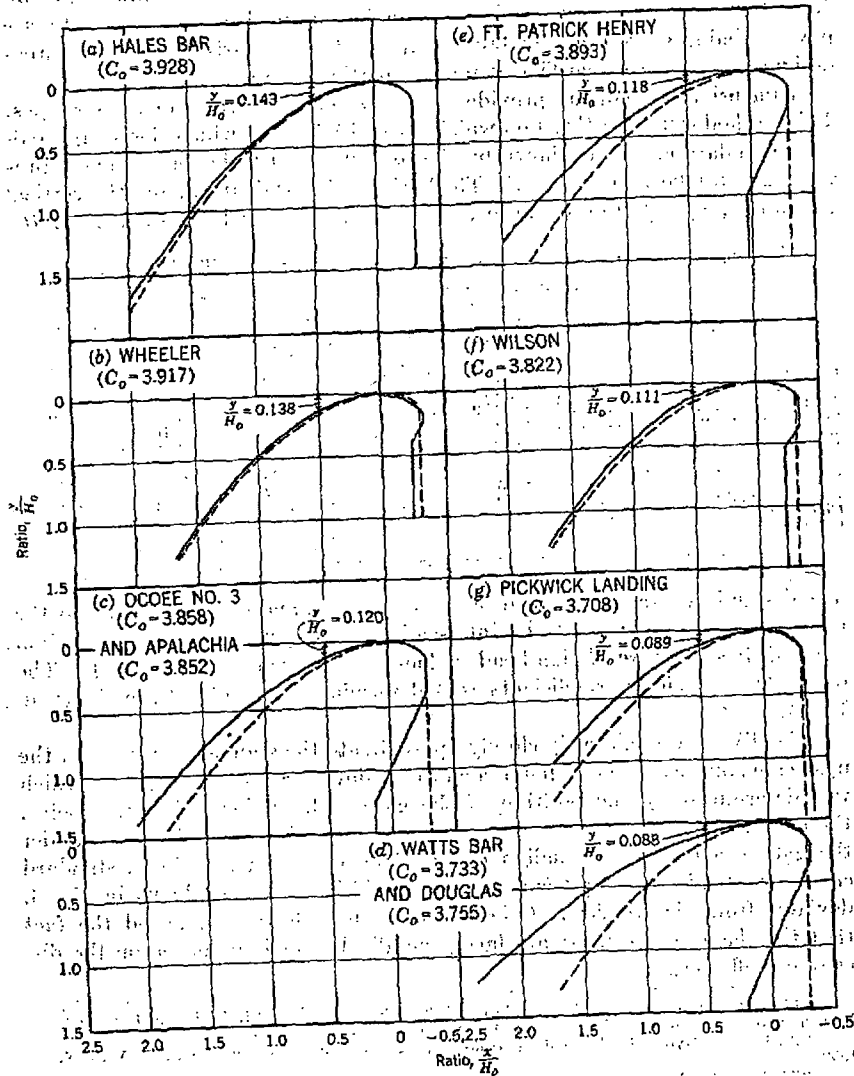


FIG. 4.—COMPARATIVE CRESTS ( $H_0/P$  SHOWN IN TABLE 1)

The relationships between the discharge coefficient and the ratio of any head to the design head,  $H/H_0$ , are shown in Fig. 5. In Fig. 5(a) the value of  $C$  is plotted against  $H/H_0$  for the four crests—Apalachia, Ocoee No. 3, Hales Bar (Tennessee), and Fort Patrick Henry (Tennessee)—that most closely follow the standard crest shape. The maximum variation of the individual points from

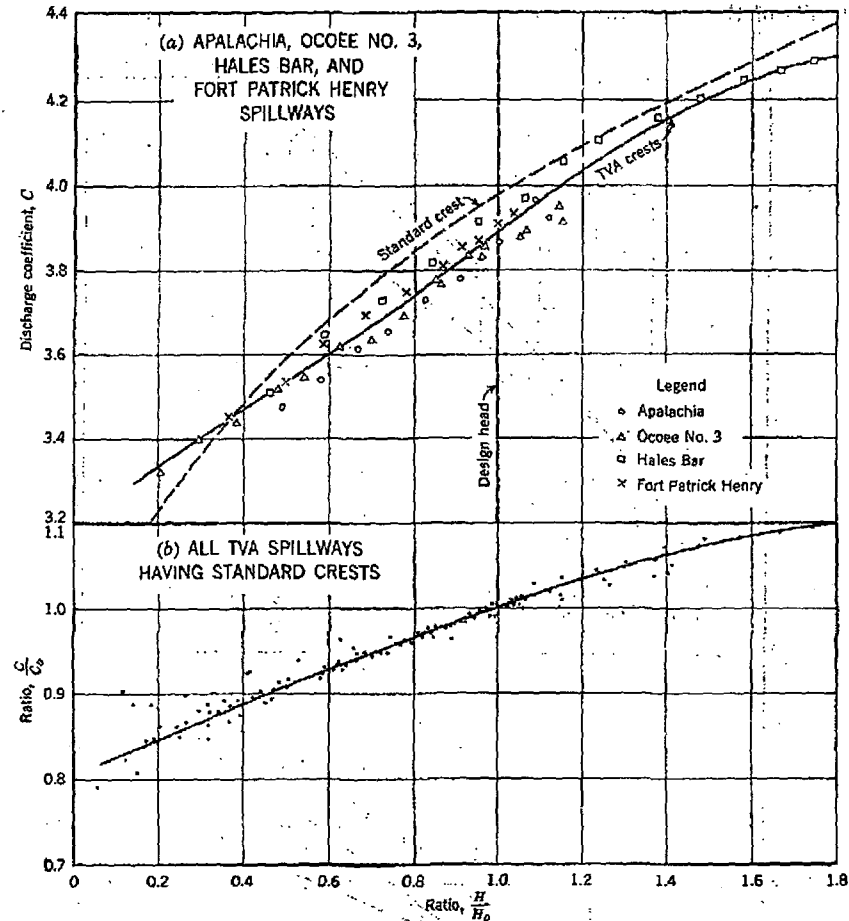


FIG. 5.—DISCHARGE COEFFICIENTS FOR SPILLWAYS HAVING STANDARD CRESTS

the average curve for TVA crests is 0.5%. The standard-crest curve shown by the dashed line in Fig. 5 is that of W. P. Creager and J. D. Justin.<sup>2</sup> This curve is approximately 2% higher than the TVA curve. Fig. 5(b) is a dimensionless plot of the data from Figs. 3(a) and 3(b). The deviation of the points from the average curve is greater than in Fig. 5(a) because all crests are included, but for design purposes the curve should be useful. Actually, the

curve is more firmly established than it may appear because the curve itself obliterates several test points.

**Irregular Spillway Crests.**—The designation "irregular spillway crests" is used to distinguish between standard spillway crests and other crest forms. Only two of the TVA spillways, those at Chickamauga, Tenn., and Guntersville, Ala., have irregular spillway crests. Both are trapezoidal in cross section. Details of these spillway crests and the discharge coefficients computed using

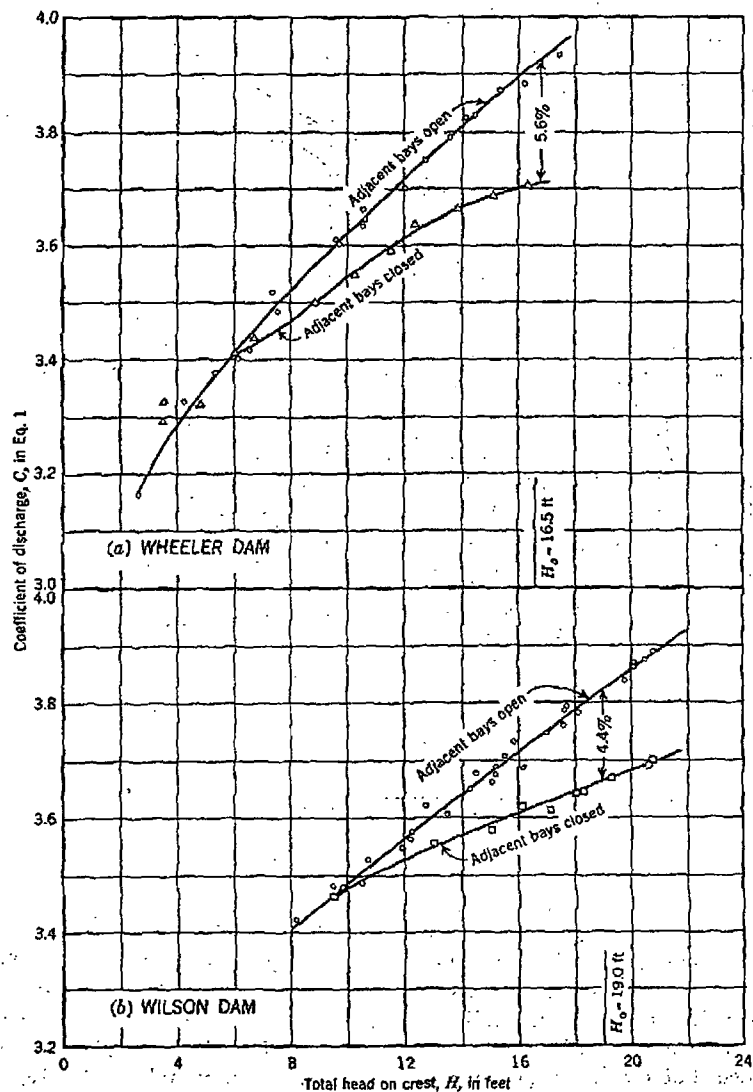


FIG. 6.—EFFECT OF OPERATION OF ADJACENT SPILLWAY BAYS

Eq. 1 from the model-study data are shown in Fig. 3(c). The two crests differ chiefly in the shape of the upstream and downstream edges of the crest and the height above the apron. Over the range of the tests of the Chickamauga spillway the coefficients are consistently from 3% to 5% greater than those for the Guntersville spillway. The additional height of the crest above the apron and the rounding of the near upstream edge of the Chickamauga crest would operate to increase the discharge coefficients.

**The Effect of Operating Adjacent Spillway Bays.**—In the TVA water-control operations, it is necessary to operate single spillway bays and groups of consecutive spillway bays. Because a greater contraction forms at a pier situated next to a closed bay, models of the Wilson and Wheeler spillways in Tennessee were tested with adjacent spillway bays open and closed to determine the difference in contraction effects at the piers.

Fig. 6 shows the head-coefficient relationships for the two conditions tested. The discharge coefficient at the design head was 5.6% higher at Wheeler Dam with adjacent bays opened and 4.4% higher at Wilson Dam than with these bays closed. These relationships show the importance of spillway pier contraction effects in spillway discharge determinations.

#### SUBMERGENCE DISCHARGE COEFFICIENTS FOR FLOW OVER SPILLWAY CRESTS

Chickamauga Dam, Guntersville Dam, Pickwick Landing Dam (Tennessee), and Watts Bar Dam are subject to submergence of the crest at periods of high discharge. To determine the effect of this submergence model tests were conducted by establishing a constant rate of discharge and varying the tailwater elevation to determine the relationship between the headwater and tailwater elevations. This procedure was repeated for several discharge rates covering the operating range at the dam.

Two flow conditions were observed in the model tests which are characterized as "plunging nappe" and "flowing nappe." In the condition of plunging nappe the discharge issuing from the spillway plunges down into the tailwater and appears to follow the boundary surface of the spillway.

In the condition of flowing nappe the flow is nearly horizontal, producing an undulating surface flow in the tailrace channel. The plunging nappe usually occurs with low submergence whereas the flowing nappe occurs with high submergence. When the headwater and tailwater head relationship at a constant rate of discharge was plotted for each series of tests, it was found that the change from plunging nappe to flowing nappe had no apparent effect on the discharge coefficient.

The results from these tests on the four spillways have been plotted in Fig. 7 in the dimensionless form,  $d/H$ , against  $C_s/C$ , in which  $d$  is the depth of submergence and  $H$  is the total head above the crest. The coefficient,  $C_s$ , was computed from Eq. 1 using the  $H$ -value for the submerged conditions;  $C$  was determined using the  $H$ -value for the free-flow condition.

No systematic variation of  $C_s/C$  could be determined for any variable except the  $(d/H)$ -ratio for any of the conditions tested. However, no relatively low discharges were tested because in practice the TVA installations can never be submerged at low discharges.

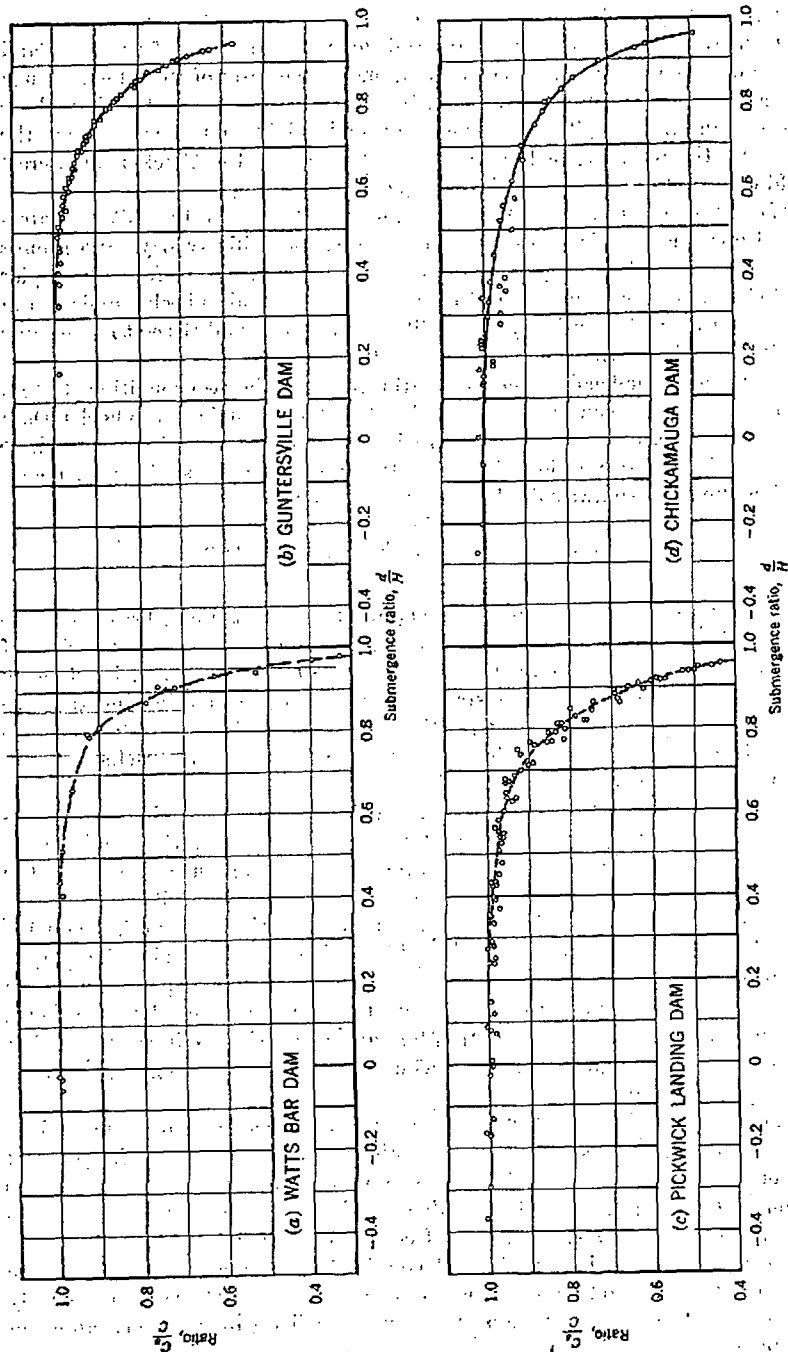


FIG. 7.—EFFECT OF SUBMERGENCE ON DISCHARGE COEFFICIENTS (C-VALUES FROM FIG. 3).

In Fig. 8 the four curves of Fig. 7 are shown on a single plot. Although the maximum spread between curves is about 10%, this is to be expected considering the wide range of crest shapes used in the tests.

#### FREE-DISCHARGE COEFFICIENTS FOR FLOW OVER VERTICAL LIFT GATES

The Pickwick Landing vertical lift gates are representative of this type of gate, which has been used on several TVA projects. In Fig. 9(a) are shown details of the lower spillway gate leaf. For heads greater than 2 ft, this gate is essentially a sharp-crested weir 40 ft long and 20 ft high with piers 7.5 ft thick at each end of the gate. Air intakes were installed in the sides of the piers just below the top of the gate to ventilate the underside of the nappe.\* Model tests were conducted with the 1/50-scale, 3-bay spillway model.


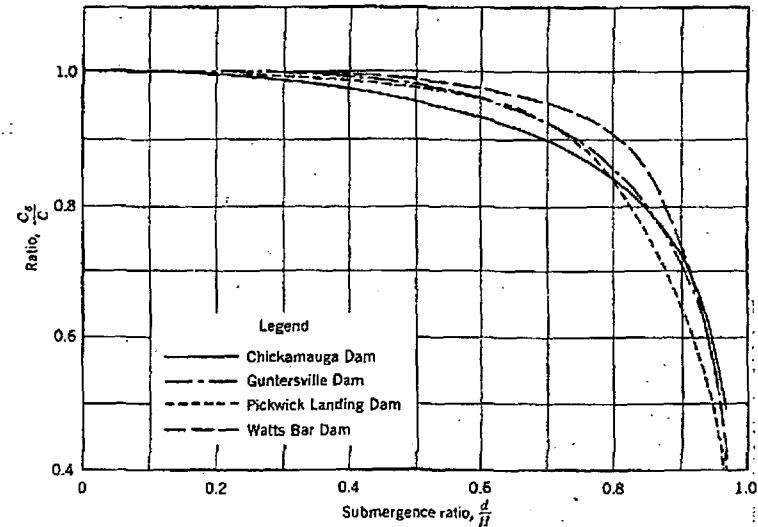


FIG. 8.—COMPARISON OF SUBMERGENCE EFFECTS FOR VARIOUS SPILLWAY CREST SHAPES

In Fig. 9(b) is shown the head-coefficient relationship for flow over the crest of the spillway gate. The coefficient,  $C$ , was computed from Eq. 1 using the top of the gate as crest elevation. The points define the head-coefficient relationship for heads between 3 ft and 28 ft. Each point was determined from the average of from 3 to 5 separate tests. A constant value of  $C$  equal to 3.428 is shown for heads in excess of 12 ft. For heads of from 12 ft to about 4 ft the model test curve shows a gradual rise in the coefficient, with an abrupt drop-off when the heads are approximately 4 ft and less. This curve takes the characteristic form for the coefficients of a sharp-crested weir, the rise and fall in the coefficient curve being due to the nappe clinging to the surface of the weir. This phenomenon is a function of the absolute head. Therefore, similarity between the model and prototype did not exist for prototype heads

\* "Aeration of Spillways," by G. H. Hickox, *Transactions, ASCE*, Vol. 109, p. 537.

of less than 12 ft. Because the gate has a 10-in.-wide flat top, at low heads the prototype can be expected to exhibit discharge characteristics similar to those of the model. However, for a head in excess of about 2 ft the prototype can be expected to act similarly to a sharp-crested weir and to have a flat coefficient curve.

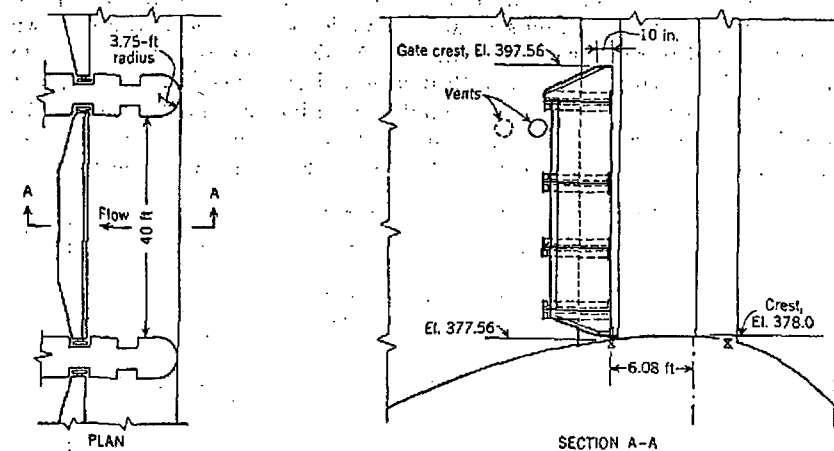

(a) GATE DESIGN

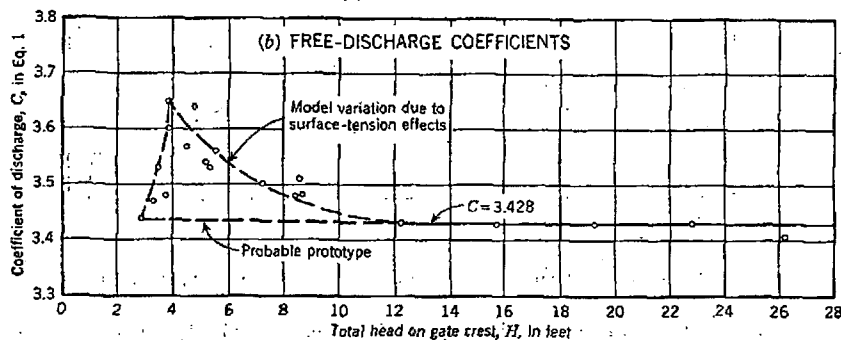


FIG. 9.—VERTICAL LIFT GATE, PICKWICK LANDING DAM

#### SUBMERGENCE DISCHARGE COEFFICIENTS FOR FLOW OVER A VERTICAL LIFT GATE

To obtain data on the effect of the submergence of flow over vertical-lift gates, model tests were conducted in a manner similar to that used in determining submergence effects on spillway crests. The coefficient,  $C_d$ , was computed from Eq. 1 in a manner similar to that used for the spillway crest data but using the top of gate as the crest elevation. Fig. 10 shows a plot of the headwater-tailwater relationships that have been determined. The data presented in Fig. 10 represent the rating of a three-bay, 1/50-scale model of the Pickwick Landing Dam. The total equivalent prototype crest width was

117.8 ft. The discharge was for three spillway bays. These curves illustrate the characteristic flow phenomena associated with this type of gate. Each constant-discharge curve begins with a horizontal line where the head-discharge relationship is not affected by the tailwater level. Just before the tailwater elevation reaches the gate crest level there is a drop in the headwater

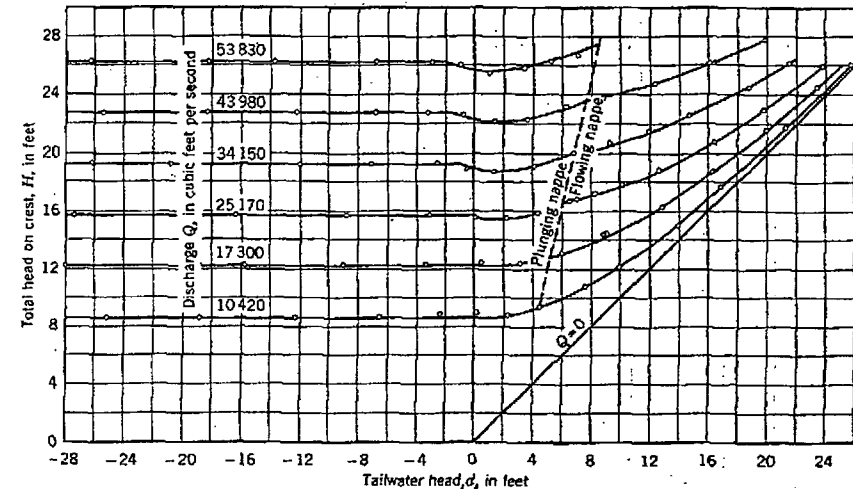
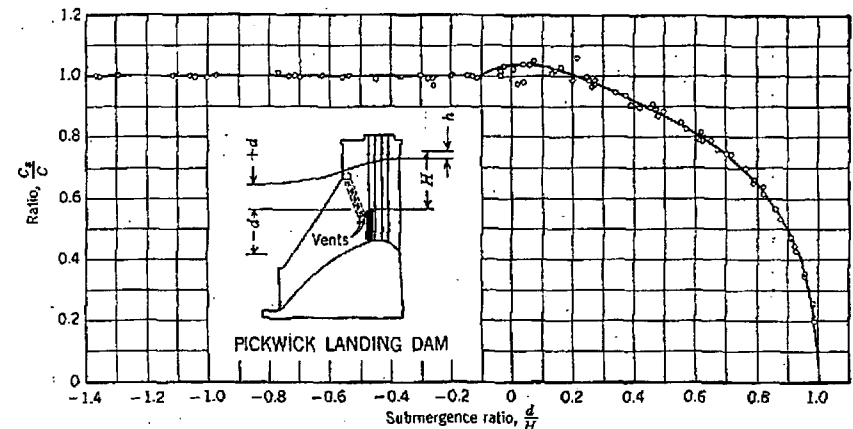


FIG. 10.—HEADWATER-TAILWATER RELATIONS FOR FLOW OVER A VERTICAL LIFT GATE (PROFILE SKETCH IN FIG. 11)

FIG. 11.—SUBMERGENCE EFFECT FOR FLOW OVER A VERTICAL LIFT SPILLWAY GATE ( $C_d = 2.428$ )

level for an increase in the tailwater level. Observations of the model operation showed that at this point the air vents, located in the sides of the piers just below the crest of the spillway gate, became submerged by the tailwater, reducing the contraction of the lower nappe issuing from the gate crest. The

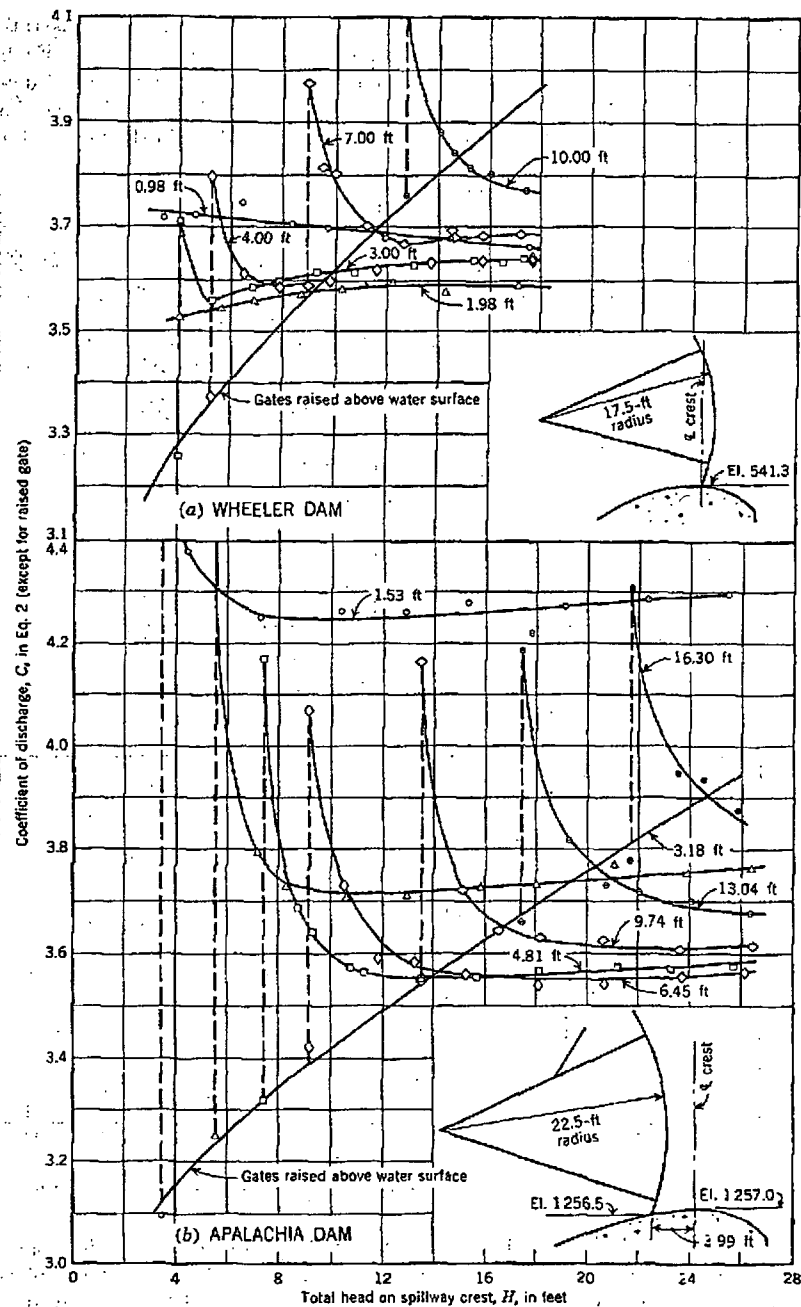


FIG. 12.—TAINTER-GATE SPILLWAY DISCHARGE COEFFICIENTS  
(DIMENSIONS ON CURVES ARE GATE OPENINGS)

discharge over the gate was thus increased with a consequent lowering of the headwater level.

The flow conditions of plunging nappe and flowing nappe, previously described, also occurred in this type of flow. In this case the change from one to the other is apparent in the data. The dashed line in Fig. 10 indicates the approximate location of the change. At these points the curves show a definite discontinuity in shape. The data of Fig. 10 can be reduced in coeffi-

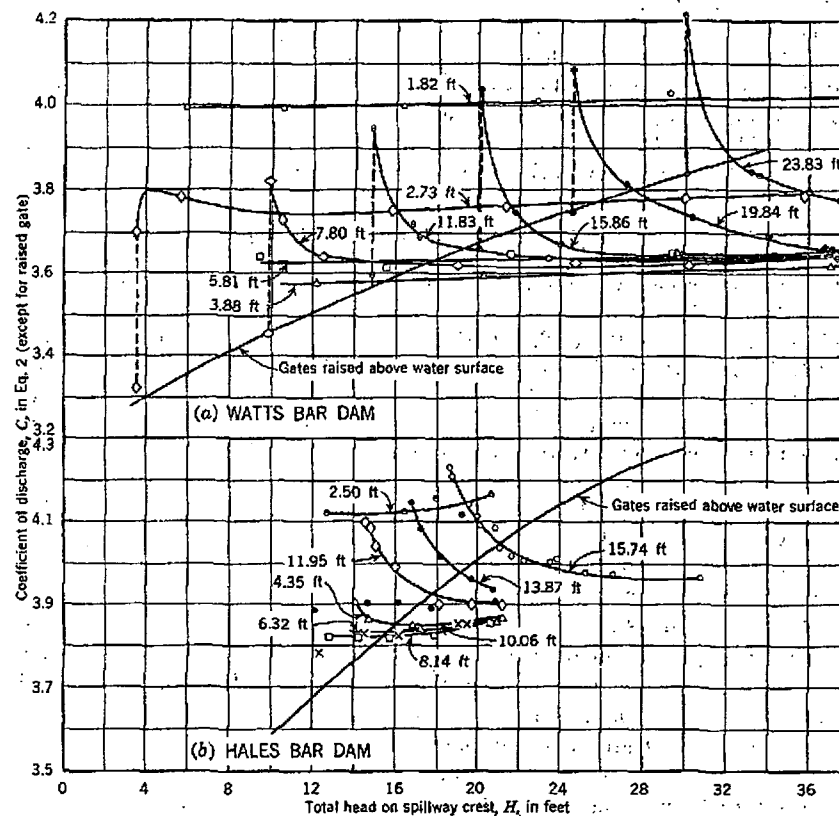


FIG. 13.—TAINTER-GATE SPILLWAY DISCHARGE COEFFICIENTS  
(DIMENSIONS ON CURVES ARE GATE OPENINGS)

cient form to the single-curve representation shown in Fig. 11. In this illustration, a constant value of  $C$ , equal to 3.428, was used in computing the ratio of  $C_1/C$ .

#### DISCHARGE COEFFICIENTS FOR FLOW UNDER TAINTER GATES

The flow under Tainter gates mounted on curved crests is controlled by the geometry of three interrelated variables—the crest shape, the gate, and the gate setting. The major factors which influence the discharge relation-

ships are the position of the gate seal point with respect to the highest point of the spillway crest and the curvature of the upstream face of the gate. In obtaining the model data on the various TVA Tainter-gate installations no attempt has been made to determine the quantitative effect of these factors taken individually. The data presented in Figs. 12 and 13 for the gate settings at Wheeler Dam, Apalachia Dam, Watts Bar Dam, and Hales Bar Dam are not, therefore, applicable to other installations unless the several variables involved are similar.

Data on Tainter-gate coefficients previously published have, in most cases, been based on flow along a horizontal surface although many of these gates are installed on curved crests. The tests reported herein are for Tainter gates mounted on curved spillway crests where the pressure distribution differs considerably from that in a horizontal channel. The coefficients obtained from tests on a horizontal channel are not applicable to installations on curved crests.

The discharge coefficients for Figs. 12 and 13 were computed using Eq. 2, with the heads measured above the crest elevation. The curves designated "Gates raised above water surface" are the free-discharge curves taken from Figs. 3(a) and 3(b) for which  $C$ -values were computed using Eq. 1. The points connected by the dashed lines represent the point at which the water touched the bottom edge of the gate. The difference in the  $C$ -values is, of course, due to the use of Eq. 2 for the gate curve. The Hales Bar tests were not conducted in a manner that allowed the determination of the point of contact of the gate with the free water surface.

The gate opening was measured as the vertical distance above the crest. This definition leads to the somewhat peculiar variation in the coefficients for small gate openings. In Fig. 12(a) the data for Wheeler Dam are presented. The Wheeler gate was positioned, as shown in the insert, with the seal at the high point on the crest. With this design, except at the smallest opening, the coefficient curves for each gate position followed the general pattern of an increase in  $C$  for an increase in gate opening. In Fig. 12(b) the data for Apalachia Dam indicate that, when the gate seal is 3.99 ft downstream and 0.50 ft below the highest point on the crest, the coefficients for gate openings of less than 6.45 ft are increased materially with a decrease in gate opening. This is caused by an arbitrary use in Eq. 2 of an  $H$ -value as measured above the crest rather than as measured above the elevation of the spillway surface below the gate. Thus, although the  $H$ -value is consistently too small at the smaller gate openings, the effect becomes more appreciable and results in the increase in  $C$ .

#### TAINTER-GATE DISCHARGE COEFFICIENTS WITH ADJACENT GATES OPENED OR CLOSED

The results of tests on the six-spillway-bay model of Wheeler Dam with one gate in operation and with six gates in operation are shown in Fig. 14. In operating with all six gates the contraction effect of the end piers was the same as that for the intermediate piers because the model was constructed

with half piers against the sidewalls of the flume. This operation thus represented the case in which all adjacent bays are open.

#### EFFECT OF MODEL SCALE ON FREE-DISCHARGE COEFFICIENTS

In developing discharge ratings for prototype structures from model data, it is important that the scale at which the model is built be such that the coefficients determined are applicable to the prototype structure. One author has presented data to indicate that with an increase in the model size the discharge coefficients increase.<sup>7</sup> To study this relationship, a series of precise

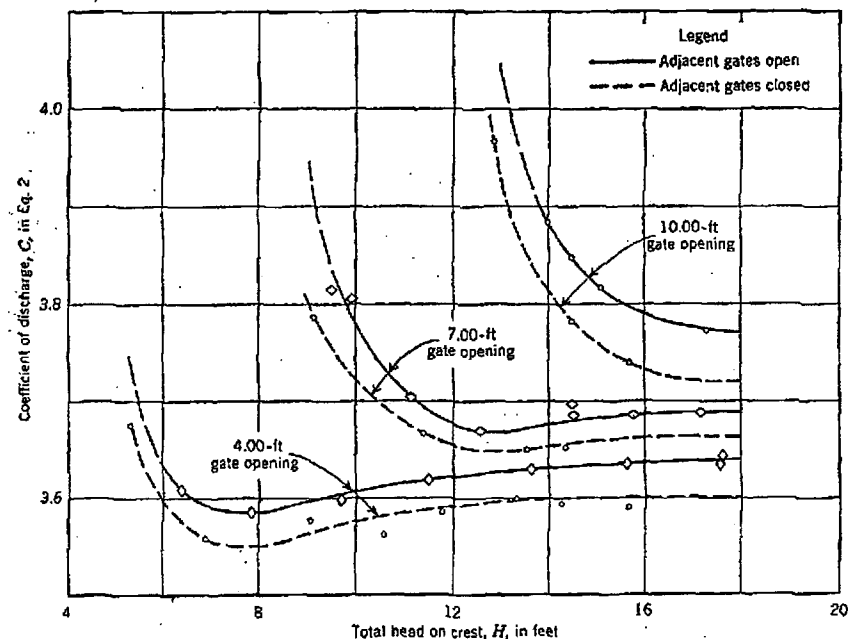


FIG. 14.—TAINTER-GATE DISCHARGE COEFFICIENTS,  $C$ , WHEELER DAM

tests was made at the TVA Hydraulic Laboratory under the joint sponsorship of the American Society for Engineering Education, the University of Tennessee (Knoxville) and the TVA.<sup>8</sup> In this study three models of Pickwick Landing spillway were constructed to scales of 1:50, 1:100, and 1:200. Each model consisted of a reproduction of three spillway bays. The shape of the spillway crest and the piers of Pickwick Landing Dam are shown in Figs. 2 and 9(a). Similar techniques were used in all tests with one exception. Hook gages reading to 0.0001 ft were used for the 1/200-scale

<sup>7</sup> "Überfallversuche in verschiedener Modellgröße," by F. Eisner, The Prussian Experiment Station for Hydraulic Structures and Shipbuilding, Berlin, 1933.

<sup>8</sup> "A Study of the Effect of Model Size on Spillway Coefficients," by C. R. Ownbey, thesis presented in 1949 to the University of Tennessee at Knoxville, in partial fulfillment of the requirements for the degree of Master of Science.

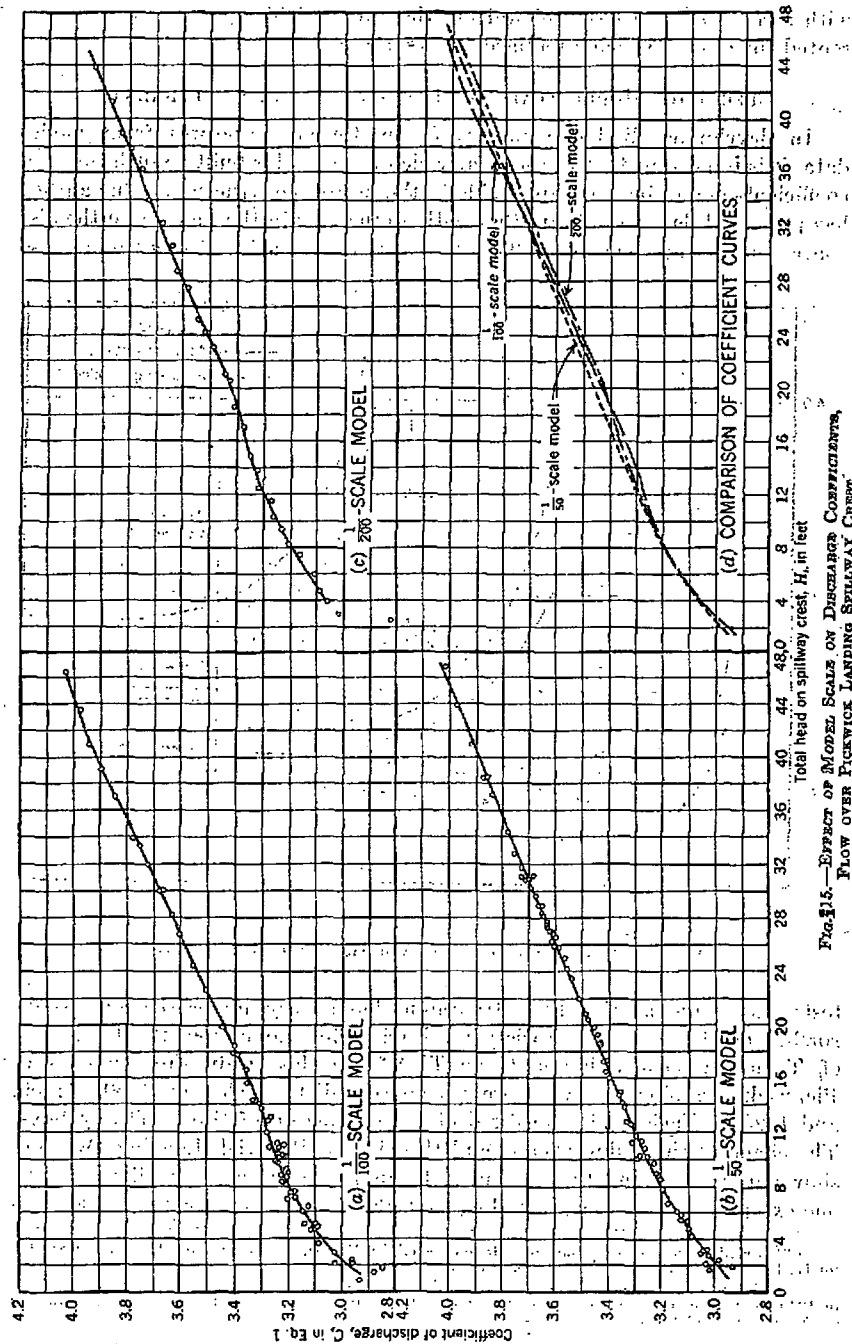


FIG. 15.—EFFECT OF MODEL SCALE ON DISCHARGE COEFFICIENTS, FLOW OVER PICKWICK LANDING SPILLWAY CREST.

tests, and gages reading to 0.001 ft were used in the 1/50-scale tests and 1/100-scale tests.

Discharge coefficients for free flow over the crest of each model are shown in Figs. 15(a), 15(b), and 15(c). The coefficients of discharge were computed using Eq. 1. Each curve was drawn through the average of the plotted points.

A comparison of the three coefficient curves is shown in Fig. 15(d). The maximum spread of the curves does not exceed 2%. For prototype heads between 2 ft and 8 ft, the three coefficient curves are almost identical. At 13 ft the coefficient curve for the 1/100-scale model is approximately 1% lower than those for the 1/50-scale model and the 1/200-scale model. At 43 ft the curve for the 1/100-scale model is 1% higher than the data for the 1/50-scale model, and that of the 1/200-scale model is 1% lower than that of the 1/50-scale model. Because there is no consistent relationship between the coefficient curves, it is logical to conclude that these variations are merely the result of experimental error and that the model scale did not affect the stage-coefficient relationship. The close agreement of the coefficient curves at the three scales supports the validity of the preparation of prototype ratings based on model tests.

#### ACKNOWLEDGMENTS

The model studies were made under the general direction of Albert S. Fry, M. ASCE, chief of the Hydraulic Data Branch of the TVA, and under the immediate supervision of G. H. Hickox, M. ASCE, former head of the TVA Hydraulic Laboratory, and Rex A. Elder, M. ASCE, head of the TVA Hydraulic Laboratory. The assistance of Jack C. Jones, J. M. ASCE, is acknowledged in making the computations and preparing the illustrations in this paper. The writer also acknowledges the many helpful suggestions made by Mr. Hickox and Mr. Elder.

#### APPENDIX. NOTATION

The following letter symbols, adopted for use in the paper and for the guidance of discussers, conform essentially with American Standard Letter Symbols for Hydraulics (ASA-Z10.2-1942), prepared by a committee of the American Standards Association with Society representation, and approved by the Association in 1942:

- $C$  = coefficient of discharge for any head:
  - $C_0$  = coefficient of discharge for the design head;
  - $C_s$  = coefficient of discharge for submerged flow;
- $D$  = depth of flow above the crest, in feet (Fig. 1(a));
- $D_1$  = depth, bottom of gate to water surface, in feet (Fig. 1(b));
- $d$  = submergence tailwater, measured above the crest, in feet (Fig. 1(a));
- $g$  = acceleration due to gravity, in feet per second per second;

- $H$  = total head above the crest, including the velocity head of approach, in feet (Fig. 1);  
 $H_s$  = design head for a standard crest, including the velocity head of approach, in feet;  
 $h$  = velocity head of approach,  $v^2/2g$ , in feet (Fig. 1);  
 $L$  = spillway crest length, in feet;  
 $P$  = depth of the approach channel, crest to river bed, in feet (Fig. 1(a));  
 $Q$  = total discharge, in cubic feet per second;  
 $v$  = average velocity of approach, in feet per second; and  
 $X, Y$  = crest coordinates, in feet.

## AMERICAN SOCIETY OF CIVIL ENGINEERS

Founded November 5, 1852

## TRANSACTIONS

Paper No. 2856

## WATER CONTROL IN CENTRAL AND SOUTHERN FLORIDA

BY HAROLD A. SCOTT,<sup>1</sup> M. ASCE

## SYNOPSIS

This paper describes the historical efforts made to provide drainage and water control for central and southern Florida. Distribution and utilization of water in the comprehensive plan for flood control and multiple purposes are described. The need for a secondary water-control plan is emphasized.

## INTRODUCTION

The area described in this paper (Fig. 1) lies south of an east-west line through Lake Harney (about 35 miles north of Cocoa) in Florida in the St. Johns River basin and east of the ridge that extends through Haines City and Sebring. The ridge divides the waters which flow into the Atlantic Ocean and those which flow into the Gulf of Mexico. Water-control problems are quite common throughout the area, although there are a few variations in topography and soil. The area consists of approximately 15,000 sq miles of groveland, pastures, rich agricultural lands, lakes, and marshlands. Elevations range from approximately 7 ft in the vicinity of Miami and 15 ft around Lake Okeechobee to 80 ft in the area of the headwaters of the Kissimmee River basin. (All stages and elevations throughout this paper refer to mean sea level data.) However, the lands of a large part of the area are extremely flat, and natural water courses are not common. Except for the St. Johns River, the Kissimmee River, Fisheating Creek, and a few minor streams, most of the water control is accomplished by man-made canals and drainage districts. Soils in the area vary from sand to peat with a small amount of marl. The areas with higher elevations in the St. Johns and Kissimmee River basins consist of sand mixed with a small amount of organic material in the upper 6 in. to 12 in. In the low areas and marshes, deposits of peat of thicknesses ranging to several feet are found. The Everglades is covered with a layer of peat of thickness ranging to approximately 15 ft at Lake Okeechobee and gradually diminishing to zero at

NOTE.—Published, essentially as printed here, in October, 1954, as *Proceedings-Separate No. 521*. Editions and titles given are those in effect when the paper was approved for publication in *Transactions*.  
<sup>1</sup> Cons. Engr., Reynolds, Smith, and Hills, Jacksonville, Fla.



0200M01 C 90

2

3

4

5

6

7


8

9


10

11


12

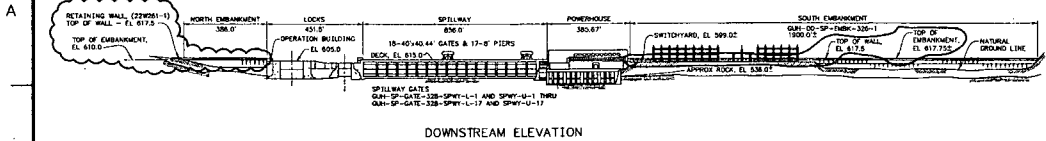


DOWNSTREAM ELEVATION

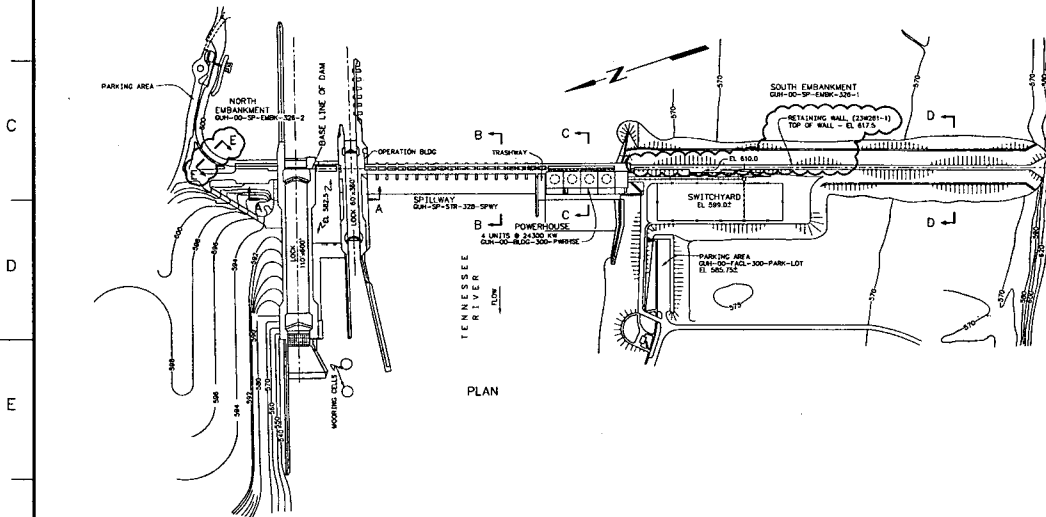


PLAN

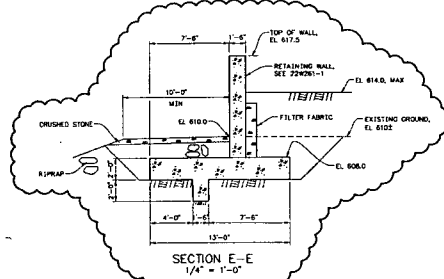


SECTION E-E  
1/4" = 1'-0"

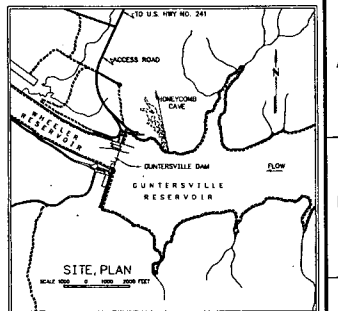


SITE PLAN  

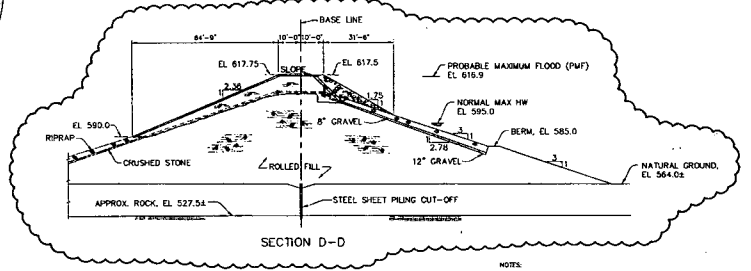


SECTION D-D

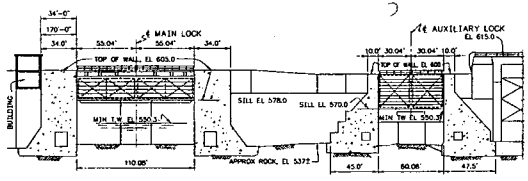

SECTION A-A  
1" = 40'

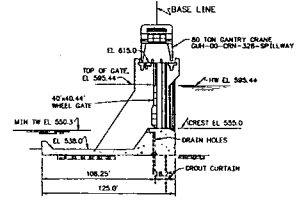

SECTION B-B

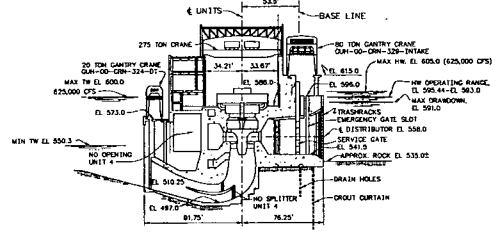

SECTION C-C  
UNITS 1, 2, & 3 AS SHOWN  
UNIT 4 AS SHOWN & NOTED

- NOTES:
- COMPONENT UNIT NUMBERING SCHEME:  
PLAN UNIT FUNCTION SYSTEM GRADE NO.  
GSM GO GWR 329 CRANE
  - UNITS ARE LISTED IN WHOLE ON THIS DRAWING WHEN IT IS PRACTICAL. OTHER COMPONENT UNITS ARE LISTED BY SCHEMATIC NUMBER TO FIT ON THIS PAGE. FOR EXAMPLE TO HAVE THE COMPLETE UNIT NUMBER FOR THE DAM ADD THE PREFIX "GSM-GO-CRW-329" TO THE SCHEMATIC NUMBER.
  - COMPONENT UNIT NUMBERS USE THE FOLLOWING SYSTEM AND FUNCTION CODES:  
SYSTEM NUMBER - SYSTEM NAME FUNCTION CODES - FUNCTION CODE NAMES  
300 - FACILITIES & EQUIPMENT BLDG - POWERHOUSE  
314 - DRAFT TUBE ENCLOSURE GWR - DRAFT TUBE GATE GANTRY CRANE  
328 - DAM GWR - SPILLWAY GATE GANTRY CRANE  
329 - SPILLWAY GWR - INTAKE GANTRY CRANE  
329 - INTAKE SYSTEM GWR - EMERGENCY GATE  
329 - PARKING LOT GATE - SPILLWAY GATE

FOR PROBABLE MAXIMUM FLOOD DETAILS AND NOTIFICATIONS, SEE DRAWINGS:  
 220280-SERIES - NORTH EMBANKMENT MODIFICATIONS  
 220281-SERIES - NORTH WALL SECTIONS & DETAILS  
 220282-SERIES - SOUTH EMBANKMENT MODIFICATIONS  
 220283-SERIES - SOUTH WALL SECTIONS & DETAILS  
 220284-SERIES - SPILLWAY GATE MODIFICATIONS

NO.	DATE	BY	CHKD BY	APP'D BY	REVISION
1	12-29-34	...	...	...	...

SCALE: 1"=200 EXCEPT AS NOTED


MAIN DAM WORKS

GENERAL PLAN  
ELEVATION AND SECTIONS

DESIGNED BY: ... DRAWN BY: ... CHECKED BY: ... APPROVED BY: ...

GUNTERSVILLE HYDRO PLANT  
TENNESSEE VALLEY AUTHORITY  
POSSIBLE AND HYDRO ENGINEERING

AUTOCAD 2000 12-29-34 06 C 10W200 R 11

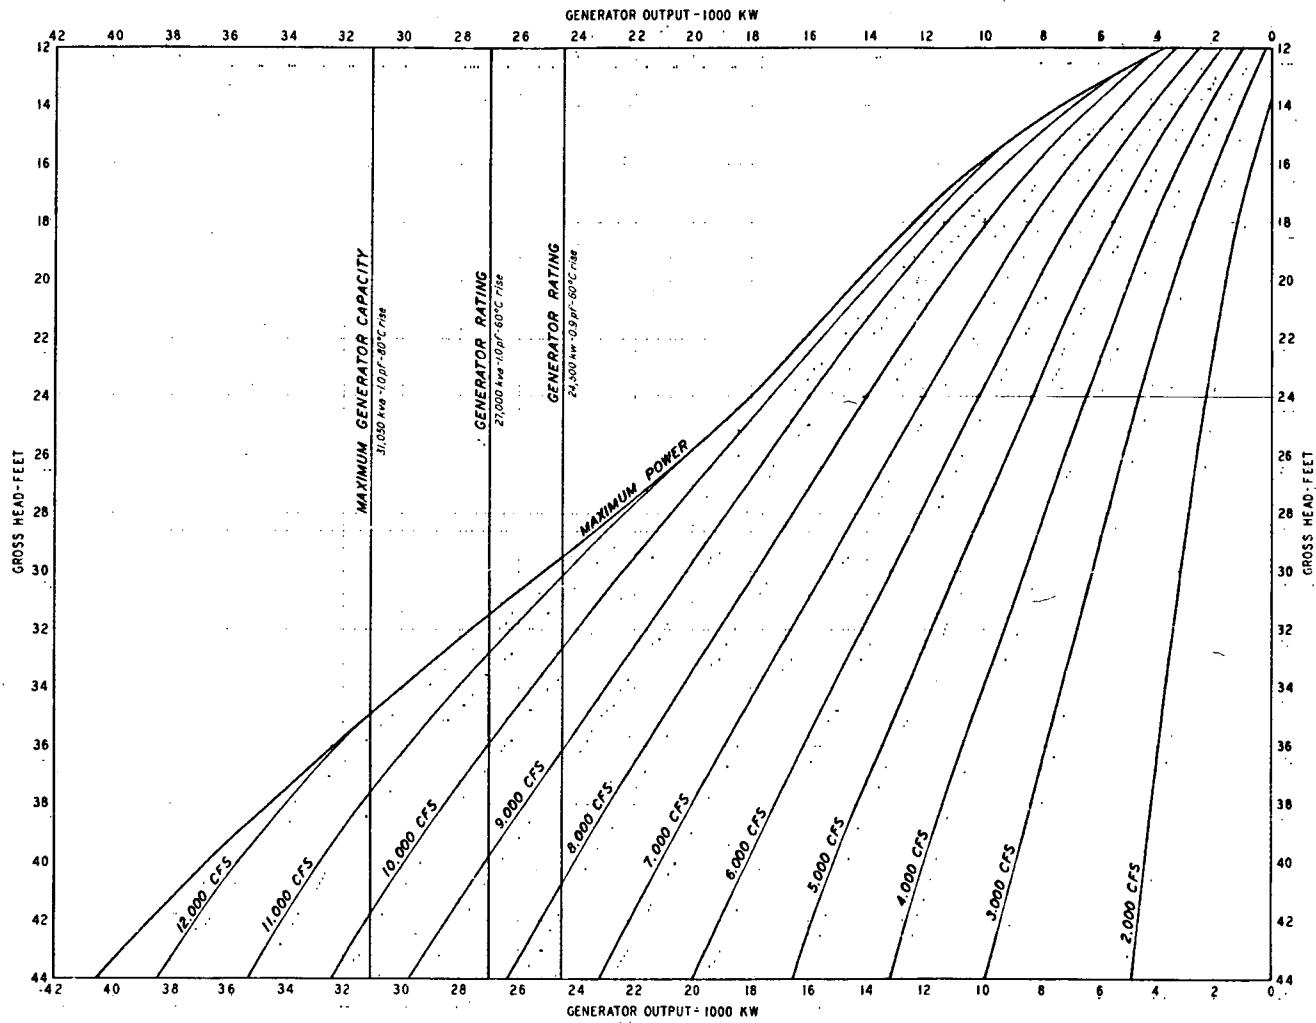


**NOTES:**  
 Curves are based on S. Morgan Smith Co. model test  
 At 1437 and modified in accordance with index test  
 conducted March 21, 1952 at approximately 38 ft head.  
 Tests should be made at other heads and curves revised  
 accordingly.  
 TURBINE: 34,000 hp at 36 ft head and 69.2 rpm. Furnished  
 by S. Morgan Smith Co., York, Pa.  
 GENERATOR: 27,000 kw, 3 phase, 60 cycle, 69.2 rpm.  
 Furnished by General Electric Co.


DATE	BY	CHKD	APP'D
	JWR	CLN	
		NCE	
	JWR		

Guntersville Calculation  
 CDQ000020080011 Attachment 26


POWERHOUSE UNIT 4	
DISCHARGE CURVES BASED ON INDEX TEST	
GUNTERSVILLE PROJECT TENNESSEE VALLEY AUTHORITY	
DIVISION OF DESIGN	
DESIGNED BY C. H. Morris	APPROVED BY B. C. Morris
KNOWLEDGE 5-6-52	DATE 6/14/47
K2900	

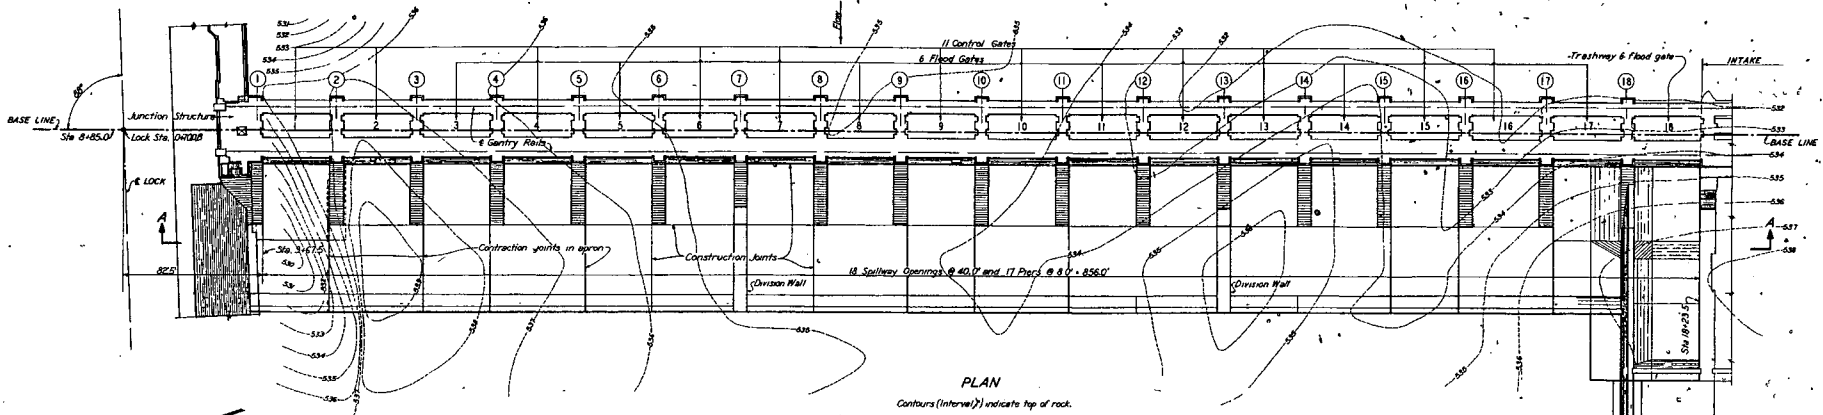


PLAN  
Contours (Intermittent) indicate top of rock.

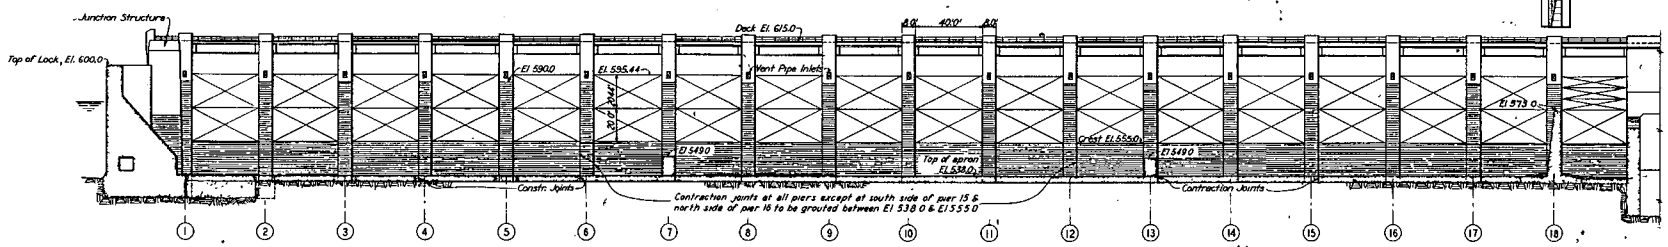


ELEVATION A-A

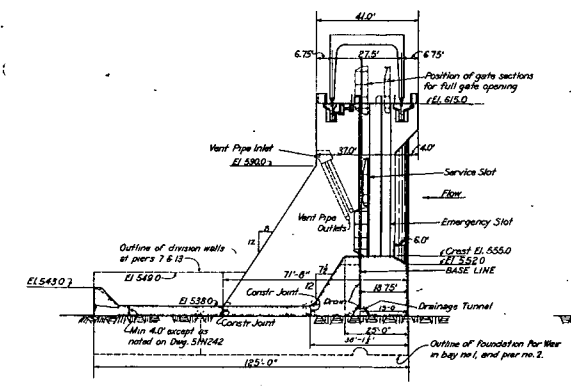

TYPICAL SECTION  
SHOWING STRUCTURAL FEATURES  
Scale 0 20 Feet

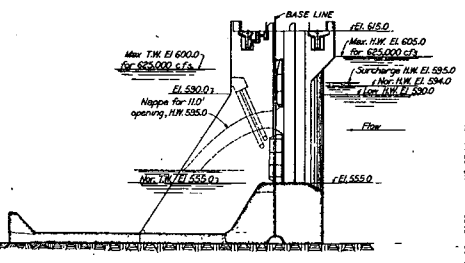

TYPICAL SECTION  
SHOWING HYDRAULIC FEATURES  
Scale 0 20 Feet

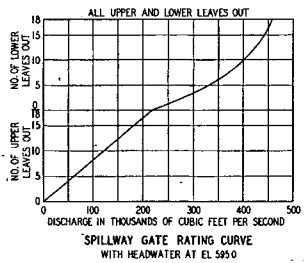

- REFERENCE DRAWINGS:
- S1 N 273 - BAYS 17 & 18 - APRON & TRAINING WALL - OUTLINE
  - S1 N 201 - ROCK DOWELS, FOUNDATION GROUTING AND DRAINAGE
  - S1 N 222 - JUNCTION WITH LOCK - GEN. PLANS AND SECS. - OUTLINE
  - S1 N 406 - STABILITY ANALYSIS AND STRESS DIAGRAMS
  - S1 N 206 - TYPICAL PIER - EL. 555.0 TO EL. 615.0 - OUTLINE
  - S1 N 242 - TYPICAL PIER, WEIR AND APRON - FOUND. TO EL. 555.0 - OUTLINE
  - S1 N 210 - GROUTING SYSTEM - JOINTS BETWEEN PIER AND WEIR, SPILLWAY - JOINTS AND SEALS
  - S1 N 247 - DETAILS AT CREST ELEVATION
  - S1 N 217 - OPERATING BRIDGE DECK OUTLINE
  - S1 N 227 - JUNCTION WITH LOCK - PIER NO. 1 EL. 555.0 TO EL. 615.0 - OUTLINE
  - S1 N 228 - FOUND. TO EL. 555.0
  - S1 N 202 - GATE TRACK SUPPORT TOWERS - INTERMEDIATE PIERS
  - S1 N 303 - END PIERS
  - S1 N 311 - INTAKE & SPILLWAY - GATES & CRANES - GEN. ARRANGEMENT
  - S1 N 244 - DIVISION WALL ABOVE APRON - OUTLINE & REINFORCEMENT
  - INTAKE -
  - S1 N 200 - GEN. PLAN, ELEVATIONS AND SECTIONS
- ELECTRICAL -
- S1 N 118 - SPILLWAY - GENERAL ARRANGEMENT.
- LOCK -
- U.S.G.O. DRAWINGS.

SPILLWAY DAM

PLAN, ELEVATION AND SECTIONS


GUNTERSVILLE PROJECT  
TENNESSEE VALLEY AUTHORITY  
ENGINEERING DESIGN DEPARTMENT

SUBMITTED BY Ron M. Riegel	RECOMMENDED BY J. H. [Signature]	APPROVED BY [Signature]
KNOXVILLE, TENN. - 4/16-37	6	4
	5	241 RB

Guntersville Calculation  
CDQ0002008011 Attachment 27


THIS DRAWING SUPERSEDES DWG. S1N200.

8	REVISIONS	DATE	BY	DESCRIPTION

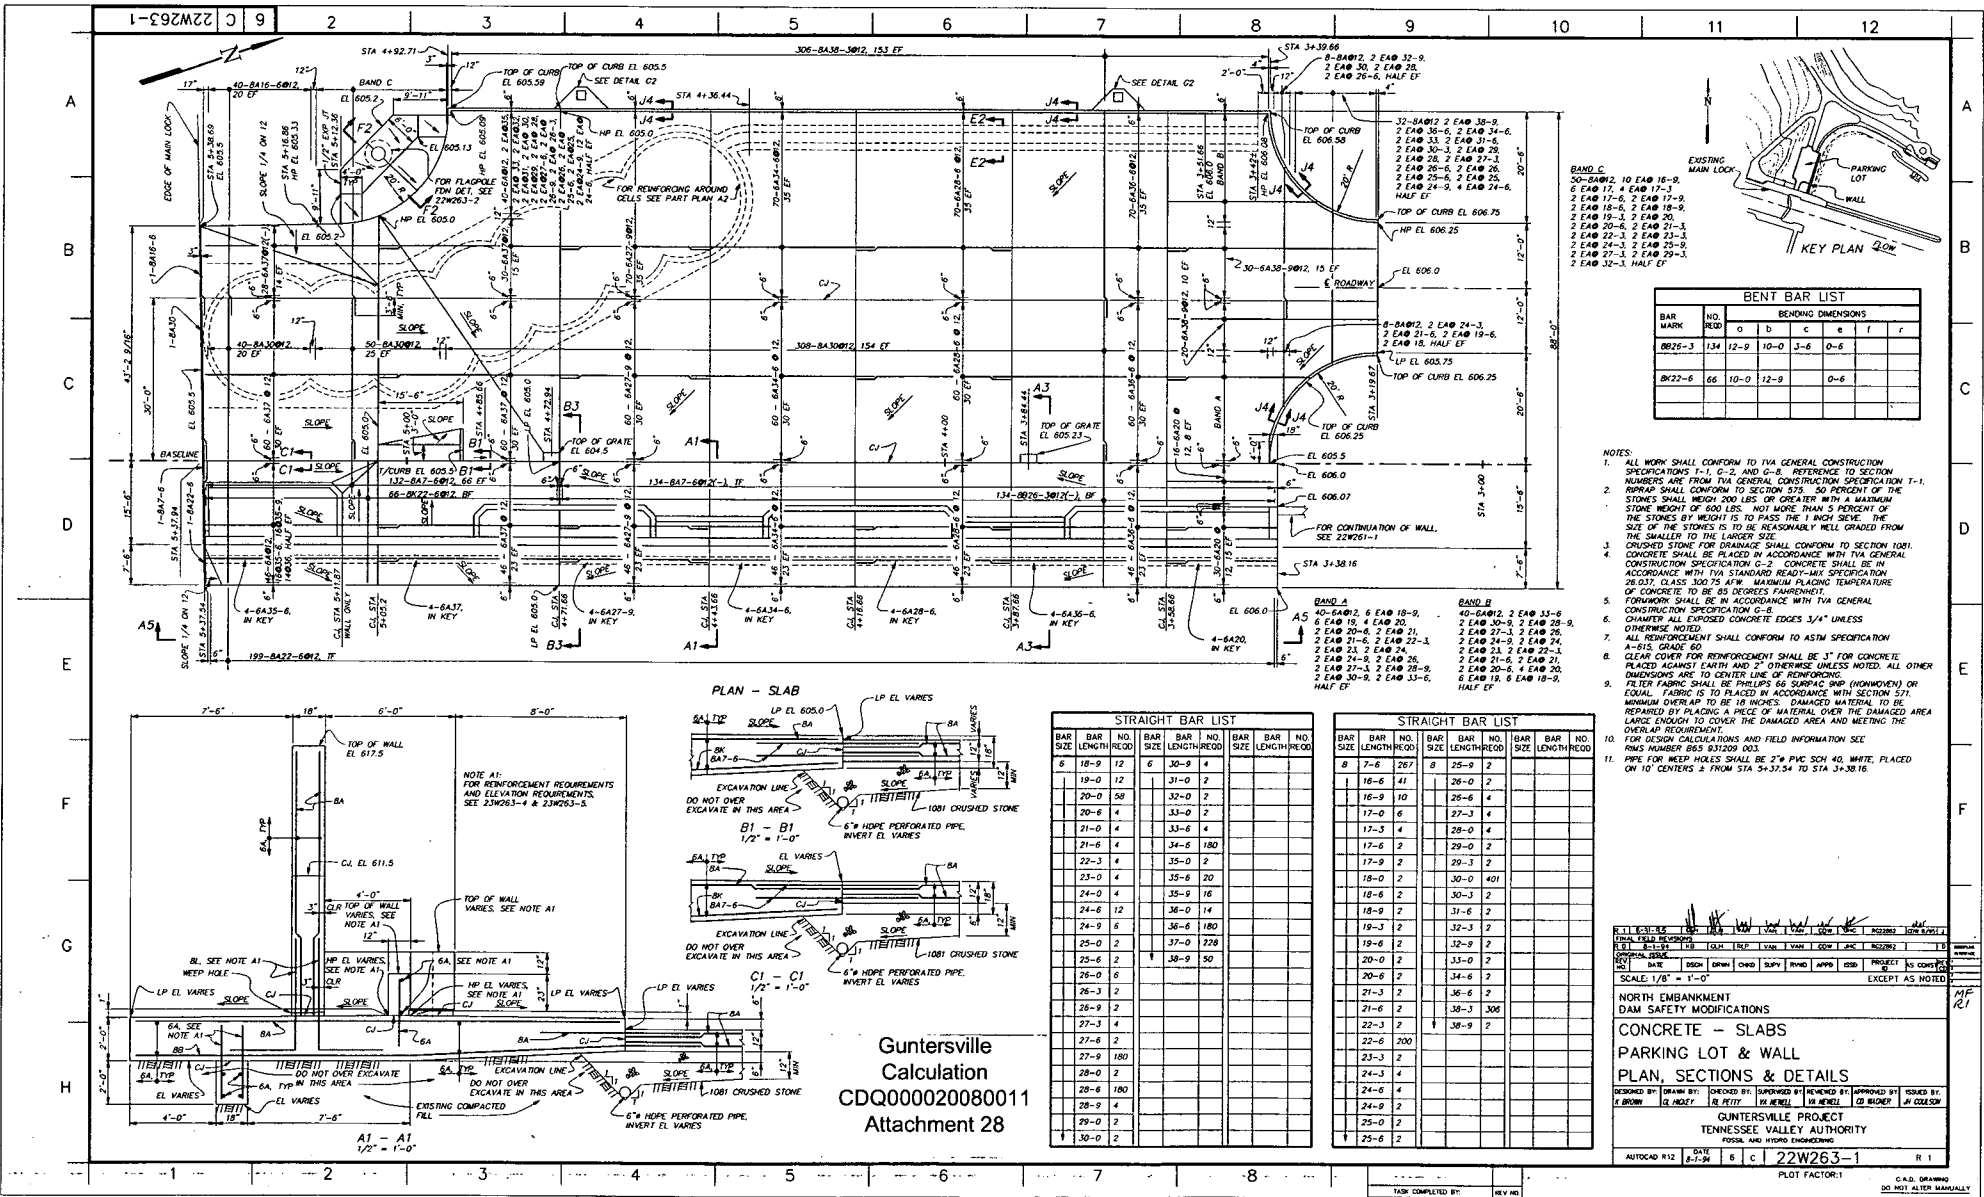

BENT BAR LIST						
BAR MARK	NO. REQD	BENDING DIMENSIONS				
		a	b	c	e	f
BK23-3	134	12-9	10-0	3-6	0-6	
BK22-6	66	10-0	12-9		0-6	

- NOTES:
- ALL WORK SHALL CONFORM TO IVA GENERAL CONSTRUCTION SPECIFICATIONS T-1, C-2 AND G-8. REFERENCE TO SECTION NUMBERS ARE FROM IVA GENERAL CONSTRUCTION SPECIFICATION T-1.
  - REBAR SHALL CONFORM TO SECTION 575. 50 PERCENT OF THE STONES SHALL BEGRIND 200 LBS. OR GREATER WITH A MAXIMUM STONE HEIGHT OF 600 LBS. NOT MORE THAN 5 PERCENT OF THE STONES BY WEIGHT IS TO PASS THE 1/8" SIEVE. THE SIZE OF THE STONES IS TO BE REASONABLY WELL GRADUED FROM THE SMALLER TO THE LARGER SIZE.
  - CRUSHED STONE FOR DRAINAGE SHALL CONFORM TO SECTION 1081. CONSTRUCTION SPECIFICATION G-2. CONCRETE SHALL BE IN ACCORDANCE WITH IVA STANDARD READY-MIX SPECIFICATION 26.D17. CLASS 300 75 AFW. MAXIMUM PLACING TEMPERATURE OF CONCRETE TO BE 95 DEGREES FAHRENHEIT.
  - FORMWORK SHALL BE IN ACCORDANCE WITH IVA GENERAL CONSTRUCTION SPECIFICATION G-8.
  - CHANGEL ALL EXPOSED CONCRETE EDGES 1/4" UNLESS OTHERWISE NOTED.
  - ALL REINFORCEMENT SHALL CONFORM TO ASTM SPECIFICATION A-615, GRADE 60.
  - CLEAN COVER FOR REINFORCEMENT SHALL BE 3" FOR CONCRETE PLACED AGAINST EARTH AND 2" OTHERWISE UNLESS NOTED. ALL OTHER DIMENSIONS ARE TO CENTER LINE OF REINFORCING.
  - FILTER FABRIC SHALL BE PROVIDED 66 SURFACE IMP. (NONMOVING) OR EQUAL. FABRIC IS TO BE PLACED IN ACCORDANCE WITH SECTION 571. MINIMUM OVERLAP TO BE 18" MINIMUM. DAMAGED MATERIAL TO BE REPAIRED BY PLACING A PIECE OF MATERIAL OVER THE DAMAGED AREA LARGE ENOUGH TO COVER THE DAMAGED AREA AND MEETING THE OVERLAP REQUIREMENT.
  - FOR DESIGN CALCULATIONS AND FIELD INFORMATION SEE PWS NUMBER BSS 831209 003.
  - PIPE FOR WEEP HOLES SHALL BE 2" PVC SCH 40, WHITE, PLACED ON 10" CENTERS & FROM STA 5+37.54 TO STA 3+38.16.

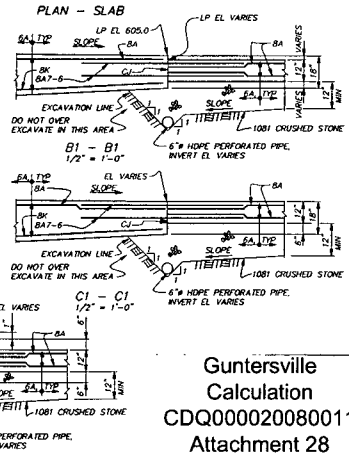

STRAIGHT BAR LIST				STRAIGHT BAR LIST			
BAR NO.	BAR SIZE	LENGTH (FEET)	NO. REQD	BAR NO.	BAR SIZE	LENGTH (FEET)	NO. REQD
6	18-9	12	6	30-9	4		
19-9	12	31-0	2				
20-0	58	33-0	2				
20-6	4	13-0	2				
21-0	4	13-6	4				
21-6	4	34-6	180				
22-3	4	35-0	2				
23-0	4	35-6	20				
24-0	4	35-9	16				
24-6	12	36-0	14				
24-9	6	36-6	180				
25-0	2	37-0	228				
25-6	2	38-9	50				
26-0	6						
26-3	2						
26-9	2						
27-3	4						
27-6	2						
27-9	180						
28-0	2						
28-6	180						
28-9	4						
29-0	2						
30-0	2						

STRAIGHT BAR LIST				STRAIGHT BAR LIST			
BAR NO.	BAR SIZE	LENGTH (FEET)	NO. REQD	BAR NO.	BAR SIZE	LENGTH (FEET)	NO. REQD
B	7-6	267	8	25-0	2		
				26-0	2		
				16-9	10	26-6	4
				17-0	6	27-3	4
				17-3	4	28-0	4
				17-6	2	29-0	2
				17-9	2	29-3	2
				18-0	2	30-0	401
				18-6	2	30-3	2
				18-9	2	31-6	2
				19-3	2	32-3	2
				19-6	2	32-9	2
				20-0	2	33-0	2
				20-6	2	34-6	2
				21-3	2	36-6	2
				21-6	2	38-3	306
				22-3	2	38-9	2
				22-6	200		
				23-3	2		
				24-3	4		
				24-6	4		
				24-9	2		
				25-0	2		
				25-6	2		

Guntersville  
Calculation  
CDQ00002080011  
Attachment 28

REVISIONS

NO.	DATE	BY	DESCRIPTION

NORTH EMBANKMENT  
DAM SAFETY MODIFICATIONS  
**CONCRETE - SLABS  
PARKING LOT & WALL  
PLAN, SECTIONS & DETAILS**


DESIGNED BY: DRAWN BY: CHECKED BY: APPROVED BY: REVISIONS BY: ISSUED BY:  
 (Signature) (Signature) (Signature) (Signature) (Signature) (Signature)

GUNTERSVILLE PROJECT  
TENNESSEE VALLEY AUTHORITY  


BENT BAR LIST						
BAR MARK	NO.	NO. REED	BENDING DIMENSIONS			
			a	b	c	f
6L10-6	12	7-0	EX			
6L26-9	12	7-0	EX			
6L9	415	5-8	EX			

STRAIGHT BAR LIST						
BAR NO.	BAR NO. LENGTH/REOD	BAR NO.	BAR NO. LENGTH/REOD	BAR NO.	BAR NO. LENGTH/REOD	BAR NO. LENGTH/REOD
	4-3	26				
	4-9	3				
	16-6	3				
	20-0	12				
	25-0	26				
	26-0	24				
	27-6	26				
	28-6	48				
	39-9	26				
8	11-3	55				
	11-6	58				
	11-9	178				
	12	124				

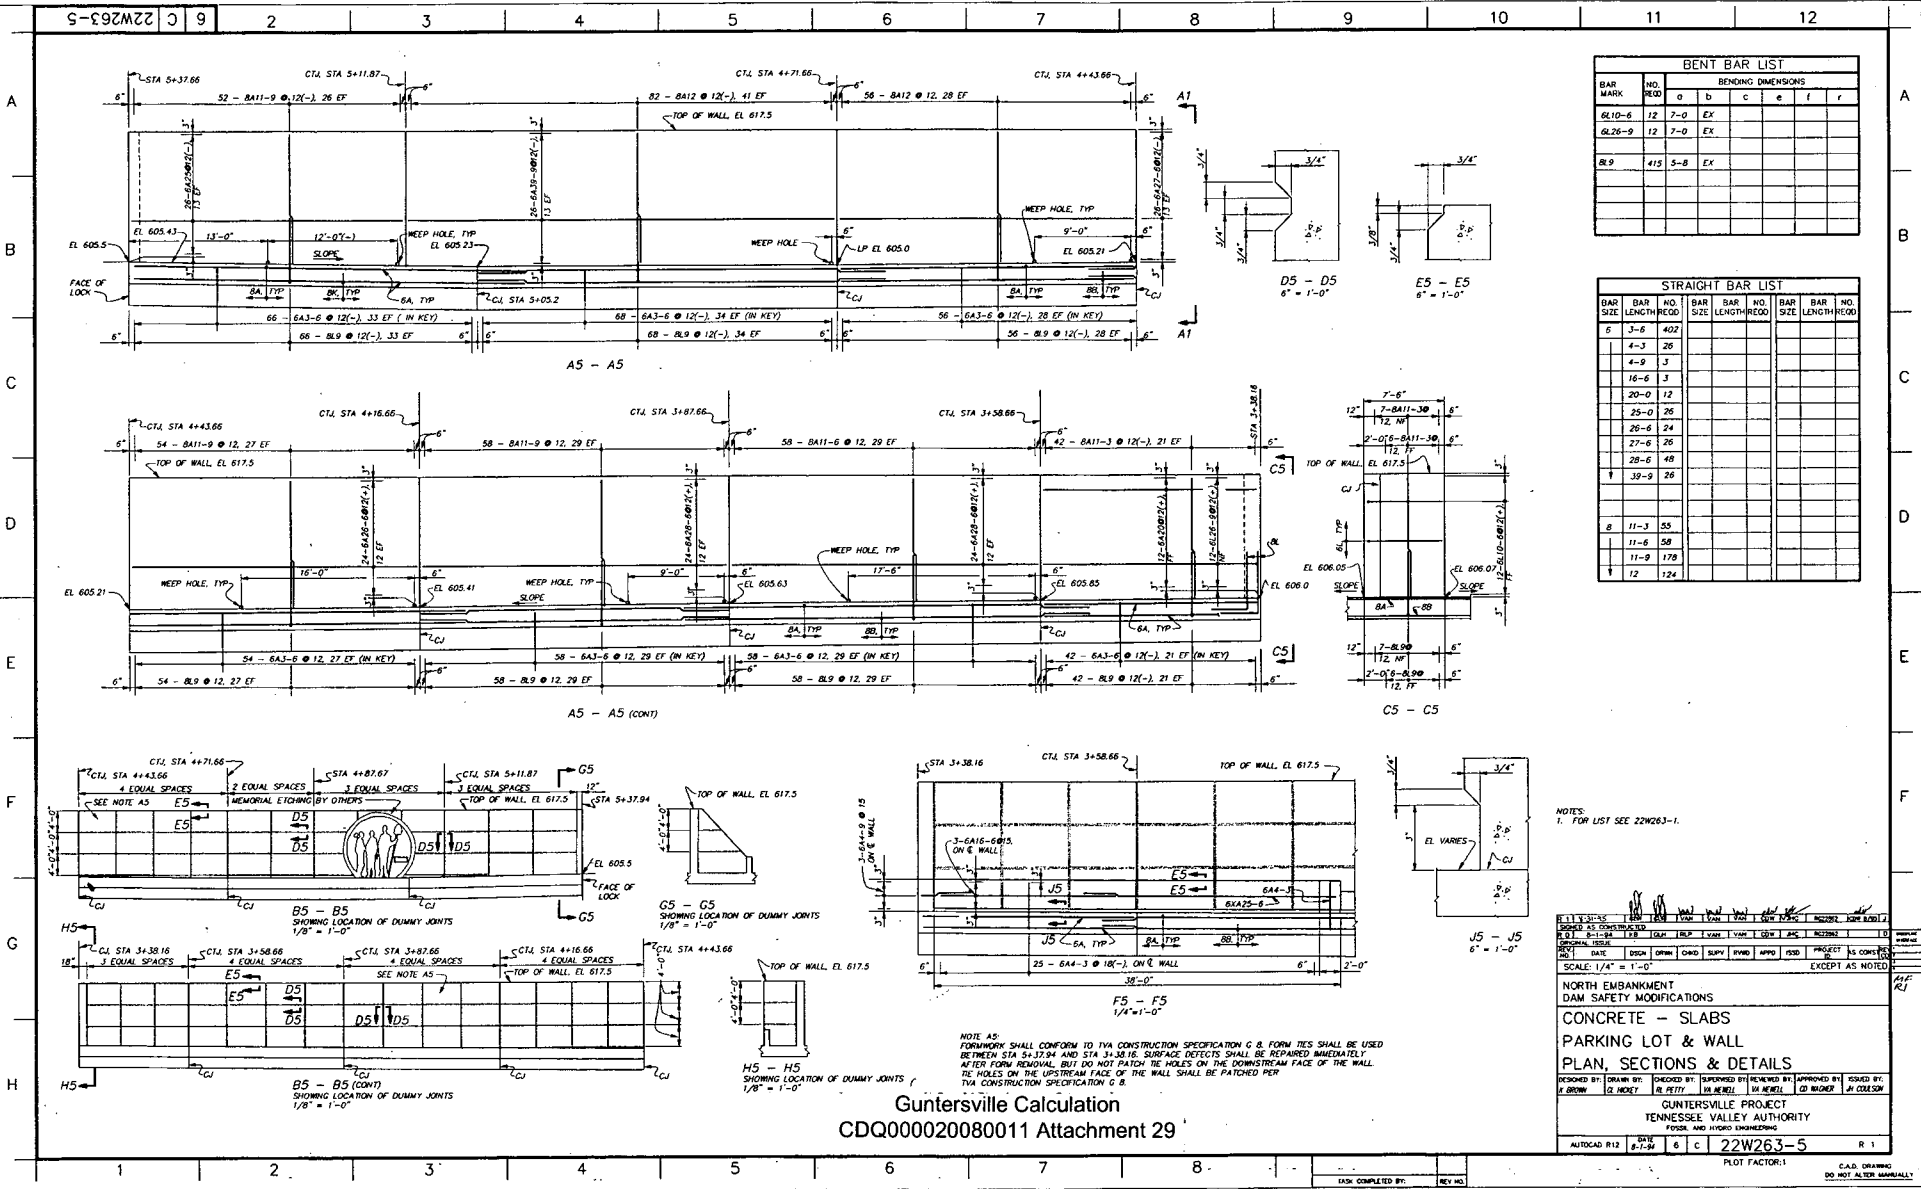


NOTES:  
1. FOR LIST SEE 22W263-1.

NORTH EMBANKMENT DAM SAFETY MODIFICATIONS											
CONCRETE - SLABS											
PARKING LOT & WALL											
PLAN, SECTIONS & DETAILS											
DESIGNED BY:	DRN	CHKD	APPD	ISSD	PROJECT	AS COMPLD	ISSUED BY:	CHKD	APPD	ISSD	PROJECT
Guntersville Project						Tennessee Valley Authority Flood and Hydro Engineering					
AUTOCAD R12 6/1/2006 6:00 PM 22W263-5 R 1											


Guntersville Calculation  
CDQ000020080011 Attachment 29

DATE COMPLETED: REV: NO.


SIN222A

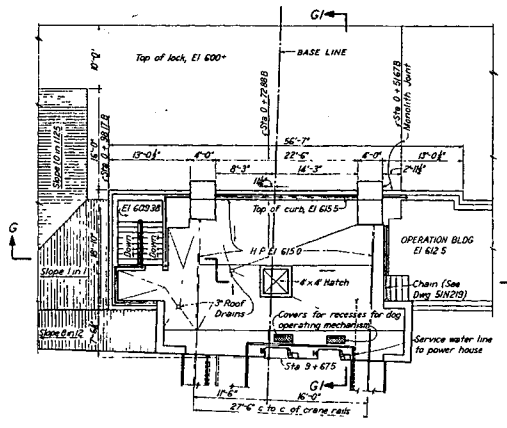


PLAN-EL. 615.0

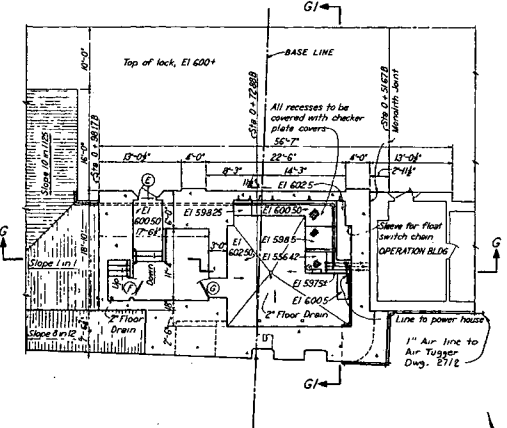


PLAN-EL. 602.5

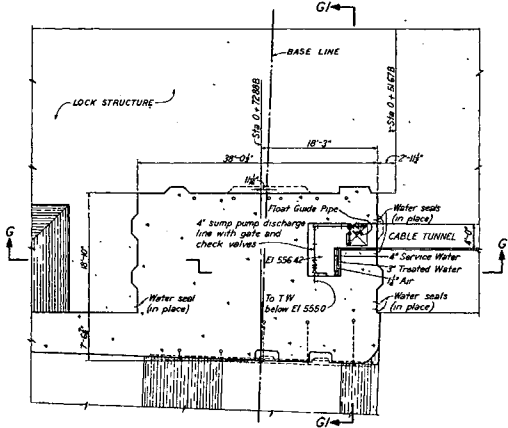

PLAN-EL. 560.0

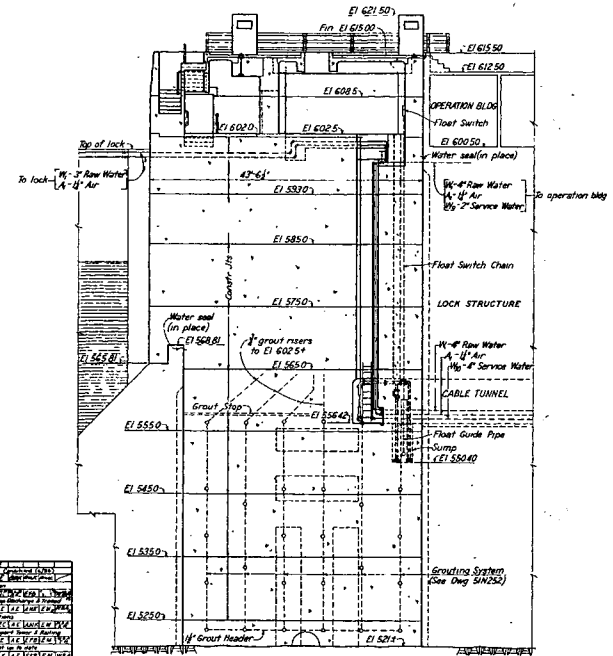

SECTION G-G

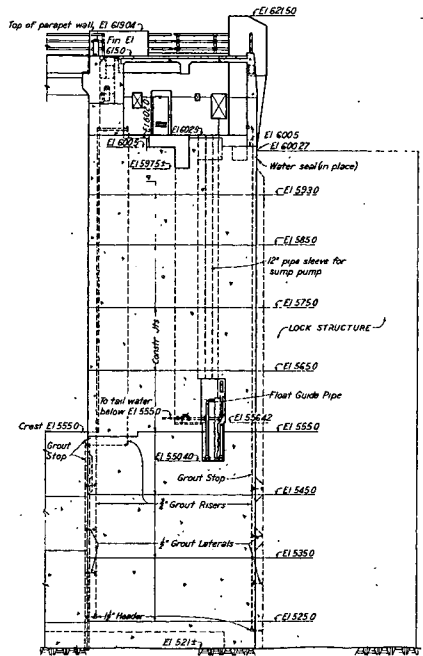

SECTION GI-GI

- REFERENCE DRAWINGS:**
- SI N 204... CONC-EL 602.5 & EL 560.0-PLANS & DETAILS-OUTLINE
  - SI N 205... WEST & NORTH WALL ELEVATIONS-OUTLINE
  - SI N 207... PIER I-EL 555.0 TO 615.0-OUTLINE
  - SI N 208... FOUNDATION TO EL 555.0-OUTLINE
  - SI N 209... WEST & NORTH WALL ELEVATIONS-REINF
  - SI N 210... EAST WALL & MISS DETAILS-REINF
  - SI N 211... PIER I-EL 555.0 TO 615.0-REINF-SH 1
  - SI N 212... FOUNDATION TO EL 555.0-REINF
  - SI N 213... PIPING LAYOUT
  - SI N 214... CONC METAL DETAILS
  - SI N 215... CONC-EL 615.0-PLANS & DETAILS-OUTLINE
  - SI N 216... TRANSVERSE & LONG SECTIONS-OUTLINE
  - SI N 217... CONC-EL 615.0-PLANS & DETAILS-REINF
  - SI N 218... CONC-DOOR & LOUVER DETAILS
  - SI N 219... CONC-JOINTS & SEALS-DETAILS
  - SI N 220... DETAILS AT CREST ELEVATION
  - SI N 221... PIPING-DETAILS
  - SI N 222... WATER SEAL CONNECTIONS-DETAILS
  - SI N 223... CONC-PIER I-EL 555.0 TO 615.0-REINF-SH 2
  - SI N 224... PIPING-SUMP PUMP DISCHARGE EXTENSION VALVE & STEM
  - SI N 225... STD DETAIL OF ROUND CORNER
- SPILLWAY DAM**
- SI N 267... GATE TRACK SUPPORT TOWERS-FIELD CHANGES
  - SI N 268... ROCK EXCAVATION FOUNDATION GROUTING & DRAINAGE
  - SI N 217... OPERATING BRIDGE DECK
  - SI N 220... RAILING PLAN
  - SI N 221... DETAILS
  - SI N 241... PLAN, ELEVATION, & SECTIONS
  - SI N 303... GATE TRACK SUPPORT TOWER-CHO PIER ELECTRICAL
- LOCK**
- 85 N 14... LIGHTING PLANS-LOCK & SPILLWAY JUNCTION
  - 85 N 16... CONSULT PLAN & SECT-MULTI-LOCK & SPILLWAY JUNCTION
- LOCK**
- U S E O 20 A... LOCK WALLS-PLAN-UPPER END
  - U S E O 20 B... CABLE TUNNEL
  - U S E O 20 C... PIPING DIAGRAM & DETAILS
  - U S E O 20 D... OPERATION BUILDING-PLANS
  - N-020... REVISION IN RIVER WALL AT SPILLWAY-PLAN, ELEVATIONS, & SECTIONS
- PIPING**
- 61 N 213... TREATED WATER LINES

Scale 0 8 16 Feet  
Except as noted

**SPILLWAY DAM  
JUNCTION WITH AUXILIARY LOCK  
CONCRETE  
GENERAL PLANS & SECTIONS  
OUTLINE**

**GUNTERSVILLE PROJECT  
TENNESSEE VALLEY AUTHORITY  
ENGINEERING DESIGN DEPARTMENT**

SUBMITTED: *Rose M. Boyd* RECOMMENDED: *Robert M. Jones* APPROVED: *Robert M. Jones*

KNOXVILLE, TENN. 37628-37 0 C 4 5IN222RB


RECORD DRAWING AS CONSTRUCTED  
Date: 10-6-1938

Guntersville Calculation  
CDQ000020080011 Attachment 30


02-L349-27/7



4922264

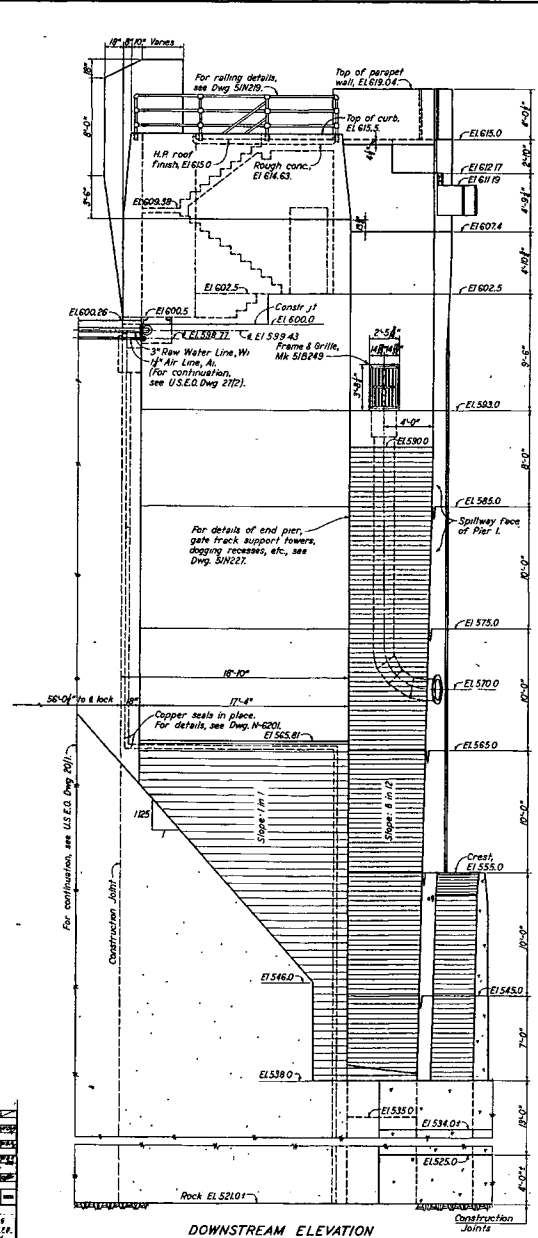


DOWNSTREAM ELEVATION

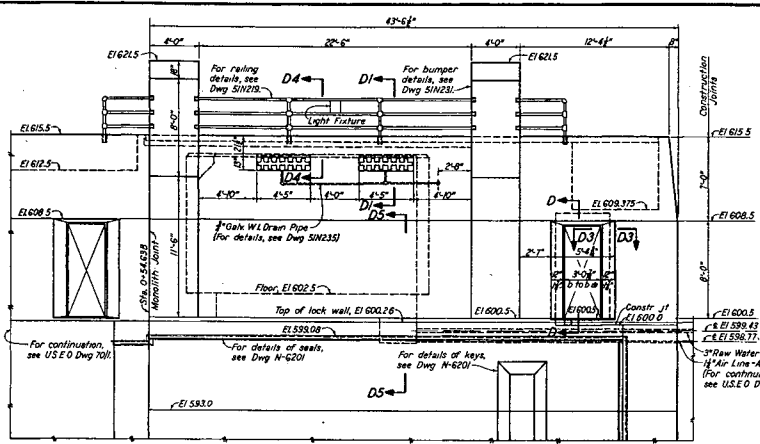


NORTH WALL ELEVATION

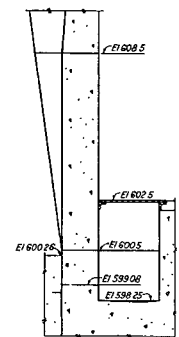


SECTION D5-D5  
Scale 0 2 Feet

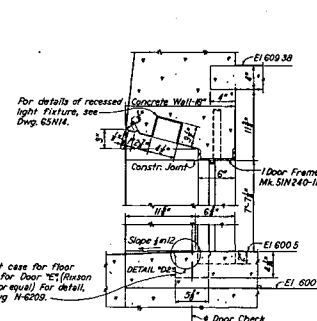


SECTION D-D  
Scale 0 1 Foot

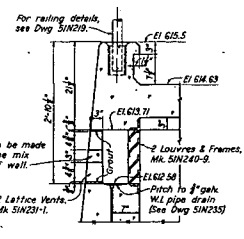


SECTION D1-D1  
Scale 0 1 Foot

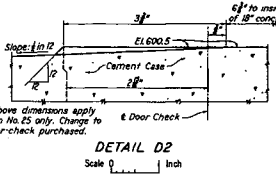

DETAIL D2  
Scale 0 1 Inch

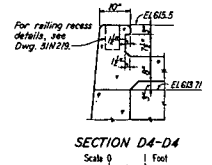

SECTION D4-D4  
Scale 0 1 Foot

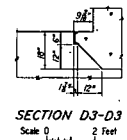

SECTION D3-D3  
Scale 0 2 Feet

NOTES:  
All concrete to be Class "A" (if) except as noted.

REFERENCE DRAWINGS:  
SPILLWAY DAM - JUNCTION WITH LOCK  
SIN 226 - CONCRETE-GENERAL PLAN & SECTIONS-OUTLINE.  
SIN 231 - DOWNSTREAM & NORTH WALL-REINF.  
SIN 240 - STR. STEEL-REINF. DETAILS-SHEET 1.  
SIN 240 - CONCRETE-GROUTING SYSTEMS-VERTICAL JOINTS.  
CDD 30821 - STANDARD DETAIL OF ROUND CORNERS.

Scale 0 4 8 Feet  
Except as noted







SPILLWAY DAM JUNCTION WITH LOCK		
CONCRETE WEST & NORTH WALL ELEVATIONS - OUTLINE		
GUNTERSVILLE PROJECT TENNESSEE VALLEY AUTHORITY ENGINEERING DESIGN DEPARTMENT		
SUBMITTED BY <i>Don McRay</i>	RECOMMENDED BY <i>W. H. Chapman</i>	APPROVED BY <i>Baron M. Jera</i>
KNOXVILLE, TENN.	7-2-37	6161 SIN226E

Guntersville Calculation  
CDQ00020080011 Attachment 31


10/1

FD5219

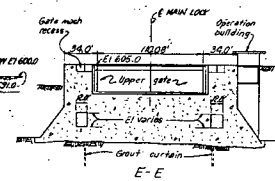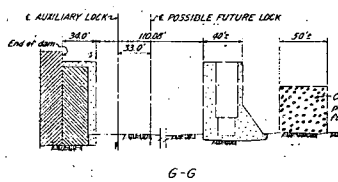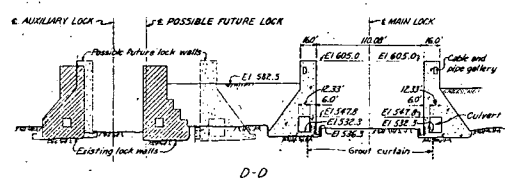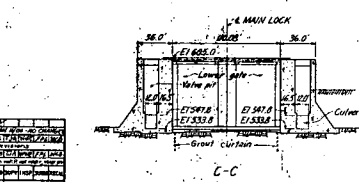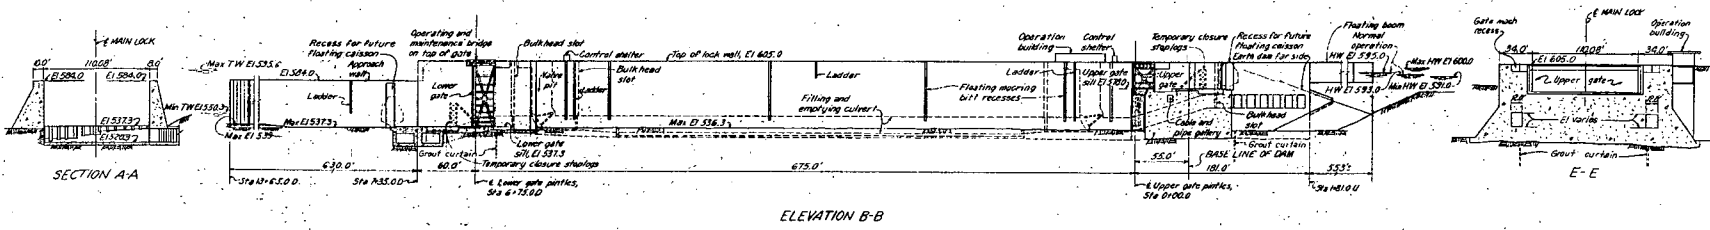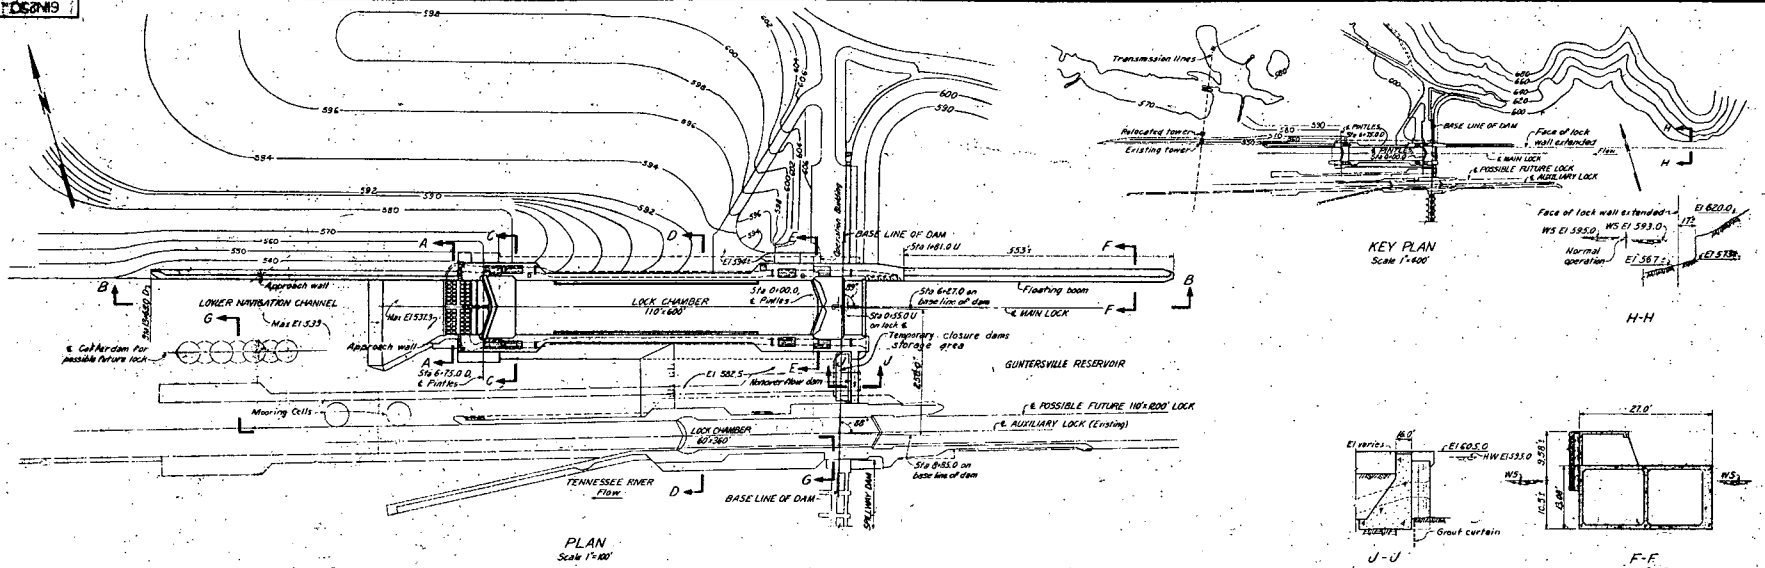


Guntersville Calculation  
CDQ00020080011 Attachment 32

**Scale 1"=30'**  
Except as noted

**MAIN LOCK**

**GENERAL PLAN  
ELEVATION AND SECTIONS**







**GUNTERSVILLE PROJECT  
TENNESSEE VALLEY AUTHORITY**

SUBMITTED	RECOMMENDED	APPROVED
KNOXVILLE	7-5-62	6-C 4 6IN25Q R3

RECORD DRAWING AS CONSTRUCTED

MF  
R1



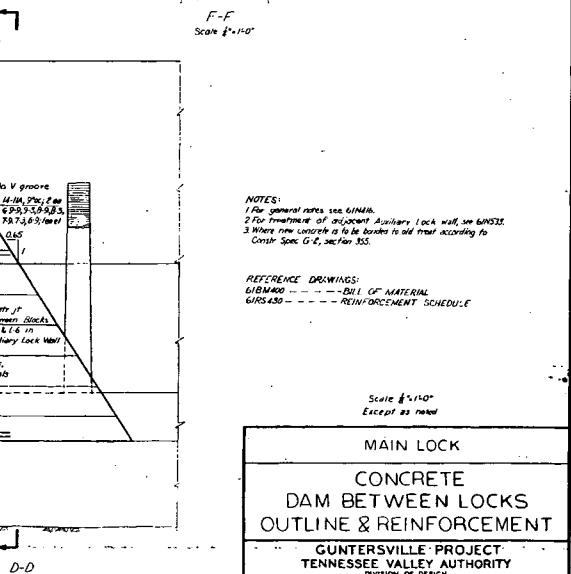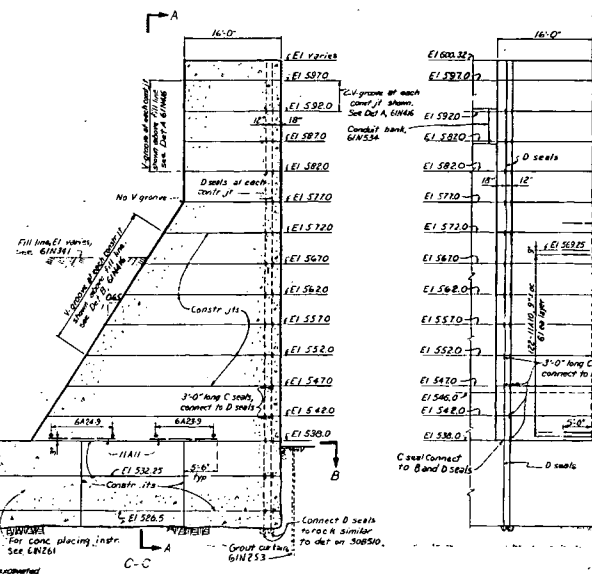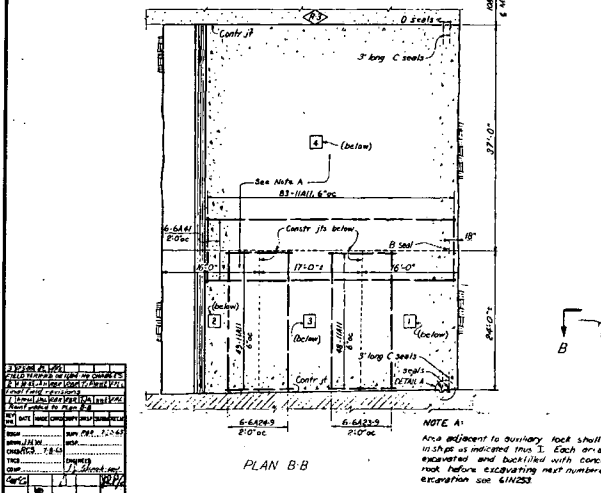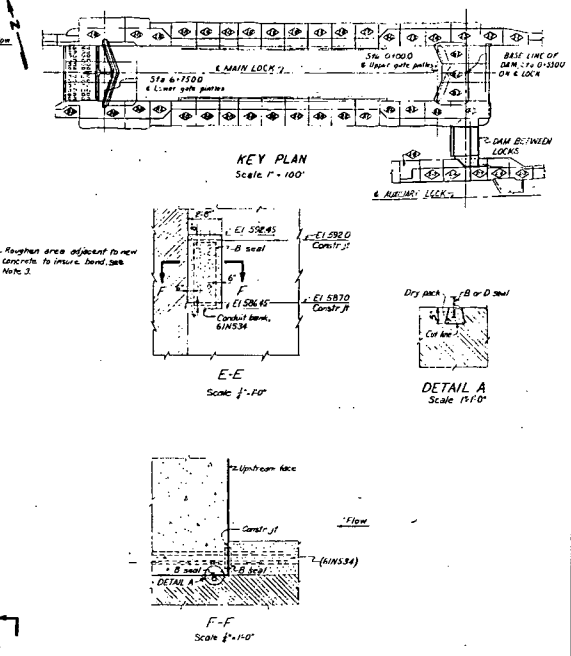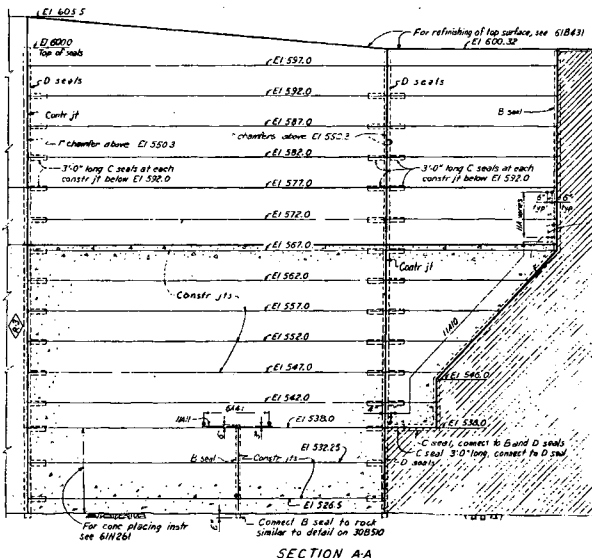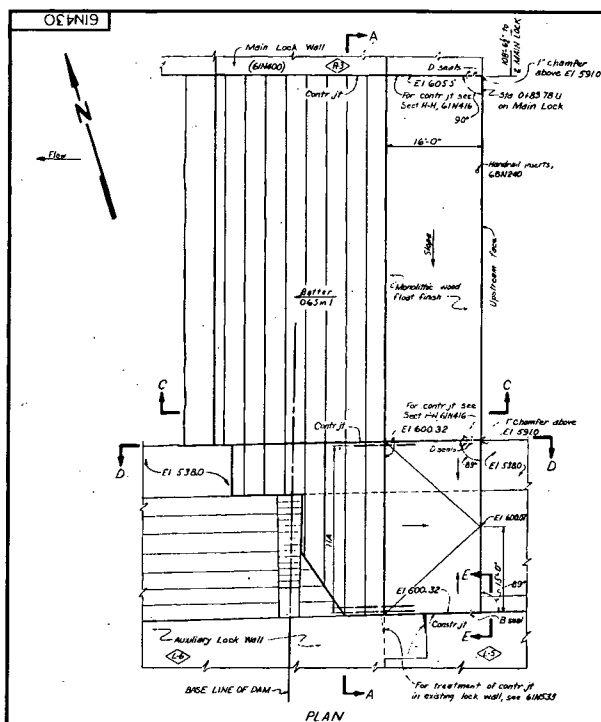

NOTES:  
 3 Where new concrete is to be added to old treat according to Constr. Spec. G-4, section 305.


PREFERENCE DRAWINGS:  

<b>MAIN LOCK</b>			
<b>CONCRETE DAM BETWEEN LOCKS OUTLINE &amp; REINFORCEMENT</b>			
<b>GUNTERSVILLE PROJECT TENNESSEE VALLEY AUTHORITY</b>			
SUBMITTED		RECOMMENDED	
APPROVED		APPROVED	
KNOXVILLE		KNOXVILLE	
8-30-63		6-4-64	
618430		618430	
REVISION		REVISION	

Guntersville Calculation CDQ000020080011  
 Attachment 33

9GZM19 | SQ | 9 | 2 | 3 | 4 | 5 | 6 | 7 | 8 | 9 | 10 | 11 | 12

A  
B  
C  
D  
E  
F  
G  
H

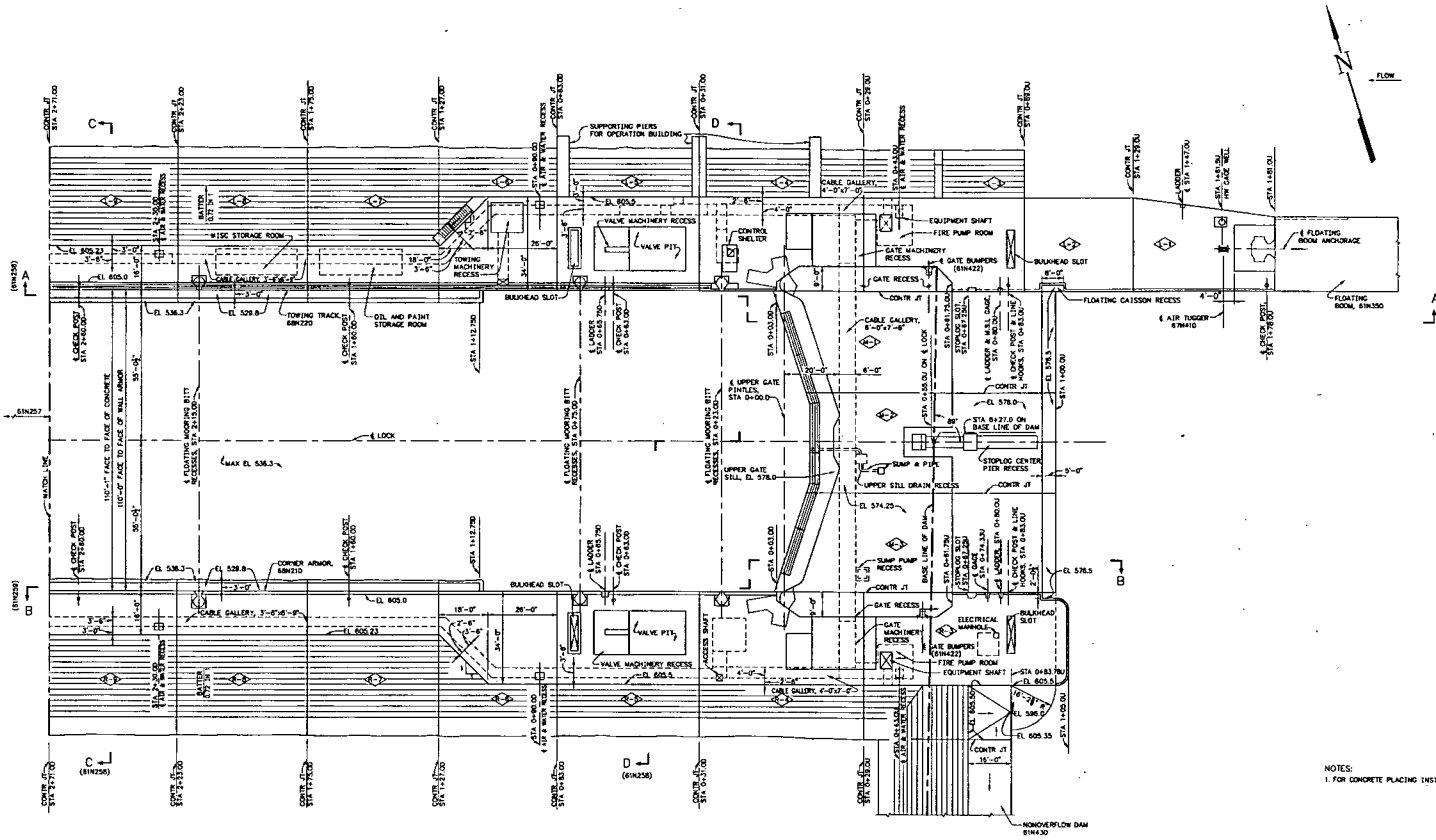

PLAN

Guntersville Calculation CDQ00002008011  
Attachment 34



NOTES:  
1. FOR CONCRETE PLACING INSTRUCTIONS SEE S14261.

EXCEPT AS NOTED											
MAIN LOCK											
CONCRETE											
PLAN-CHAMBER WALLS UPPER END											
STA 1+81.00 TO STA 2+71.00											
DESIGNED BY	DRAWN BY	CHECKED BY	APPROVED BY	DATE	SCALE						
JEP	JEP	HCB	TJA								
GUNTERSVILLE PROJECT											
TENNESSEE VALLEY AUTHORITY											
POSS. AND HYDRO ENGINEERING											
AUTOCAD PLOT	DATE	SCALE	DS	61W256	R 4						




COMPANION DWGS: 61W257, 61W258, 61W259

THIS DRAWING HAS BEEN COMPLETELY REDRAWN AND SUPERSEDES (61W256 - R3)


1 | 2 | 3 | 4 | 5 | 6 | 7 | 8 | 9 | 10 | 11 | 12

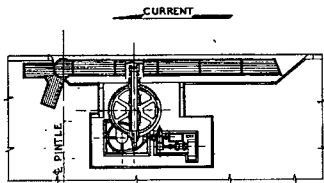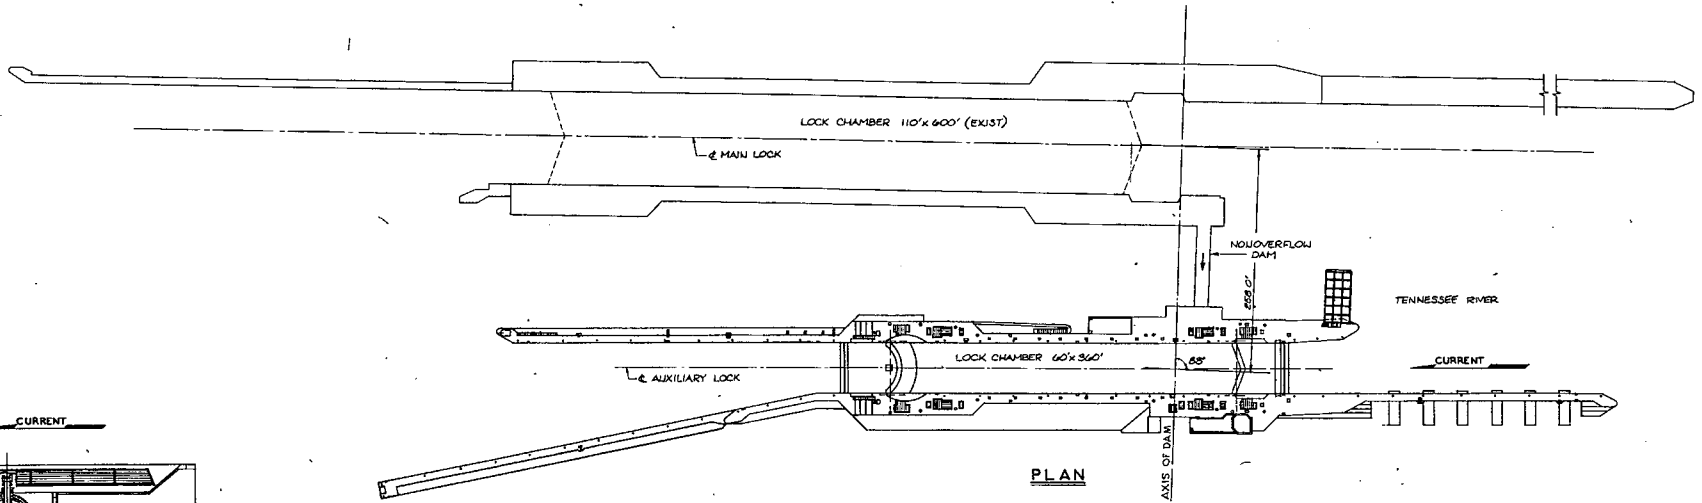

MITER GATE OPERATING MACHINERY  
SCALE: 1/4" = 1'-0"

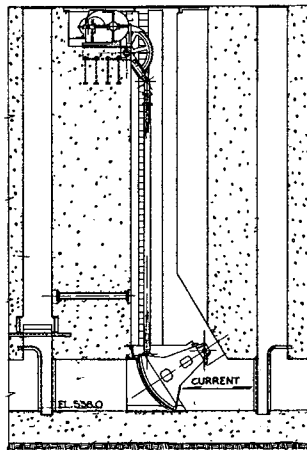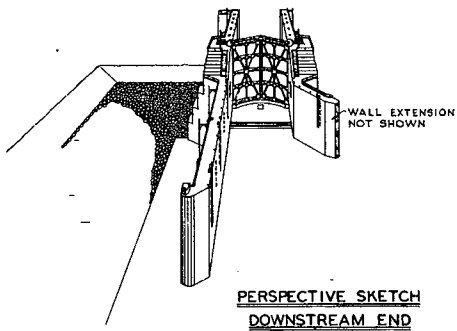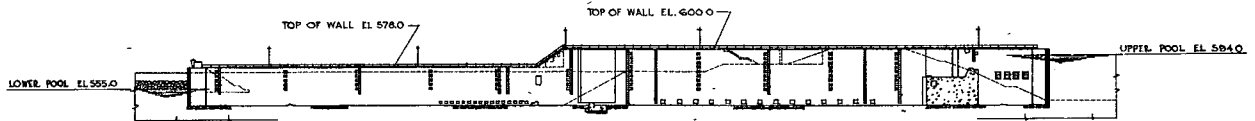

VALVE OPERATING MACHINERY  
SCALE: 1/4" = 1'-0"

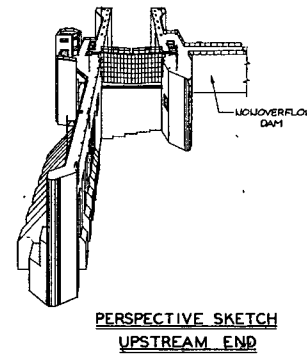

UNITED STATES  
TENNESSEE VALLEY AUTHORITY  
GUNTERSVILLE AUXILIARY LOCK

GENERAL PLAN

0' 30' 0 60' 120'  
SCALE: 1 INCH = 60 FEET



WAR DEPARTMENT CORPS OF ENGINEERS U. S. ARMY SUBMITTED: JULY 28, 1936	UNITED STATES TENNESSEE VALLEY AUTHORITY EXAMINED: <i>R. M. King</i> RECOMMENDED: <i>Amos S. Jones</i>
APPROVED: JULY 28, 1936 <i>C. P. King</i>	APPROVED: <i>Ed. D. King</i>
LT. COL. CORPS OF ENGINEERS NASHVILLE, TENN. DRAWN BY: F. J. M. CHECKED BY: F. P. G.	

NO. 4-54	UPDATED AS-BUILT CONDITIONS (C/89)
NO. 1-22-47	Revised to Conform with Construction Drawings
NO. 1-20-37	Clear Board Wall Revised
BY DATE	CHARACTER
	REVISION


Guntersville Calculation  
CDQ00020080011 Attachment 35






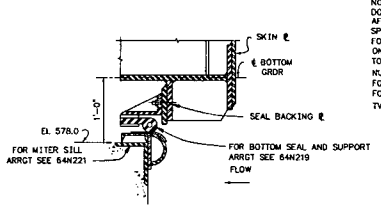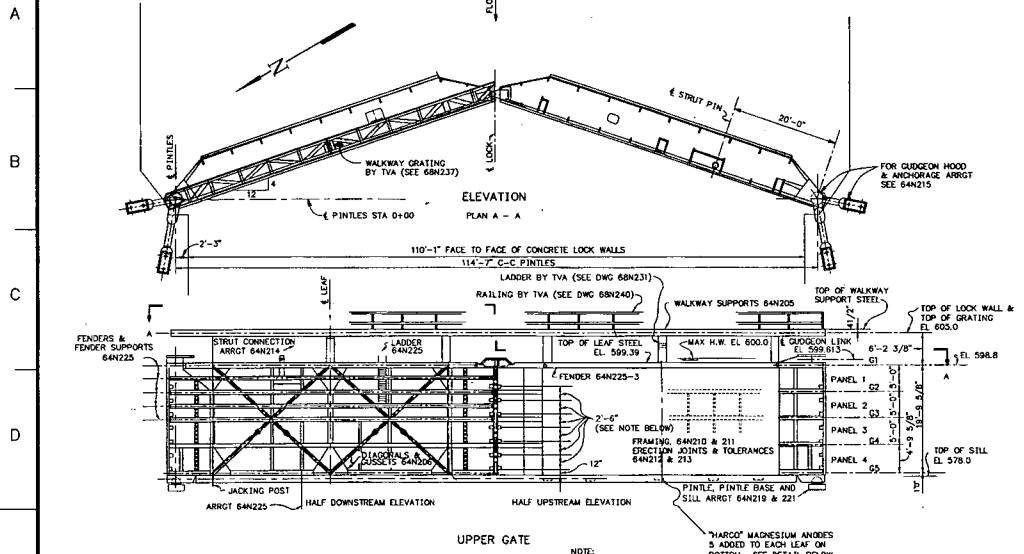

TYPICAL SECTION THRU BOTTOM SEAL  
SCALE 1/2"=1'-0"

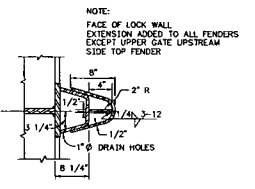

TYPICAL SECTION THRU FENDER  
SCALE 1/2"=1'-0"

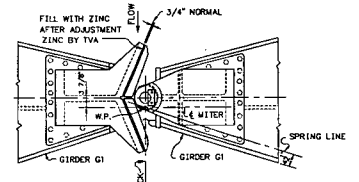


MITERING DEVICE  
FOR DETAILS SEE 64N218  
SCALE 3/4"=1'-0"


NOTE: TYPICAL SPACING FOR BOTH QUONIN AND MITER END OF GATE, UPSTREAM AND DOWNSTREAM FACES

NOTE: "HARCO" MAGNESIUM ANODES 5 ADDED TO EACH LEAF ON BOTTOM. SEE DETAIL BELOW


NOTE: ANODES USED FOR BOTH UPPER AND LOWER GATES ARE THE SAME AS THE ONES USED AT BARKLEY. 75 LBS. ANODES WITH MOUNTING HOLES IN THE CENTER

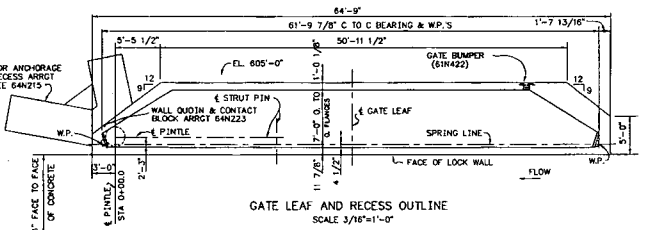


GATE LEAF AND RECESS OUTLINE  
SCALE 3/16"=1'-0"

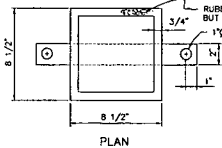

HARCO MAG. ANODES  
SCALE: 3"=1'-0"

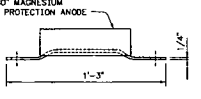

ELEVATION  
SCALE: 1/4"=1'-0"

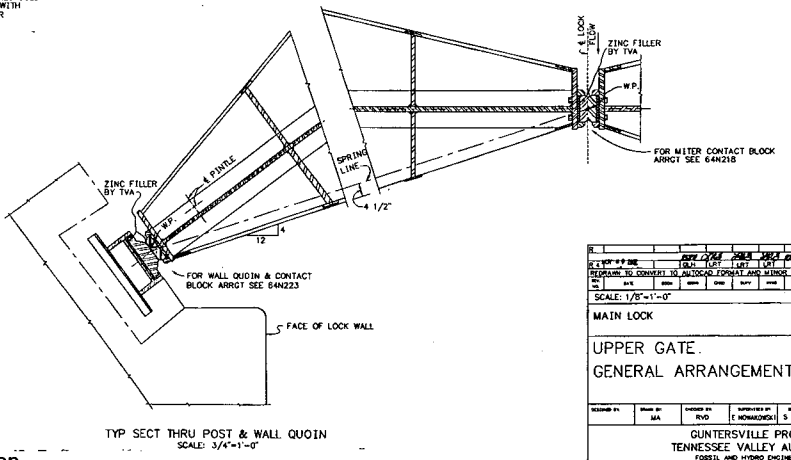

TYP SECT THRU POST & WALL QUONIN  
SCALE: 3/4"=1'-0"

NO.	DATE	BY	CHKD	APP'D	REVISION
SCALE: 1/8"=1'-0" EXCEPT AS NOTED

**MAIN LOCK**


**UPPER GATE.**

**GENERAL ARRANGEMENT**

DESIGNED BY	MA	DRAWN BY	...	CHECKED BY	...	APPROVED BY	...	DATE	10/1/00
GUNTSVILLE PROJECT TENNESSEE VALLEY AUTHORITY FOSSIL AND HYDRO ENGINEERING									
AUTOCAD FILE	64W204	6	64	64W204	R 4				

Guntersville Calculation  
CDQ00020080011 Attachment 38

64WS04-1 M 6 2 3 4 5 6 7 8 9 10 11 12

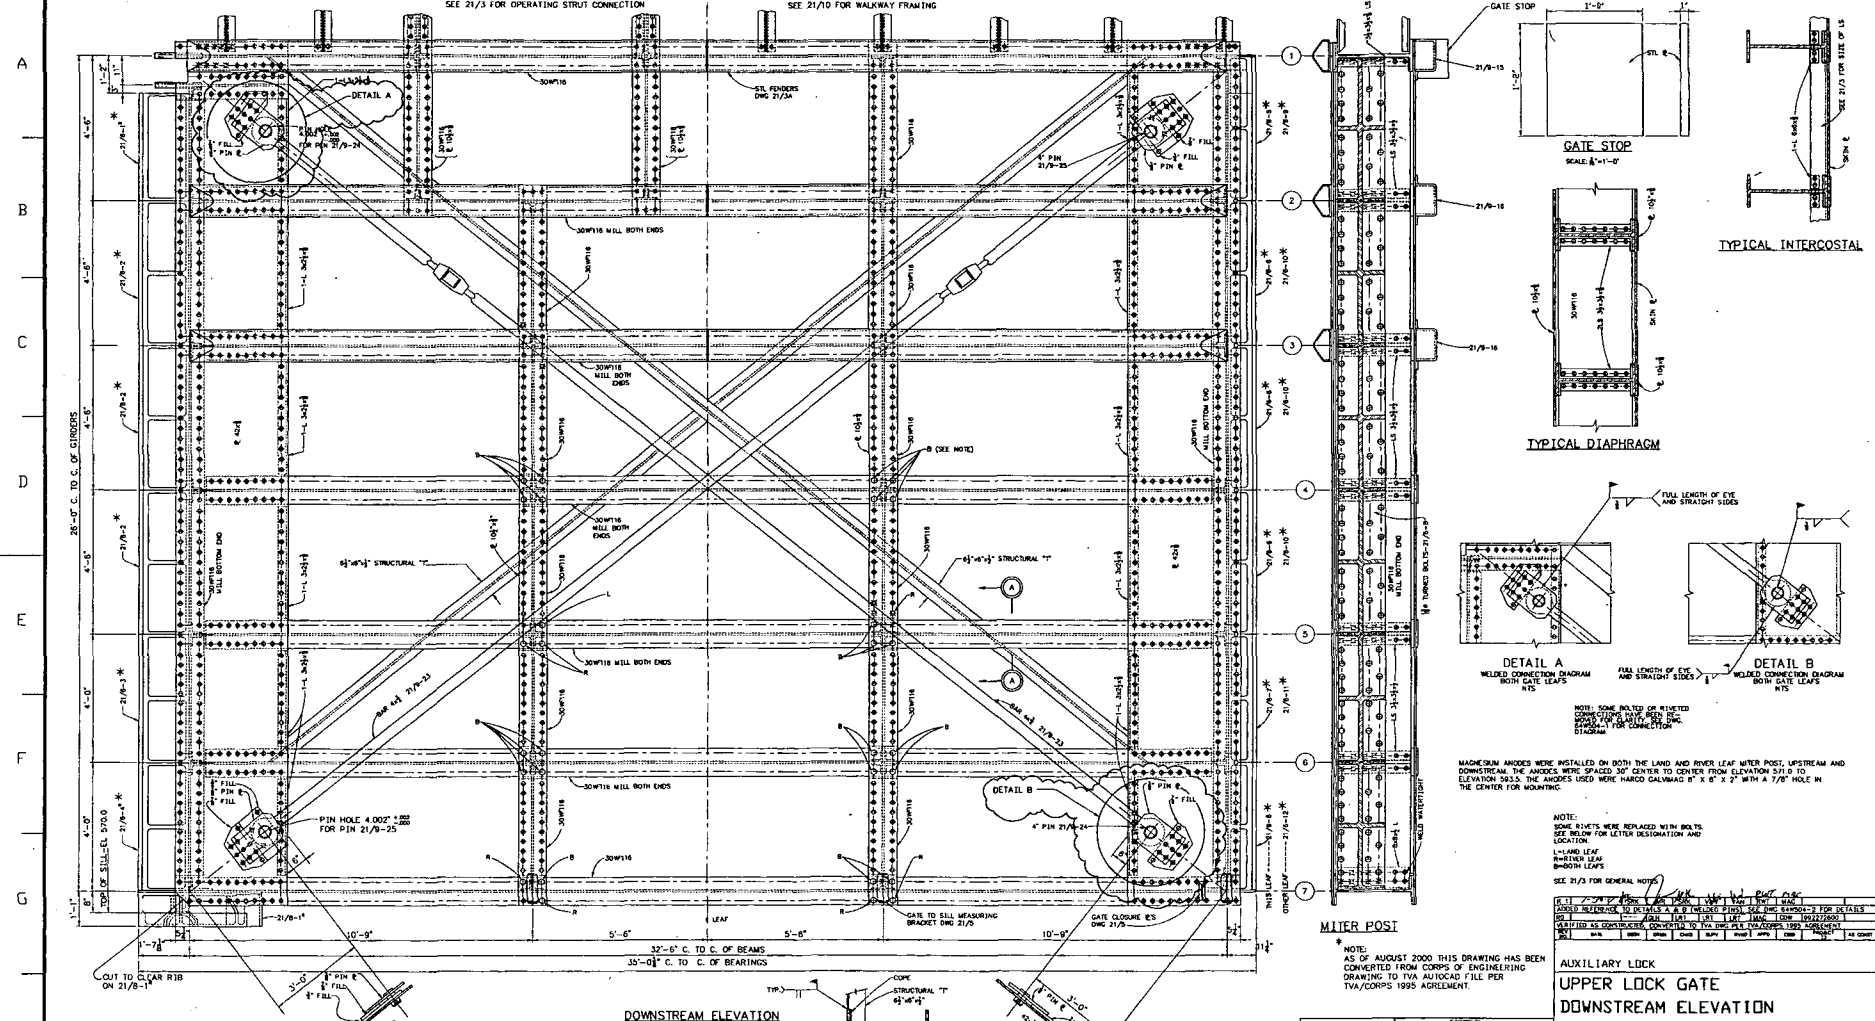

Guntersville Calculation  
CDQ00020080011 Attachment  
39


**AUXILIARY LOCK**  
**UPPER LOCK GATE**  
**DOWNSTREAM ELEVATION**

GUNTSVILLE  
TENNESSEE VALLEY AUTHORITY  
REVER SYSTEMS OPERATIONS

SCALE: 3/4" = 1'-0"

AUTOCAD R14


64WS04-1

PLOT FACTOR: R 1

THIS DRAWING HAS BEEN COMPLETELY REVISIONED AND SUPERSEDES 21/42

DATE COMPLETED BY: REV NO.

C. A. B. DRAWING  
DO NOT ALTER MANUALLY

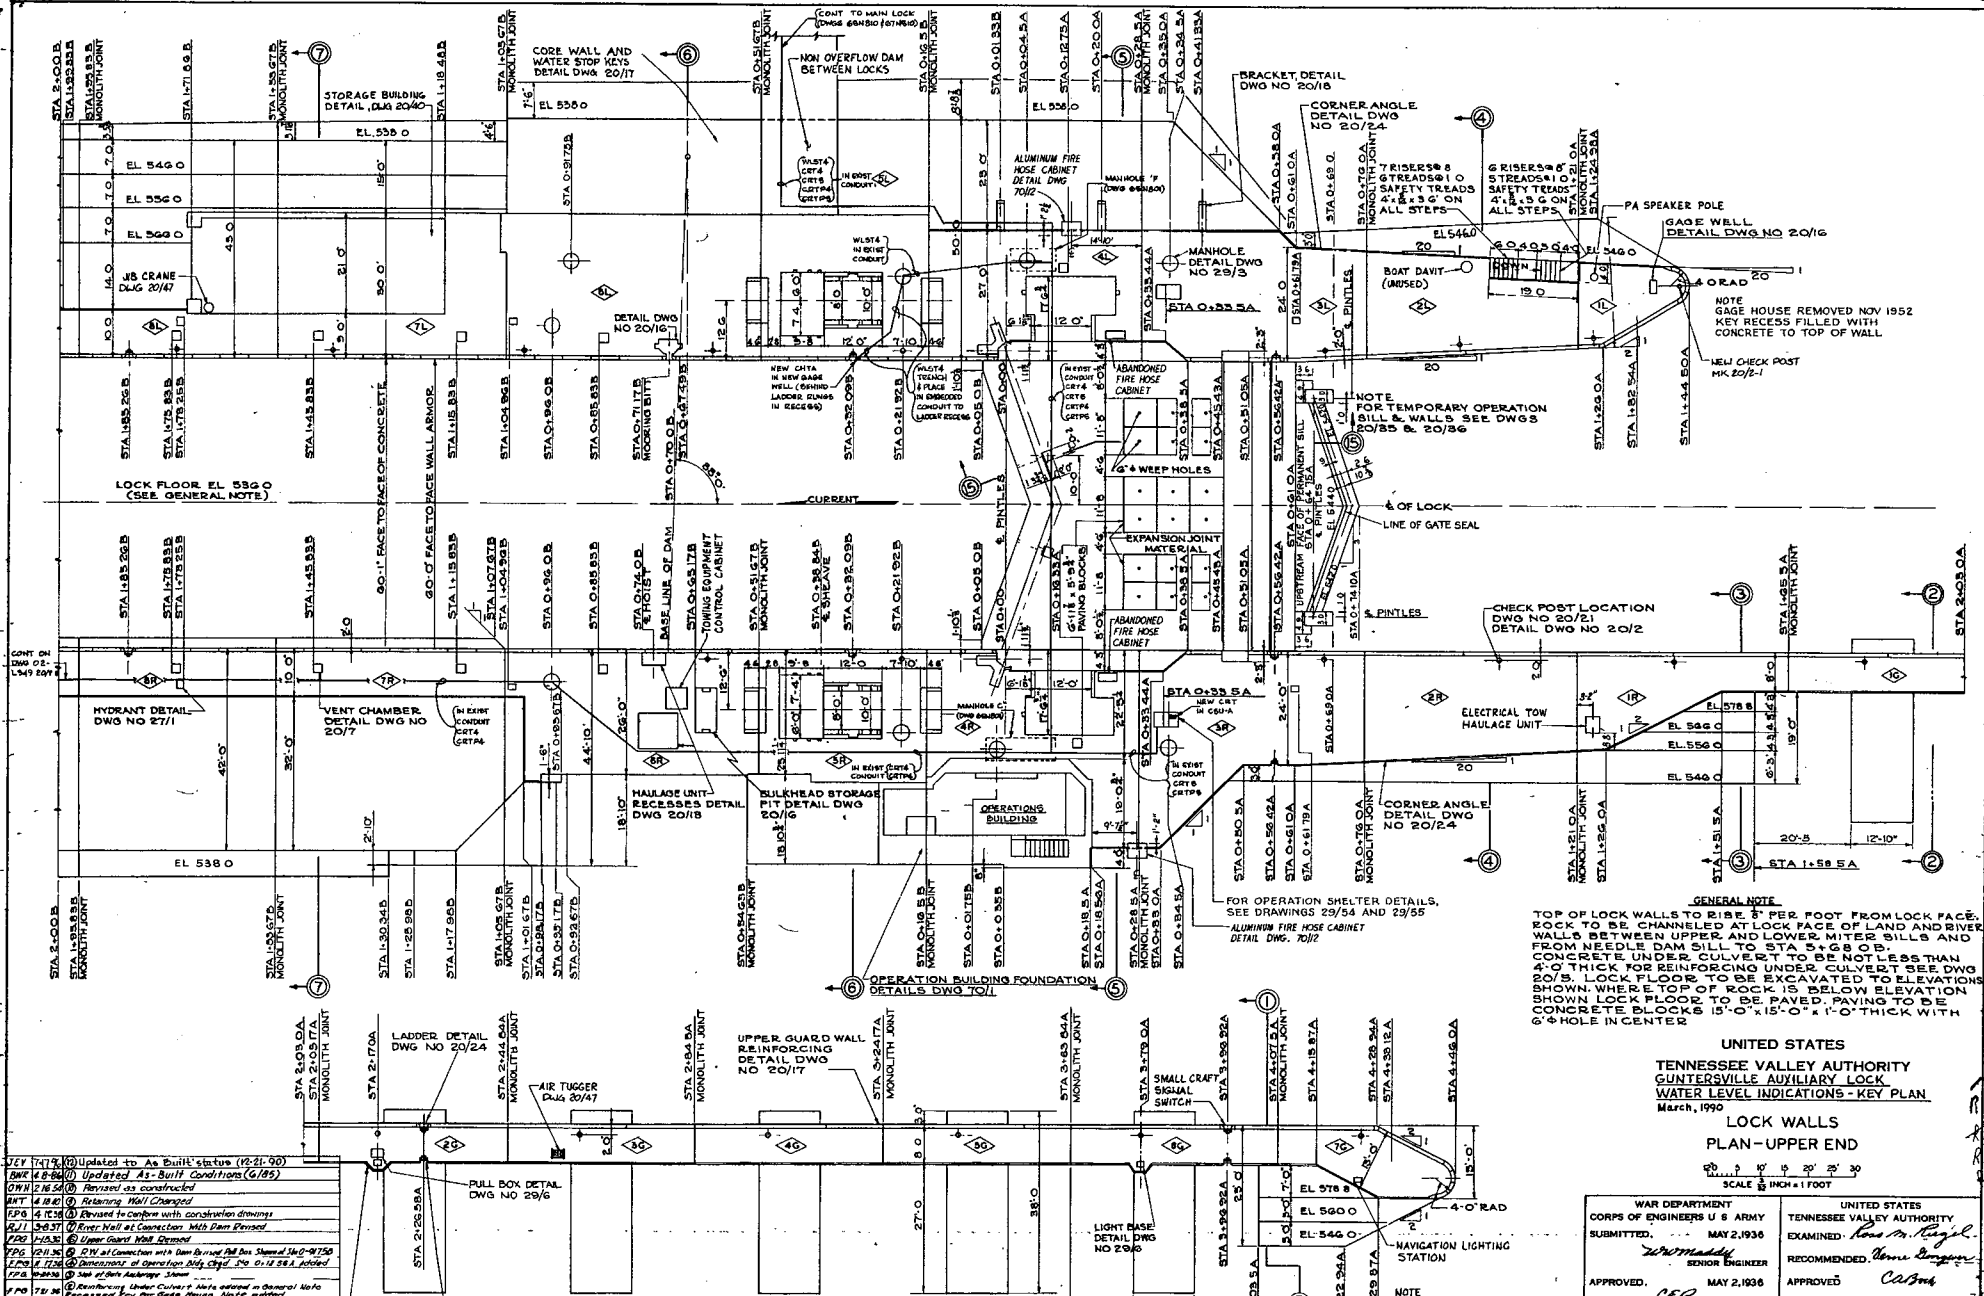

KEY	REVISION
174	Updated to As-Built status (12-21-90)
18-84	Updated As-Built Conditions (6/85)
18-54	Revised as constructed
14-81	Relieving Wall Changes
4-15-80	Revised to conform with construction drawings
1-30-77	Revised Wall at Connection With Dam Period
1-30-77	Upper Guard Wall Revised
12-11-56	Revised in Connection with Dam Revised Pull Box Shaped (12-11-56)
7-21-53	Lock Floor - Sill Drive - Load Wall

Guntersville Calculation  
 CDQ00020080011 Attachment 40

**GENERAL NOTE**  
 TOP OF LOCK WALLS TO RISE 1/2 PER FOOT FROM LOCK FACE. ROCK TO BE CHANNELED AT LOCK FACE OF LAND AND RIVER WALLS BETWEEN UPPER AND LOWER MITER SILLS AND FROM NEEDLE DAM SILL TO STA 5+68.0. CONCRETE UNDER CULVERT TO BE NOT LESS THAN 4'-0" THICK FOR REINFORCING UNDER CULVERT SEE DWG 20/5. LOCK FLOOR TO BE EXCAVATED TO ELEVATIONS SHOWN, WHERE TOP OF ROCK IS BELOW ELEVATION SHOWN LOCK FLOOR TO BE PAVED, PAVING TO BE CONCRETE 15'-0" X 15'-0" X 1'-0" THICK WITH 6" HOLE IN CENTER.



UNITED STATES  
 TENNESSEE VALLEY AUTHORITY  
 GUNTERSVILLE AUXILIARY LOCK  
 WATER LEVEL INDICATIONS - KEY PLAN  

LOCK WALLS  
 PLAN - UPPER END

WAR DEPARTMENT	UNITED STATES
CORPS OF ENGINEERS U S ARMY	TENNESSEE VALLEY AUTHORITY
DRAWN BY F.J.M. CHECKED BY P.P.G.	

20/112



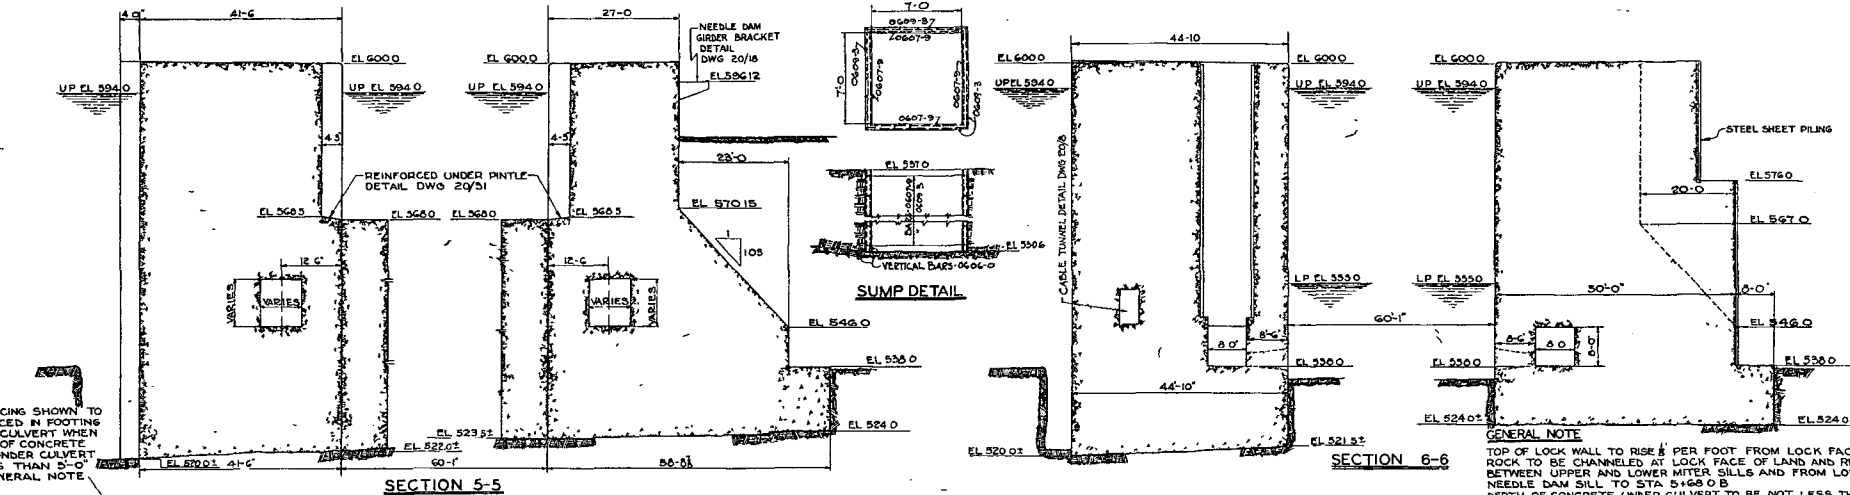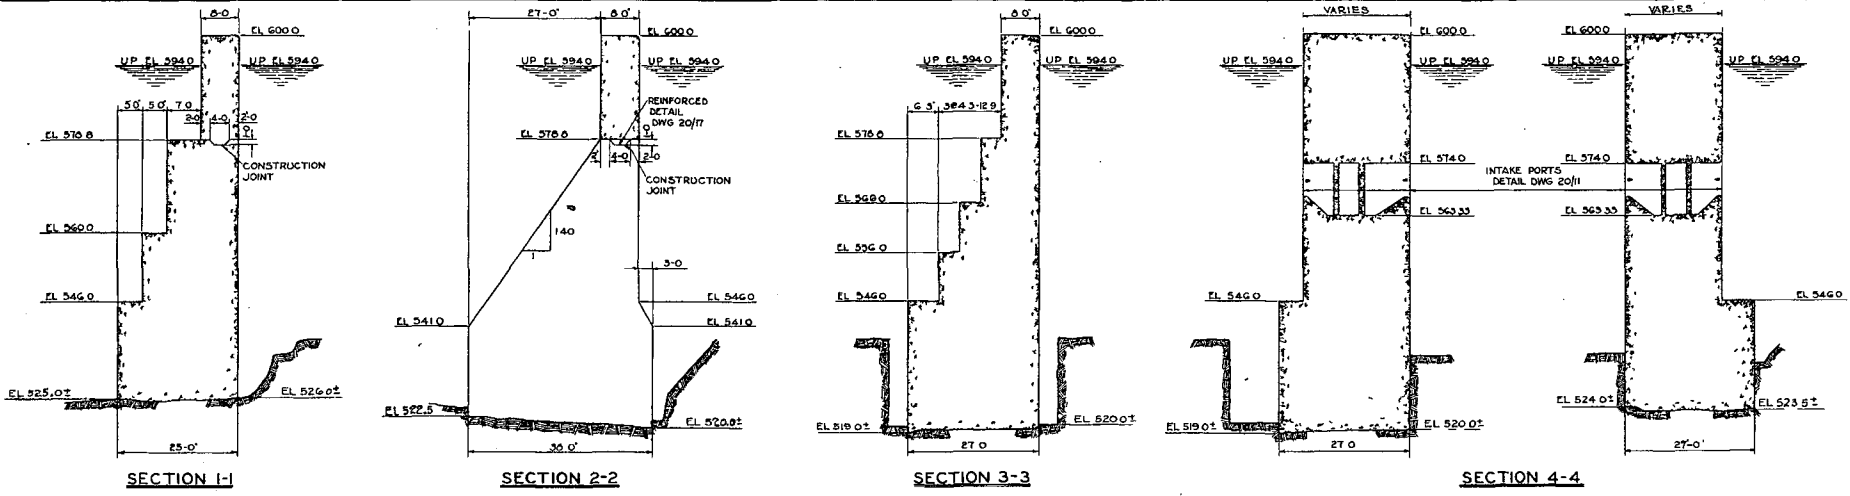

**GENERAL NOTE**  
 TOP OF LOCK WALL TO RISE 1/8" PER FOOT FROM LOCK FACE ROCK TO BE CHANNELLED AT LOCK FACE OF LAND AND RIVER WALL BETWEEN UPPER AND LOWER MITER SILLS AND FROM LOWER NEEDLE DAM SILL TO STA 5+63.0 B. DEPTH OF CONCRETE UNDER CULVERT TO BE NOT LESS THAN 4'-0" WHERE DEPTH OF CONCRETE UNDER CULVERT IS LESS THAN 5'-0" REINFORCING TO BE PLACED AS SHOWN IN TYPICAL REINFORCING UNDER CULVERT DETAIL. ALL WALLS TO BE KEVED NOT LESS THAN 1'-0" INTO SOLID ROCK.

UNITED STATES  
 TENNESSEE VALLEY AUTHORITY  
 GUNTERSVILLE AUXILIARY LOCK

LOCK WALLS  
 SECTIONS  
 10 20 30  
 SCALE: 1/4" = 1' FOOT




WAR DEPARTMENT CORPS OF ENGINEERS U S ARMY SUBMITTED MAY 2, 1936	UNITED STATES TENNESSEE VALLEY AUTHORITY EXAMINED ROSS M. RUGEL RECOMMENDED THOMAS S. BROWN APPROVED MAY 2, 1936
APPROVED C. E. PERRY LT COL. CORPS OF ENGINEERS NASHVILLE, TENN.	APPROVED C. E. PERRY MAY 2, 1936

DRAWN BY C. E. D. CHECKED BY F. P. G.

MARK	SIZE	LENGTH	MAKE	WTEA	BENDING DIAGRAM
W0713-3	13-5	27.45	*		(Diagram)
O713-10	15-0	28.68	*		(Diagram)
D13-6	15-0	6.748	*		(Diagram)
1*	*	*	*	*	BAR-W0713-3

\* TO BE DETERMINED IN FIELD

REINFORCING SHOWN TO BE PLACED IN FOOTING UNDER CULVERT WHEN DEPTH OF CONCRETE UNDER CULVERT IS LESS THAN 5'-0" SEE GENERAL NOTE

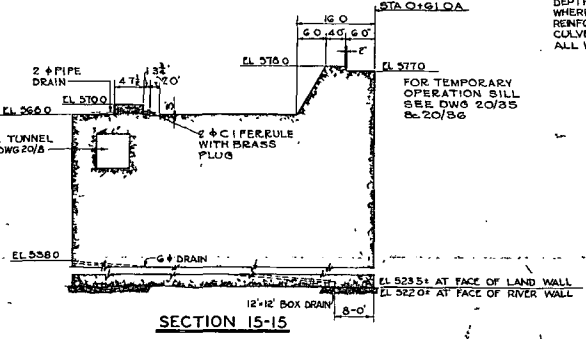
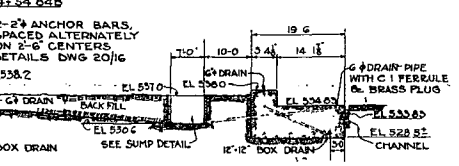
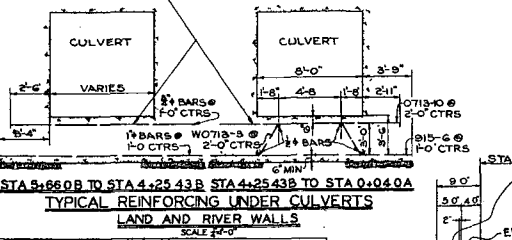


NO.	DATE	CHARACTER	REVISION
1	5/2/36	Revised As Built Conditions	
2	5/2/36	Section 15-15 Revised	
3	5/2/36	Revised To Conform With Construction Drawings	
4	5/2/36	Section 5-5 El Needle Dam Gunter Bracket	
5	5/2/36	Reinforcing Bar W0713-3 To W0713-3	
6	5/2/36	Revised Note & Section Reinforcing Under Culverts Added	
7	5/2/36	Revised Note & Section 14-14 & 15-15	

Guntersville Calculation  
 CDQ000020080011 Attachment 41

SCALE 20/56

1-09ZMZZ 0 9 2 3 4 5 6 7 8 9 10 11 12

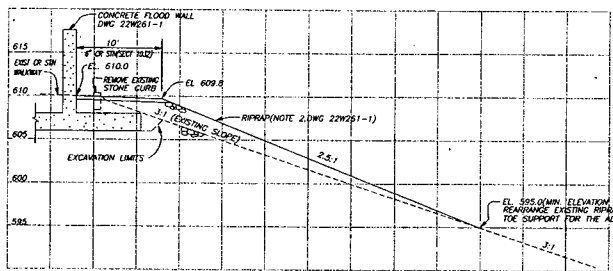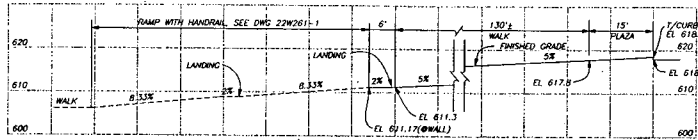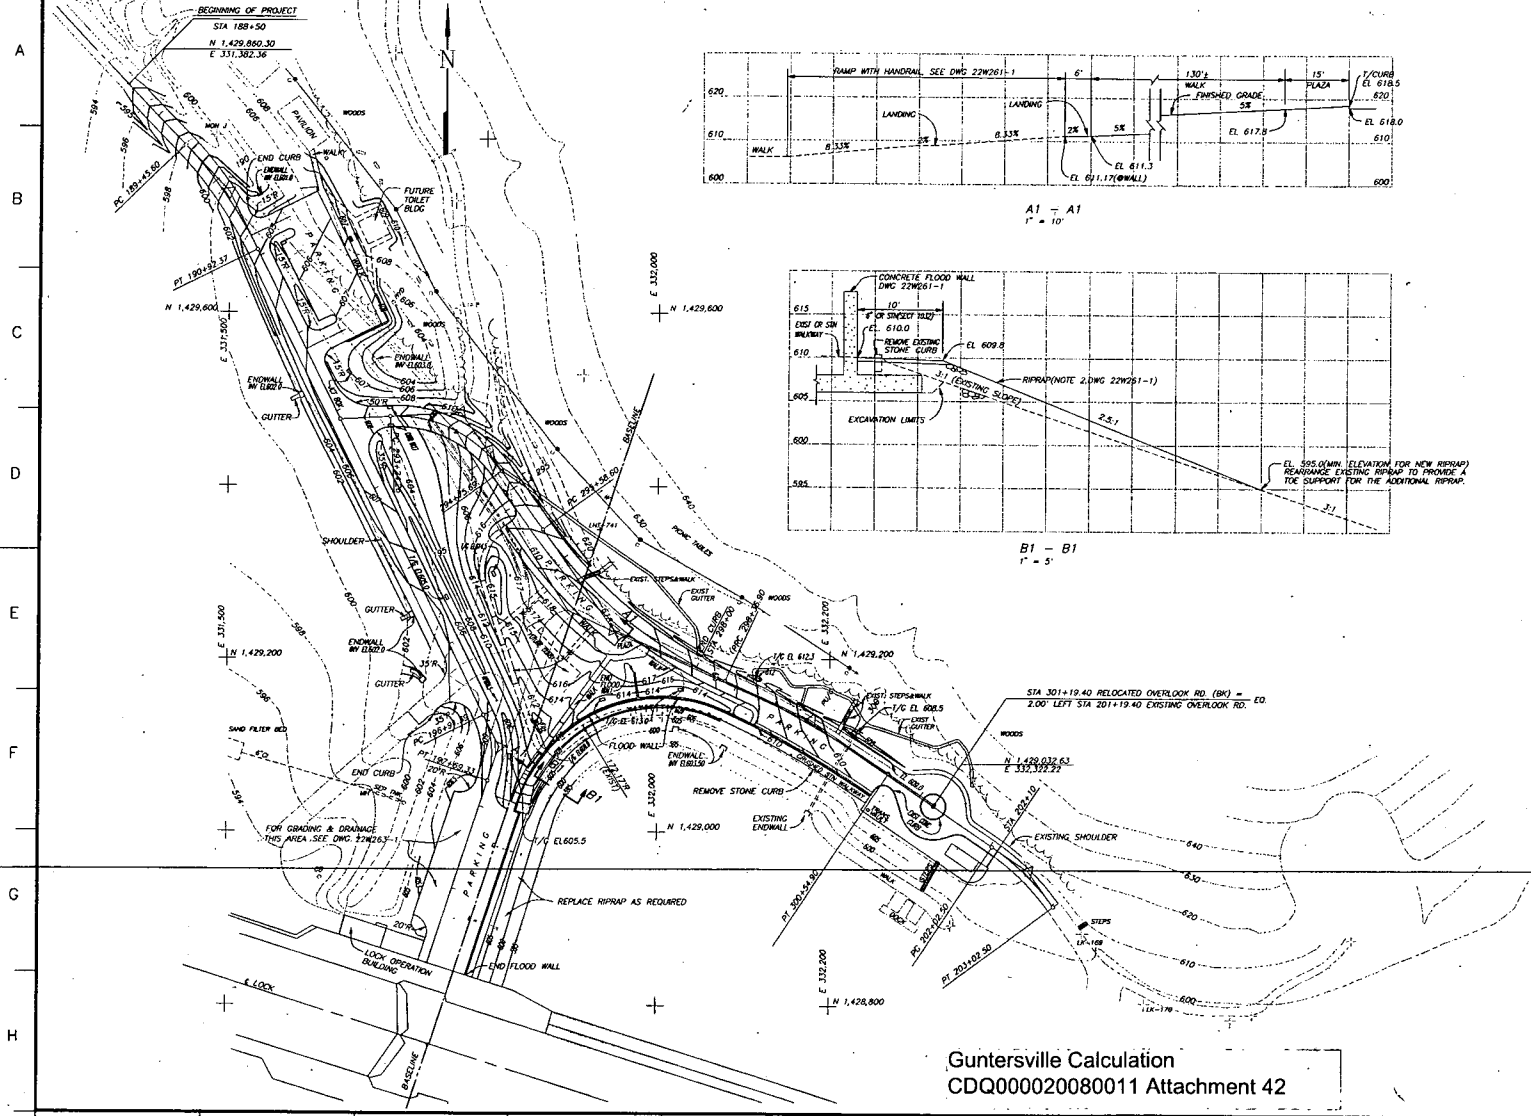

- NOTES:
- FOR GENERAL NOTES SEE DRAWING 22W261-1.
  - ALL WORK SHALL BE DONE IN ACCORDANCE WITH GENERAL CONSTRUCTION SPECIFICATION NO. T-1 UNLESS OTHERWISE NOTED. ALL SECTION NUMBERS REFER DIRECTLY TO THE T-1 SPECIFICATION.
  - FOUNDATION PREPARATION FOR ALL EMBANKMENTS SHALL CONSIST OF REACHING ORGANIC TOPSOIL TO A DEPTH THAT WILL REMOVE ALL ROOTS AND EXCAVATION SHALL CONTINUE TO A DEPTH THAT WILL OBTAIN A FOUNDATION THAT WILL SUPPORT EARTHMOVING EQUIPMENT WITHOUT PUTTING INTO THE GROUND AND HEAVING THE GROUND SO AS TO REDUCE ITS STABILITY. CLEARING AND GRUBBING SHALL BE IN ACCORDANCE WITH SECTION 101.
  - AT THE BEGINNING OF GRADING OPERATIONS, ALL TOPSOIL SUITABLE FOR USE IN ESTABLISHING VEGETATION IN FINISHED AREAS SHALL BE STOCKPILED FOR FUTURE USE.
  - EARTH BORROW IS TO BE OBTAINED FROM THE DESIGNATED BORROW AREA OR FROM AN OFFSITE BORROW PIT APPROVED BY THE ENGINEER.
  - CLASS "A" EARTHFILL, CAREFULLY CONTROLLED FILL, SHALL BE PLACED IN 8 INCH THICK LAYERS IN ACCORDANCE WITH SECTION 100. EACH LAYER SHALL BE COMPACTED TO AT LEAST 95% OF MAXIMUM DRY DENSITY AS DETERMINED BY ASTM D698. MOISTURE CONTENT SHALL BE BETWEEN 2% BELOW AND 3% ABOVE OPTIMUM MOISTURE CONTENT. IN-PLACE DENSITY TESTS USING THE SAND CONE (ASTM D1556) OR RUBBER BALLOON (ASTM D2937) TEST METHODS SHALL BE CONDUCTED AT A RATE OF AT LEAST ONE TEST PER EACH 2000 CY OF BACKFILL PLACED ON A MINIMUM OF ONE PER DAY THAT FILL IS PLACED. IF NUCLEAR DENSITY METHODS ARE USED (ASTM D2922), SUFFICIENT NUMBERS OF THE SAND CONE OR RUBBER BALLOON TEST WILL BE REQUIRED TO CORRELATE AND VERIFY THE NUCLEAR GAUGE RESULTS.
  - CLASS "B" EARTHFILL COMMON FILL, SHALL BE UNCLASSIFIED MATERIAL AND SHALL BE PLACED IN APPROXIMATELY 12 INCH LAYERS AND COMPACTED WITH HAULING EQUIPMENT.
  - PROFILE GRADE REPRESENTS FINISHED GRADE ELEVATION ON CENTER-LINE ALIGNMENT.
  - DASHED CONTOURS INDICATE EXISTING GROUND. SOLID CONTOURS INDICATE FINISHED GRADING AND PAVING.
  - SEEDING SHALL BE TYPE 1, MIXTURE 2 REBEL FESCUE SPREAD AT A RATE OF 100 LBS PER ACRE.
  - FERTILIZING, LIMING, AND SEEDING SHALL BE IN ACCORDANCE WITH SECTION 580. MULCHING SHALL BE IN ACCORDANCE WITH SECTION 582.


Guntersville Calculation  
CDQ000020080011 Attachment 42

GUNTERSVILLE PROJECT											
TENNESSEE VALLEY AUTHORITY											
FLOOD AND HYDRO ENGINEERING											
AUTOCAD R12											
PLOT FACTOR: 1											


TASK COMPLETED BY: REV NO. C.A.D. DRAWING DO NOT ALTER MANUALLY




9-19ZMZZ C 9 2 3 4 5 6 7 8 9 10 11 12

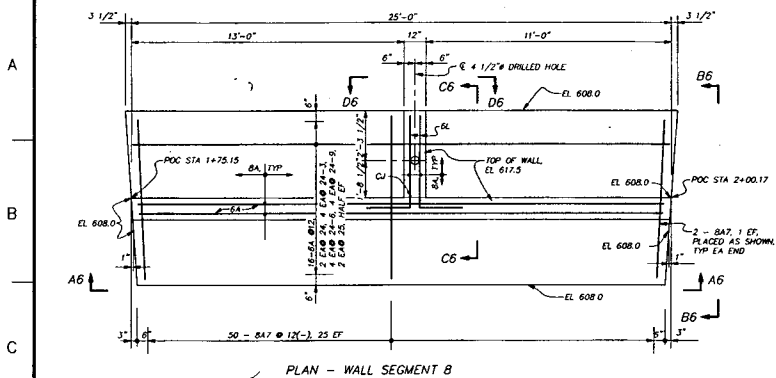


PLAN - WALL SEGMENT B

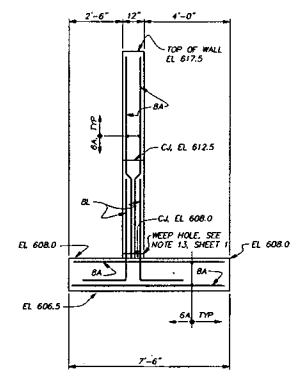


B6 - B6

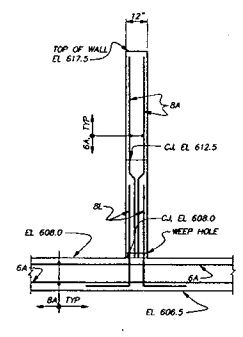

D6 - D6

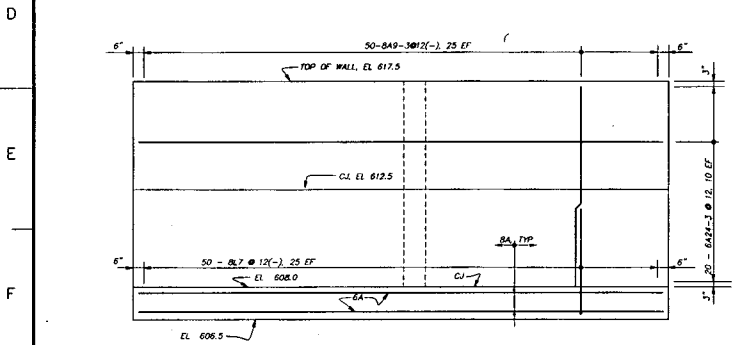

A6 - A6

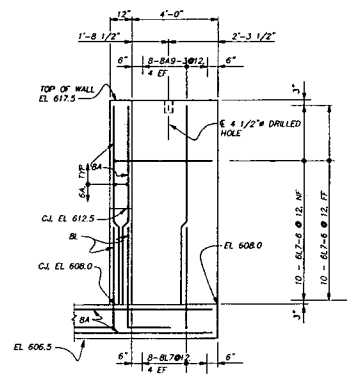

C6 - C6

BENT BAR LIST									
BAR MARK	NO. REOD	BENDING DIMENSIONS							
		a	b	c	d	e	f	g	
KL7-6	20	5-0	EX						
KL7	58	2-0	EX						

STRAIGHT BAR LIST									
BAR SIZE	BAR LENGTH	NO. REOD	BAR SIZE	BAR LENGTH	NO. REOD	BAR SIZE	BAR LENGTH	NO. REOD	BAR SIZE
	24-3	24		9-3	58				
	24-6	4							
	24-9	4							
	25-0	2							

NOTES:  
1. FOR LIST SEE 22W261-1.

PROJECT REVISION HISTORY									
NO.	DATE	BY	REASON	APPROVED BY	DATE	NO.	DATE	BY	REASON
01	13-11-95	GAH	ISSUE	GAH	11/13/95	01			

DESIGNED AS CONSTRUCTED

DESIGNER: [ ] DRAWN BY: [ ] CHECKED BY: [ ] SUPERSEDED BY: [ ] REVIEWED BY: [ ] APPROVED BY: [ ] ISSUED BY: [ ]

DATE: [ ]

SCALE: 1/2" = 1'-0" EXCEPT AS NOTED

NORTH EMBANKMENT  
DAM SAFETY MODIFICATIONS




CONCRETE  
FLOOD WALLS  
PLAN, SECTIONS & DETAILS

DESIGNED BY: [ ] DRAWN BY: [ ] CHECKED BY: [ ] SUPERSEDED BY: [ ] REVIEWED BY: [ ] APPROVED BY: [ ] ISSUED BY: [ ]

GUNTERVILLE PROJECT  
TENNESSEE VALLEY AUTHORITY  
TOSSE, AND ASSOCIATES, INC.

AUTOCAD R12 DATE: 8-7-98 6 | C | 22W261-6 R 2

Guntersville Calculation  
CDQ00020080011 Attachment 44

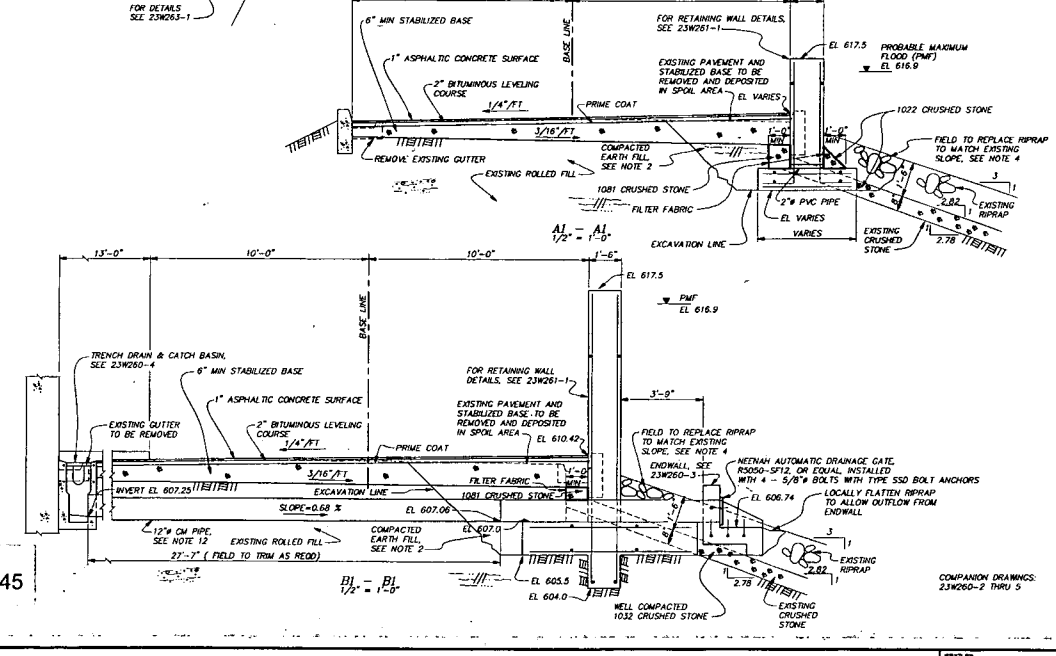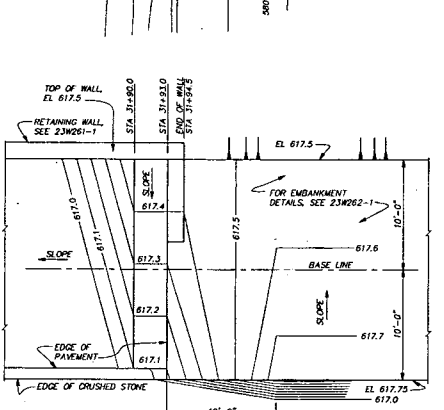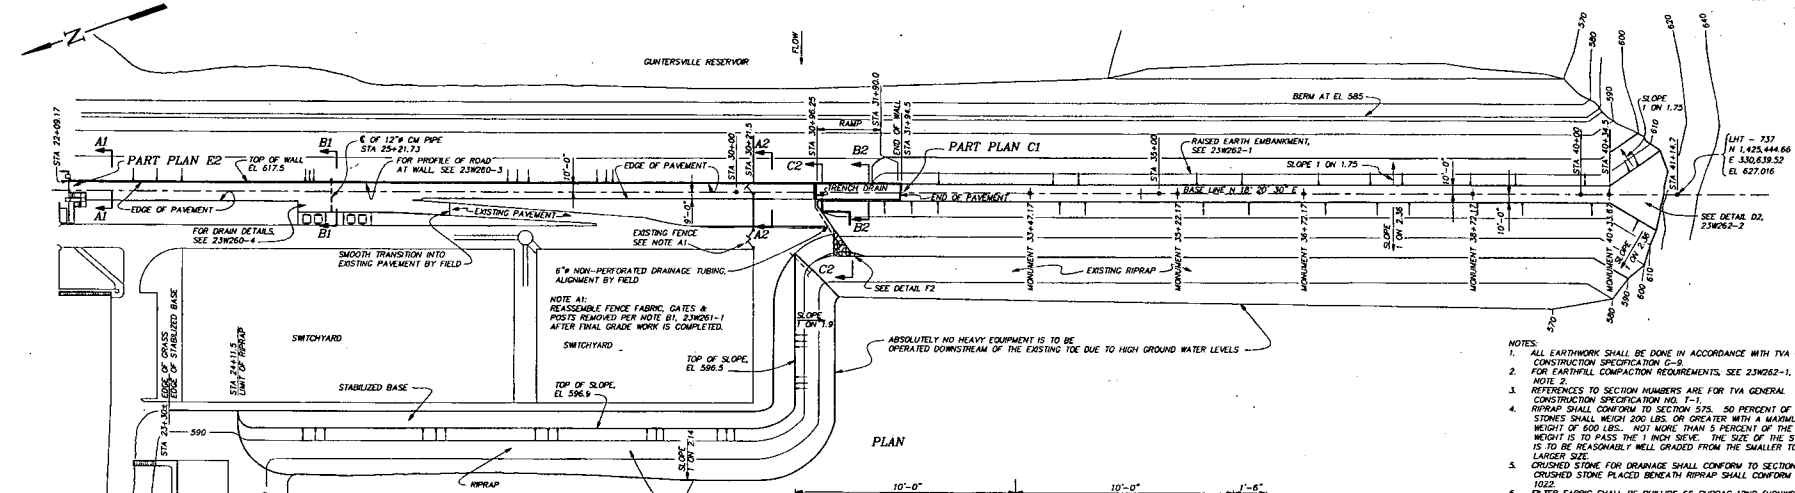

- NOTES:
1. ALL EARTHWORK SHALL BE DONE IN ACCORDANCE WITH TVA GENERAL CONSTRUCTION SPECIFICATION C-9.
  2. FOR EARTHFILL COMPACTION REQUIREMENTS, SEE 23W262-1, GENERAL NOTE 2.
  3. REFERENCES TO SECTION NUMBERS ARE FOR TVA GENERAL CONSTRUCTION SPECIFICATION NO. 1-1.
  4. RRAPR SHALL CONFORM TO SECTION 575. 50 PERCENT OF THE STONES SHALL WEIGH 200 LBS. OR GREATER WITH A MAXIMUM STONE HEIGHT OF 600 LBS. NOT MORE THAN 5 PERCENT OF THE STONES BY WEIGHT IS TO PASS THE 1 INCH SEIVE. THE SIZE OF THE STONES IS TO BE REASONABLY WELL GRADED FROM THE SMALLER TO THE LARGER SIZE.
  5. CRUSHED STONE FOR DRAINAGE SHALL CONFORM TO SECTION 1001. CRUSHED STONE PLACED BENEATH RRAPR SHALL CONFORM TO SECTION 1022.
  6. FILTER FABRIC SHALL BE PHILLIPS 66 SURFAC 12MP (NONWEAVE) OR EQUAL. FABRIC IS TO BE PLACED IN ACCORDANCE WITH SECTION 571. MINIMUM OVERLAP TO BE 18 INCHES. DAMAGED MATERIAL TO BE REPAIRED BY PLACING A PIECE OF MATERIAL OVER THE DAMAGED AREA LARGE ENOUGH TO COVER THE DAMAGED AREA AND MEETING THE OVERLAP REQUIREMENT.
  7. CONCRETE SHALL BE PLACED IN ACCORDANCE WITH TVA GENERAL CONSTRUCTION SPECIFICATION C-2. CONCRETE SHALL BE IN ACCORDANCE WITH TVA STANDARD READY-MIX SPECIFICATION 26.037, CLASS 300.75 AFM. MAXIMUM PLACING TEMPERATURE OF CONCRETE SHALL BE 85 DEGREES FAHRENHEIT.
  8. FORMWORK SHALL BE IN ACCORDANCE WITH TVA GENERAL CONSTRUCTION SPECIFICATION C-6. ALL SURFACES ABOVE FINAL GRADE SHALL HAVE SMOOTH FORM FINISH.
  9. CHAMFER ALL EXPOSED CONCRETE EDGES 3/4" UNLESS OTHERWISE NOTED.
  10. ALL REINFORCEMENT SHALL CONFORM TO ASTM SPECIFICATION A-615, GRADE 60.
  11. CLEAR COVER FOR REINFORCEMENT SHALL BE 1" UNLESS OTHERWISE NOTED. ALL OTHER DIMENSIONS ARE TO CENTERLINE OF REINFORCEMENT.
  12. CORRUGATED METAL PIPE SHALL BE 14 GA CONFORMING TO SECTION 1271. EXCAVATION AND PLACEMENT OF PIPES ARE TO BE DONE IN STAGES SO THAT AT NO TIME IS AN EXCAVATED AREA OPEN ACROSS THE ENTIRE CREST OF THE DAM.
  13. NON-PERFORATED DRAINAGE TUBING SHALL CONFORM TO AASHTO M252.
  14. PAVEMENT MATERIALS SHALL CONFORM TO SECTION 225 FOR STABILIZED BASE, SECTION 300 FOR PRIME COAT, SECTION 335 FOR BITUMINOUS LEVELING COURSE AND SECTION 345 FOR ASPHALTIC CONCRETE. FOR DESIGN CALCULATIONS AND FIELD INFORMATION SEE RWS NUMBER 865 831006 001.

PROJECT REVISION HISTORY

NO.	DATE	DESCRIPTION
1	12-21-83	ISSUED FOR CONSTRUCTION

SCALE: 1" = 100'

EXCEPT AS NOTED


**SOUTH EMBANKMENT DAM SAFETY MODIFICATIONS FINISHED GRADE PLANS, SECTIONS AND DETAILS**

Guntersville Project  
TENNESSEE VALLEY AUTHORITY


DESIGN	DISCIPLINE	INTERFACE	ENGINEERING APPROVAL
DESIGNED BY: J. H. COUSON	1	2	
CHECKED BY: V. A. NEMEL	3	4	C. D. WACHER
DATE: 12-21-83	6	C-23W260-1	R-2

Guntersville Calculation  
CDQ000020080011 Attachment 45

COMPANION DRAWINGS:  
23W260-2 THRU 5

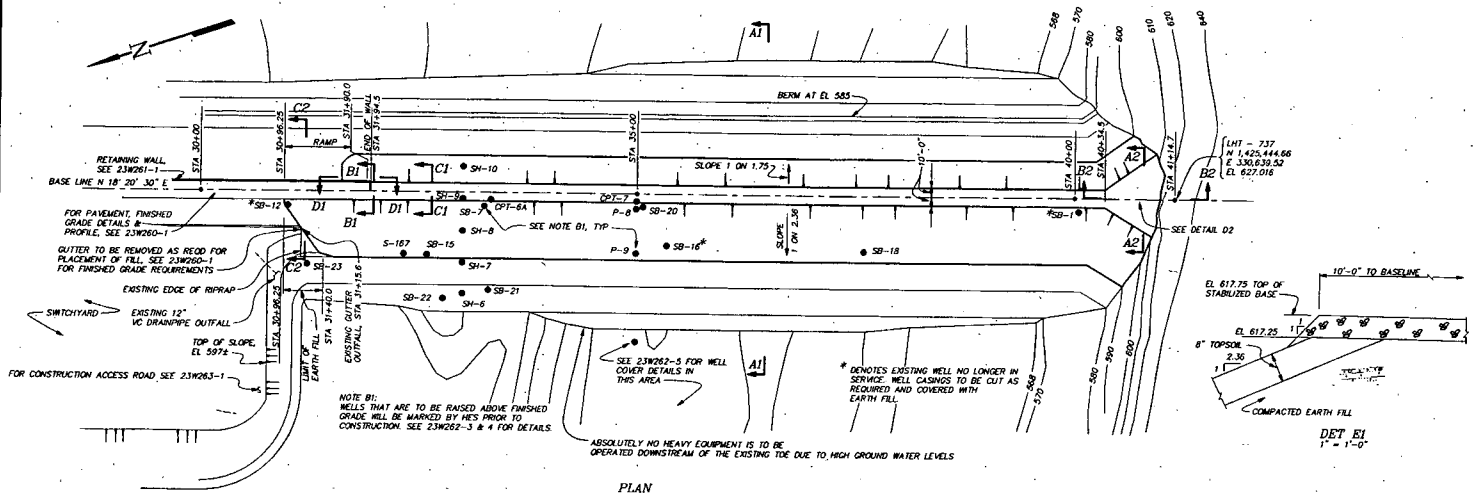

- NOTES:
1. ALL EARTHWORK SHALL BE DONE IN ACCORDANCE WITH TVA GENERAL CONSTRUCTION SPECIFICATION 6-9.
  2. EARTHFILL MATERIAL IS TO BE OBTAINED FROM AN OFF-SITE BORROW AREA APPROVED BY THE ENGINEER. EARTHFILL SHALL BE PLACED IN LAYERS OF APPROXIMATELY 8 INCHES. EACH LAYER SHALL BE COMPACTED TO AT LEAST 95% OF MAXIMUM DRY DENSITY AS DETERMINED BY ASTM D998. MOISTURE CONTENT SHALL BE WITHIN 3% ABOVE OR BELOW THE OPTIMUM MOISTURE CONTENT. IN-PLACE DENSITY TESTS USING THE SAND CONE (ASTM D1556) OR RUBBER BALLOON (ASTM D 2167) TEST METHODS SHALL BE CONDUCTED AT A RATE OF AT LEAST ONE TEST PER EACH 2000 CY OF EARTHFILL PLACED OR A MINIMUM OF ONE PER DAY THAT EARTHFILL IS PLACED. IF NUCLEAR DENSITY METHODS ARE USED (ASTM D2922), SUFFICIENT NUMBERS OF THE SAND CONE OR RUBBER BALLOON TESTS WILL BE REQUIRED TO CORRELATE AND VERIFY THE NUCLEAR GAUGE RESULTS. REFERENCES TO SECTION NUMBERS ARE FOR TVA GENERAL CONSTRUCTION SPECIFICATION NO. 7-1.
  3. RIPRAP SHALL CONFORM TO SECTION 574. 50 PERCENT OF THE STONES SHALL WEIGH 200 LBS. OR GREATER WITH A MAXIMUM STONE WEIGHT OF 600 LBS. NOT MORE THAN 5 PERCENT OF THE STONES BY WEIGHT IS TO PASS THE 1 INCH SIEVE. THE SIZE OF THE STONES IS TO BE REASURABLE WELL GRADED FROM THE SMALLER TO THE LARGER SIZE.
  4. CRUSHED STONE FOR DRAINAGE SHALL CONFORM TO SECTION 1081. CRUSHED STONE PLACED BENEATH RIPRAP SHALL CONFORM TO SECTION 1022.
  5. FILTER FABRIC SHALL BE PHILLIPS 66 SURPAC 12NP (NONWOVEN) OR EQUAL. FABRIC IS TO BE PLACED IN ACCORDANCE WITH SECTION 571. MINIMUM OVERLAP TO BE 18 INCHES. DAMAGED MATERIAL TO BE REPAIRED BY PLACING A PIECE OF MATERIAL OVER THE DAMAGED AREA LARGE ENOUGH TO COVER THE DAMAGED AREA AND MEETING THE OVERLAP REQUIREMENT.
  6. STABILIZED BASE TO CONSIST OF CRUSHED STONE CONFORMING TO SECTION 1032. PLACED IN ACCORDANCE WITH SECTION 225.
  7. CONCRETE USED TO FILL HOLES IN EXISTING ROCK IN THE SOUTH ABUTMENT SHALL BE PLACED IN ACCORDANCE WITH TVA GENERAL CONSTRUCTION SPECIFICATION G-2. EXISTING EARTH IS TO BE REMOVED TO EXPOSE ROCK. ALL LOOSE ROCK IS TO BE REMOVED. CREVICES ARE TO BE CLEANED TO A DEPTH OF TWICE THEIR WIDTH OR, AS DEEMED AS PRACTICAL, NOTIFY HYDRO ENGINEERING SERVICES. CIVIL ENGINEERING SECTION FOR INSPECTION OF ROCK SURFACE PRIOR TO PLACEMENT OF CONCRETE. CONCRETE SHALL BE IN ACCORDANCE WITH TVA STANDARD READY-MIX SPECIFICATION 26.037, CLASS 30075 AFM, MAXIMUM PLACING TEMPERATURE OF CONCRETE SHALL BE 85 DEGREES FAHRENHEIT. MINIMUM THICKNESS OF CONCRETE TO BE 12 INCHES.
  8. FORMWORK SHALL BE IN ACCORDANCE WITH TVA GENERAL CONSTRUCTION SPECIFICATION G-8.
  9. RIPRAP EXCAVATED FROM THE UPSTREAM FACE OF THE DAM SHALL BE STOCKPILED AND SAVED FOR REUSE.
  10. FOR ADDITIONAL NOTES SEE 23W262-1.
  11. FOR DESIGN CALCULATIONS AND FIELD INFORMATION, SEE RMS NUMBER B05 931006 001.

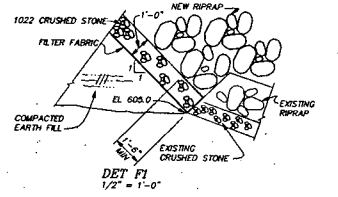


GROUND WATER WELL TABLE

WELL NO.	COORDINATES		APPROXIMATE EXISTING ELEV. TOP OF GROUND	APPROXIMATE FINISHED GRADE ELEV.
	NORTH	EAST		
SH-10	1,426,208.9	330,923.4	603.7	608.7
SH-9	1,426,222.4	330,899.2	610.0	617.7
SH-8	1,426,232.0	330,854.7	598.9	603.3
S-167	1,426,302.8	330,850.3	590.0	592.0
SB-15	1,426,272.1	330,841.4	590.0	591.7
SB-7	1,426,192.7	330,871.6	606.2	615.2
OPT-6A	1,426,189.8	330,878.0	610.0	617.7
OPT-7	1,426,031.4	330,825.3	610.0	617.7
P-8	1,426,034.5	330,819.9	607.6	614.4
P-9	1,426,050.3	330,769.4	580.9	593.2
SB-20	1,426,026.5	330,816.9	608.4	618.5
SB-18	1,426,000.6	330,681.2	592.3	595.0

GROUND WATER WELLS NOT TO BE MODIFIED

SH-6	SH-7	SB-21	SB-22	SB-23

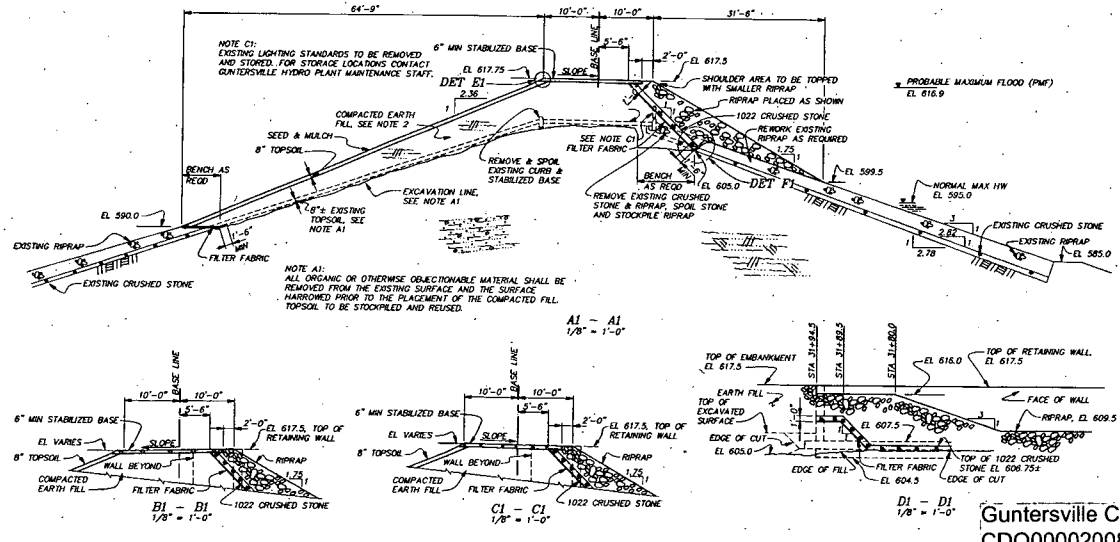

COMPANION DRAWINGS:  
23W262-2 THRU 8

Guntersville Calculation  
CDQ00020080011 Attachment 46

DESIGNED BY: J.H. COULSON

SCALE: 1" = 50'

EXCEPT AS NOTED

**SOUTH EMBANKMENT DAM SAFETY MODIFICATIONS**

**EMBANKMENT MODIFICATIONS EARTH DAM - PLANS, SECTIONS & DETAILS**


**GUNTERSVILLE PROJECT**  
TENNESSEE VALLEY AUTHORITY

DESIGN	DISCIPLINE INTERFACE	ENGINEERING APPROVAL
DESIGNED BY: J.H. COULSON	SUPERVISED BY: V.A. NEWELL	C.D. WAGNER
CHECKED BY: J.H. COULSON	REVIEWED BY: V.A. NEWELL	
APPROVED BY: J.H. COULSON	APPROVED BY: V.A. NEWELL	
ENGINEERING DATE: 22-01-01	8 c 23W262-1	R 1


ISSUED BY: J.H. COULSON

CAD SYSTEM ORIGINAL DO NOT CHANGE MANUALLY




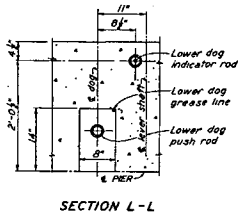


SECTION L-L

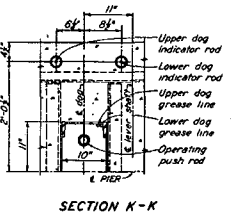


SECTION K-K

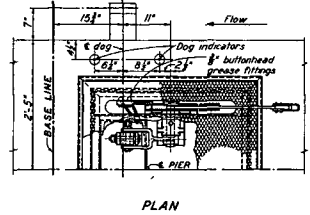


PLAN

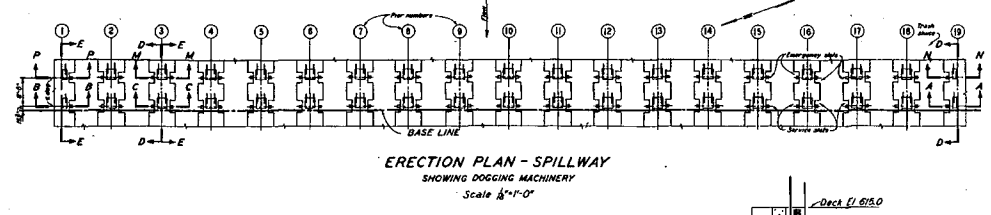


ERECTION PLAN - SPILLWAY  
SHOWING DOGGING MACHINERY  
Scale 1/4"=1'-0"

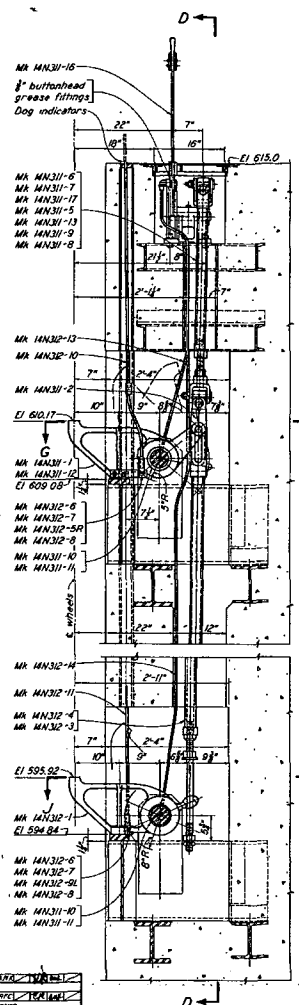


SECTION A-A & B-B  
SECTION B-B OPPOSITE HAND

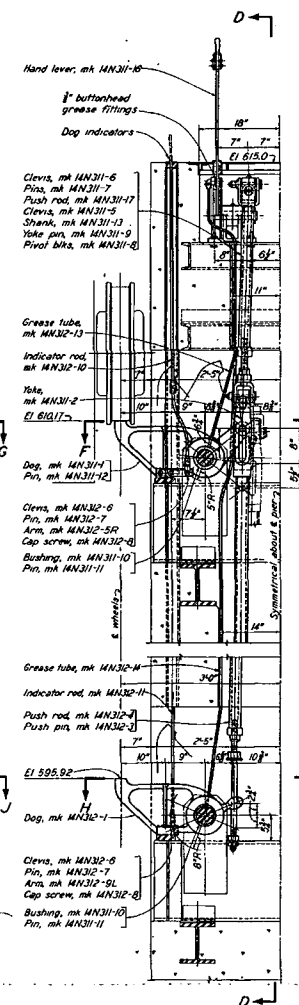


SECTION C-C  
PIERS 2 TO 18 INCL

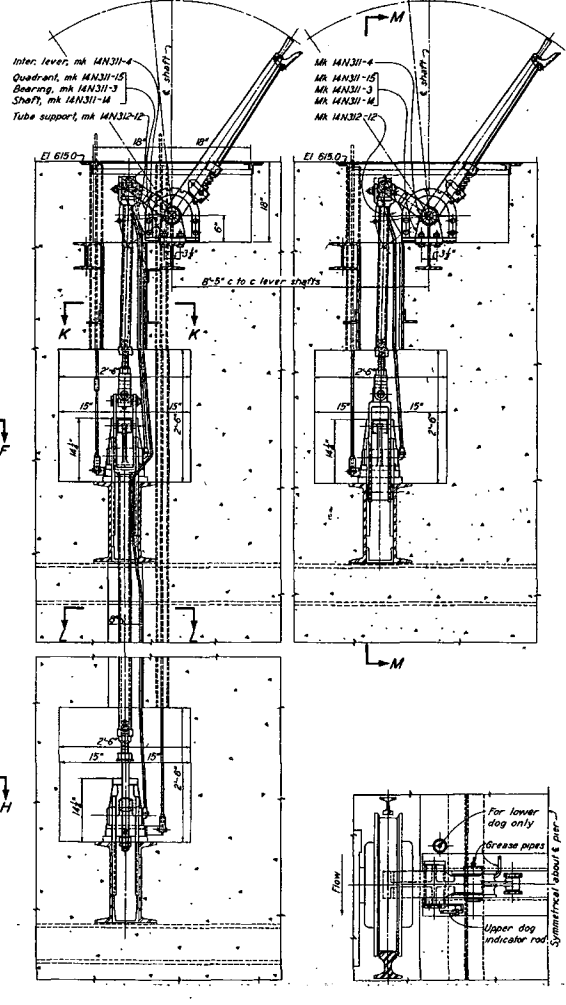


SECTION D-D & E-E  
SECTION E-E OPPOSITE HAND

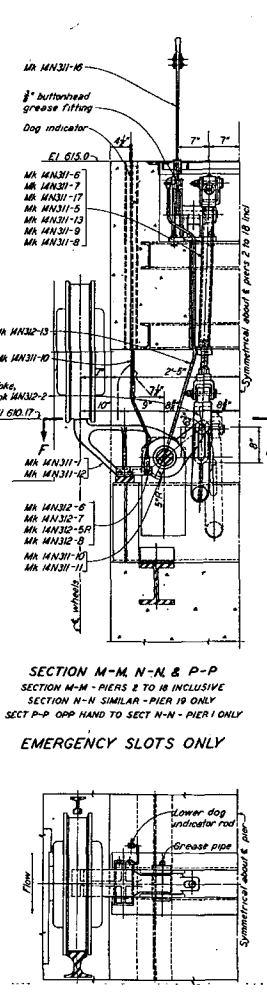

SECTION F-F & G-G  
SECTION G-G SIMILAR

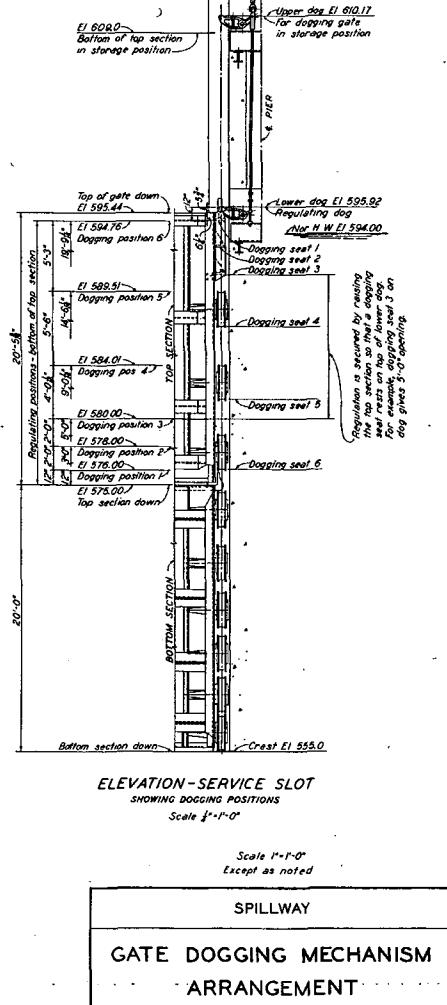

SECTION H-H & J-J  
SECTION J-J SIMILAR

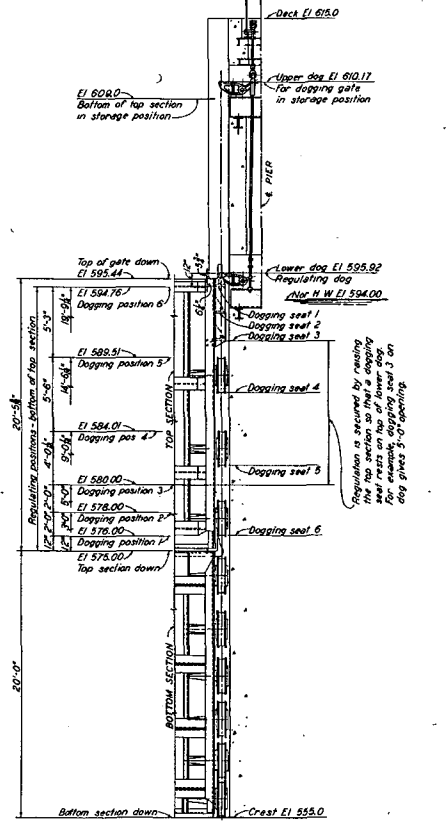

ELEVATION - SERVICE SLOT  
SHOWING DOGGING POSITIONS  
Scale 1/2"=1'-0"

SECTION M-M, N-N & P-P  
SECTION M-M - PIERS 2 TO 18 INCLUSIVE  
EMERGENCY SLOTS ONLY

REVISION	DATE	BY	CHKD
1	10/1/58	J.P.	J.P.
2	10/1/58	J.P.	J.P.
NOTES:  
For manufacturer's details refer to H. P. Gazzam Machine Co.  
File, TVA Contract No. TV-18939

SPILLWAY

**GATE DOGGING MECHANISM  
ARRANGEMENT**











GUNTERSVILLE PROJECT  
TENNESSEE VALLEY AUTHORITY  
ENGINEERING DESIGN DEPARTMENT

SUBMITTED BY <i>George K. Rul</i>	RECOMMENDED BY <i>A. C. Waggoner</i>	APPROVED BY <i>Robert M. Jones</i>
KNOXVILLE, TENN. 6-24-57 6 M 4 14N310R3		

RECORD DRAWING AS CONSTRUCTED 3-12-1940



17215 9 2 3 4 5 6 7 8 9 10 11 12

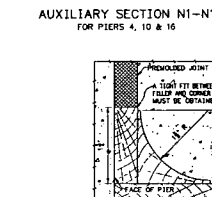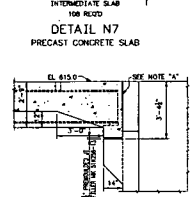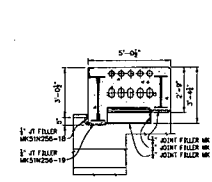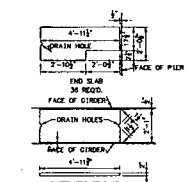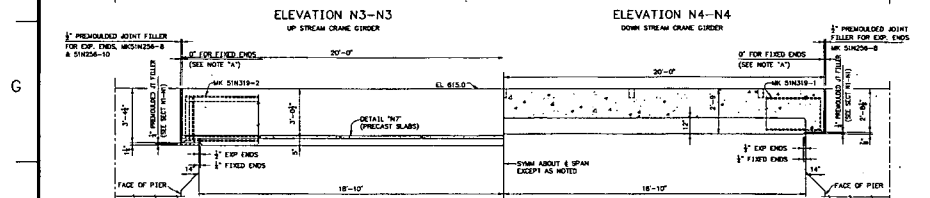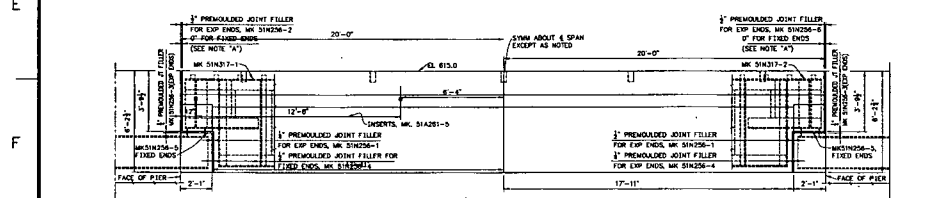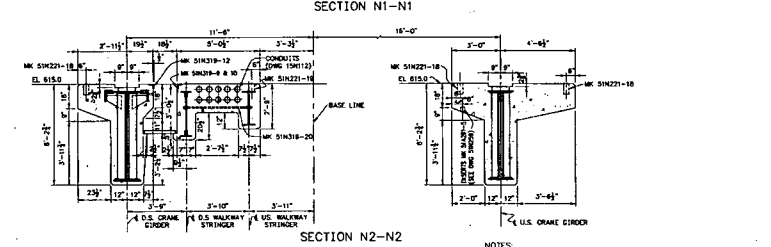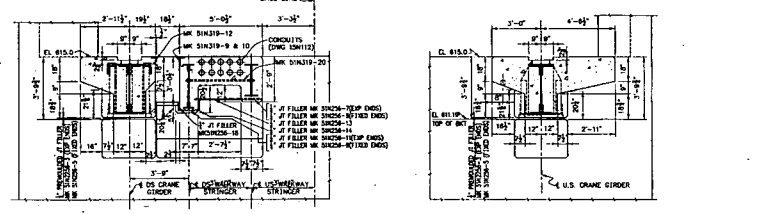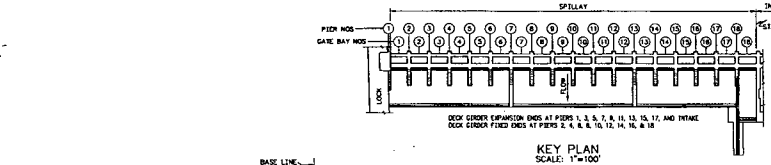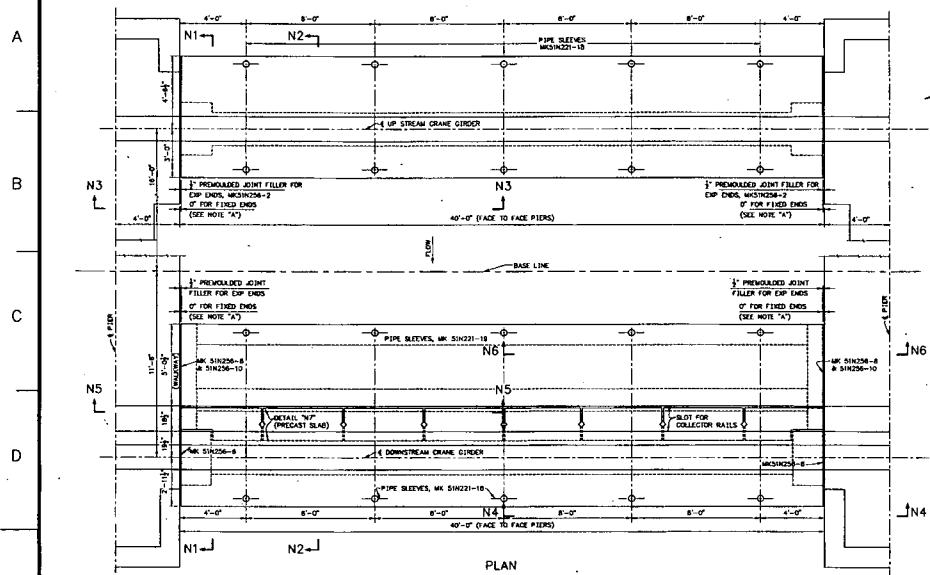

NOTES:  
ALL CONCRETE TO BE CLASS "A" (3)  
ALL EXPOSED EDGES TO HAVE STANDARD ROUND CORNERS AS SHOWN ON DWG 000030215, EXCEPT WHERE NOTED AND AT EL. 615.0 ON JOINT BETWEEN OPERATING BRIDGE DECK AND PIER AT THIS POINT THE EDGE IS FINISHED WITH A STANDARD 1/2" EDGER

REFERENCE DRAWINGS:  
SPILLWAY DAM  
SIN204 --- CONCRETE-TOP OF PIER-DETAILS  
SIN206 --- CONCRETE-TYPICAL PIER-EL. 505.0 TO EL. 615.0-OUTLINE  
SIN218 --- CONCRETE-OPERATING BRIDGE DECK-REINFORCEMENT  
SIN220 --- ARCHITECTURAL-OPERATING BRIDGE DECK-RAILING PLAN  
SIN221 --- ARCHITECTURAL-OPERATING BRIDGE DECK-RAILING DETAILS  
SIN241 --- PLAN, ELEVATION, & SECTIONS  
SIN242 --- PREMOULDED JOINT FILLER-OPERATING BRIDGE DECK-SIN256  
SIN255 --- DETAILS  
SIN256 --- PIPING-5 INCH WATER SERVICE LINE  
SIN315 --- STRUCTURAL STEEL-OPERATING BRIDGE DECK-GENERAL PLAN & SECTION DIAGRAM

ELECTRICAL  
15N112 --- POWER CONDUITS-PLAN & SECTIONS  
15N126 --- GANTRY CRANE CONTACT TROLLEY-GEN ARRANGEMENT

DATE	BY	CHECKED	APP'D
05 MAR 15 2011	W.M.B.	E.A.	E.M.S.
DESIGNED	DRAWN	CHECKED	APPROVED
L.V.M.	M.A.B.	M.H.B.	P.L.A.H.

SCALE: 1"=1'-0" EXCEPT AS NOTED

SPILLWAY DAM			
CONCRETE OPERATING BRIDGE DECK OUTLINE			
DESIGNED BY	DRAWN BY	CHECKED BY	APPROVED BY
L.V.M.	M.A.B.	M.H.B.	P.L.A.H.
GUNTERSVILLE PROJECT TENNESSEE VALLEY AUTHORITY RIVER SYSTEMS OPERATIONS			
AUTOCAD 2008	8-20-07	6 C	51W217
PLOT FACTOR: 32			C.A.S. DRAWING
THIS DRAWING HAS BEEN COMPLETELY REDRAWN AND SUPERSEDES (SIN217 R4)			DO NOT ALTER MANUALLY

Guntersville Calculation  
CDQ000020080011 Attachment 49

1 2 3 4 5 6 7 8 9 10 11 12

April 2000

Attachment 8

Calculation No: CDQ000020080011

Source: Reference 2

Guntersville 43

## SAFETY MODIFICATIONS FOR PROBABLE MAXIMUM FLOOD

### Chronology

Safety analysis studies for Guntersville Dam for the Probable Maximum Flood (PMF) were started in August 1984 and completed in February 1993. Final design started in April 1993. Onsite construction began in 1994 and was completed on June 30, 1995.

### Cost of Modification

Design costs for the capital safety modifications to Guntersville Dam were approximately \$5,460,000. Construction costs were approximately \$31,869,070. The total project cost was approximately \$37.3 million. This did not include costs for dam safety evaluation studies which resulted in the modifications.

### Controlling Features

The embankments at Guntersville Dam were modified in order to safely pass the probable maximum flood. The embankments were raised to an elevation of 617.5 from the lowest embankment elevation of 610.0. The modifications to the south embankment consisted of a cantilever concrete wall, impervious earthfill embankment, and a stoplog system at the powerhouse. The modifications to the north embankment consisted of a cantilever concrete wall, sheet pile cells/wall cutoff, and a structural slab. These PMF modifications will prevent overtopping and erosion of the embankments and thus prevent breach and failure of the dam.

AMERICAN SOCIETY OF CIVIL ENGINEERS

Founded November 5, 1852

TRANSACTIONS

Paper No. 2855

DISCHARGE COEFFICIENTS FOR SPILLWAYS AT TVA DAMS

BY KENNETH W. KIRKPATRICK, A. M. ASCE

SYNOPSIS

Spillway ratings derived from model studies have been used in the preparation of spillway rating tables for the Tennessee Valley Authority dams. As a result of these studies, discharge coefficients for eleven of the Tennessee Valley Authority dams are given in this paper. Coefficients for both submerged and free discharge conditions are presented for discharges over standard spillway crests, irregular spillway crests, and a vertical-lift spillway gate. Discharge coefficients for Tainter gates placed on curved spillway crests are also given for various gate openings under free discharge conditions. In addition, data on the effect of model scale on the discharge coefficient and the effect of closing adjacent spillway bays and gates are presented. The coefficient relationships are shown in a form that may be used by designers as a guide in making determinations of the discharges for future spillways.

NOTATION

The letter symbols adopted for use in this paper are defined where they first appear, in the illustrations or in the text, and are arranged alphabetically, for convenience of reference, in the Appendix.

INTRODUCTION

The Tennessee Valley Authority (TVA) operates a system of nine dams on the Tennessee River and twenty-three on the tributary rivers. The successful operation of such a system requires accurate discharge ratings for each structure. Although enough water is seldom available to make complete ratings for most spillways from measurements conducted on the prototype structure, ratings can be determined from scale model tests. Therefore, the necessary ratings for the TVA spillways have been determined by this means. Model studies have been made at the TVA Hydraulic Laboratory at Norris, Tenn.,

Note.—Published, essentially as printed here, in February, 1955, as Proceedings-Separate No. 686. Positions and titles given are those in effect when the paper was approved for publication in Transactions. <sup>1</sup> Hydr. Engr., Hydr. Lab., Tennessee Valley Authority, Norris, Tenn.

on nine different spillway crest shapes equipped with three types of control gates.

Seven of the nine crests were curved sections which approximated the shape of the lower nappe of a sharp-crested weir. The other two crests were flat. The two flat-crested weirs and one of the curved crests were equipped with double-leaf vertical lift gates. Five of the curved crests were equipped with Tainter gates and the other with vertical lift gates.

Data Presented.—Data are presented for the following conditions: (1) Free, ungated flow through a series of spillway bays; (2) submerged, ungated flow through a series of spillway bays; (3) free, ungated flow through a series of spillway bays, with adjacent bays fully open or closed; (4) free flow over a vertical lift gate; (5) submerged flow over a vertical lift gate; (6) flow under a series of Tainter gates set with equal openings; and (7) flow under a series of Tainter gates with adjacent gates closed.

Data are also presented to show the effect of model scale for the condition of free, ungated flow through a series of spillway bays.

General Model Arrangement.—The models were tested in flumes either 3.5 ft wide or 8 ft wide. Models installed in the smaller flume usually consisted of a reproduction of three of the prototype spillway bays. In the larger flume five or six spillway bays were reproduced. Each of these flumes was provided with glass panels for observation purposes. The models placed in the larger flume were constructed at scale ratios of from 1:28.72 to 1:50 with a ratio of approximately 1:35 generally used. Those tested in the smaller flume were built at scale ratios of 1:50, 1:100, and 1:200.

The models were usually provided with concrete crests and concrete piers to insure dimensional stability. Half piers were constructed on the ends of each model. If the model did not completely fill the flume one side was placed against the glass side of the flume and the other against a false wall. The river bed upstream and downstream from the model was reproduced at the elevation of the prototype river bed. Suitable baffling was provided to obtain a uniform distribution of flow in the spillway approach channel. The tailwater level was controlled at the end of the flumes by means of slot gates. Model discharges were determined from readings of a carefully calibrated diaphragm orifice located in the water supply line.

Headwater heights were measured at two piezometers at distances equal to approximately 5 and 8 times the design head upstream from the spillway crest. Tailwater heights were obtained at 2 piezometers at distances equal to approximately 9 and 12 times the design head downstream from the spillway crest—in all cases, sufficiently far enough downstream to eliminate the effect of the spillway apron.

In most studies the headwater and tailwater levels were determined by means of hook gages reading to 0.001 ft. For the 1/200-scale model the heads were measured with a micrometer point gage reading to 0.0001 ft.

Discharge Equations.—The model data have been reduced by the use of two commonly accepted discharge equations. For both free and submerged flow over a spillway crest the equation,

Q = C L H^3/2 ..... (1)

was used, in which  $Q$  is the discharge in cubic feet per second,  $C$  is the coefficient of discharge determined from the model tests,  $L$  is the length of the crest, and  $H$  is the total head as shown in Fig. 1(a). Use was made of the same equation in the reduction of the data for free and submerged flows over a vertical gate with  $D$ ,  $H$ ,  $d$ , and  $P$  (Fig. 1(a)) being measured from the top of the gate.

For flow under a gate the equation for a rectangular orifice under low head,

$$Q = CL [H^{3/2} - (D_1 + h)^{3/2}] \quad (2)$$

was used, in which  $D_1$  is the depth of water to the bottom of the gate as defined in Fig. 1(b) and  $h$  is the approach velocity head.

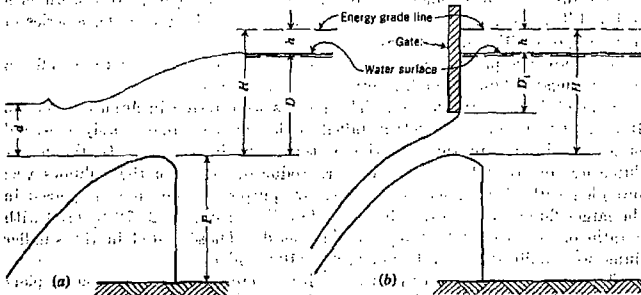


FIG. 1.—SPILLWAY-CREST DIAGRAM

FREE-DISCHARGE COEFFICIENTS, FLOW OVER SPILLWAY CRESTS

It is common practice for engineers to design spillway crests to approximate closely the shape of the lower portion of a jet issuing from a sharp-crested weir, and this type of crest is designated a standard crest.<sup>2</sup> Because the shape of the jet changes with the head on the weir, some particular head must be used for each design. This head for which a particular crest is designed is termed the design head. At this head, pressures approximating atmospheric pressure are developed at the spillway surface. At smaller heads, pressures are greater than atmospheric. Seven of the nine TVA crests for which data are available, approximate standard crests in shape whereas the other two crests, which are flat, do not. Fig. 2 shows the basic details and dimensions of each of these crests. Fig. 3 presents the coefficient data obtained on the crests of Fig. 2. Pertinent design data concerning each crest, together with the scale to which each was modeled, appear in Table 1. Eleven spillways are also listed in Table 1. Two pairs of these, the Ocoee No. 3-Apalachia set, and the Douglas-Watts Bar set, both in Tennessee, have crest shapes that are identical within the pair but which were tested for different values of the approach depth,  $P$ .

<sup>2</sup>"Hydroelectric Handbook," by W. P. Creager and J. D. Justin, John Wiley & Sons, Inc., New York, N. Y., 2d Ed., 1950.

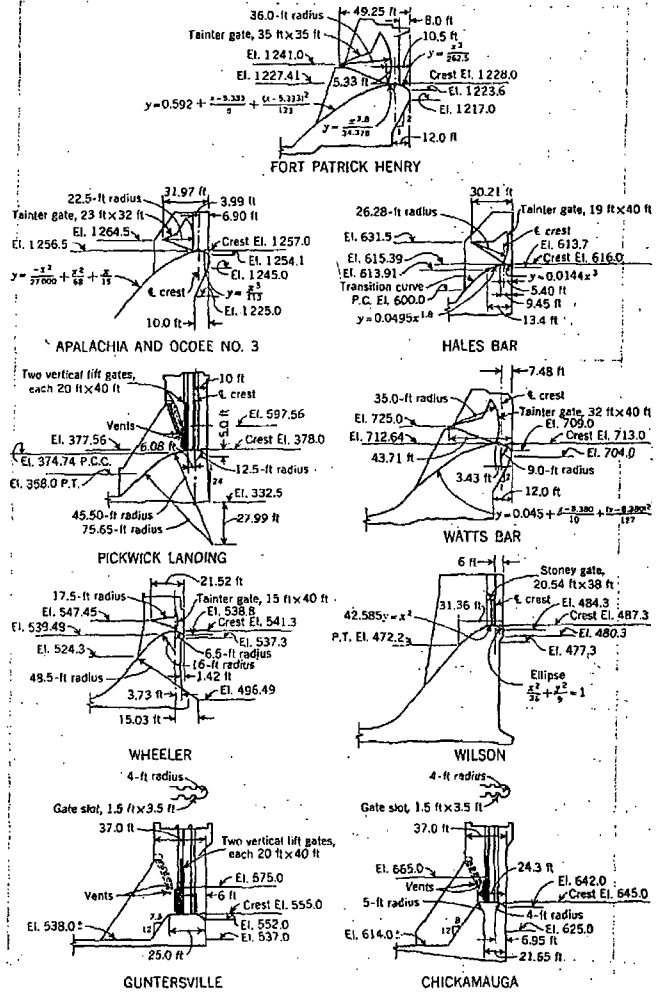


FIG. 2.—TVA SPILLWAY CRESTS (DATA IN FIG. 3)

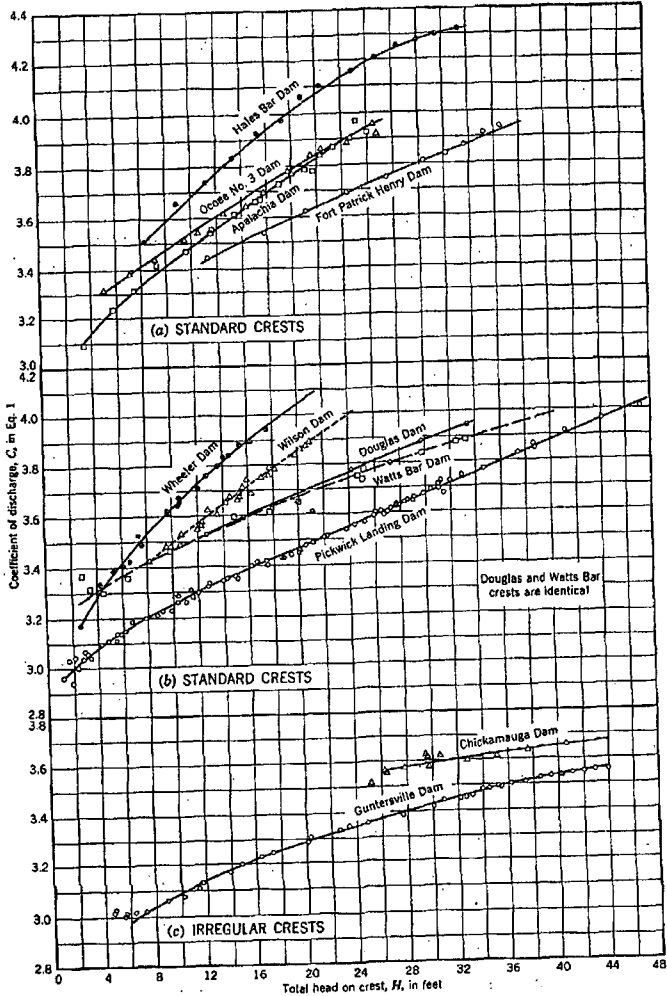


FIG. 3.—DISCHARGE COEFFICIENTS FOR FREE FLOW OVER THE SPILLWAY CRESTS OF FIG. 2

The accuracy of the data is evidenced by the plotting of the data points in Fig. 3. Except in some cases at low heads, the deviation of any plotted point from the coefficient curve does not exceed 0.5%.

**Standard Crests.**—It has been shown by various authors that the discharge coefficients for all standard crests can be related to each other and that, conversely, the coefficients to be used for a new design can be taken from previous test data.<sup>3,4,5</sup> Unfortunately, in most crest designs, due to other design considerations, it is necessary that the shape be varied from the standard form. Nevertheless, satisfactory coefficients can be obtained as sufficient data are now available on a range of crest shapes. By comparison of crest shapes designers may select a coefficient for any particular crest.

Dimensionless plotting provides a means for comparison of crest shapes. This method is used in Fig. 4 on which seven TVA crests which closely approximate standard crests are shown by the solid lines, with the dashed line representing a standard crest shape.<sup>6</sup> The horizontal coordinate,  $x$ , and the vertical coordinate,  $y$ , of the crest curve have been divided by the design head,  $H_d$ .

TABLE 1.—DESIGN DATA FOR ELEVEN MODELS OF TVA SPILLWAYS

Project	Model scale	Design head, $H_d$ , in feet	Upstream depth, $P$ , in feet	$H_d/P$	Pier nose radius, in feet
Hales Bar.....	1:34.76	18	32	0.56	3.00
Ocoee No. 3.....	1:22.72	23	67	0.35	3.00
Apalachia.....	1:22.72	23	97	0.24	3.00
Fort Patrick Henry.....	1:50	35	43	0.81	2.25
Wheeler.....	1:34.35	18.5	43	0.43	2.50
Wilson.....	1:32.4	19	75	0.25	4.00
Douglas.....	1:35	23.5	133	0.18	3.25
Watts Bar.....	1:35	23.5	62	0.45	3.25
Pickwick Landing.....	1:50	31.5	32	0.98	3.75
Chickamauga.....	1:50	20	20	1.00	4.00
Gunterville.....	1:50	18	18	1.00	4.00

The design head was determined by fitting the real and standard curves at the crest point ( $x = 0$ ) and at the intersection of the curve with the upstream vertical face. These design-head values are presented in Table 1. The design-head discharge coefficients ( $C_d$ ) determined from Fig. 3 are shown in Fig. 4.

The TVA crests all fairly closely approximate the standard curve from the upstream spillway face to a point somewhere downstream from the crest which was determined by the position of the gate seal. Below this latter point, the crest shape was modified to fit the trajectory of a jet issuing from under the gate when set at a small opening. The upstream face for a standard crest is vertical. The upstream face of the TVA crests, as shown in Fig. 4, deviates from the vertical. Other experimenters have established the fact that the shape of the upstream face generally has little influence on the discharge coefficient.<sup>7</sup>

<sup>3</sup> "Final Reports of Boulder Canyon Project," *Bulletin No. 3*, Part VI, Hydraulic Investigations, Bureau of Reclamation, U. S. Dept. of the Interior, Washington, D. C., 1947.

<sup>4</sup> "Engineering Hydraulics," edited by Hunter Rouse, John Wiley & Sons, Inc., New York, N. Y., 1950.

<sup>5</sup> "Discharge Coefficients for Irregular Overall Spillways," by J. N. Bradley, *Engineering Monograph No. 9*, Bureau of Reclamation, U. S. Dept. of the Interior, Washington, D. C., 1952.

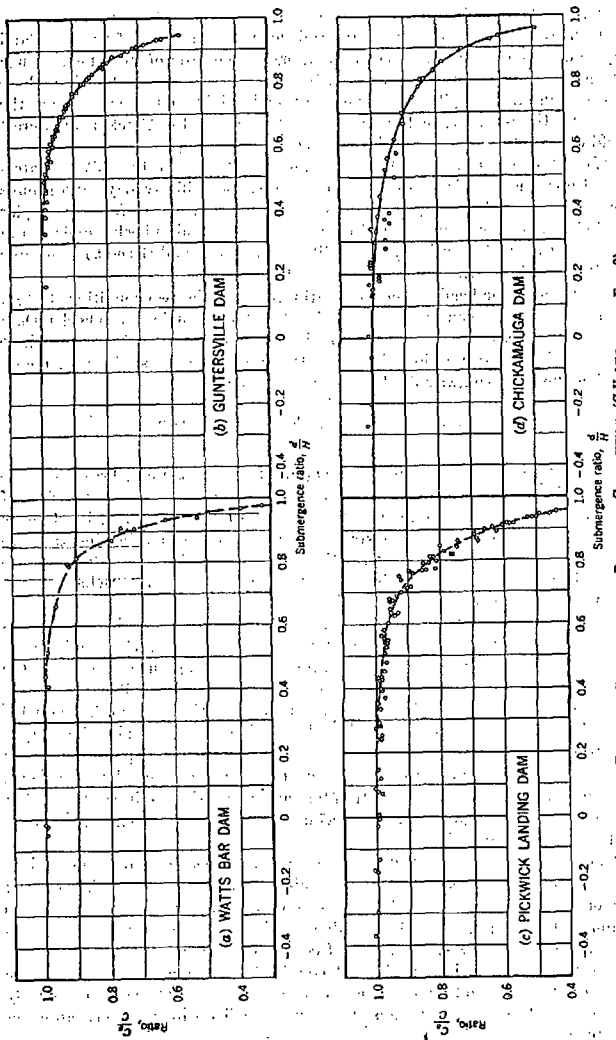


FIG. 7.—EFFECT OF SUBMERGENCE ON DISCHARGE COEFFICIENTS (C-VALUES FROM FIG. 3)

In Fig. 8 the four curves of Fig. 7 are shown on a single plot. Although the maximum spread between curves is about 10%, this is to be expected considering the wide range of crest shapes used in the tests.

FREE-DISCHARGE COEFFICIENTS FOR FLOW OVER VERTICAL LIFT GATES

The Pickwick Landing vertical lift gates are representative of this type of gate, which has been used on several TVA projects. In Fig. 9(a) are shown details of the lower spillway gate leaf. For heads greater than 2 ft, this gate is essentially a sharp-crested weir 40 ft long and 20 ft high with piers 7.5 ft thick at each end of the gate. Air intakes were installed in the sides of the piers just below the top of the gate to ventilate the underside of the nappe.<sup>6</sup> Model tests were conducted with the 1/50-scale, 3-bay spillway model.


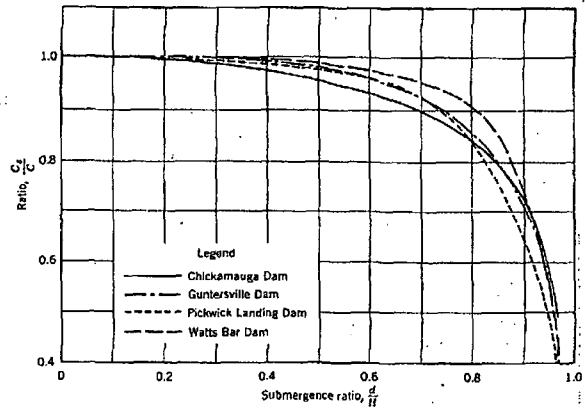


FIG. 8.—COMPARISON OF SUBMERGENCE EFFECTS FOR VARIOUS SPILLWAY CREST SHAPES


In Fig. 9(b) is shown the head-coefficient relationship for flow over the crest of the spillway gate. The coefficient,  $C$ , was computed from Eq. 1 using the top of the gate as crest elevation. The points define the head-coefficient relationship for heads between 3 ft and 28 ft. Each point was determined from the average of from 3 to 5 separate tests. A constant value of  $C$  equal to 3.428 is shown for heads in excess of 12 ft. For heads of from 12 ft to about 4 ft the model test curve shows a gradual rise in the coefficient, with an abrupt drop-off when the heads are approximately 4 ft and less. This curve takes the characteristic form for the coefficients of a sharp-crested weir, the rise and fall in the coefficient curve being due to the nappe clinging to the surface of the weir. This phenomenon is a function of the absolute head. Therefore, similarity between the model and prototype did not exist for prototype heads

<sup>6</sup> "Action of Spillways," by G. H. Hickox, *Transactions, ASCE*, Vol. 109, p. 537.

Source: Reference 6

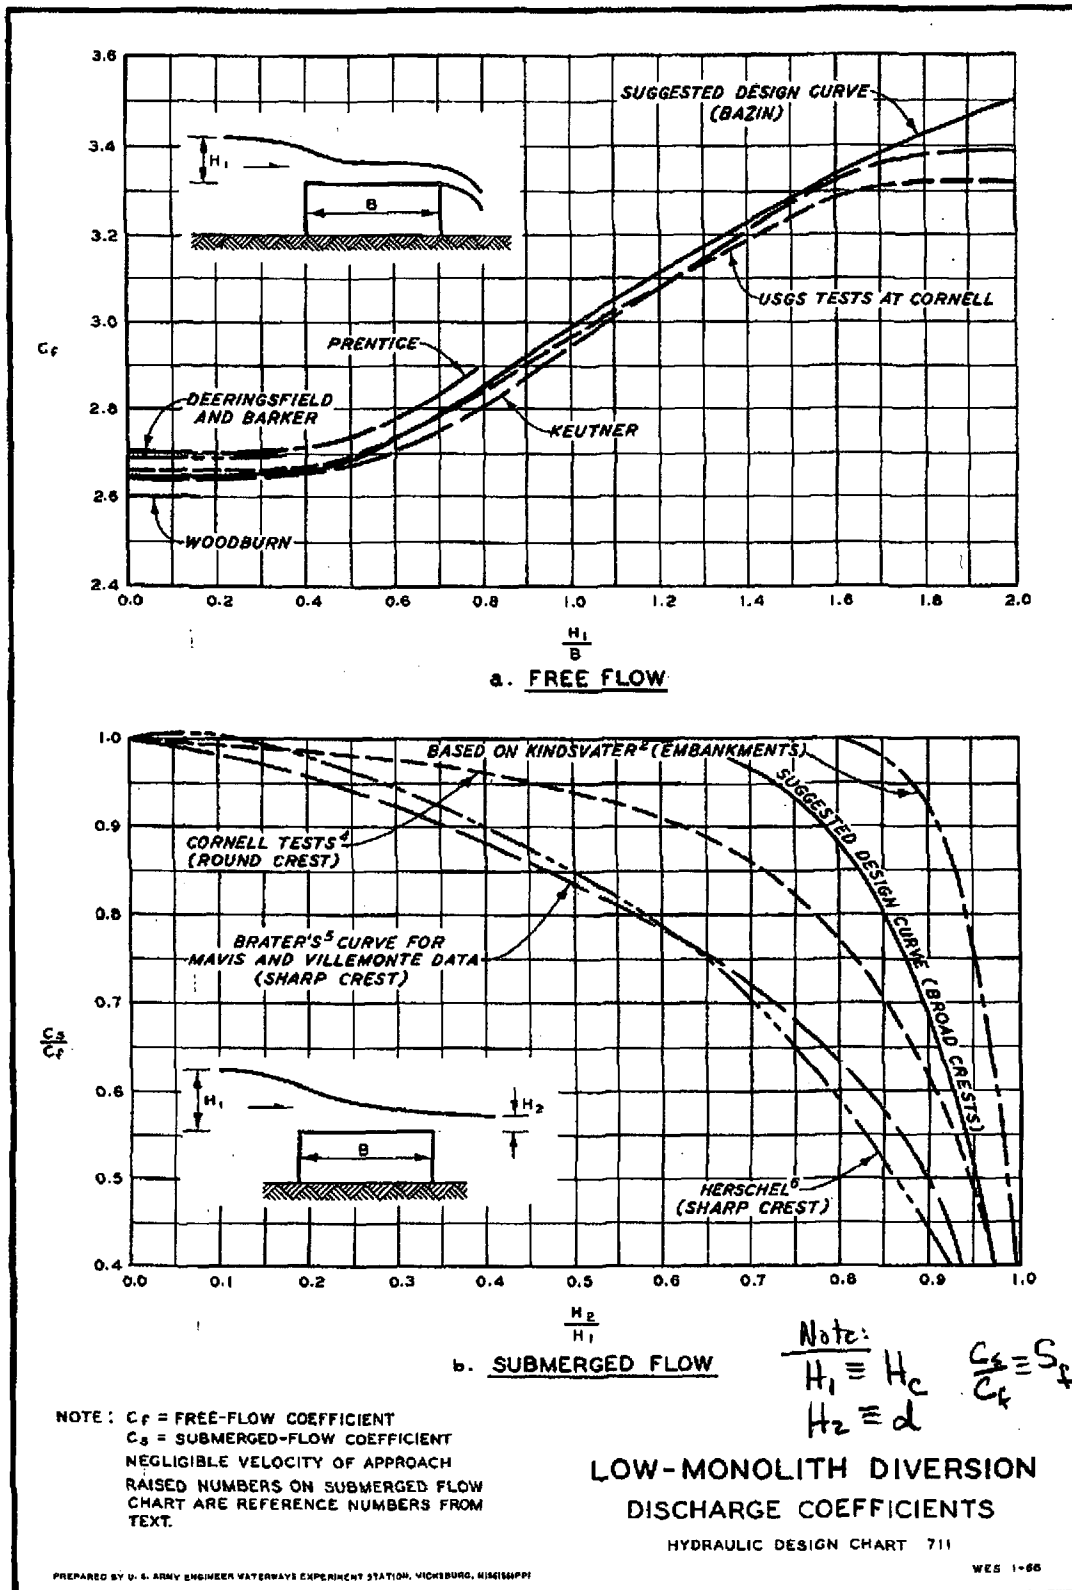

Submergence Factors for Weirs from Chart 711 in Hydraulic Design Criteria

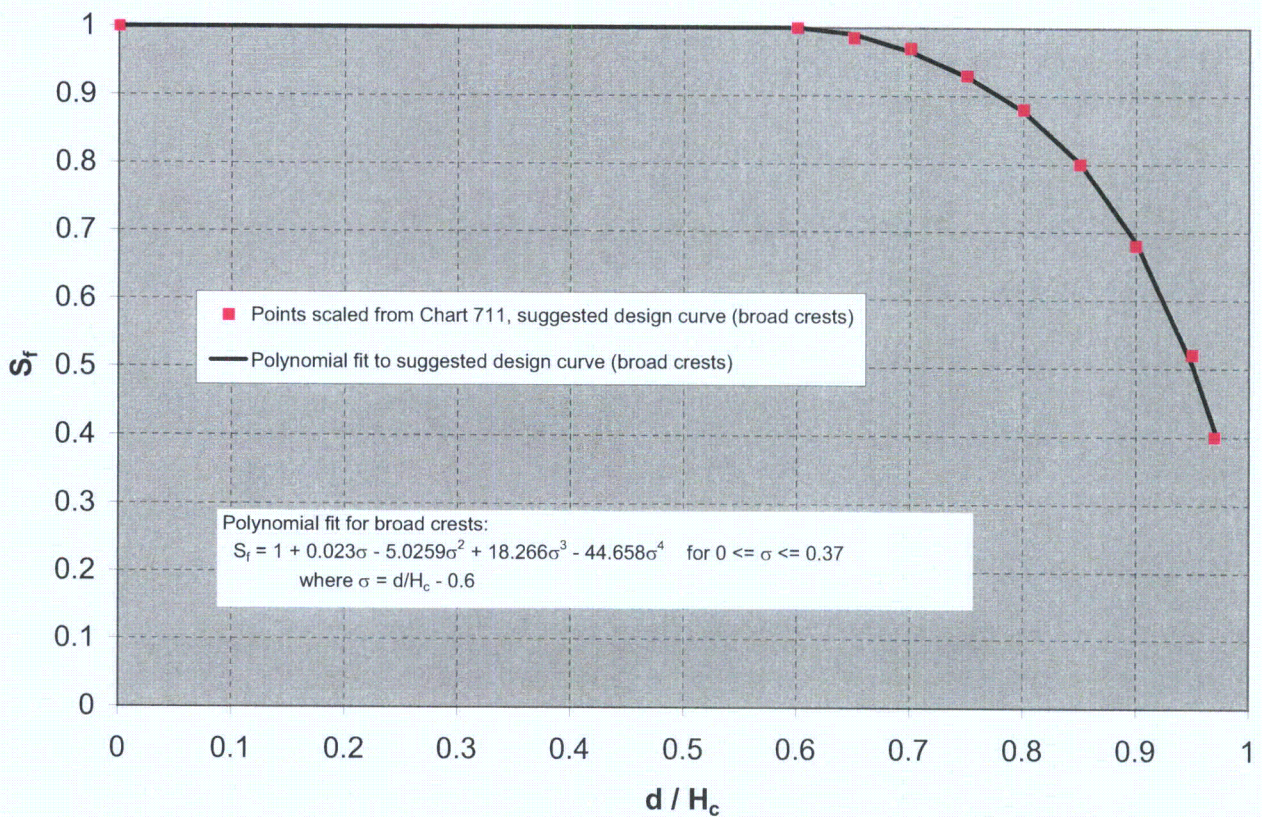





Source: Reference 5

Guntersville Rating Curves.xls Cf


Data Scaled from Figure 3 in Reference 5

H <sub>c</sub> , ft.	C <sub>f</sub>
5	2.980
10	3.090
15	3.200
20	3.295
25	3.365
30	3.425
35	3.475
40	3.520
45	3.555
50	3.590 extrapolated
55	3.620 extrapolated
60	3.645 extrapolated
65	3.665 extrapolated

Curve fit using 4th-order polynomial (see plot)

H <sub>c</sub> , ft	C <sub>f</sub> from polynomial
0	2.834
5	2.976
10	3.098
15	3.201
20	3.289
25	3.363
30	3.425
35	3.477
40	3.521
45	3.558
50	3.590
55	3.618
60	3.643
65	3.667
70	3.689

### Free Discharge Coefficient, C<sub>f</sub>, for Guntersville Dam Spillway Crest

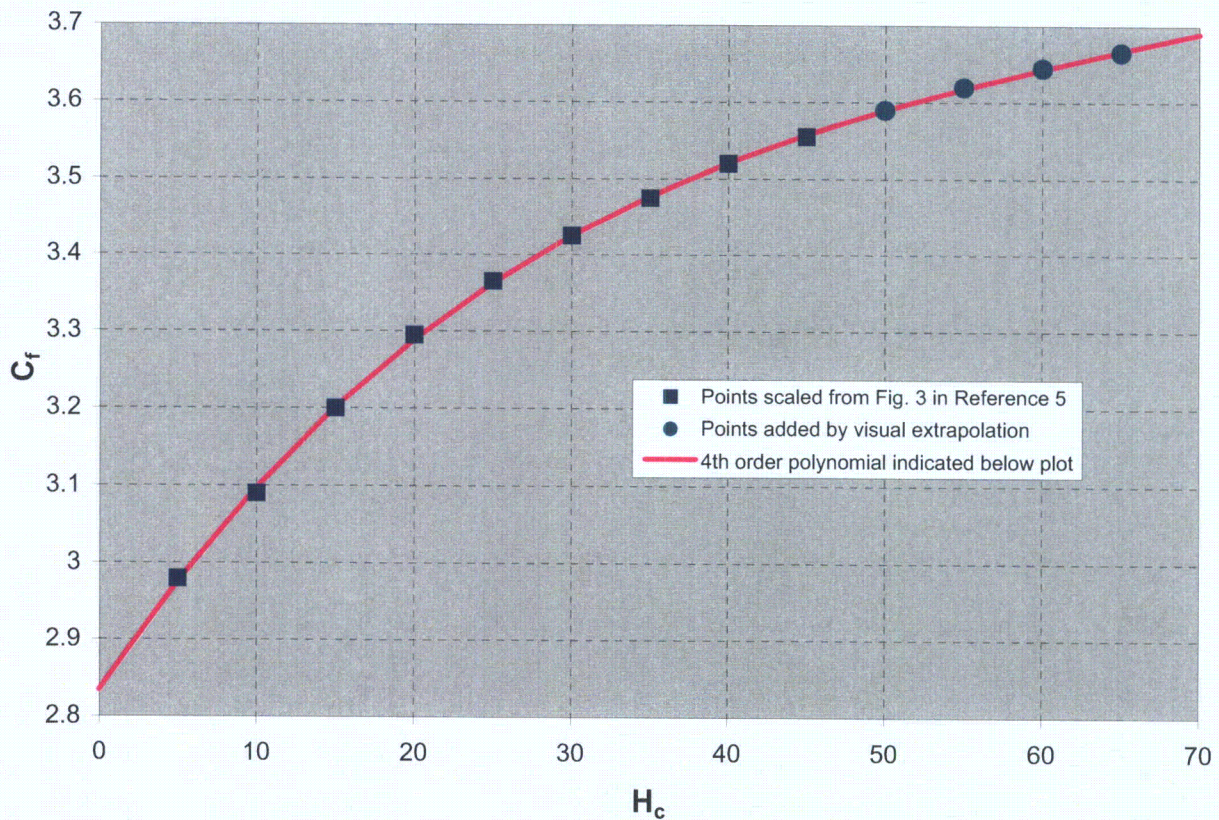


$$C_f = -9.1183 \times 10^{-9} H_c^4 + 3.4794 \times 10^{-6} H_c^3 - 4.6300 \times 10^{-4} H_c^2 + 0.030717 H_c + 2.8335$$

Data Scaled from Plot of  $C_s/C$  vs.  $d/H$  (Figure 7) in Reference 5

$d / H_c$	$S_f$	Curve fit to $S_f$	exponents (see chart)
0	1	1.000	5.5
0.300	1.000	0.999	0.4
0.400	0.997	0.997	
0.500	0.992	0.991	
0.550	0.985	0.985	
0.600	0.974	0.975	
0.650	0.957	0.961	
0.700	0.937	0.941	
0.750	0.909	0.912	
0.800	0.872	0.870	
0.850	0.810	0.810	
0.875	0.777	0.770	
0.9	0.72	0.720	
0.925	0.66	0.656	
0.95	0.575	0.570	
0.96		0.526	
0.97		0.473	
0.98		0.406	
0.99		0.311	
0.995		0.236	
1		0.000	

### Submergence Effect on Free Discharge Guntersville Dam Spillway Crest

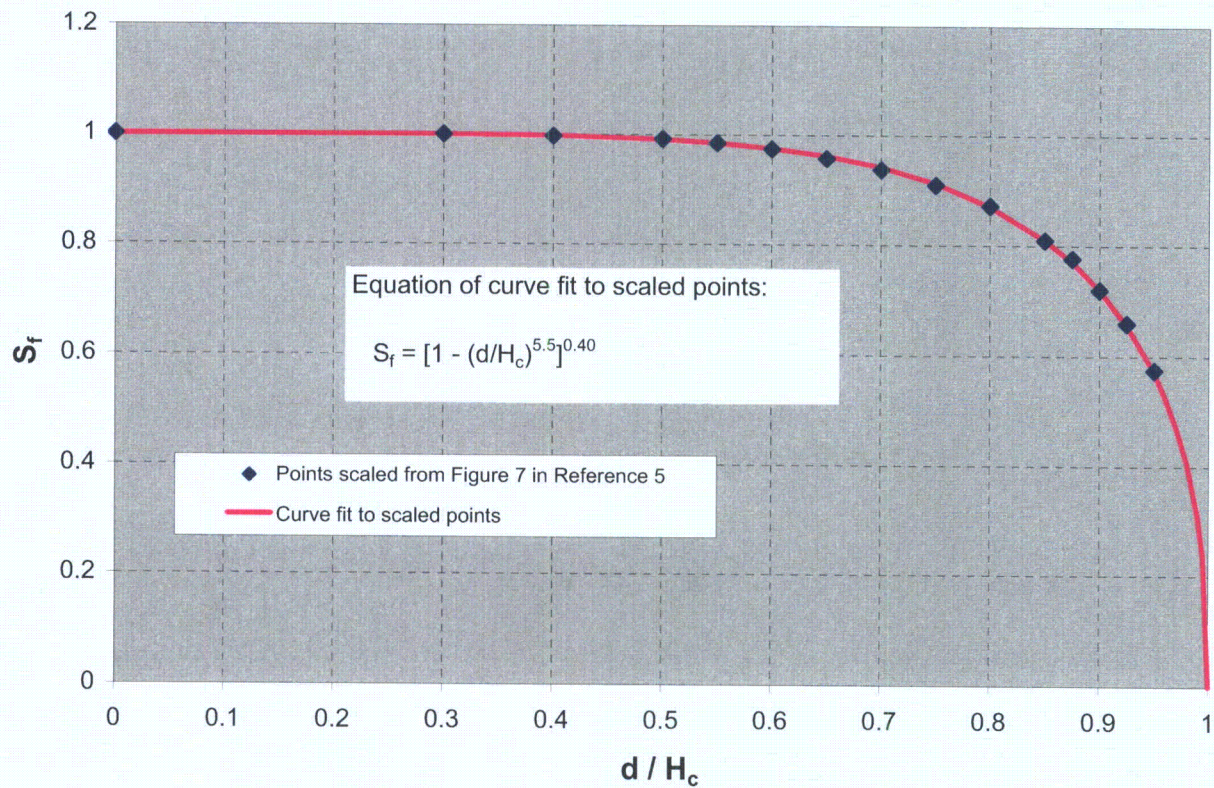



Attachment 15-2

Calculation No: CDQ000020080011

## Guntosville Navigation Locks Overflow

COMPUTED GAS DATE 12/19/2008

CHECKED DATE

## Overflow Parameters

• Main and auxiliary lock miter gates (see [4.12] for discussion).

For calculation convenience, use average overflow elevation and  $C_f$  for both:

$$\begin{cases} Z_c = \frac{1}{2}(599.4 + 597.1) \approx 598.3' \\ L = 110' + 60' = 170' \end{cases}$$

For  $C_f$ :  $B \leq 10'$


$$0 \leq H_c/B \leq \frac{624 - 598.3}{10} = 2.57^*$$

\*larger for  $B < 10$

From Attachment 10:

$$2.65 \leq C_f \leq 3.4 \text{ (sharp-crest)}$$

• Use  $C_f = 3.2$  ~ upper end of range since  $B < 10'$  and  $(H_c/B)_{max} > 2.0$

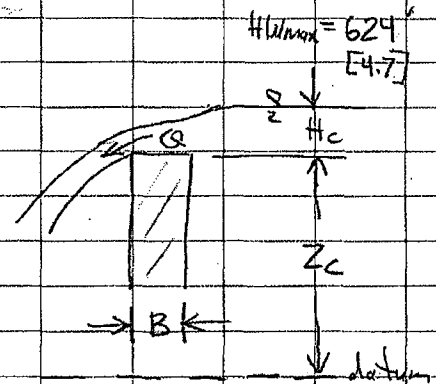

Note: The miter gate overflow is small compared to the spillway discharge. Use of the average overflow elevation for both gates and neglect of the gate angles in determining the length will have negligible impact on the rating curves.

## Guntersville Navigation Locks Overflow

COMPUTED GAS DATE 12/19/2008

CHECKED DATE

• Auxiliary Lock Section,  $Z_c = 600'$  (see sheet 1)

Identify two segments (a) and (b) (different overflow widths, B)

(a) dam between locks

$$L = 172' - 82.5' - 30' - 45' = 14.5'$$

↑ sheet elevation view  
 ↑ 1/2 lock width  
 ↑ lock wall

$$B = 16' \quad 0 \leq \frac{H_c}{B} \leq \frac{624 - 600}{16} = 1.5 \quad \text{from Att. 10} \quad 2.65 \leq C_f \leq 3.25$$

(b) lock walls (no flow over Ops. Bldg)

$$L = 35' + 26' = 61'$$

↑ streamwise length between upper gate and dam between locks (sheet 1, plan)  
 ↑ for flow between operations bldg and upper gate (sheet 1, plan)

$$B = 26 \rightarrow 45' \quad 0 \leq \frac{H_c}{B} \leq \frac{24'}{26'} = 0.92 \quad \text{from Att. 10} \quad 2.65 \leq C_f \leq 2.9$$

Note: These overflows are small compared to the spillway discharge. Combination of some section and utilization of a representative value of  $C_f$  will have negligible impact on the rating curve.

Combine sections and use:

$$\left\{ \begin{array}{l} Z_c = 600' \\ L = 14.5' + 61' = 75.5' \\ C_f = 2.9 \quad \sim \text{weighted towards (b) which is longer than (a)} \end{array} \right.$$

Guntersville Navigation Locks Overflow

COMPUTED GAS DATE 9/24/2008

CHECKED DATE

• Main Lock Section,  $Z_c = 605'$  (see sheet 1)

Identify two segments (a) and (b) (different overflow widths, B)

(a) dam between locks

$$L = 197.6' - 2(34') - 110' = 20'$$

$\uparrow$  sheet 1, elevation view       $\uparrow$  2 lock walls       $\uparrow$  lock width

$B = 16'$        $0 < \frac{H_c}{B} < \frac{624 - 605}{16} = 1.2$        $2.5 \leq C_f \leq 3.1$  (from Att 10)

(b) lock walls

$$L = 2(55') + 14' + 15' = 139'$$

$\uparrow$  streamwise lengths of wall between baseline of dam and upper gate (sheet 1, plan)       $\uparrow$  streamwise lengths of wall between retaining wall and baseline and between "dam between locks" and baseline (sheet 1, plan)

$B = 34 - 9 = 25'$  (between baseline and upper gate) use  $B = 24'$  for  $C_f$  determination  
 $\approx 34'$  upstream from base line

$0 \leq \frac{H_c}{B} \leq \frac{624 - 605}{25} = 0.76$        $2.65 \leq C_f \leq 2.8$  (from Att 10)

Note: These over flows are small compared to the spillway discharge. Combination of some sections and utilization of a representative value of  $C_f$  will have negligible impact on the rating curve.

Combine sections and use

$$\left\{ \begin{array}{l} Z_c = 605' \\ L = 139' + 20' = 159' \\ C_f = 2.80 \sim \text{weighted towards (b) which is longer than (a)} \end{array} \right.$$

Attachment 15-5

Calculation No: CDQ000020080011

## Guntersville Navigation Locks Overflow

COMPUTED GAS DATE 9/26/2008

CHECKED DATE

Sloped Section of Dam Between Locks

$$L = 60' \quad (\text{sheet 1, elevation view})$$

$$Z_c = \frac{1}{2}(600 + 605) = 602.5' \quad \sim \text{use average overflow elevation}$$

$$B = 16' \quad 0 \leq \frac{H_c}{B} \leq \frac{624 - 602.5}{16} = 1.34$$

$$\Rightarrow 2.65 < C_f < 3.15 \quad \text{from Att. 10}$$

Use

$$\begin{cases} Z_c = 602.5 \\ L = 60' \\ C_f = 2.9 \end{cases}$$

Summary for Navigation Locks Overflows:

$Z_c$ , ft	L, ft	$C_f$	
578.3	170	3.2	main and auxiliary upper miter gates
600	75.5	2.9	auxiliary lock section
602.5	60	2.9	sloped section of dam between locks
605	159	2.8	main lock section

Notes:

26.5' long section at EL. 615 (spillway junction w/ Aux. Lock) will be included with spillway pier overflow, also at EL. 615

Drawing ① shows "nominal elevations." Other drawings (e.g., ③ and ⑧) sometimes indicate slightly different elevations. Will use nominal elevations.








Attachment 15-8  
Source: Reference 13


Calculation No: CDQ000020080011

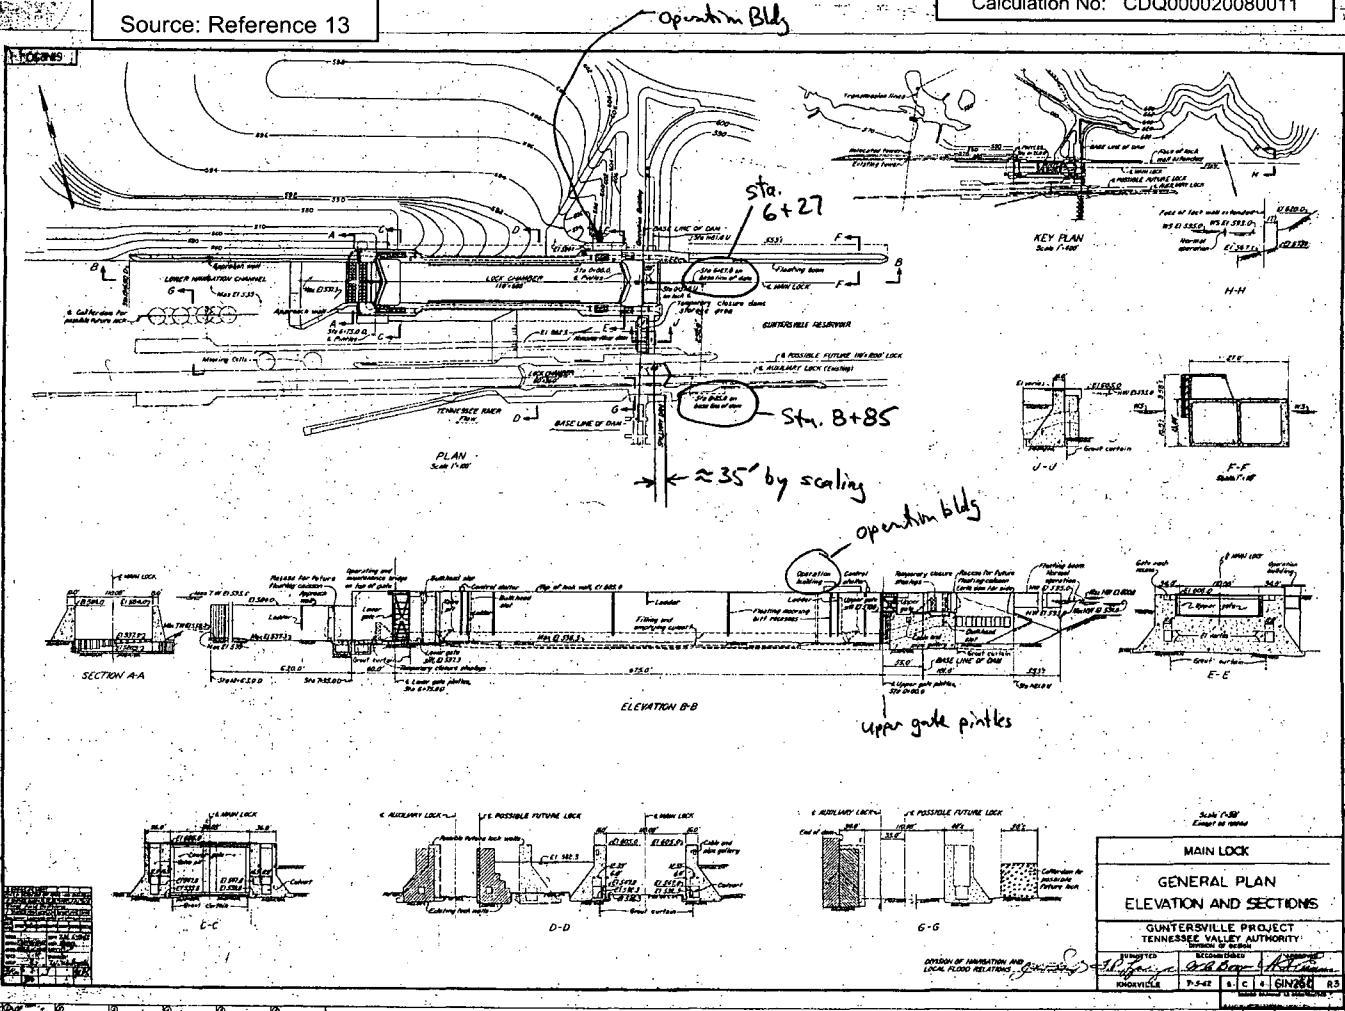

5


Attachment 15-9  
Source: Reference 9

Calculation No: CDQ000020080011

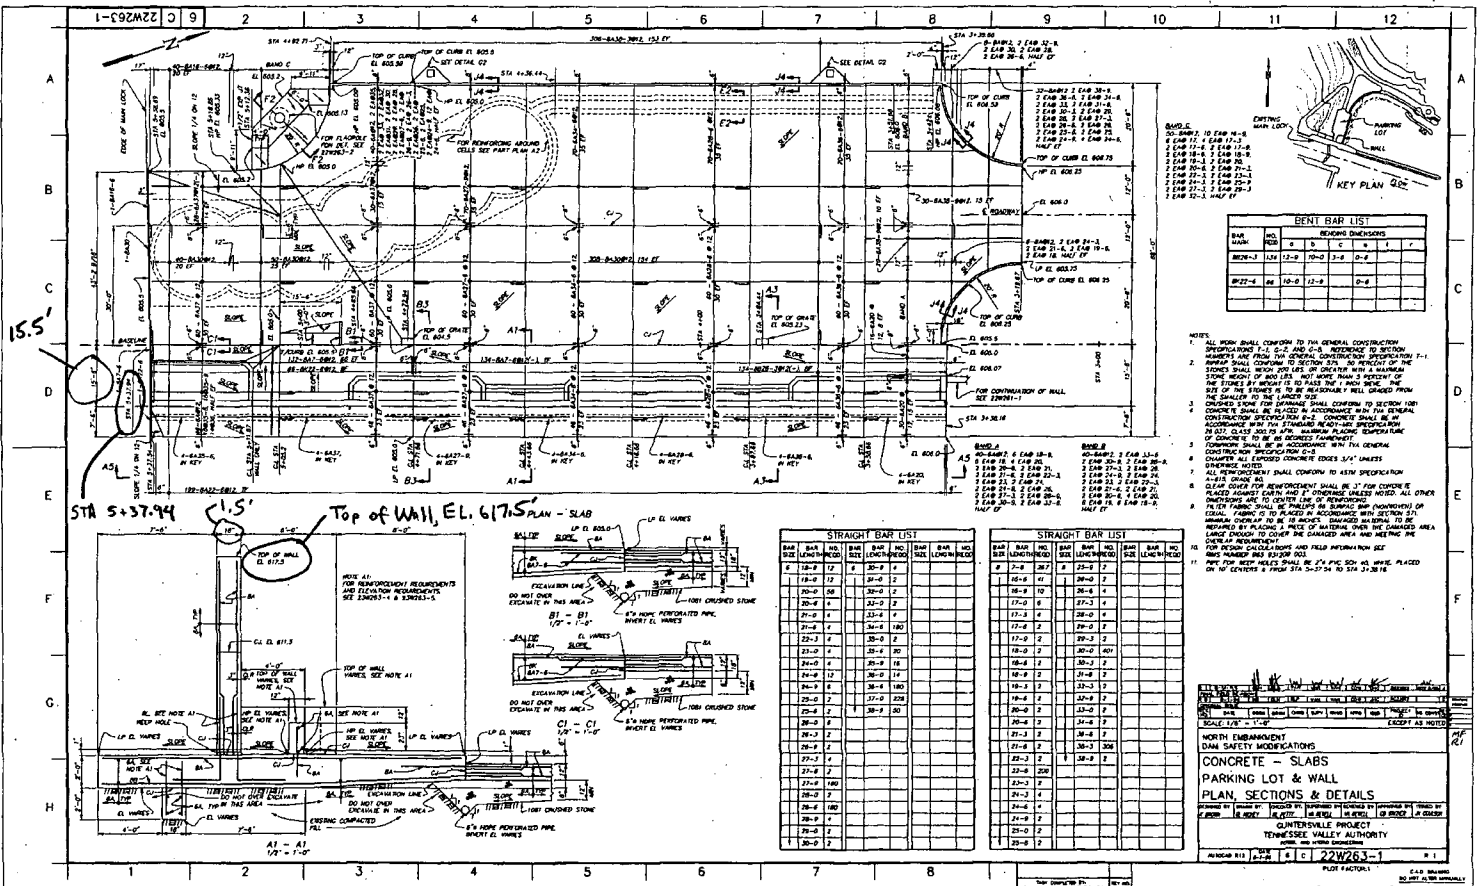

Attachment 15-10  
Source: Reference 10


Calculation No: CDQ000020080011

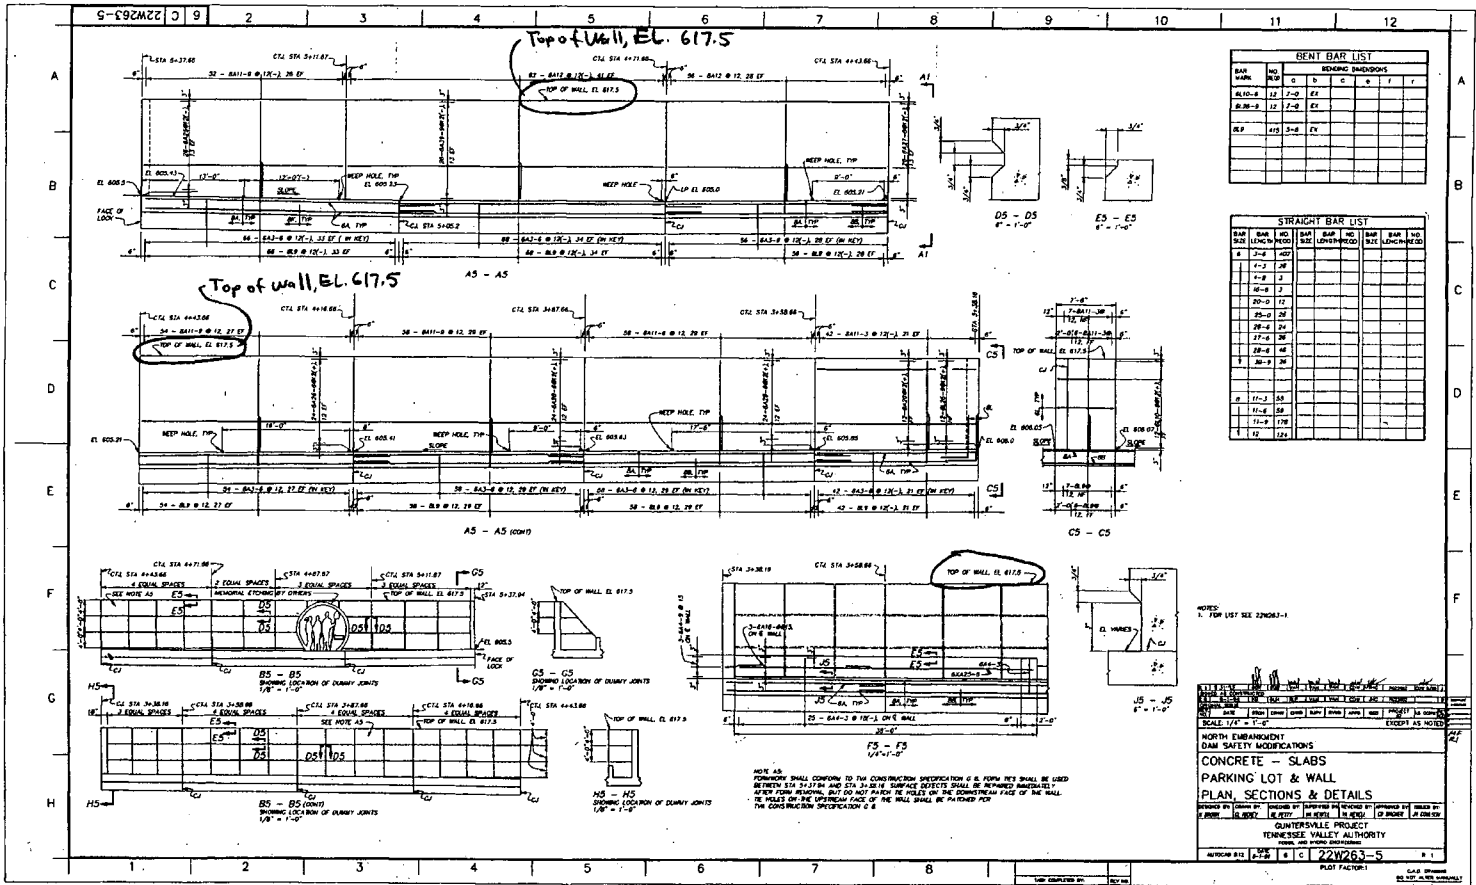

Attachment 15-11


Source: Reference 14

Calculation No: CDQ000020080011

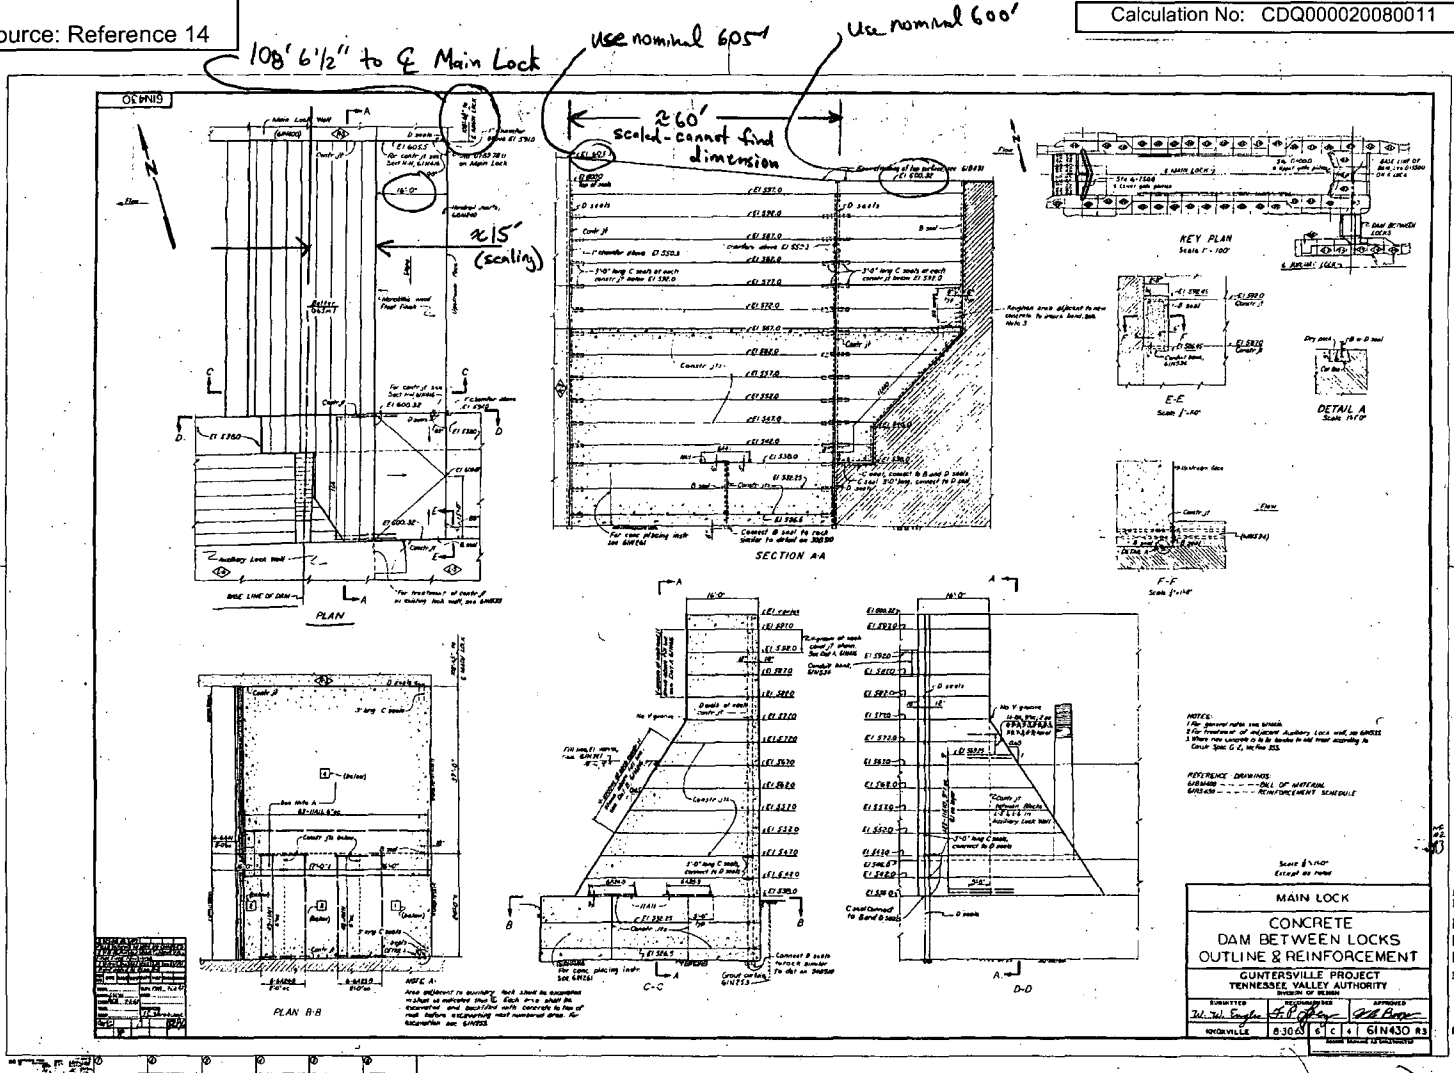







Attachment 15-12  
 Source: Reference 15

Calculation No: CDQ000020080011

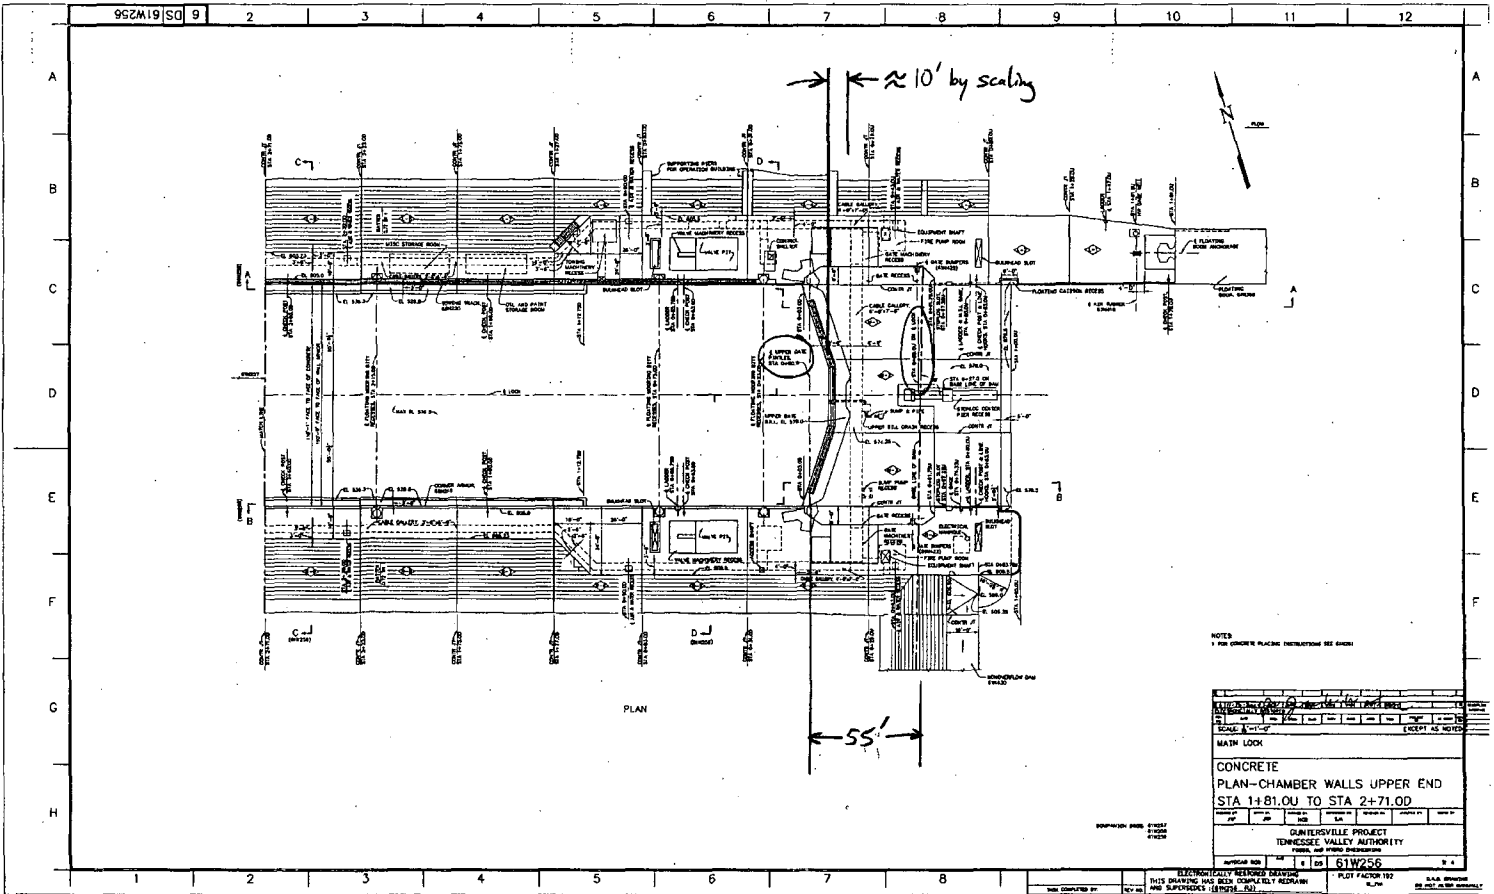

Attachment 15-13  
Source: Reference 16

Calculation No: CDQ000020080011

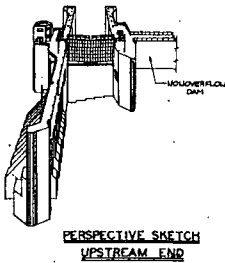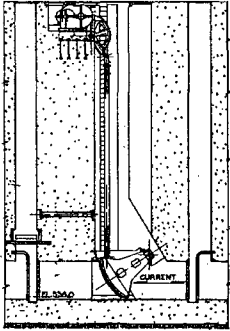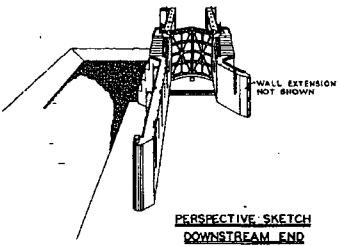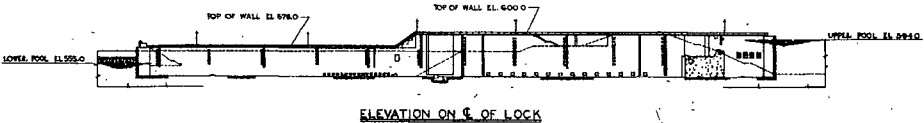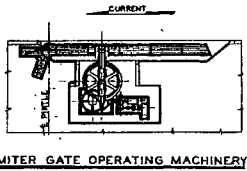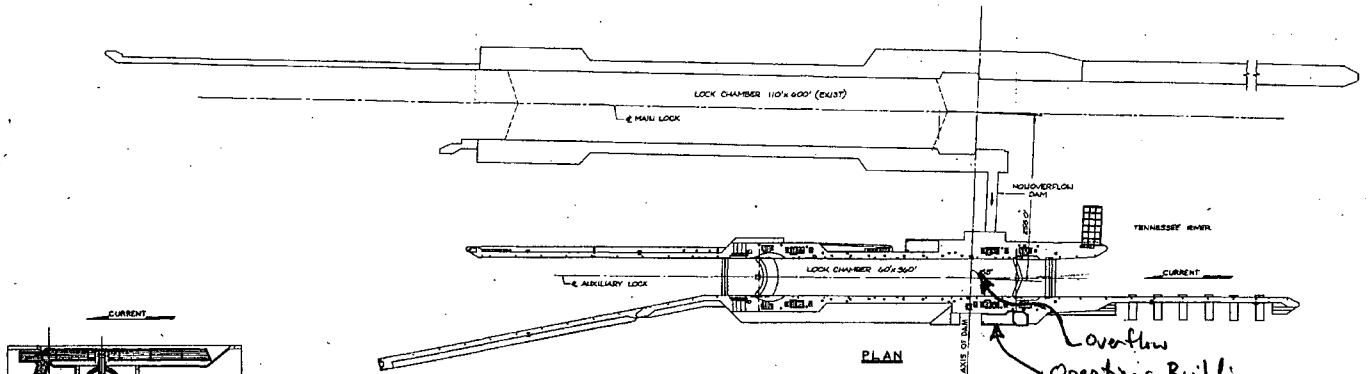

UNITED STATES  
TENNESSEE VALLEY AUTHORITY  
GUNTSVILLE AUXILIARY LOCK  
GENERAL PLAN

WAR DEPARTMENT CORPS OF ENGINEERS U. S. ARMY SUBMITTED: JULY 28, 1930. RECOMMENDED: <i>[Signature]</i> APPROVED: JULY 28, 1930. <i>[Signature]</i> 1 ST. COL. CORPS OF ENGINEERS NASHVILLE, TENN. DESIGNED BY: <i>[Signature]</i> CHECKED BY: <i>[Signature]</i>	UNITED STATES TENNESSEE VALLEY AUTHORITY EXAMINED: <i>[Signature]</i> RECOMMENDED: <i>[Signature]</i> APPROVED: <i>[Signature]</i>
---	--

NO. 4-10-36 UPHOLD AS-BUILT CONDITIONS (C/2)	REVISION
BY DATE	REVISION


3/13



Attachment 15-14

Source: Reference 21

Calculation No: CDQ000020080011

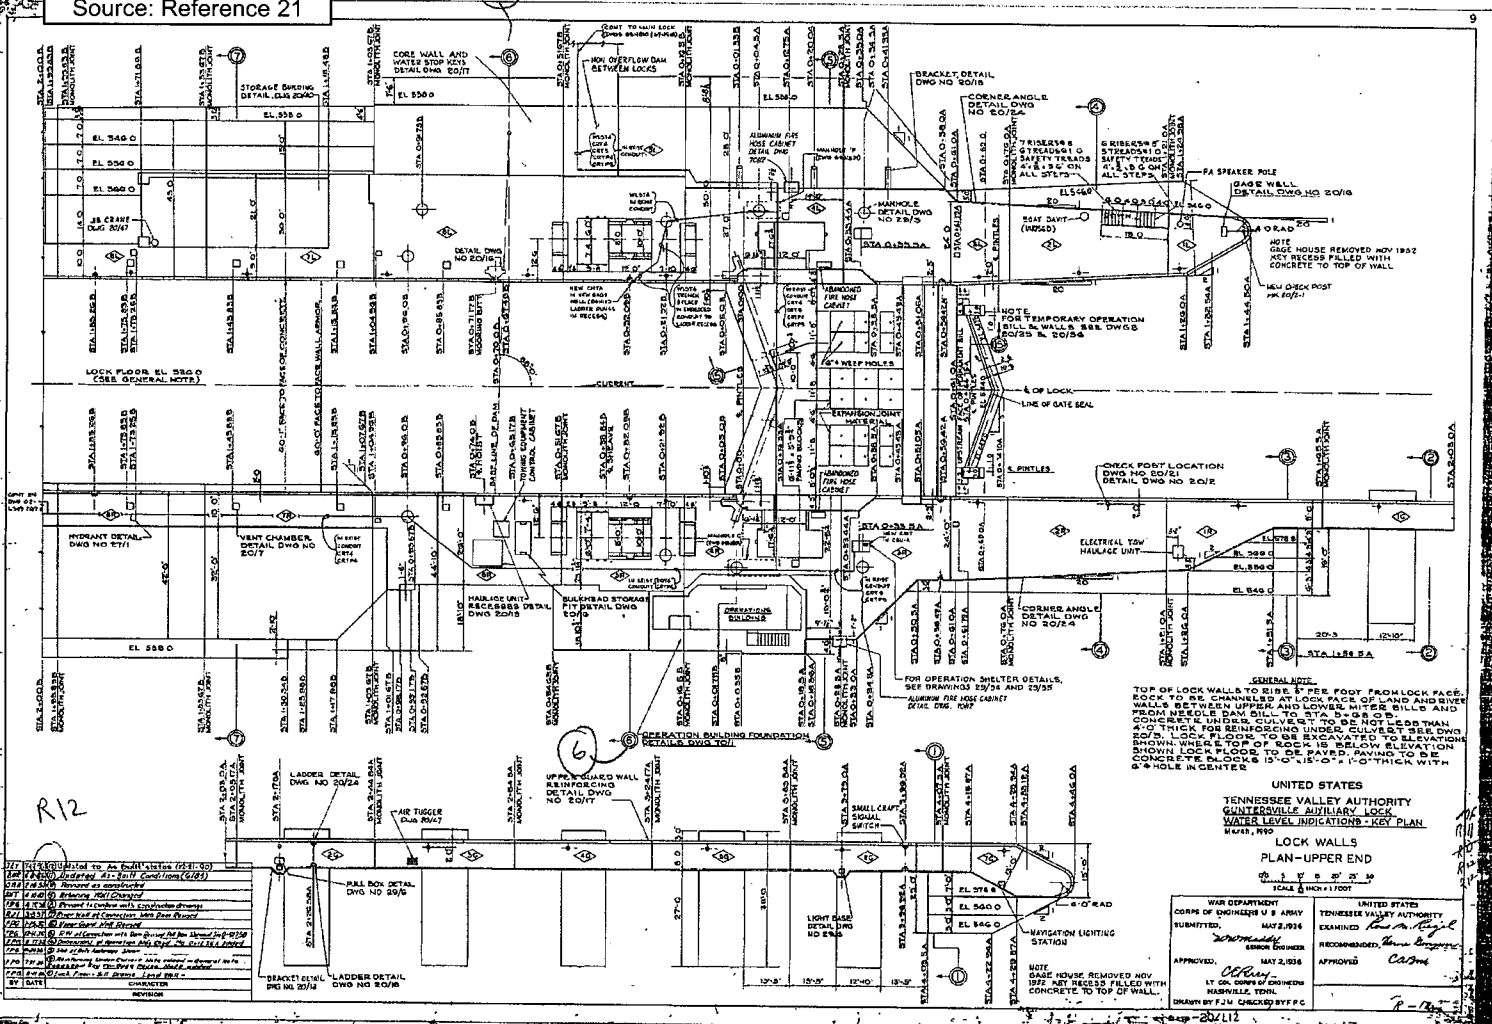

**GENERAL NOTE:**  
 TOP OF LOCK WALLS TO BE 5" PER FOOT FROM LOCK FACE. ROCK TO BE CHANGES AT LOCK FACE OF LAND AND RIVER WALLS BETWEEN UPPER AND LOWER MILES BILLS AND FROM MIDDLE DAM DILL TO STA. 5+08.0. CONCRETE UNDER CURVES TO BE NOT LESS THAN 4" THICK FOR REINFORCING UNDER CURVES PER DWG 2015. 

UNITED STATES  
 TENNESSEE VALLEY AUTHORITY  
 WATER LEVEL INDICATIONS - KEY PLAN  

LOCK WALLS  
 PLAN-UPPER END  
 10'-0" X 15'-0" X 1'-0"  
 SCALE 1/4" = 1'-0"

---	--


02-L349-20/1.12, R12



Guntersville Overflow - Spillway Piers


COMPUTED DATE

CHECKED DATE

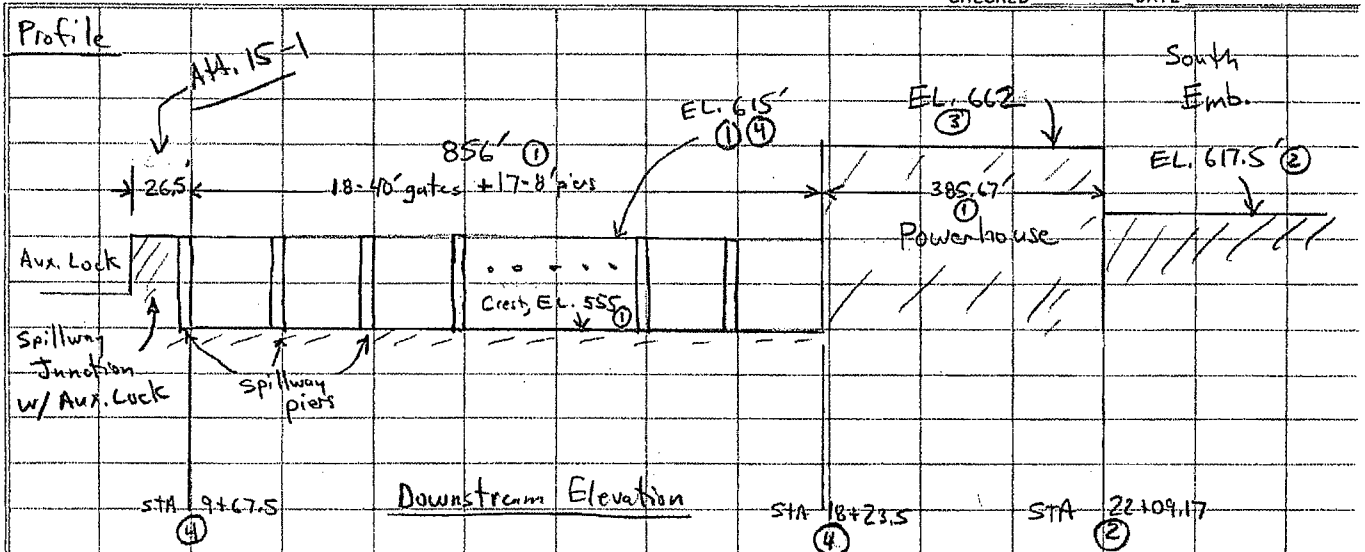

Downstream Elevation  
 Overflow elevation 615';  $Z_c = 615'$   
 $L = 26.5 + 17 \times 8 = 162.5'$   
 Tops of spillway piers


$C_f$  determination (Ref. 7)  
 $0 \leq \frac{H_c}{B} \leq \frac{624 - 615}{41} = 0.22$   
 $\Rightarrow C_f = 2.65$

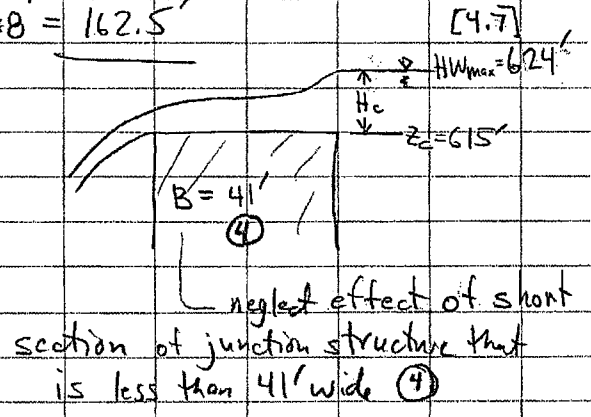

- Drawings
- ① 10W200, R11 (Ref. 1, Att. 1)
  - ② 23W261-1, R2 (Ref. 17, Att. 16-2)
  - ③ 46W300, R6 (Ref. 18, Att. 16-3)
  - ④ 51N241, R8 (Ref. 8, Att. 12)


Attachment 16-2  
Source: Reference 17

Calculation No: CDQ000020080011

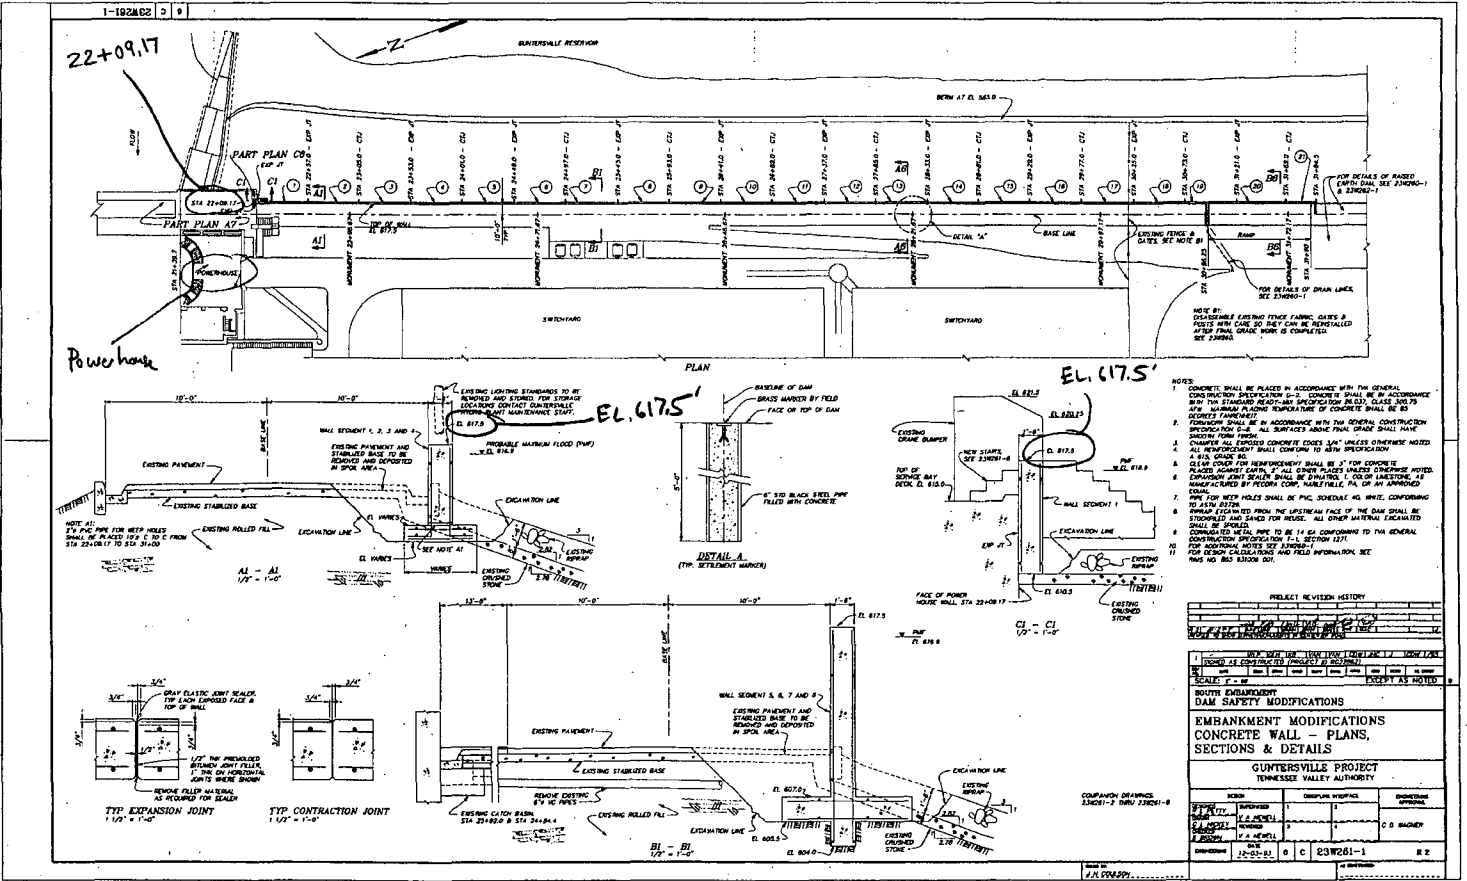

Attachment 16-3  
Source: Reference 18


Calculation No: CDQ000020080011

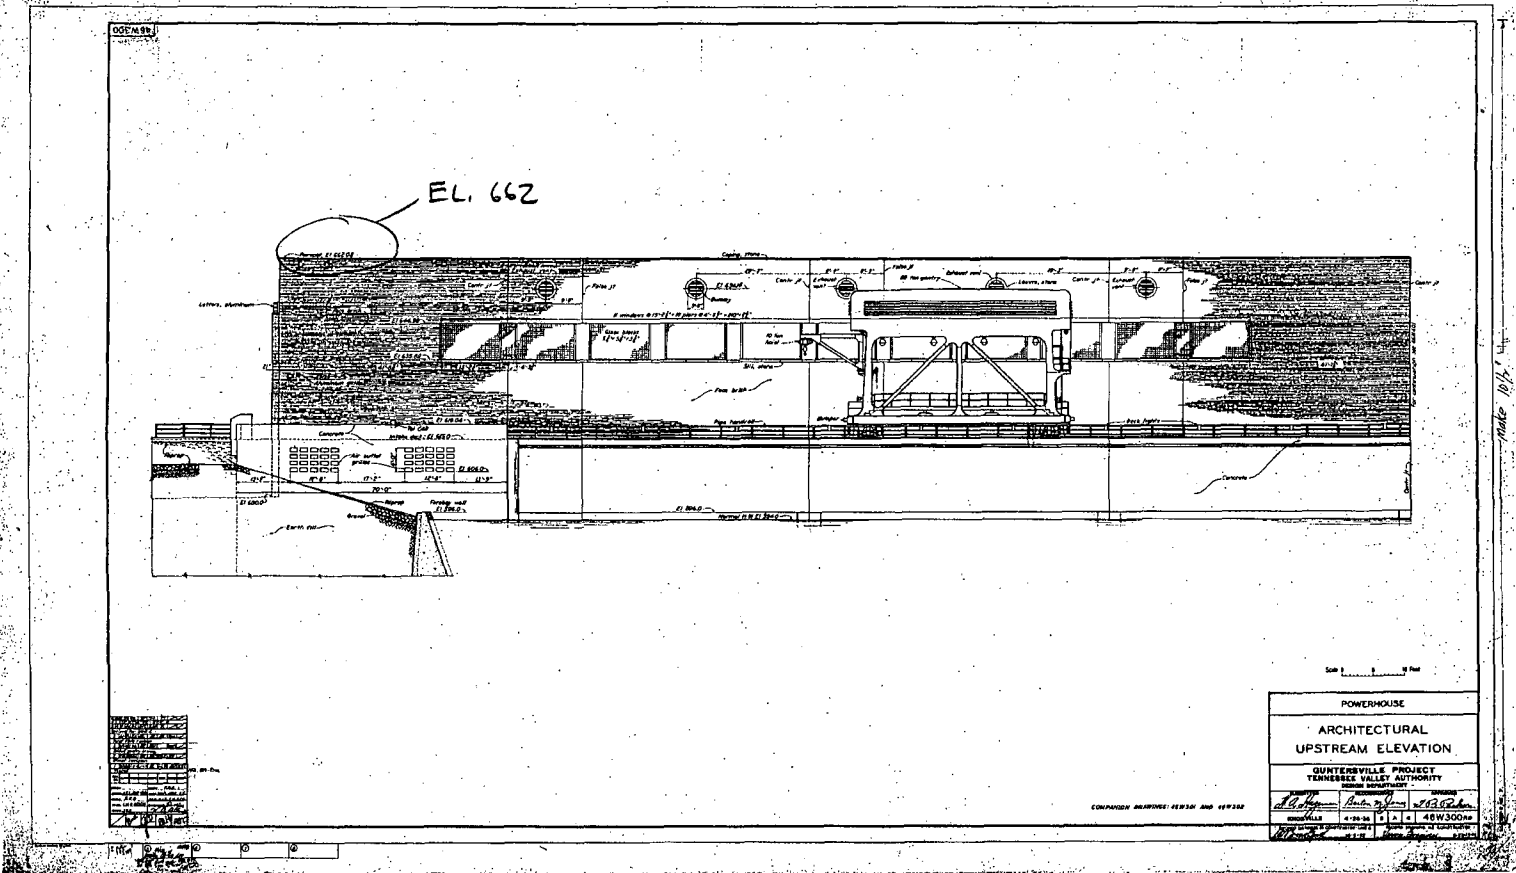

Guntersville North Embankment- Flood Wall

COMPUTED WITH DATE 11/24/08


CHECKED DATE

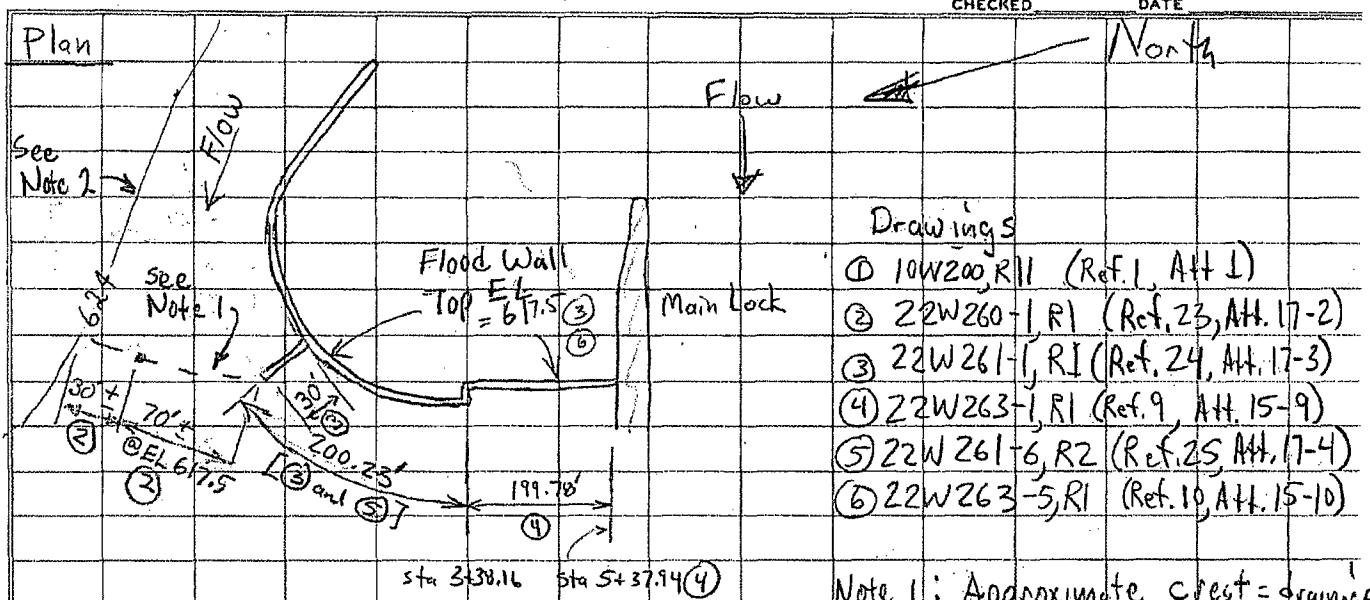

- DRAWINGS
- ① 10W200, R11 (Ref. 1, Att 1)
  - ② 22W260-1, R1 (Ref. 23, Att. 17-2)
  - ③ 22W261-1, R1 (Ref. 24, Att. 17-3)
  - ④ 22W263-1, R1 (Ref. 9, Att. 15-9)
  - ⑤ 22W261-6, R2 (Ref. 25, Att. 17-4)
  - ⑥ 22W263-5, R1 (Ref. 10, Att. 15-10)

Note 1: Approximate crest = drainage divide estimated from ②  
 Note 2: Contour estimated from ②

Overflow Profile

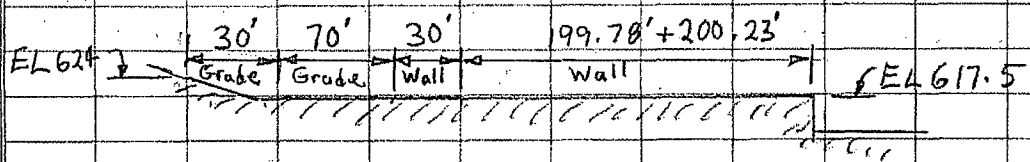

Overflow Parameters

Flood Walls:  $B = 1.5'$  (③),  $Z_c = 617.5'$  (③)

$$0 \leq H_c < 624 - 617.5 = 6.5'$$

$$0 \leq H_c/B \leq 6.5/1.5 = 4.3 \quad \therefore 2.65 \leq C_f \leq 3.3 \quad \text{per Ref 6}$$

$$L = 200.23 + 199.78 + 30 = 430'$$

Use  $C_f = 3.2$

For Grade North of Flood Walls

Treat as weir with very broad crest,  $\therefore C_f = 2.65$  per Ref 6

$Z_c = 617.5'$  for  $L = 70'$  for parking area

$Z_c \approx (624 + 617.5)/2 = 621'$  for  $L = 30'$  for sloped section


weighted average =  $[3.2(430) + 2.65(70)]$

Summary:	$Z_c$ , ft	$L$ , ft	$C_f$		
	617.5	430	3.2	} Flood Walls	
	617.5	70	2.65		} Grade including parking area
	621	30	2.65		

500  
= 3.12

Attachment 17-2  
Source: Reference 23

Calculation No: CDQ000020080011

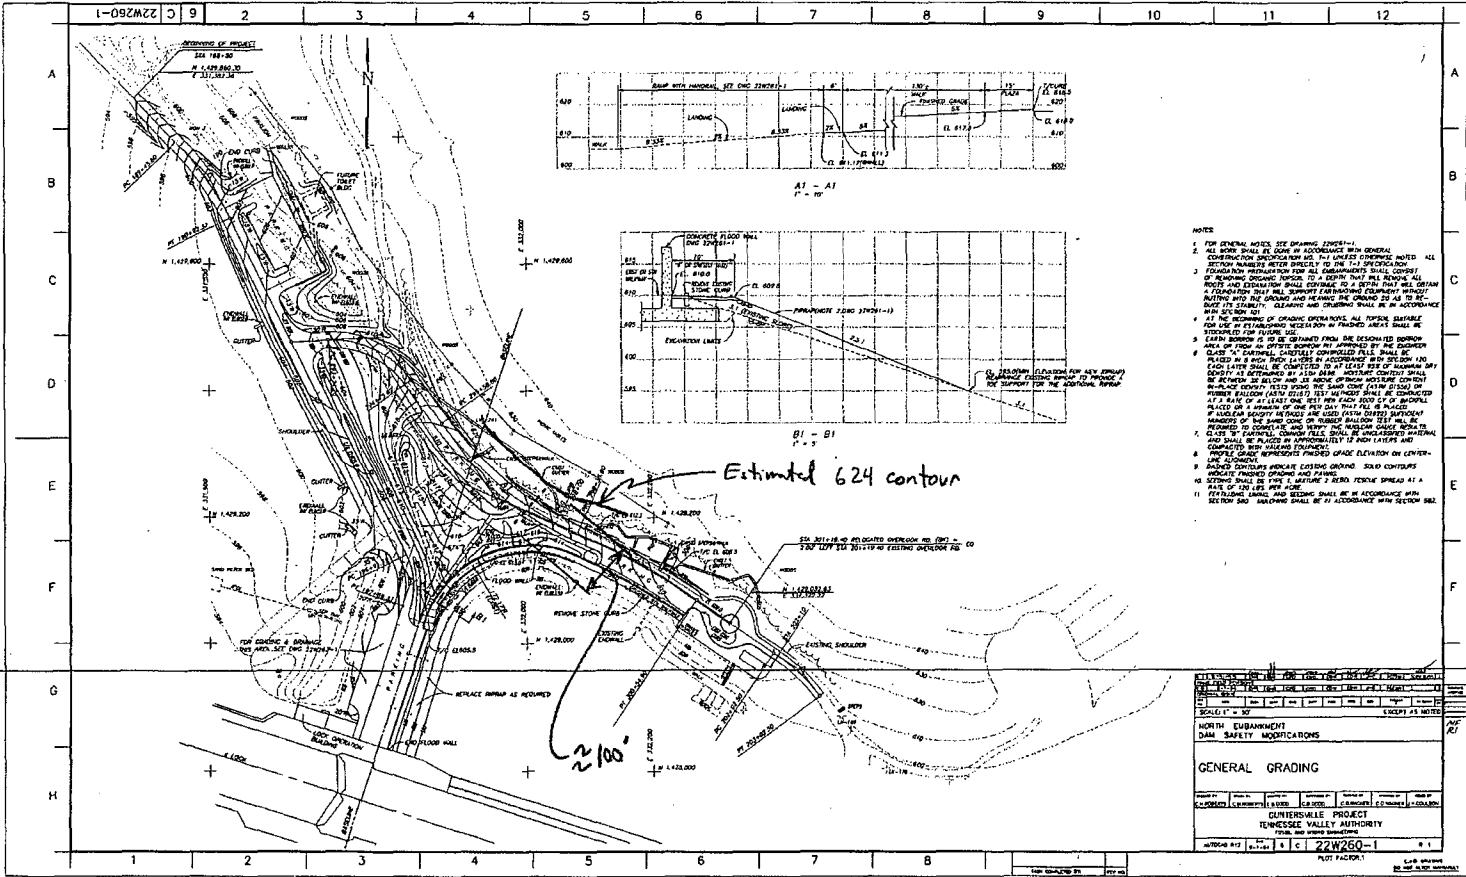


- NOTES
1. FOR GENERAL NOTES, SEE DRAWING 22W50-1.
SCALE: 1" = 100'	
NORTH SUBAMMENT	
DAM SAFETY MODIFICATIONS	
GENERAL GRADING	
DESIGNED BY: [ ]	CHECKED BY: [ ]
DATE: [ ]	PROJECT NO: [ ]
TENNESSEE VALLEY AUTHORITY	

Attachment 17-3  
Source: Reference 24

Calculation No: CDQ00020080011

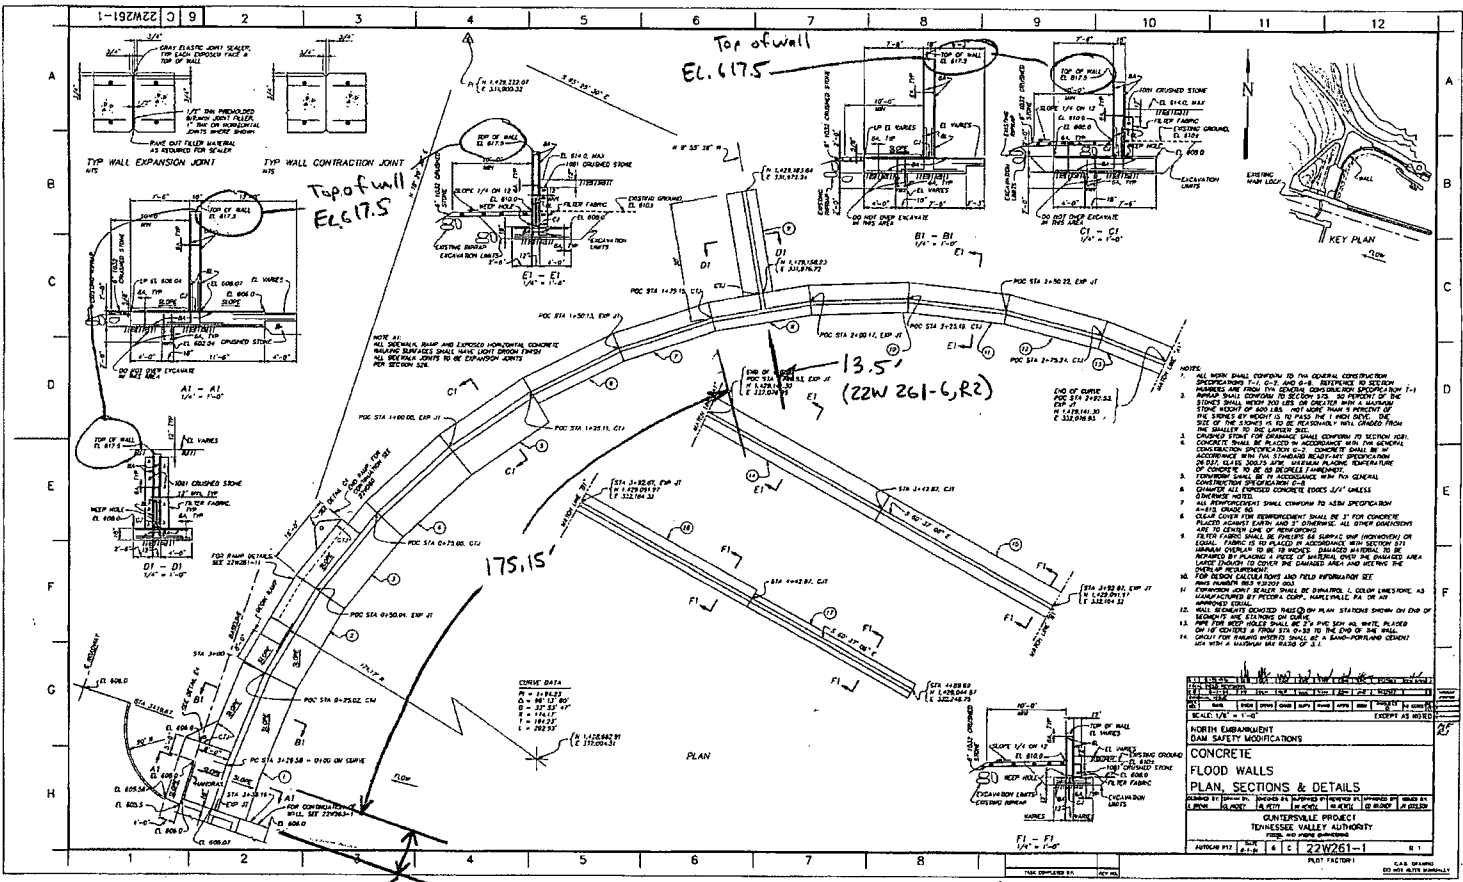

11.58' (station difference)


$$11.58 + 175.15 + 13.5 = 200.23$$

3



Attachment 17-4  
Source: Reference 25

Calculation No: CDQ000020080011

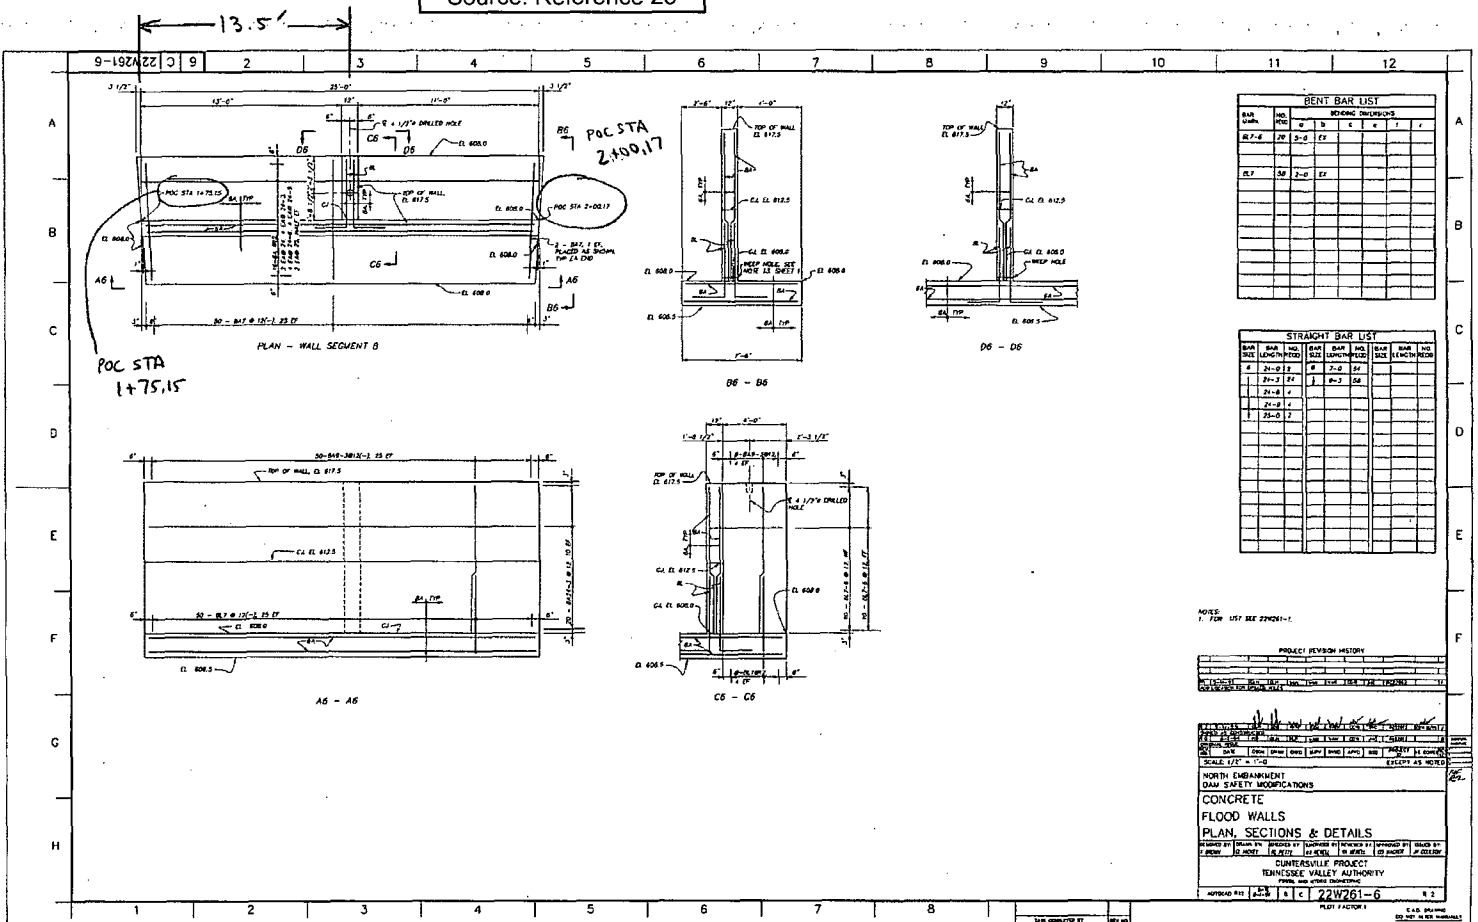


5

Guntersville South Embankment

COMPUTED W/H R DATE 11-24-08

CHECKED \_\_\_\_\_ DATE \_\_\_\_\_

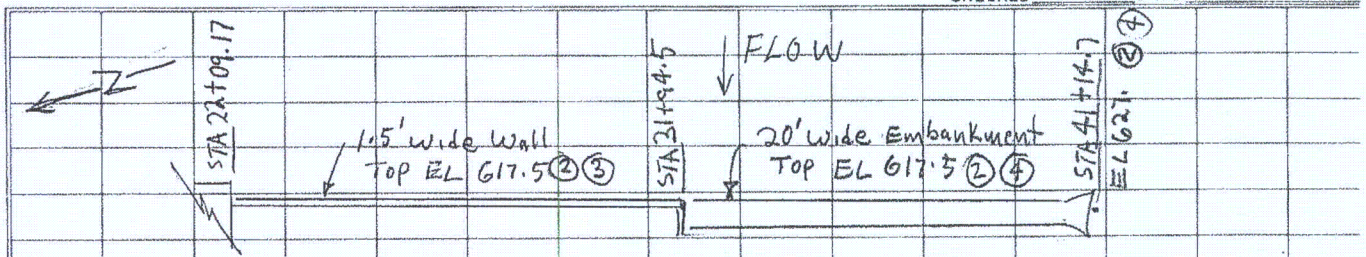

Drawings

- ① 10W 200, R11 (Ref. 1, Att. 1)
- ② 23 W 260-1, R2 (Ref. 26, Att. 18-2)
- ③ 23 W 261-1, R1 (Ref. 17, Att. 16-2)
- ④ 23 W 262-1, R1 (Ref. 27, Att. 18-3)

Flood Wall Section (Sta 22+09.17 to sta 31+94.5)

$B = 1.5$  ② ③       $Z_c = 617.5'$  ② ③  
 $0 \leq H_c \leq 624 - 617.5' = 6.5'$   
 $0 \leq H_c/B \leq 6.5/1.5 = 4.3$ ,  $\therefore 2.65 \leq C_f \leq 3.3$  per Ref 6  
 Use  $C_f = 3.2$   
 $L = 3194.5 - 2209.17 = 985.33'$

Embankment Section (beyond sta 31+94.5)

$B = 20'$  ② ④       $Z_c = 617.5'$  ② ④  
 $0 \leq H_c \leq 6.5$   
 $0 \leq H_c/B \leq 6.5/20 = 0.33$   $\therefore C_f = 2.65$  per Ref 6  
 From Det D2 and section B2-B2 on 23W 262-6, approximate  
 end point for embankment = STA 40+99'  
 $L = 40+99 - 31+94.5 = 905'$


Summary

$Z_c$ , ft	$L$ , ft	$C_f$	
617.5	985'	3.2	Flood wall
617.5	905'	2.65	Embankment
Use 617.5	1890	2.94	weighted average $= [3.2(985) + 2.65(905)] / 1890$


Attachment 18-2

Source: Reference 26

Calculation No: CDQ00020080011

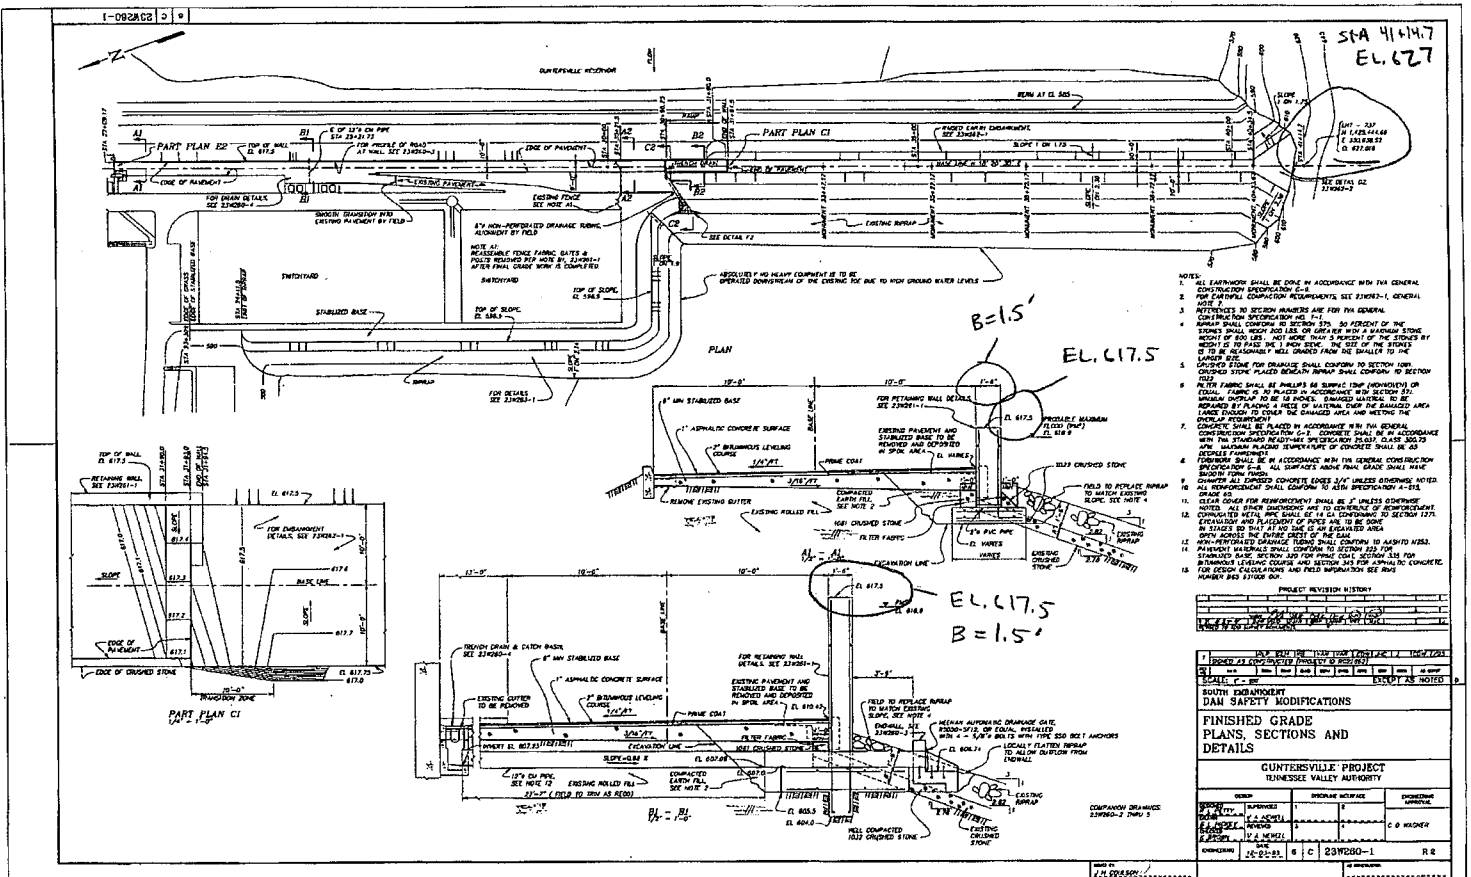

1-202462

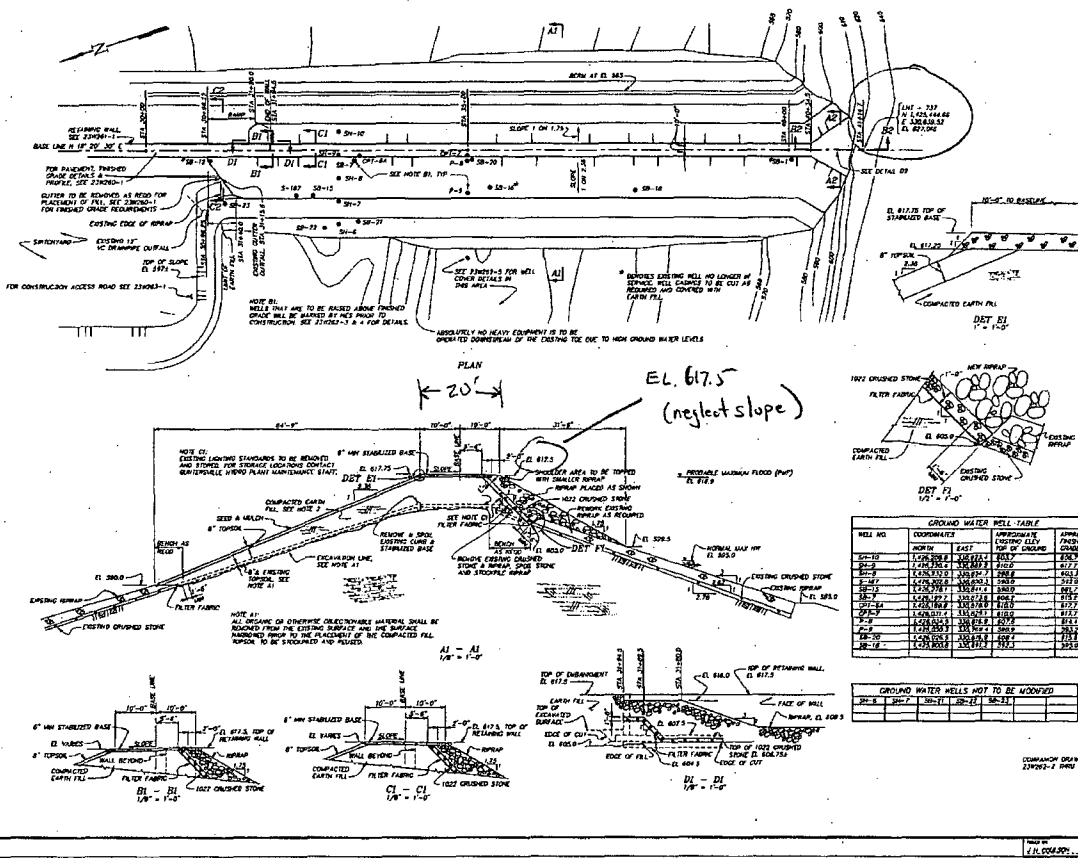



EMBAANKMENT MODIFICATIONS  
EARTH DAM - PLANS,  
SECTIONS & DETAILS

GUNTERSVILLE PROJECT  
TENNESSEE VALLEY AUTHORITY




TW-Q points from Attachment 5

Downstream Elev. = 557 ft.

Discharge 1000 cfs	TW
20	557.6
40	559.0
60	560.8
80	562.8
100	564.6
150	569.3
200	573.2
250	576.6
300	579.8
350	582.6

Downstream Elev. < 548 ft.

Discharge 1000 cfs	TW
400	584.8
500	589.2
600	593.1
700	596.6
800	599.8
900	602.9
1000	605.7
1100	608.4
1200	610.9
1400	615.8
1500	618.1


Polynomial Fit

(1) Discharge 1000 cfs	(2) TW
0	554.9
25	557.6
50	560.2
75	562.6
100	564.9
150	569.2
200	573.0
250	576.4
300	579.6
400	585.0
500	589.4
600	593.3
800	599.8
1000	605.5
1200	611.0
1400	615.9
1500	617.9

Polynomial Curve Fit:

$$TW = 554.89 + 0.11085Q - 1.157 \times 10^{-4} Q^2 + 7.335 \times 10^{-8} Q^3 - 1.788 \times 10^{-11} Q^4$$


where TW = tailwater elevation in feet and Q = discharge in 1000 cfs

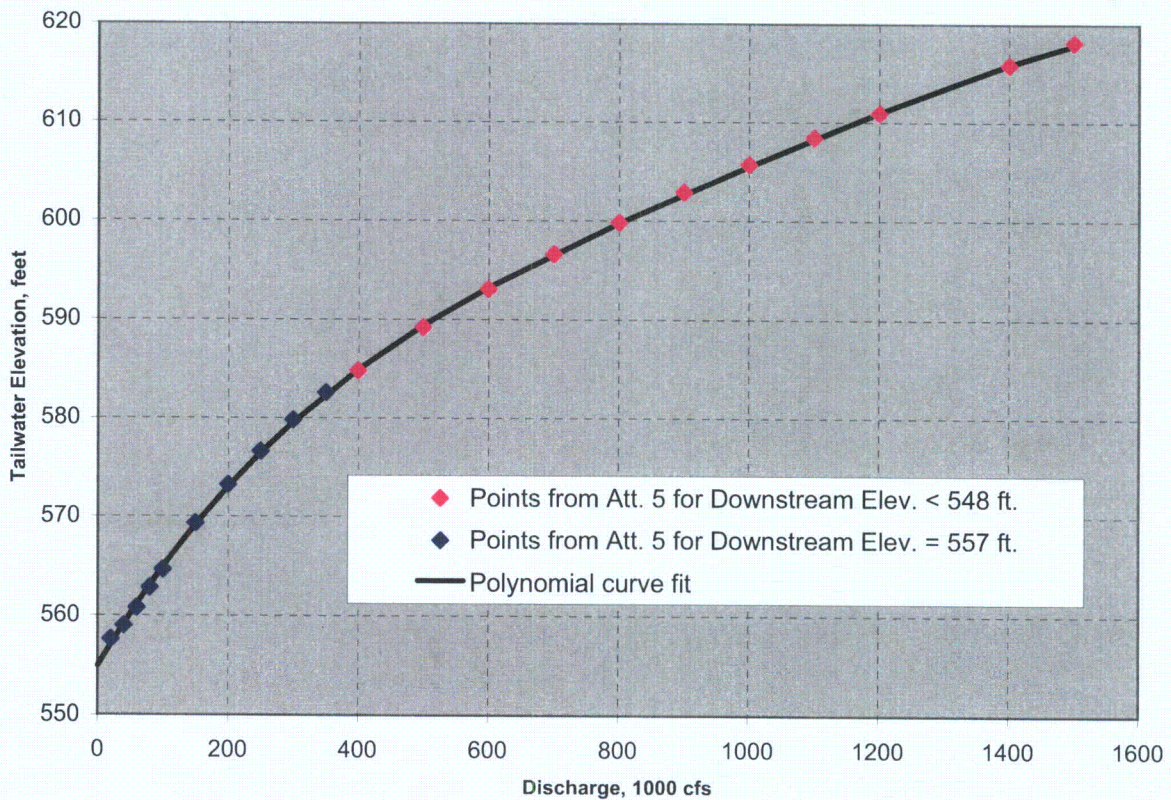

Attachment 20-1

Source: Section from Reference 8


Calculation No: CDQ000020080011

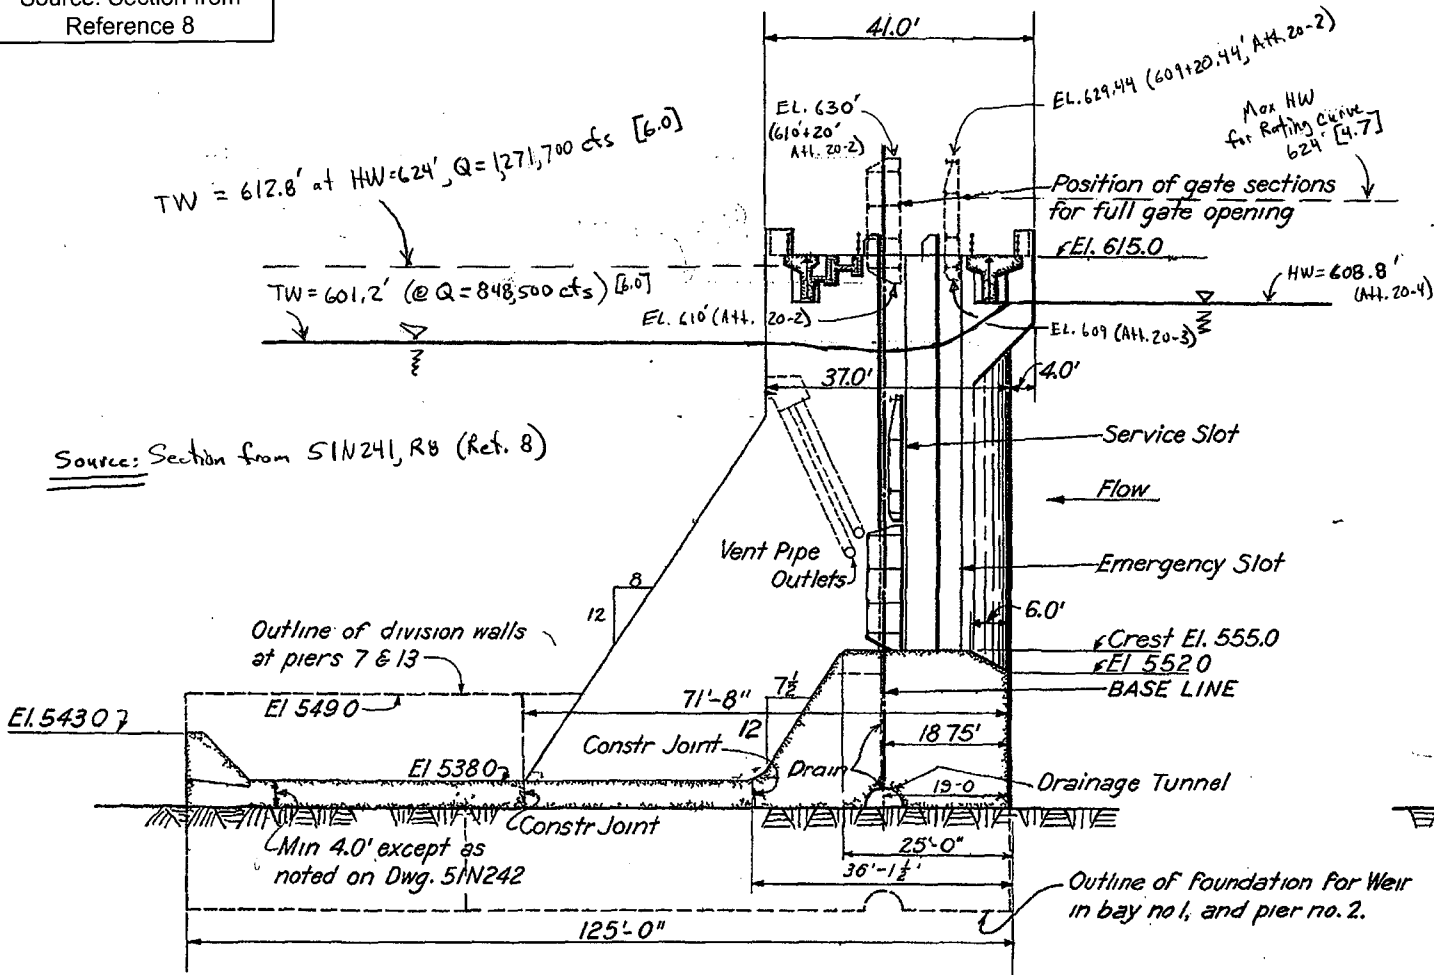








Source: Section from 51N241, R8 (Ref. 8)

Attachment 20-2  
 Source: Reference 28

Calculation No: CDQ000020080011

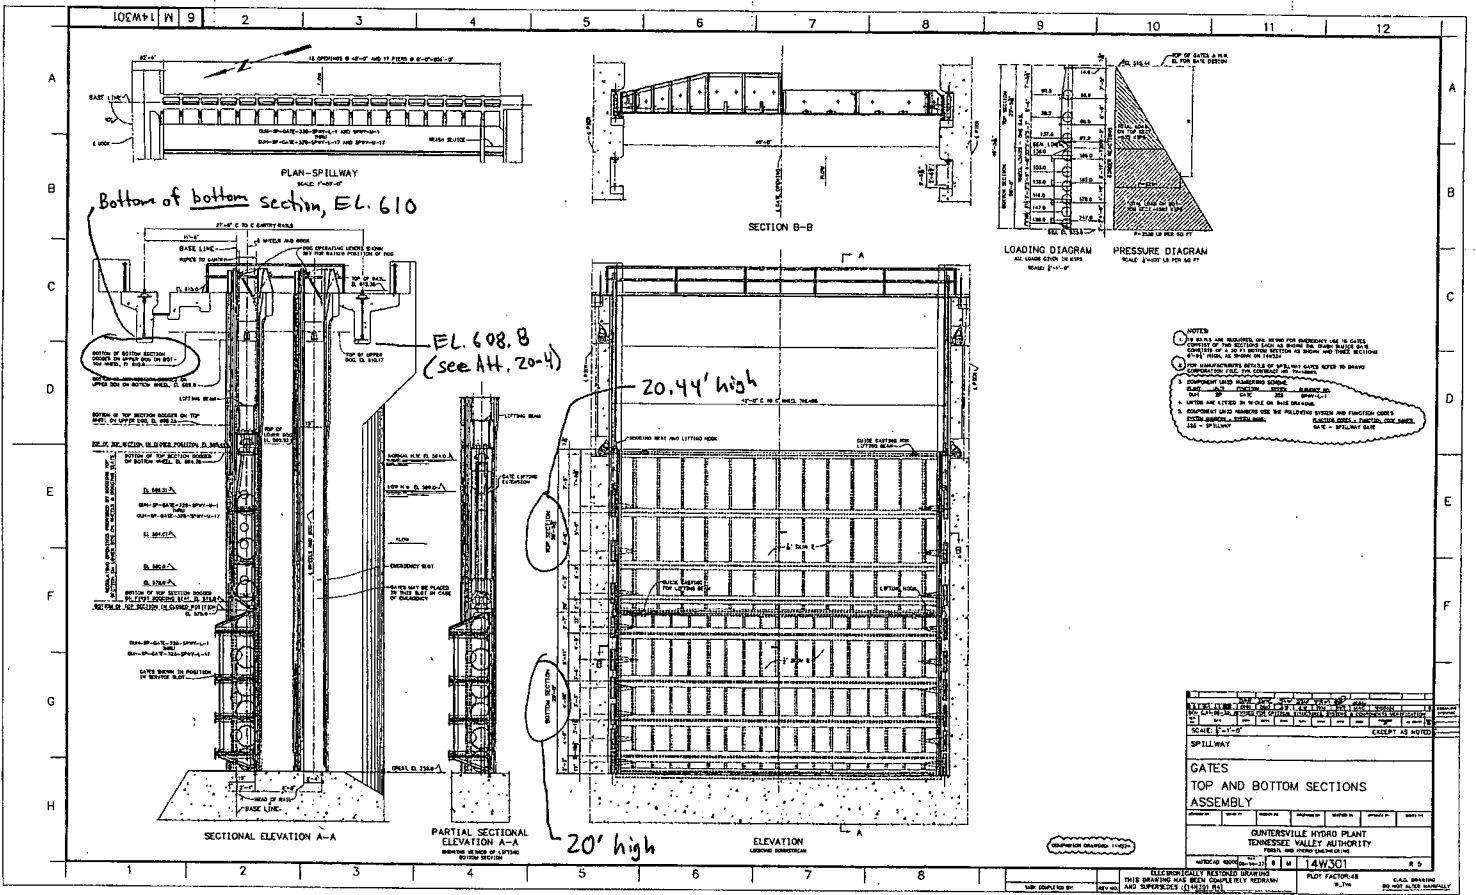

Source: Reference 29

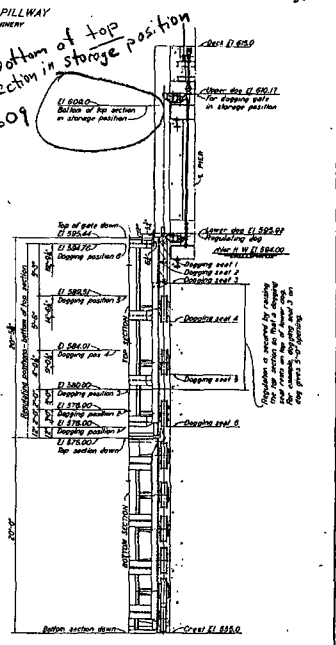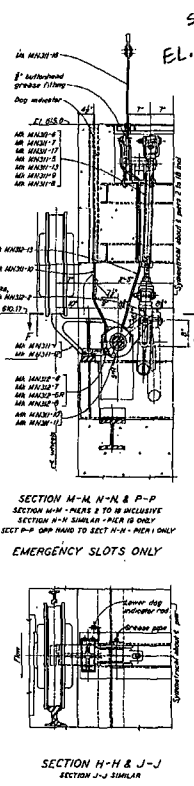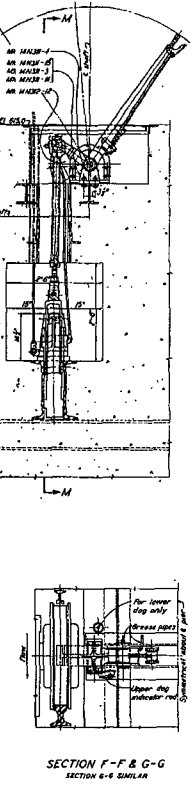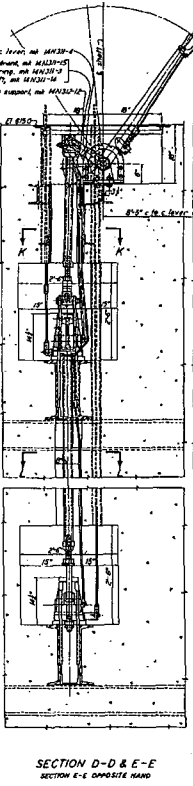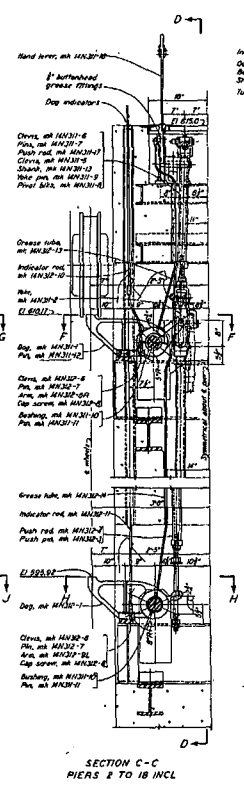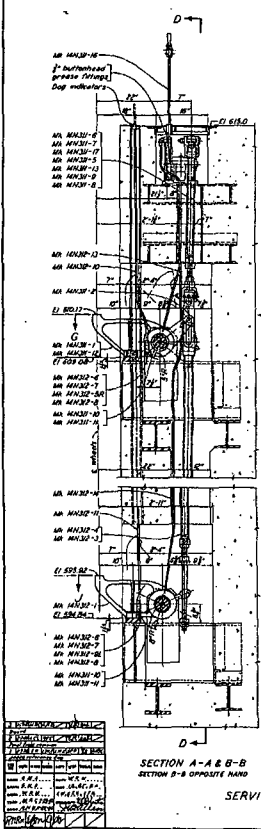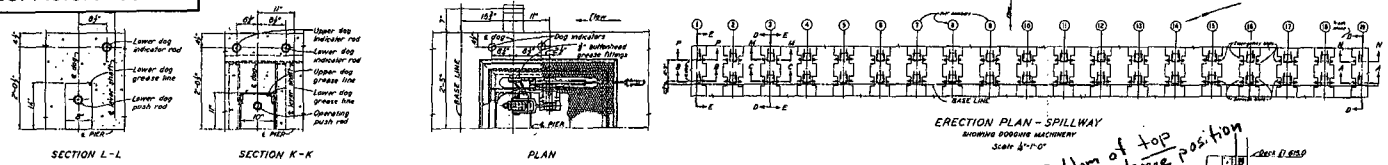

SPILLWAY		
<b>GATE DOGGING MECHANISM ARRANGEMENT</b>		
GUNTERSVILLE PROJECT TENNESSEE VALLEY AUTHORITY ENGINEERING DESIGN DEPARTMENT		
DESIGNED BY <i>[Signature]</i>	CHECKED BY <i>[Signature]</i>	APPROVED BY <i>[Signature]</i>
GUNTSVILLE, TENN. 6-24-57		

NOTES:  



Attachment 20-4

Source: Reference 30

Calculation No: CDQ00020080011

